





**MATCH LINE**

**SPRINKLER SYMBOL LEGEND**

⊙ EXISTING SPRINKLER HEAD TO REMAIN

⊗ EXISTING SPRINKLER HEAD TO BE REMOVED

⊗ EXISTING SIDEWALL SPRINKLER HEAD TO BE REMOVED

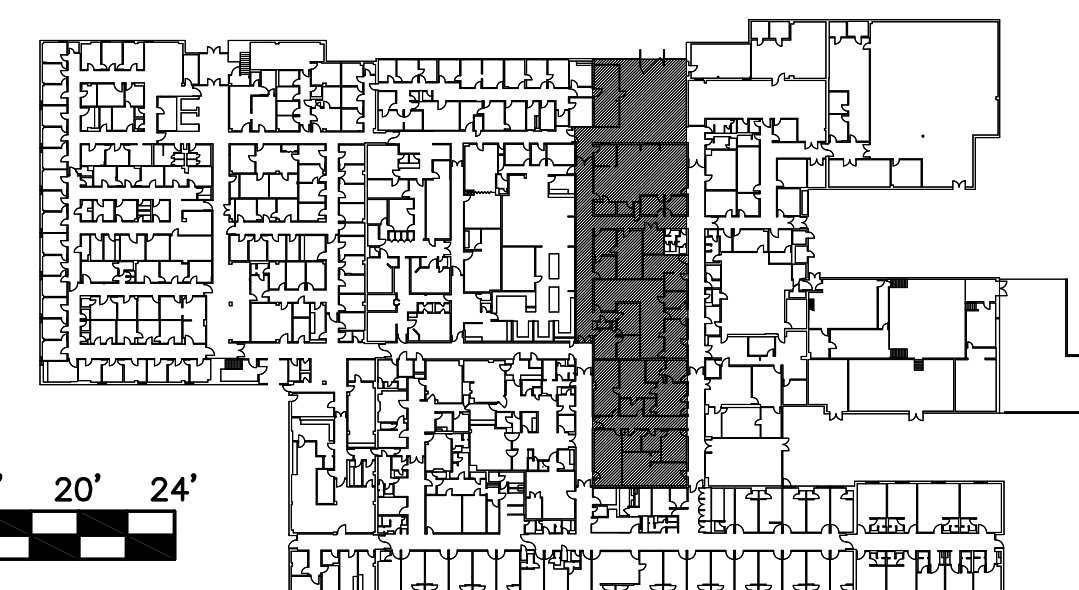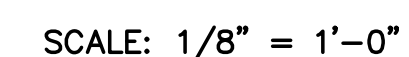

PROJECT TITLE  
REPAIR & RENOVATE MED. CLINIC PH IV A  
LITTLE ROCK AIR FORCE BASE  
JACKSONVILLE, ARKANSAS

DRAWN BY <b>BMS</b>	LEAD DESIGNER <b>JCF</b>
TECH REVIEWER <b>JCF</b>	PROJECT NUMBER <b>NKAK 06-8006 4A</b>
DESIGNED BY <b>JCF</b>	SHEET <b>F-101</b>
DATE <b>13 MAY 2009</b>	
SCALE <b>AS SHOWN</b>	<b>37 of 51</b>