


LITTLE ROCK A.F.B.
ARKANSAS

FPM



804 West Curtis Drive, Suite H
Midwest City, OK 73110
phone: 405.869.9212
fax: 405.869.9222
www.fpm-group.com

RECORD
DRAWINGS
MARCH 2007

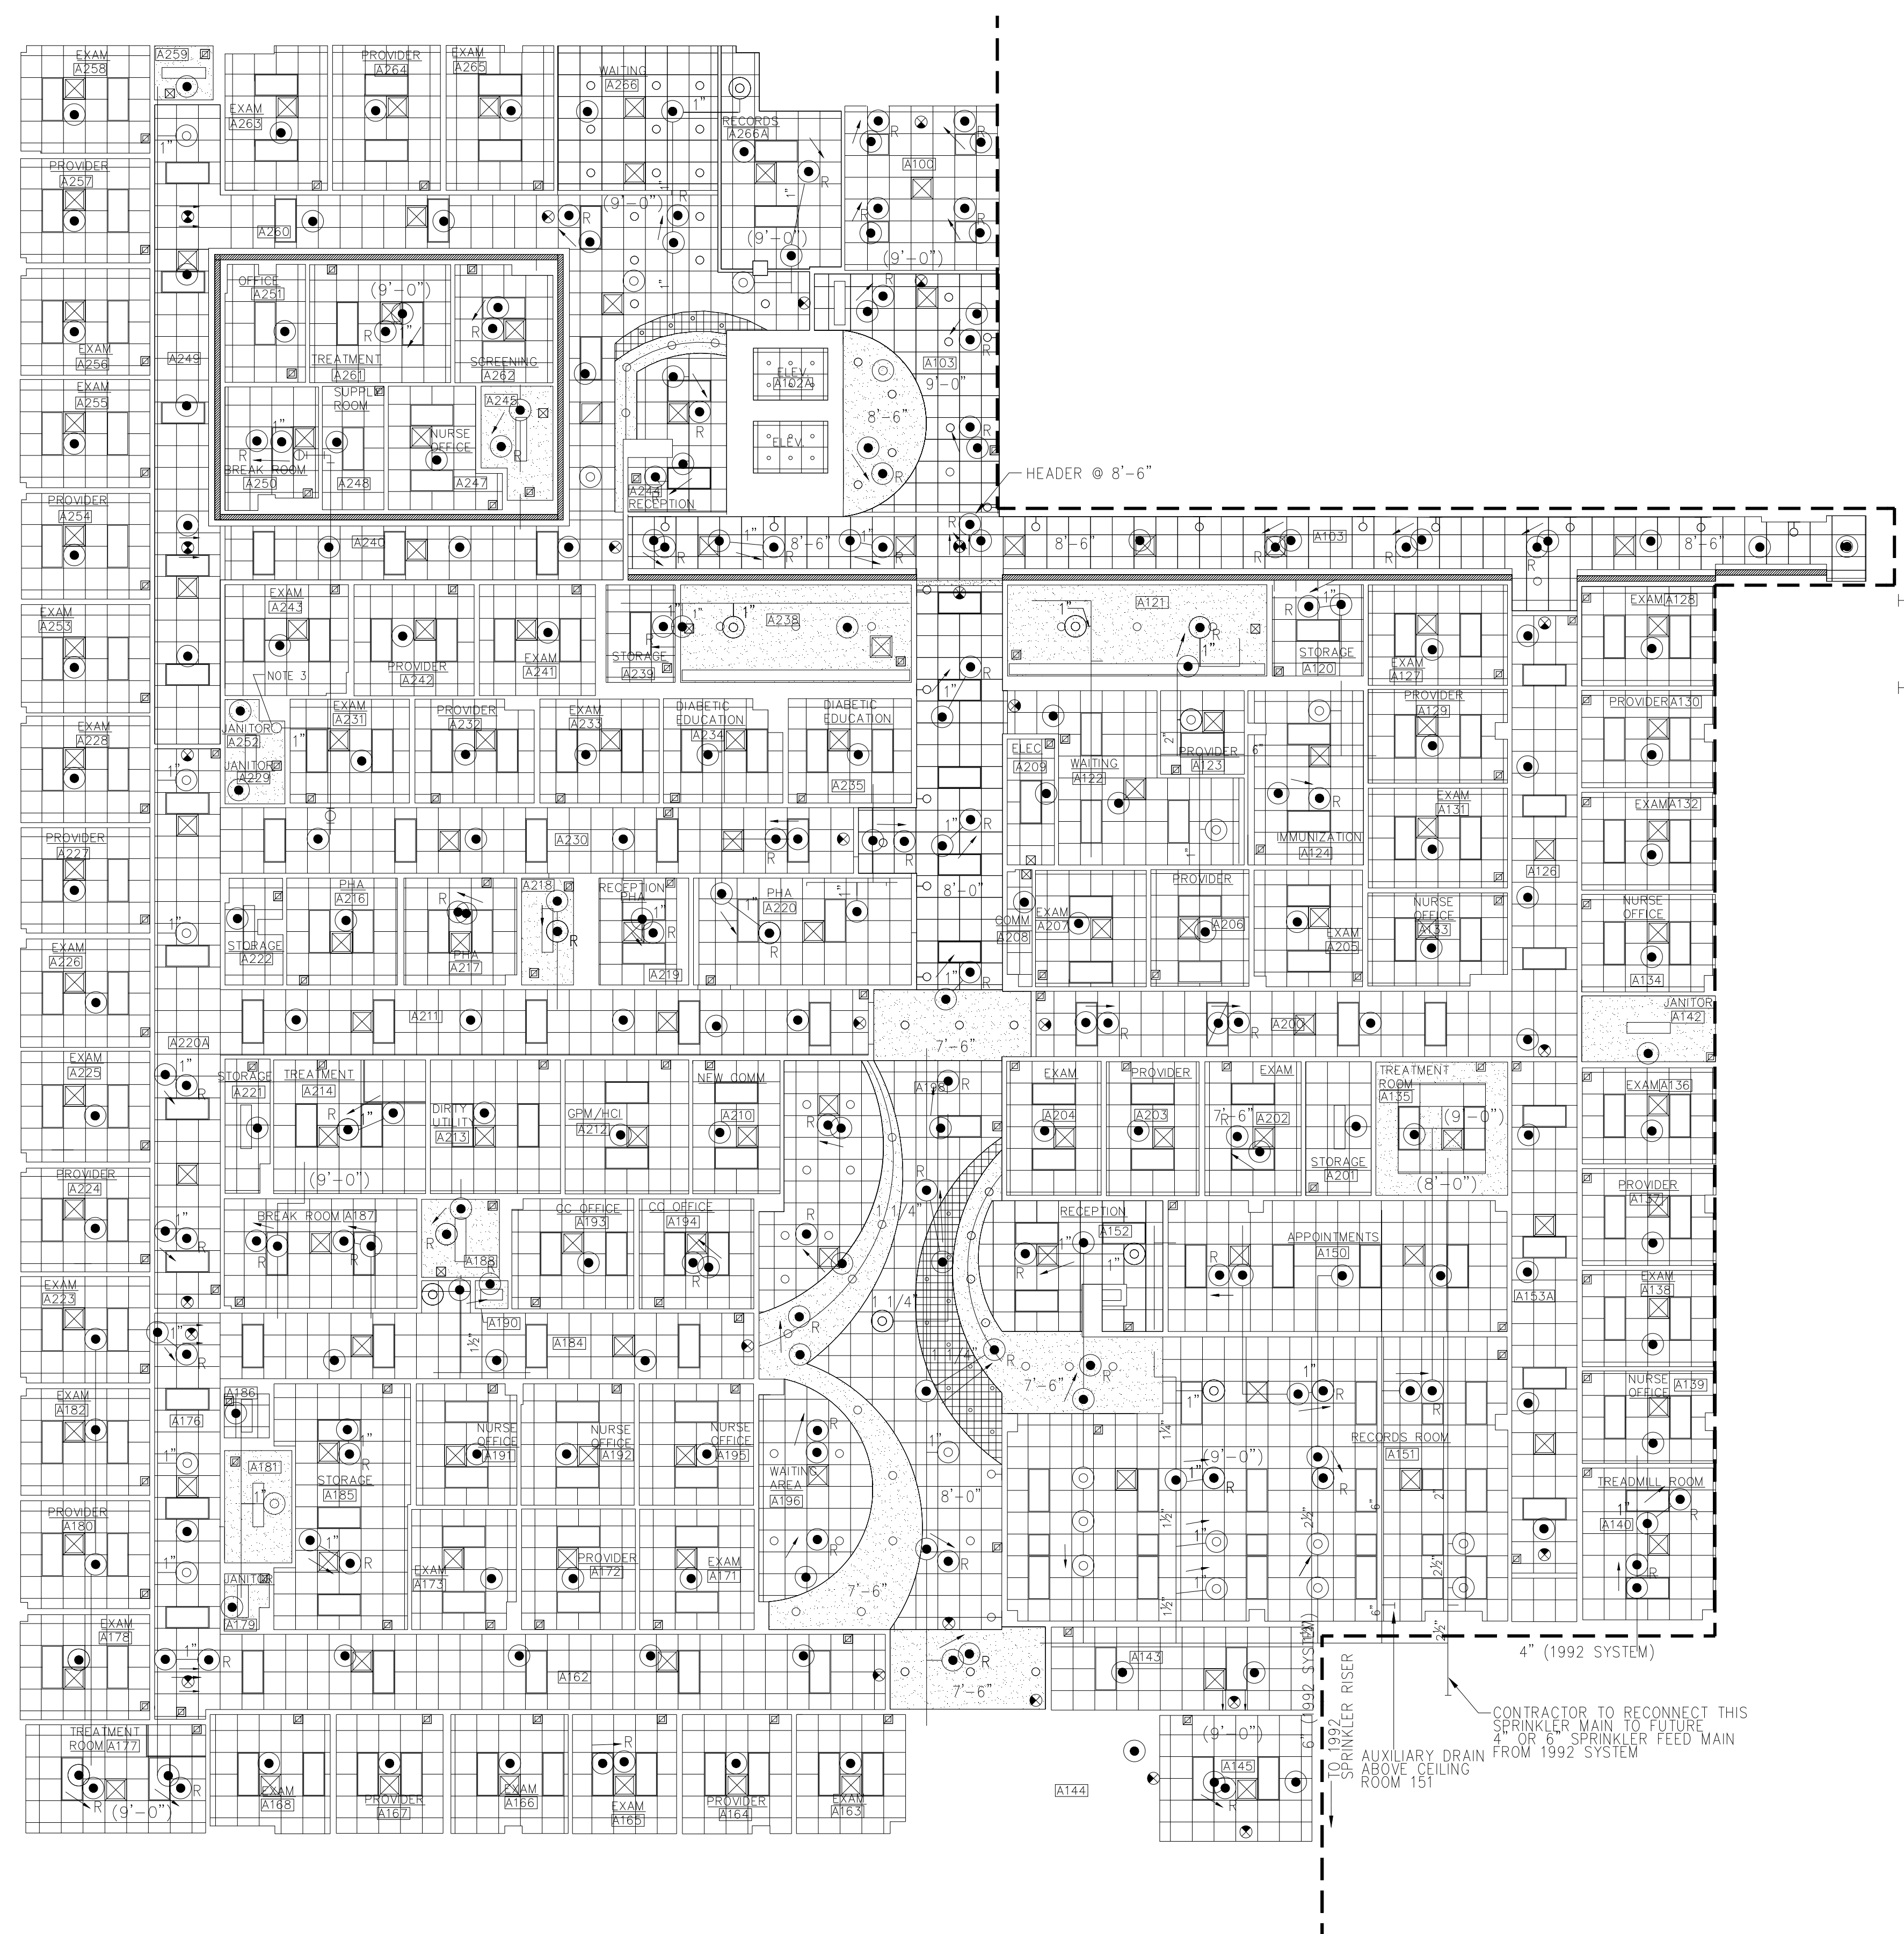

NOTE:

1. ALL PIPING AND SPRINKLER INSTALLATIONS SHALL BE IN ACCORDANCE WITH NFPA 13 - INSTALLATION OF SPRINKLER SYSTEMS (LATEST EDITION)
2. ALL FIRE SPRINKLER DRAINS AND INSPECTOR'S TEST POINTS SHALL BE ROUTED TO THE EXTERIOR OF THE BUILDING.
3. DRAIN WAS REMOVED, TIED INTO 2- $\frac{1}{2}$ " MAIN THAT SERVICED THAT AREA PER ARKANSAS AUTOMATIC SPRINKLERS.
4. SPRINKLER HEADS SHALL BE CENTERED FROM ENTRANCE A100 RUNNING SOUTH THROUGH LOBBY A103 ENDING IN WAITING AREA A196. REMAINING EXISTING SPRINKLER HEADS DO NOT HAVE TO BE CENTERED IN TILE AND SHALL BE ACCOMMODATED BY NEW ACOUSTICAL CEILING GRID.
5. SEE CEILING LEGEND ON SHEET A0.00

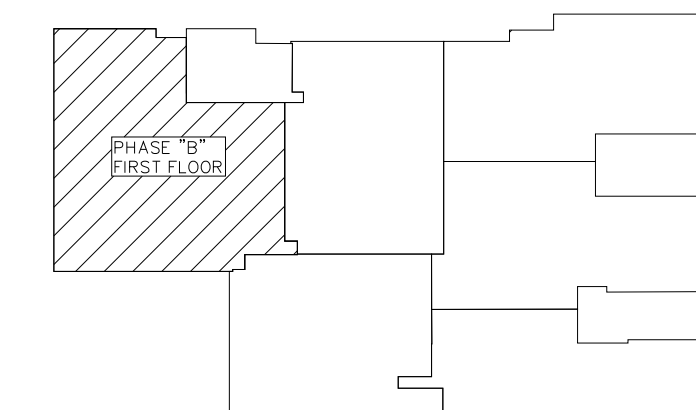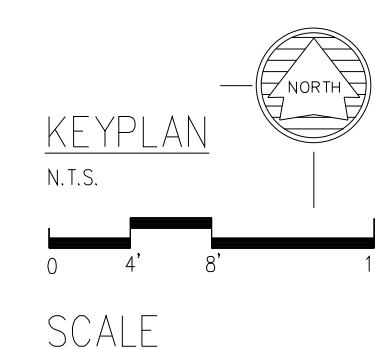

1 AUTOMATIC SPRINKLER SYSTEM INSTALLATION PLAN
SCALE: 1/8" = 1'-0"

PROJECT TITLE REPAIR MEDICAL CENTER PH B LITTLE ROCK AFB, ARKANSAS		SHEET TITLE FIRE PROTECTION AUTOMATIC SPRINKLER INSTALLATION PLAN	
DRAWN BY RJR	LEAD DESIGNER AM	TECH REVIEWER AO	PROJECT NUMBER NKA0 05-8004A
DESIGNED BY AO	SHEET FP1.11		
DATE 1-21-08	26 OF 39		
SCALE 1/8"=1"			