

KEYED PHASING AREA "C"

- 1 BUILDING SHUTDOWN: THE WORK IN AREA "C" PHASING INCLUDES LIMITED BUILDING SHUTDOWNS DUE TO THE BUILDING RENOVATION WORK AND ASSOCIATED MECHANICAL AND ELECTRICAL RENOVATION WORK IN THE FOLLOWING AREAS:

COMM ROOMS F104, F107 AND F108, AND MECH ROOM F108A; COORDINATE BUILDING SHUTDOWN FOR THE REPLACEMENT OF THE MECHANICAL HVAC UNIT SERVING THIS ROOM, INCLUDING THE ELECTRICAL RENOVATION WORK ASSOCIATED WITH PANELBOARD REPLACEMENT.

SERVER ROOM H114; COORDINATE BUILDING SHUTDOWN FOR THE RELOCATION OF THE POWER DISTRIBUTION EQUIPMENT WITHIN THIS ROOM, WHICH SERVES THE SERVER COMPUTER EQUIPMENT THEREIN.

BUILDING SHUTDOWN SCHEDULES SHALL BE COORDINATED WITH AND APPROVED IN WRITING BY THE CONTRACTING OFFICER. THE WORK IN THESE AREAS SHALL BE PERFORMED ON A 24 HOUR/ 7 DAY WORK SCHEDULE IN ORDER TO EXPEDITIOUSLY COMPLETE THE WORK IN THE MINIMUM NUMBER OF DAYS REQUIRED. THE PREFERENCE IS TO COORDINATE THESE SHUTDOWNS WITH OTHER BUILDING RENOVATION WORK SHUTDOWNS, HOLIDAYS, AND WEEKENDS IN ORDER TO MINIMIZE THE IMPACT TO THE BUILDING USERS.





LITTLE ROCK A.F.B.
ARKANSAS

GARVER 1010 Battery St.
Little Rock, AR
72202
501-376-3633
www.GarverUSA.com

CROMWELL
ARCHITECTS ENGINEERS

101 SOUTH SPRING ST
LITTLE ROCK AR 72201
TELEPHONE 501-372-2900
FACSIMILE 501-372-0482

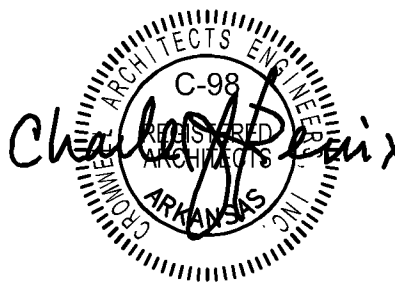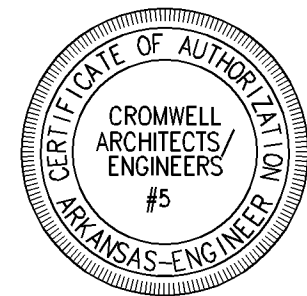

No.	Revision/Issue	Date	BY	APP'D

PROJECT TITLE
REPAIR & RENOVATE MED. CLINIC PH IV A
LITTLE ROCK AIR FORCE BASE
JACKSONVILLE, ARKANSAS

SHEET TITLE
PHASING AREA "C"

DRAWN BY JKL	LEAD DESIGNER K. TAYLOR
TECH REVIEWER JKL	PROJECT NUMBER NKA06-8006 4A
DESIGNED BY JOHN K. LAI	SHEET G-004
DATE 13 MAY 2009	
SCALE	