

MEDICAL FACILITIES  
TASK ORDER 098

RENEWAL PROJECT

RENOVATE CLINIC  
BUILDING 1090  
LITTLE ROCK AFB, ARKANSAS

DACA87-97-D-0037  
TO-098 MFRP 0007C

INDEX OF SHEETS09-04-2003

GENERAL

- G0.00PROJECT LOCATION PLAN

G1.00LIFE SAFETY PLAN

G1.10PHASING PLAN ZONE A AND B

STRUCTURAL

- ~~S0.00STRUCTURAL GENERAL NOTES~~

~~S6.10NEW CANOPIES, FOUNDATION AND FRAMING ALTERNATES 1 AND 2~~

~~S0.01STRUCTURAL DETAILS ALTERNATES 1 AND 2~~

ARCHITECTURAL

- A0.00ARCHITECTURAL SYMBOLS

A0.11DEMOLITION PLAN ZONE A

~~A0.12DEMOLITION PLAN ZONE B~~

A1.11DIMENSION PLAN ZONE A

~~A1.12DIMENSION PLAN ZONE B~~

A2.11REFLECTED CEILING PLAN ZONE A

~~A2.12REFLECTED CEILING PLAN ZONE B~~

A2.13ENLARGED CELING DIMENSION PLANS

A3.11FINISH PLAN ZONE A

~~A3.12FINISH PLAN ZONE B~~

A3.13ENLARGED CARPET PLANS

A3.20INTERIOR FINISH ELEVATIONS

A4.00DOOR SCHEDULE

A4.01DOOR SCHEDULE

~~A4.10FINISH SCHEDULE~~

A4.11FINISH SCHEDULE

A4.12FINISH SCHEDULE

A5.10PARTITION TYPES

A5.11ARCHITECTURAL DETAILS

A5.12ARCHITECTURAL DETAILS

A5.13ARCHITECTURAL DETAILS

A5.20CEILING DETAILS

~~A5.21ROOM SECTIONS~~

A5.22ROOM SECTIONS

~~A5.30SOUTH WALL~~

A5.31SOUTH WALL WINDOW REPLACEMENT ALTERNATE 5

~~A5.40CANOPY DETAILS ALTERNATE 1 AND 2~~

A5.50DOORS, FRAMES, BUCK TYPES

~~A5.60MILLWORK WALLS~~

A6.00ENLARGED RECEPTION AREA PLANS

~~A6.10NEW CANOPY PLANS ALTERNATES 1 AND 2~~

~~A0.00CANOPY ELEVATIONS, DEMOLITION AND NEW WORK ALTERNATES 1 AND 2~~

~~A0.01CANOPY SECTIONS AND DETAILS ALTERNATE 1~~

~~A0.02CANOPY SECTIONS AND DETAILS ALTERNATE 2~~

EQUIPMENT

- Q0.00TYPICAL MOUNTING HEIGHTS

Q1.11EQUIPMENT PLAN ZONE A

~~Q1.12EQUIPMENT PLAN ZONE B~~

Q4.00EQUIPMENT SCHEDULE

Q4.01EQUIPMENT SCHEDULE

Q5.00MILLWORK SECTIONS

Q5.60RECEPTION COUNTER MILLWORK SECTIONS

Q6.00ENLARGED RECEPTION COUNTER PLANS

Q6.01ENLARGED TOILET ROOM PLANS

Q6.02ENLARGED COUNTERTOP PLANS

Q8.20INTERIOR ELEVATIONS

Q8.21INTERIOR ELEVATIONS

Q8.22TOILET ROOM ELEVATIONS


Q8.23RECEPTION COUNTER ELEVATIONS

Q8.24RECEPTION COUNTER ELEVATIONS

FURNITURE (FOR INFORMATION ONLY)  
(NOT IN CONTRACT)

- F1.11FURNITURE PLAN ZONE A

~~F1.12FURNITURE PLAN ZONE B~~

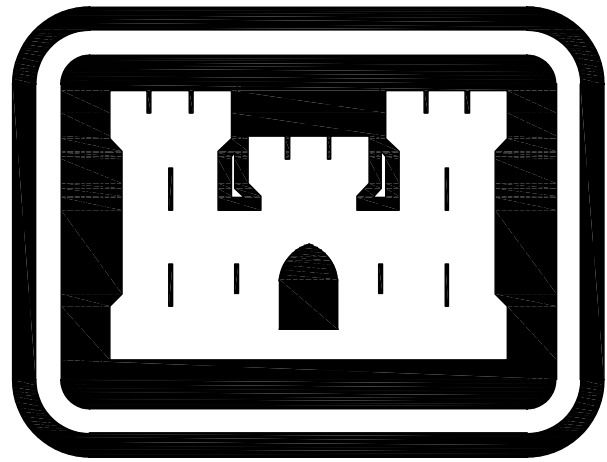

US Army Corps  
of Engineers  
Huntsville  
Alabama

MECHANICAL

- M0.00ABBREVIATION, SYMBOLS & GENERAL NOTES

M0.11LEVEL ONE ZONE A HVAC DEMOLITION PLAN

~~M0.12LEVEL ONE ZONE B HVAC DEMOLITION PLAN~~

~~M0.13ROOF ZONE A & B HVAC DEMOLITION PLAN~~

M1.10MECHANICAL PHASING PLAN

M1.11LEVEL ONE ZONE A HVAC PLAN

~~M1.12LEVEL ONE ZONE B HVAC PLAN~~

M1.13LEVEL ONE ZONE A RETURN AIR DUCT PLAN

M2.11ZONE A REHEAT COILS PIPING PLAN

M3.11LEVEL ONE ZONE A HVAC EQUIPMENT ROOF PLAN

M3.12PENTHOUSE ENLARGED PLAN

M4.11HVAC DETAILS

M4.12HVAC DETAILS

M4.13HVAC DETAILS

M6.11HVAC SCHEDULES

M6.12LOAD DATA SUMMARY SCHEDULES

M6.13LOAD DATA SUMMARY SCHEDULES

M7.11ZONE A CONTROL DIAGRAM / SEQUENCE OF OPERATIONS

PLUMBING

- P0.00ABBREVIATIONS, SYMBOLS, GENERAL NOTES & FIXTURE SCHEDULES

P0.11ZONE A DEMOLITION PLAN

~~P0.12ZONE B DEMOLITION PLAN~~

P1.11ZONE A WASTE & VENT PLAN

~~P1.12ZONE B WASTE & VENT PLAN~~

P1.13ZONE A & B WASTE AND VENT RISER DIAGRAMS

P1.14ZONE A WATER PIPING PLAN

~~P1.15ZONE B WATER PIPING PLAN~~

P1.16ZONE A & B WATER RISER DIAGRAM

P1.17ZONE A & B DETAILS

P2.11ZONE A MEDICAL GAS PLAN

~~P2.12ZONE B MEDICAL GAS PLAN~~

FIRE PROTECTION

- FP0.00FIRE PROTECTION LEGEND, SCHEDULES, AND DETAILS

~~FP0.11ZONE A FIRE PROTECTION DEMOLITION PLAN~~

~~FP0.12ZONE A FIRE PROTECTION DEMOLITION PLAN~~

~~FP0.13ZONE B FIRE PROTECTION DEMOLITION PLAN~~

~~FP0.14ZONE B FIRE PROTECTION DEMOLITION PLAN~~

FP1.00FIRE PROTECTION PLAN

Fire ProtAS-BUILT FIRE PROTECTION PLAN

ELECTRICAL

- E0.00ABBREVIATION, SYMBOLS, & GENERAL NOTES

E0.11LEVEL ONE ZONE A LIGHTING DEMOLITION PLAN

~~E0.12LEVEL ONE ZONE B LIGHTING DEMOLITION PLAN~~

E0.21LEVEL ONE ZONE A POWER DEMOLITION PLAN

~~E0.22LEVEL ONE ZONE B POWER DEMOLITION PLAN~~

E0.31LEVEL ONE ZONE A SYSTEMS DEMOLITION PLAN

~~E0.32LEVEL ONE ZONE B SYSTEMS DEMOLITION PLAN~~

E1.11LEVEL ONE ZONE A LIGHTING PLAN

~~E1.12LEVEL ONE ZONE B LIGHTING PLAN~~

E1.20ELECTRICAL PHASING AND POWER PLAN

E1.21LEVEL ONE ZONE A POWER PLAN

~~E1.22LEVEL ONE ZONE B POWER PLAN~~

E1.23PARTIAL AREA ELECTRICAL PLANS

E1.24ZONE A HVAC POWER PLAN

E1.31LEVEL ONE ZONE A SYSTEMS PLAN

~~E1.32LEVEL ONE ZONE B SYSTEMS PLAN~~

E2.01SINGLE LINE DIAGRAM

E2.02FIRE ALARM RISER DIAGRAM

~~E2.03FIRE ALARM RISER DIAGRAM~~

E3.11LIGHTING SCHEDULES AND DETAILS

E3.12DETAILS

E4.01ELECTRICAL SCHEDULES

AS BUILT SET  
6/30/2005



3121 Butterfield Rd. - Oak Brook, IL. 60523 - (603) 574-2006



Architecture  
Engineering  
Planning  
HLM Design USA, Inc.  
Suite 500  
125 South Dubuque Street  
Iowa City, Iowa 52240-4003  
319.354.7813