

DOOR SCHEDULE

DOOR NUMBER PER SCHEDULE.
SEE DOOR SCHEDULE & ELEVATIONS

WINDOW SCHEDULE

WINDOW PER ELEVATIONS

DRAWING TITLE SYMBOL

DETAIL NUMBER

SCALE

SHEET NUMBER WHERE DRAWN
SHEET NUMBER WHERE CUT
(IF APPLICABLE)

SHEET DRAWN ON
SHEET CUT ON

AREA DETAILED

DETAIL SYMBOL

DETAIL NUMBER

DIRECTION DETAIL CUT

SHEET NUMBER WHERE DRAWN
SHEET NUMBER WHERE CUT

MATCH LINE

ELEVATION DATUM ABOVE FINISH FLOOR

ROOM NUMBER SYMBOL

ROOM NUMBER ON PLAN

BUILDING / INTERIOR ELEVATION SYMBOL

ELEVATION NUMBER

SHEET NUMBER WHERE DRAWN
SHEET NUMBER WHERE CUT

BUILDING / WALL SECTION SYMBOL


SECTION NUMBER

SHEET NUMBER WHERE DRAWN
SHEET NUMBER WHERE CUT


REVISION INDICATION

REVISION NO.

GENERAL AREA OR
DETAIL INCLUDED ON
LATEST REVISION

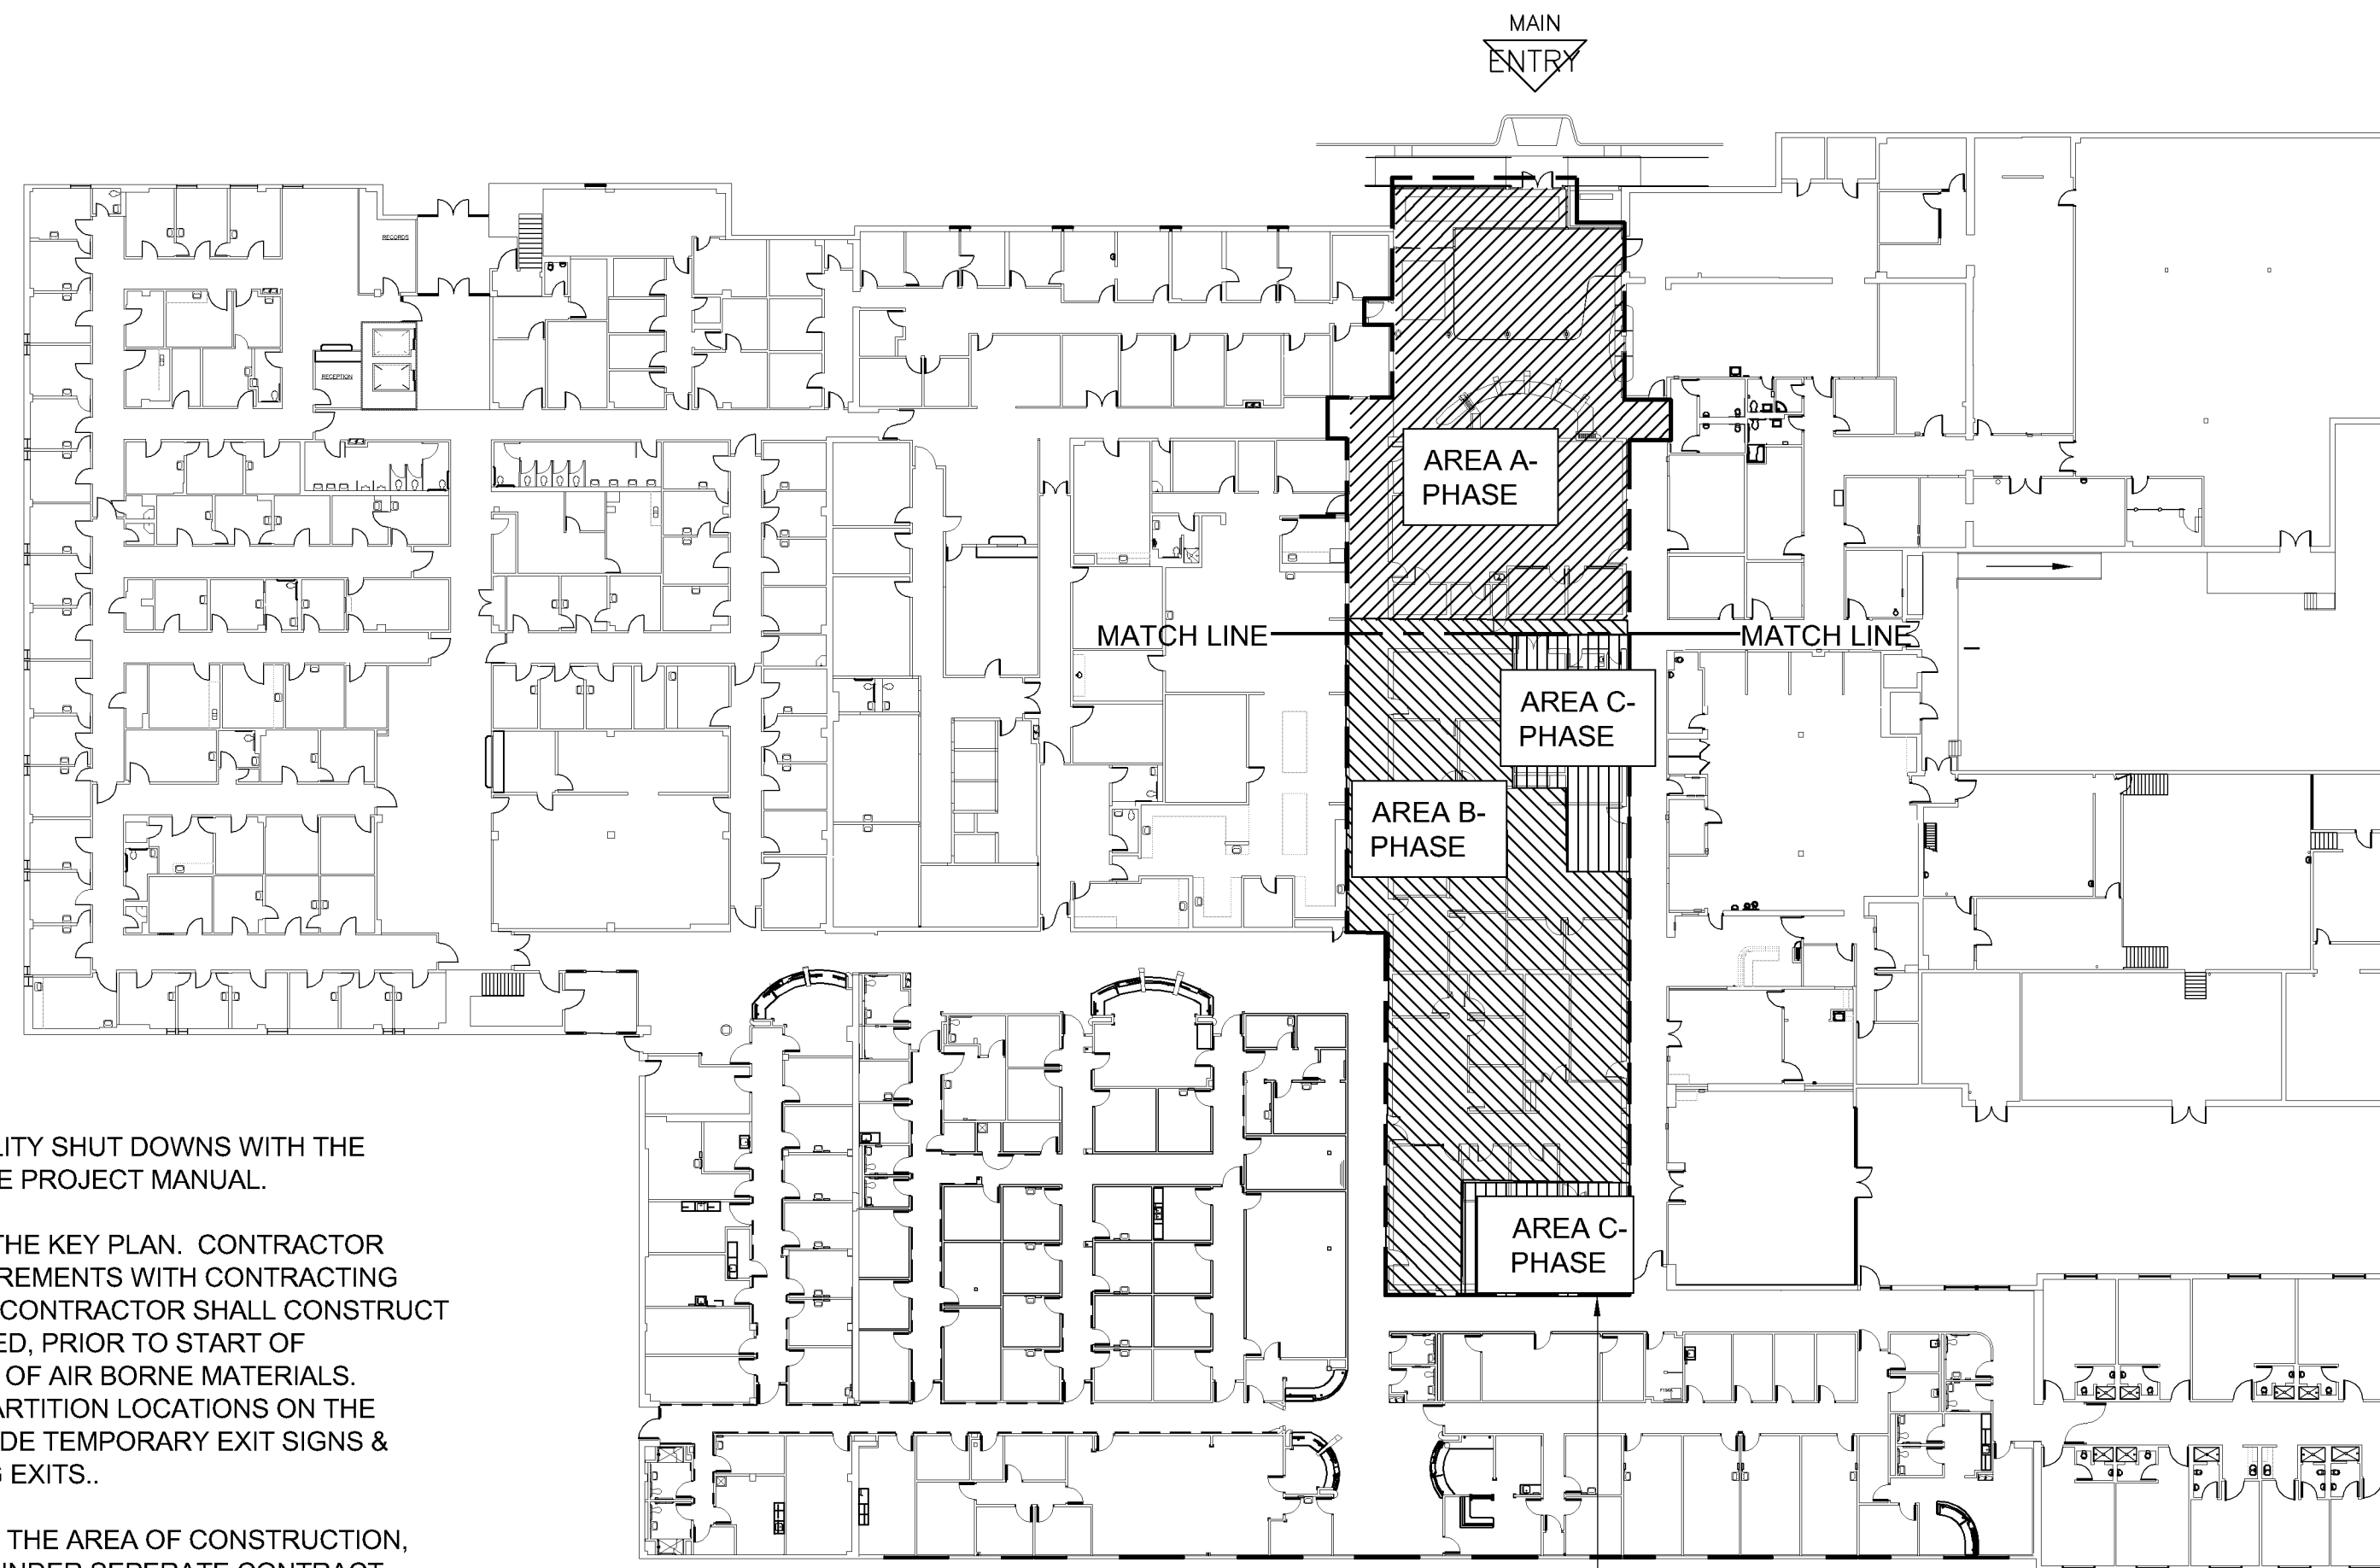





KEY PLAN



CODE STUDY

A.C.	AIR	C.M.U.	CONCRETE MASONRY UNIT	F	I	N	RCP	REFLECTED CEILING PLAN	T				
A.C.T.	ACOUSTIC	C.O.	CLEAN OUT	F.A.	FIRE ALARM	I.D.	INSIDE DIAMETER	N.A.	NOT APPLICABLE	RD	ROUND	T.	TOILET
A.D.	AREA DRAIN	COL.	COLUMN	F.C.	FLEXIBLE CONNECTION	I.E.	INVERT	N.I.C.	NOT IN CONTRACT	RD	RECESSED	T.	TELEPHONE
A.F.F.	ABOVE FINISHED FLOOR	CONC.	CONCRETE	F.D.	FLOOR DRAIN	IN.	INCHES	NO.	NUMBER	RECIRC.	RECIRCULATING	TEMP.	TEMPERATURE
A.H.U.	AIR HANDLING UNIT	CONN.	CONNECTION	F.E.C.	FIRE EXTINGUISHER CABINET	INCAND.	INCANDESCENT			RECIP.	REGISTER	THK.	THICKNESS
ALT.	ALTERNATE	CONST.	CONSTRUCTION	FIN.	FINISH	INSUL.	INSULATION	O		REG.	REGISTER	THD.	THRESHOLD
ALUM.	ALUMINUM	CONT.	CONTINUOUS	FT.	FOOT/FEET	INT.	INTERIOR	O.A.	OUTDOOR AIR	REINF.	REINFORCING	TOIL.	TOILET
AMP., A.	AMPERES	CONTR. JT.	CONTRACTION JOINT	FTG.	FOOTING	J		O.C.	ON CENTER	REQ.	REQUIRED	TYP.	TYPICAL
A.O.	ACCESS OPENING	C.T.	CERAMIC TILE	G		J.B.	JUNCTION BOX	O.D.	OUTSIDE DIAMETER	RET.	RETURN	V	
APPROX.	APPROXIMATELY	C.T.B.	CERAMIC TILE BASE	GA.	GAGE	JCT.	JUNCTION	O.H.	OVERHEAD	R.G.	RETURN GRILLE		
ARCH.	ARCHITECTURAL	C. TO C.	CENTER TO CENTER	GAL	GALLON	JT.	JOINT	OL	OVERLOAD	RM.	ROOM	V.	VOLT
A.T.	ASPHALT TILE			GALV.	GALVANIZED	K		OPNG.	OPENING	R.P.M.	REVOLUTION/MINUTE	VCT	VINYL COMPOSITION TILE
B		D		G.F.C.I.	GOVERNMENT FURNISHED	KVA	KILOVOLT AMPERE	OPP.	OPPOSITE	S		VENT.	VENTILATION
BAL.	BALANCE	D.F.	DRINKING FOUNTAIN		CONTRACTOR INSTALLED	KW	KILOWATT	O.S.	OVERFLOW SCUPPER			VERT.	VERTICAL
BD.	BOARD	DTL.	DETAIL	G.F.G.I.	GOVERNMENT FURNISHED	L		O.S.D.	OPEN SIGHT DRAIN	P		V.I.F.	VERIFY IN FIELD
BLDG.	BUILDING	DIA.	DIAMETER		GOVERNMENT INSTALLED	LAV	LAVATORY	PART.	PARTITION	S.A.	SUPPLY AIR	VTR	VENT THRU ROOF
BLK.	BLANK	DIFF.	DIFFUSER		GOVERNMENT INSTALLED	L		PER.	PERIMETER	SCH.	SCHEDULE	V.W.C.	VINYL WALL COVERING
BM.	BEAM	DIM.	DIMENSION	GL.	GLASS	LB. #	POUND	PL	PLATE	SERV.	SERVICE		
BOT.	BOTTOM	DISC.	DISCONNECT	GND.	GROUND	LG.	LONG	PLBG.	PLUMBING	SHT.	SHEET	W	
BRG.	BEARING	D.J.	DUMMY JOINT	GOVT	GOVERNMENT	L.P.	LIGHTING PANEL	PLYWD	PLYWOOD	S.J.	SLIP JOINT	W.	WATT
B.T.U.H.	BRITISH THERMAL UNIT/HR.	DN.	DOWN	G.P.H.	GALLONS/HR.	G.P.M.	GALLONS/MIN.	PNL.	PANEL	SPEC.	SPECIFICATIONS	W/	WITH
C		DR.	DRAIN	G.W.B.	GYPSON WALL BOARD	M		PRESS.	PRESSURE	SG. FT.	SQUARE FEET	W.C.	WATER CLOSET
CAB.	CABINET	D.S.	DOWNSPOUT	GYP.	GYPSON	M.		PSF	POUNDS/SQUARE FOOT	ST.	STEEL	WD.	WOOD
CAP.	CAPACITY	DWG.(S)	DRAWING(S)	H		MAINT.	MOTOR	PSI	POUNDS/SQUARE INCH	STOR.	STORAGE	W.D.	WINDOW DIMENSION
C/B	CIRCUIT BREAKER	E		H.	HIGH	MAX.	MAXIMUM	PSIG	POUNDS/SQUARE INCH GAGE	STRUC.	STRUCTURAL	WF	WIDE FLANGE
C.D.	CEILING DIFFUSER	(E).	EXISTING	H.B.	HOSE BIBB	M.D.P.	MAIN DISTRIBUTION PANEL	PT.	POINT	SUSP.	SUSPENDED	W.G.	WATER GAGE
CEM.	CEMENT	EA.	EACH	H.C.	HOLLOW CORE	MECH.	MECHANICAL	P.T.	PORCELAIN TILE	SW.	SWITCH	WP.	WEATHERPROOF
CER.	CERAMIC	E.C.	EMPTY CONDUIT	HGT.	HEIGHT	MTL.	METAL	PTD.	PAINTED			WTR	WATER
C.F.M.	CUBIC FEET/MINUTE	E.F.	EXHAUST FAN	H.M.	HOLLOW METAL	MIN.	MINIMUM	Q				W.W.F.	WELDED WIRE FABRIC
CIRC.	CIRCULATING	EL.	ELEVATION	H.P.	HORSE POWER	MISC.	MISCELLANEOUS	QTR.	QUARTER				
C.J.	CONTROL JOINT	ELEC.	ELECTRIC	HR.	HOUR	M.O.	MASONRY OPENING	QUAN.	QUANTITY				
CK'D	CHECKERED	EQUIP.	EQUIPMENT	HTG.	HEATING	M.T.	METAL THRESHOLD	R					
CKT.	CIRCUIT	E.W.C.	ELECTRIC WATER COOLER	HTR.	HEATER	MTD.	MOUNTED						
Q	CENTER LINE	EXH.	EXHAUST	H. & V.	HEATING & VENTILATING	M.V.	MOUNTING	R.	RISER				
CLG.	CEILING	EXP. JT.	EXPANSION JOINT	HDW.	HARDWARE	M.G.T.	MECHANICAL VENTILATION	R.A.	RETURN AIR				
CL.	CLOSE	EXT.	EXTERIOR	HYD.	HYDRANT		MATT GLAZE TILE	RAD.	RADIUS				

FIRE EXTINGUISHERS MAX TRAVEL DISTANCE: 75' APART

									
LITTLE ROCK A.F.B. ARKANSAS									
				1010 Battery St. Little Rock, AR 72202 501-376-3633 www.GarverUSA.com					
CROMWELL ARCHITECTS ENGINEERS 101 SOUTH SPRING ST LITTLE ROCK AR 72201 TELEPHONE 501-372-2900 FACSIMILE 501-372-0482									
 									
									APP'D
									BY
									Date
									Revision/Issue
									No.
PROJECT TITLE REPAIR & RENOVATE MED. CLINIC PH IV A LITTLE ROCK AIR FORCE BASE JACKSONVILLE, ARKANSAS					SHEET TITLE KEY PLAN, CODE STUDY & SYMBOLS & ABBREVIATIONS				
DRAWN BY JKL					LEAD DESIGNER K. TAYLOR				
TECH REVIEWER JKL					PROJECT NUMBER NKAK 06-8006 4A				
DESIGNED BY JOHN K. LAI					SHEET G-002				
DATE 13 MAY 2009									
SCALE					2 of 51				