





1. FURNITURE FOR INFORMATION ONLY.  
NOT PART OF THIS CONTRACT.

[illegible]REPAIR MEDICAL CENTER PH 3  
LITTLE ROCK AFB, ARKANSAS

# FURNITURE PLAN

PROJECT TITLE	REP LIT	SHEET TITLE	
DRAWN BY	GP	LEAD DESIGNER	AM
TECH REVIEWER	GP	PROJECT NUMBER	NKAK 06-8001
DESIGNED BY	GP	SHEET	F1.11
DATE	8-11-06		
SCALE	1/8" = 1'-0"		18 or 37

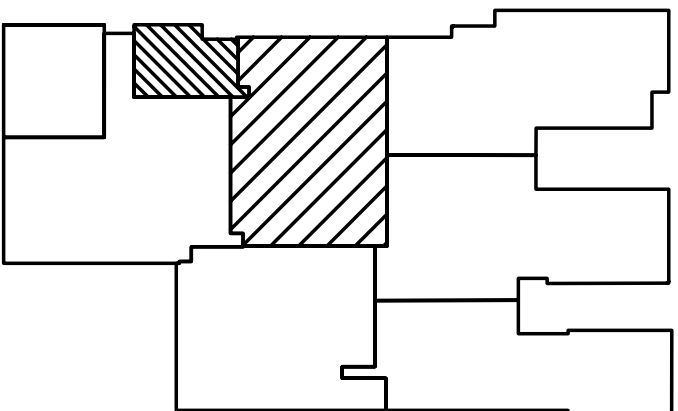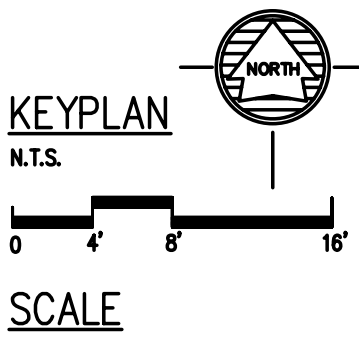

## AS BUILTS