

REVISIONS	DATE	DESCRIPTION	BY	APP'D
1	8/07/2005	REVISED FOR BID		
2	10/07/2003	AS-BUILT		















DESIGNED BY: DATE: 10/10/2003	PROJECT NO: 61503	DRAWING CODE: 61503	REVIEWED BY: SOLICITATION NUMBER: 61503
DRAWN BY: 61503	CHECKED BY: 61503	REVIEWED BY: 61503	REVIEWED BY: 61503

U.S. ARMY ENGINEERING AND SUPPORT CENTER
CORPS OF ENGINEERS
HUNTSVILLE, ALABAMA

RENOVATE CLINIC
BUILDING 1090
LITTLE ROCK AFB, ARKANSAS

ENLARGED COUNTERTOP
PLANS
AS-BUILT

SHEET
REFERENCE
NUMBER:
Q6.02
SHEET X OF XX

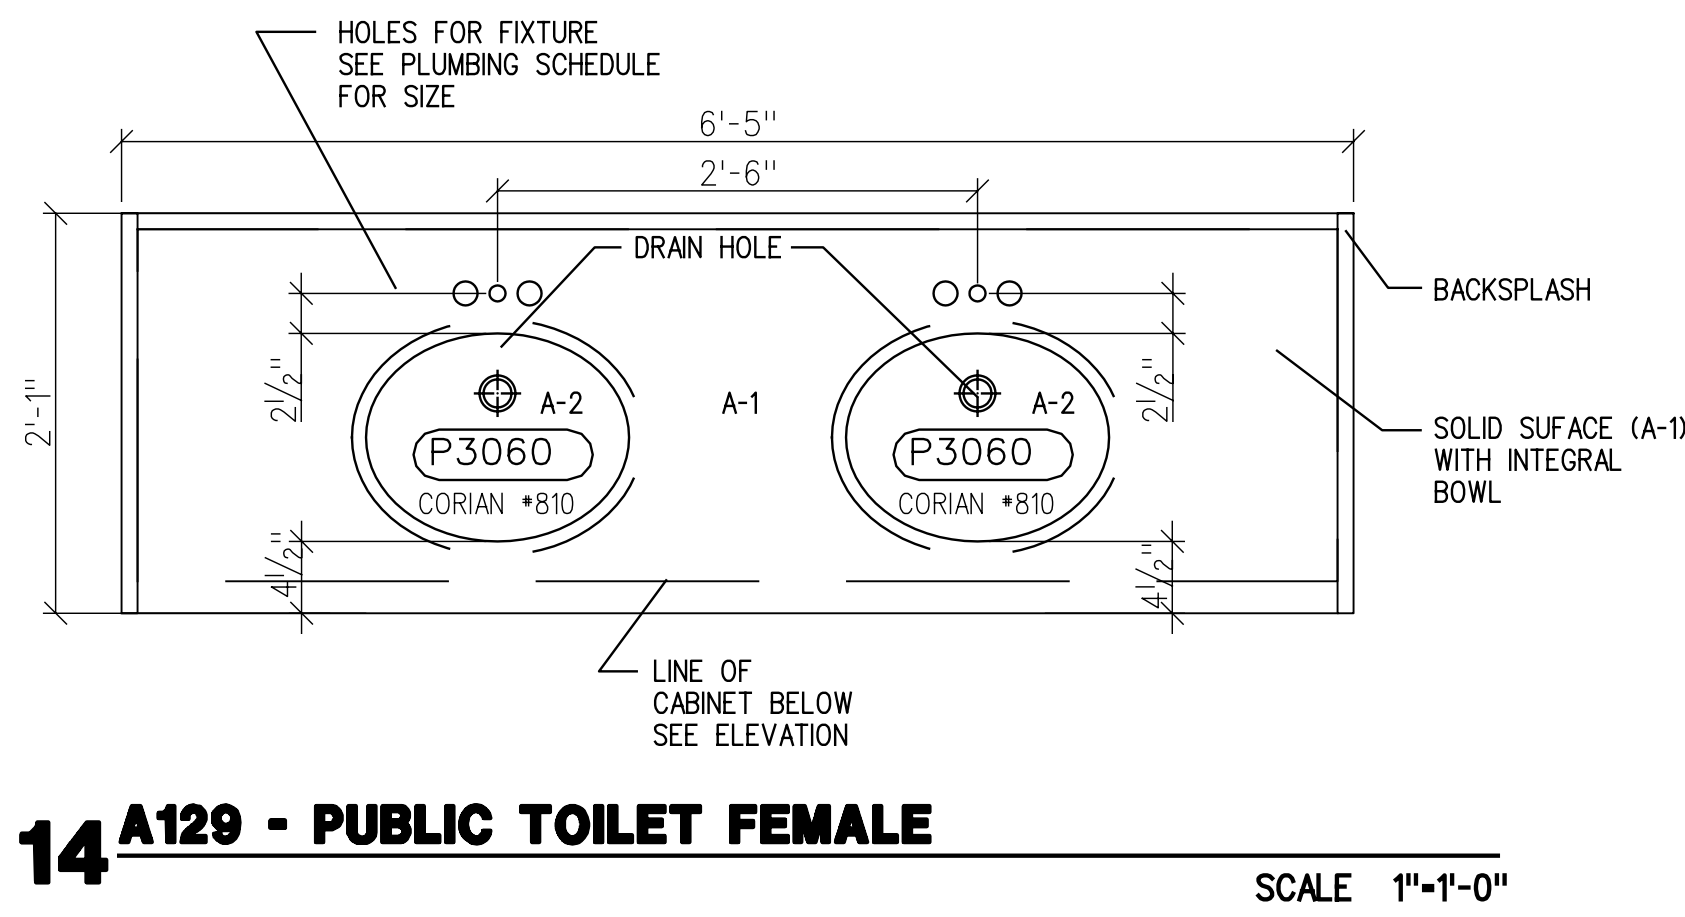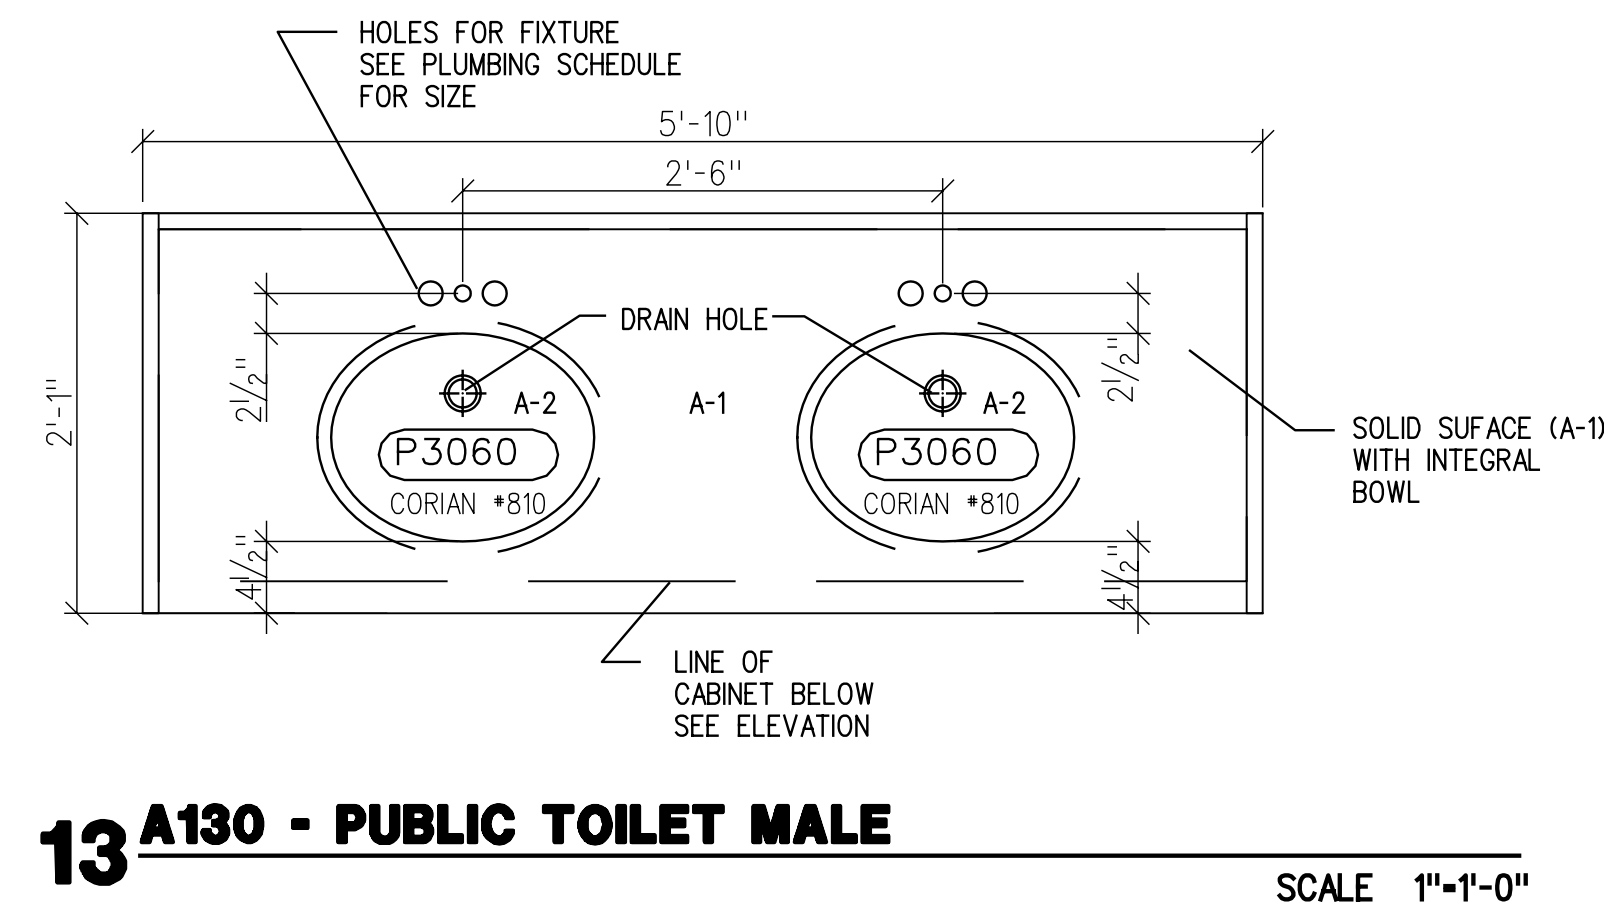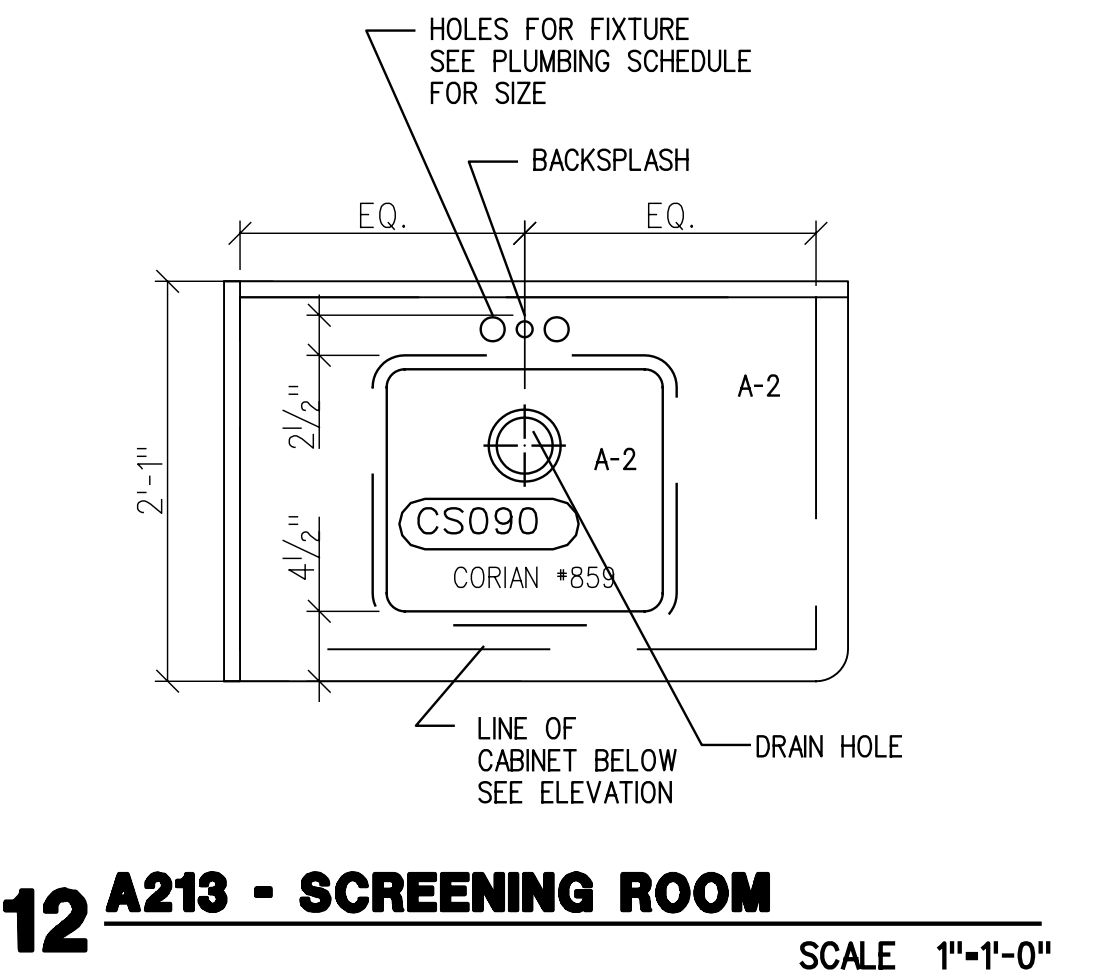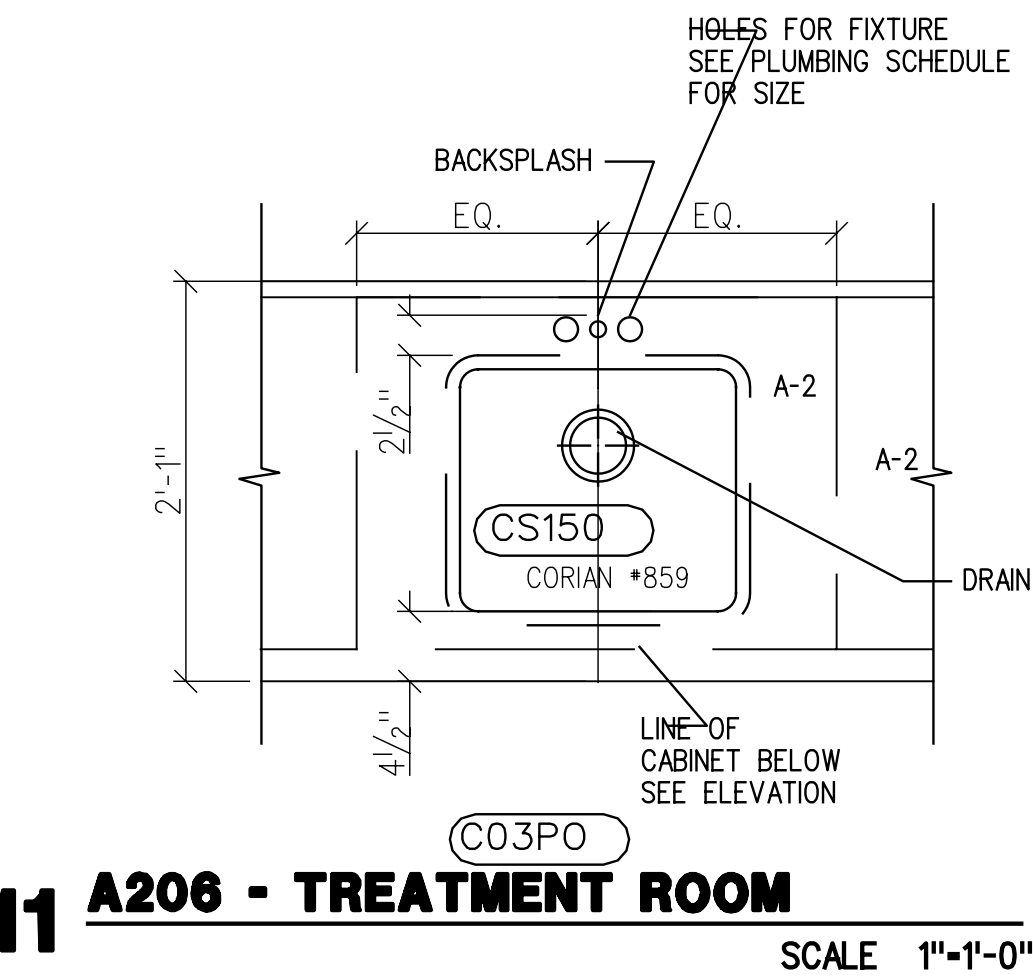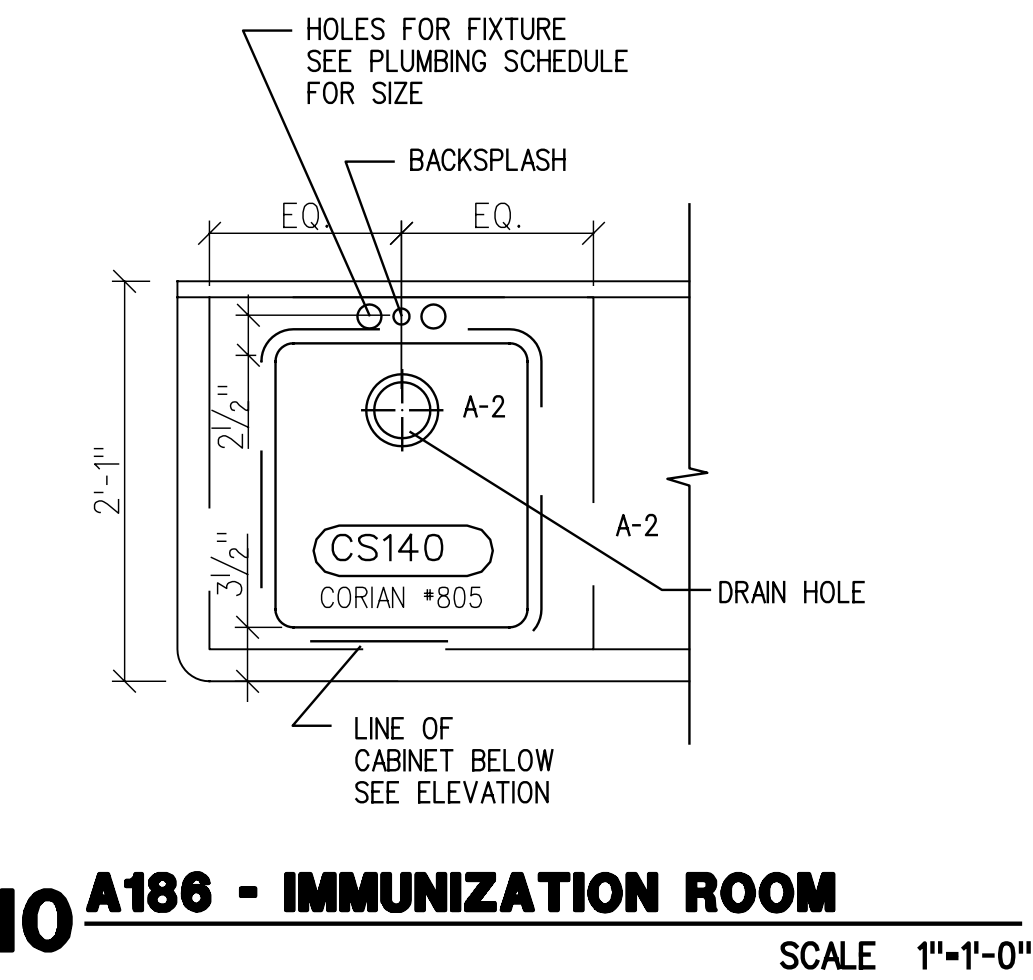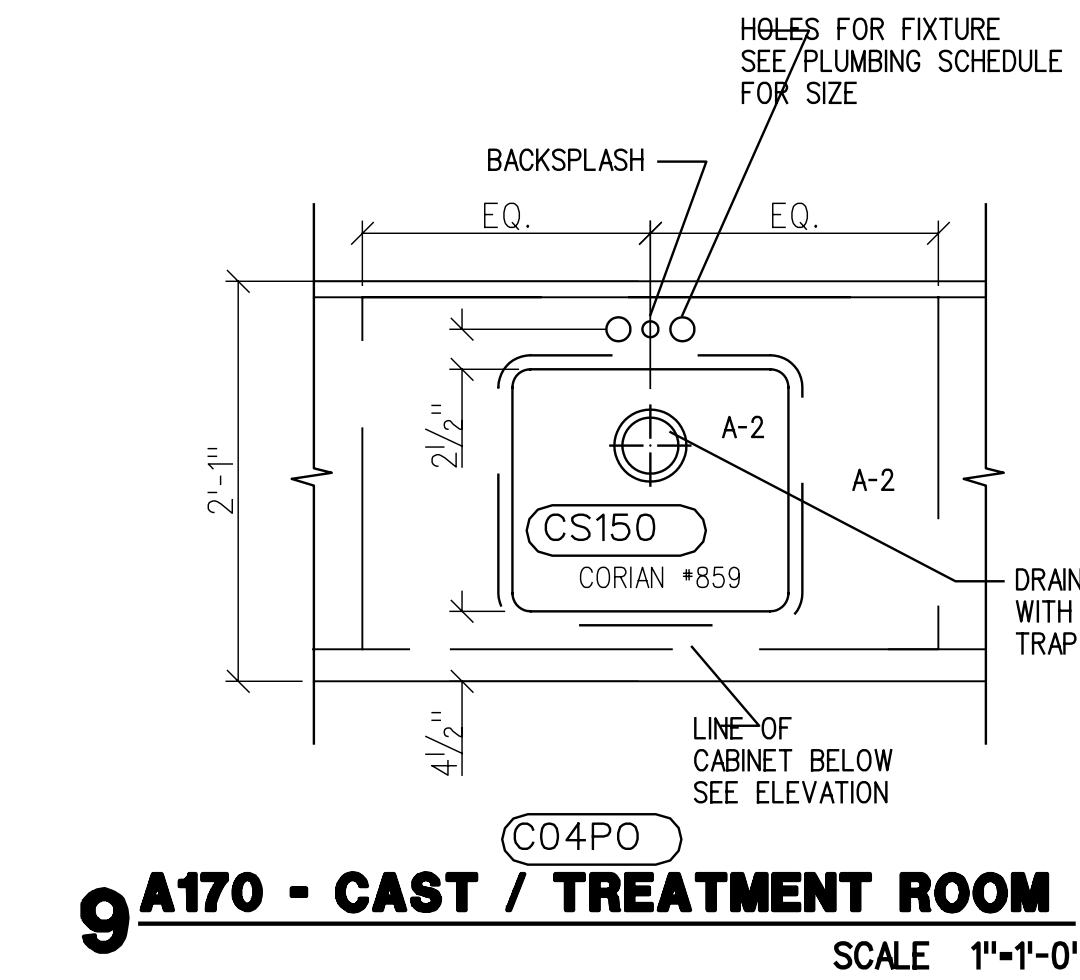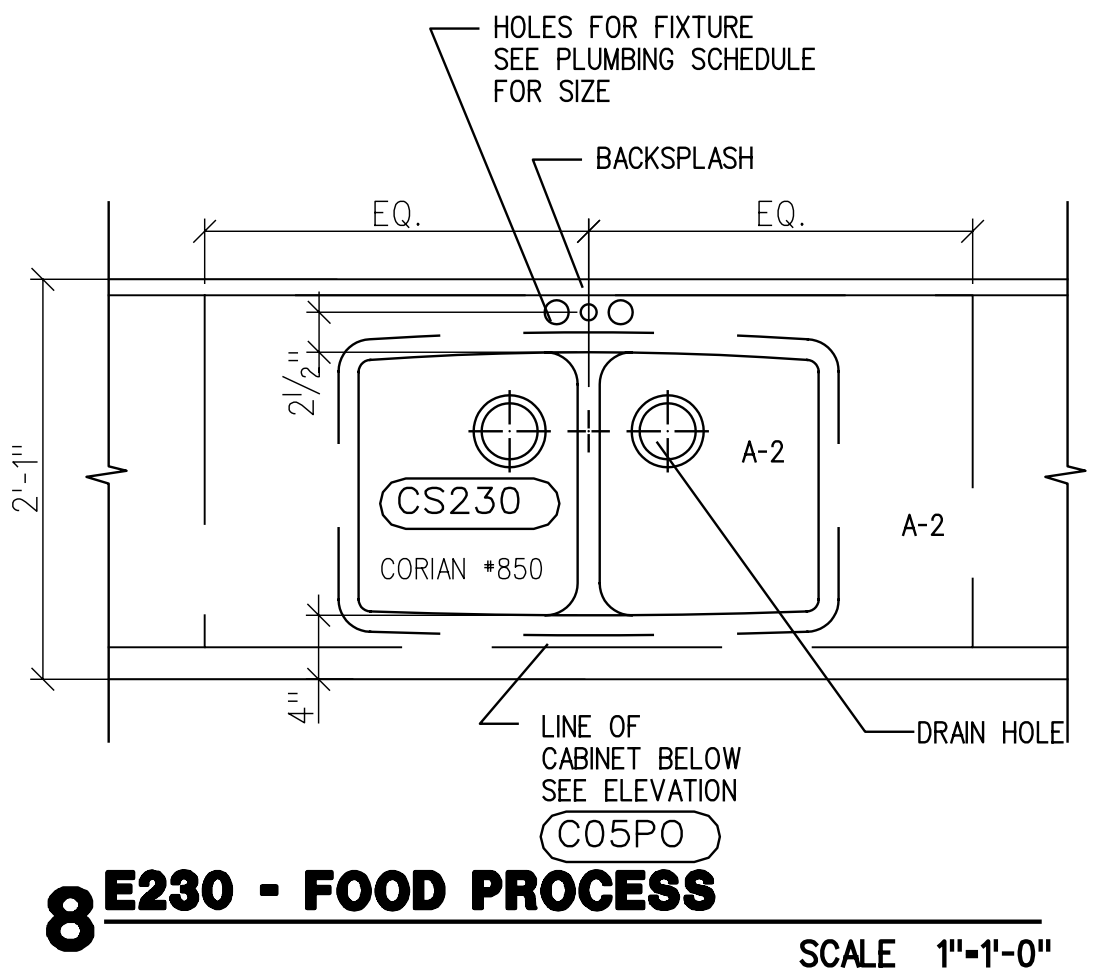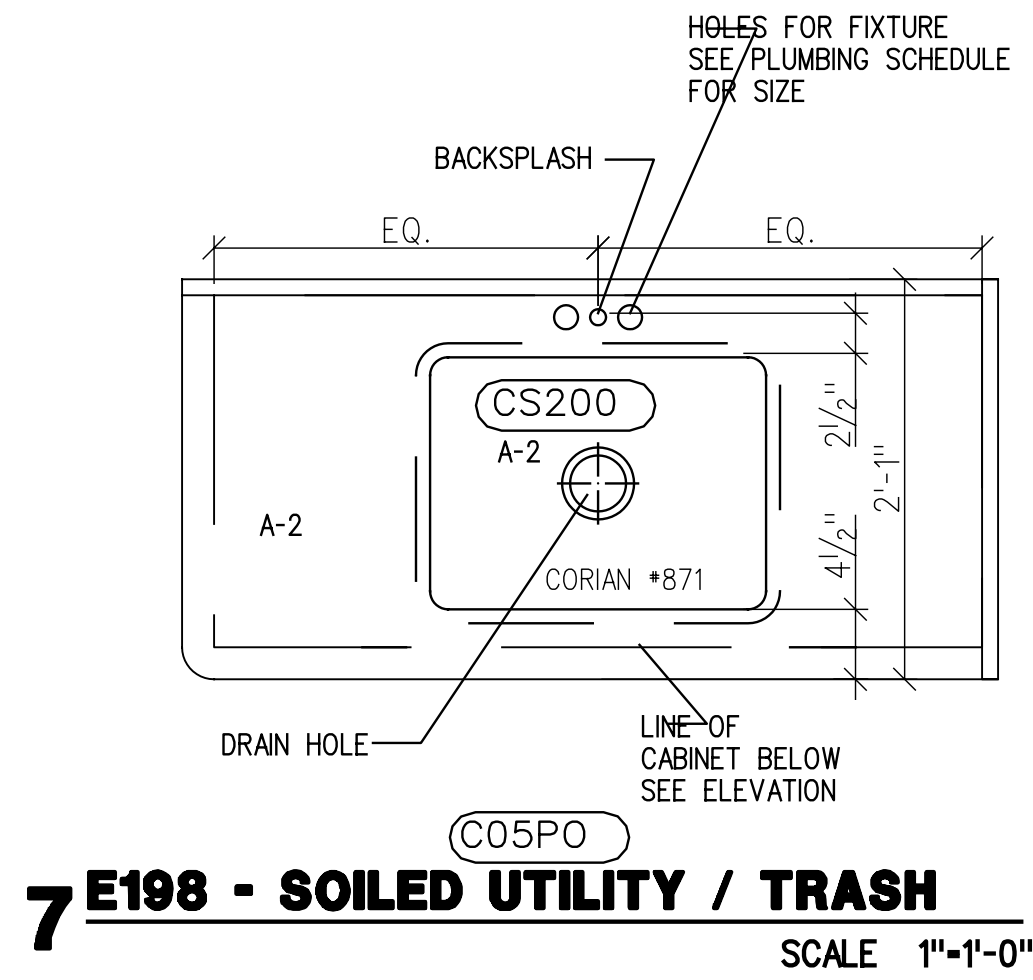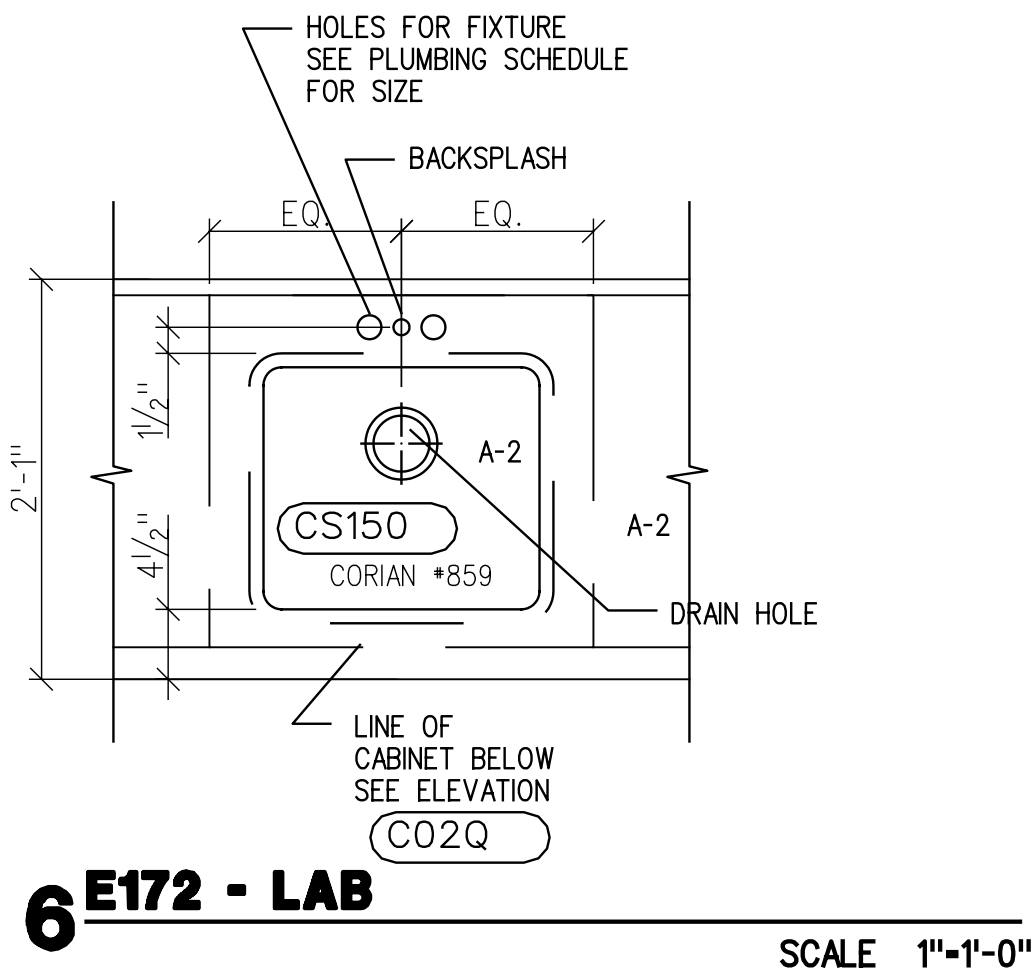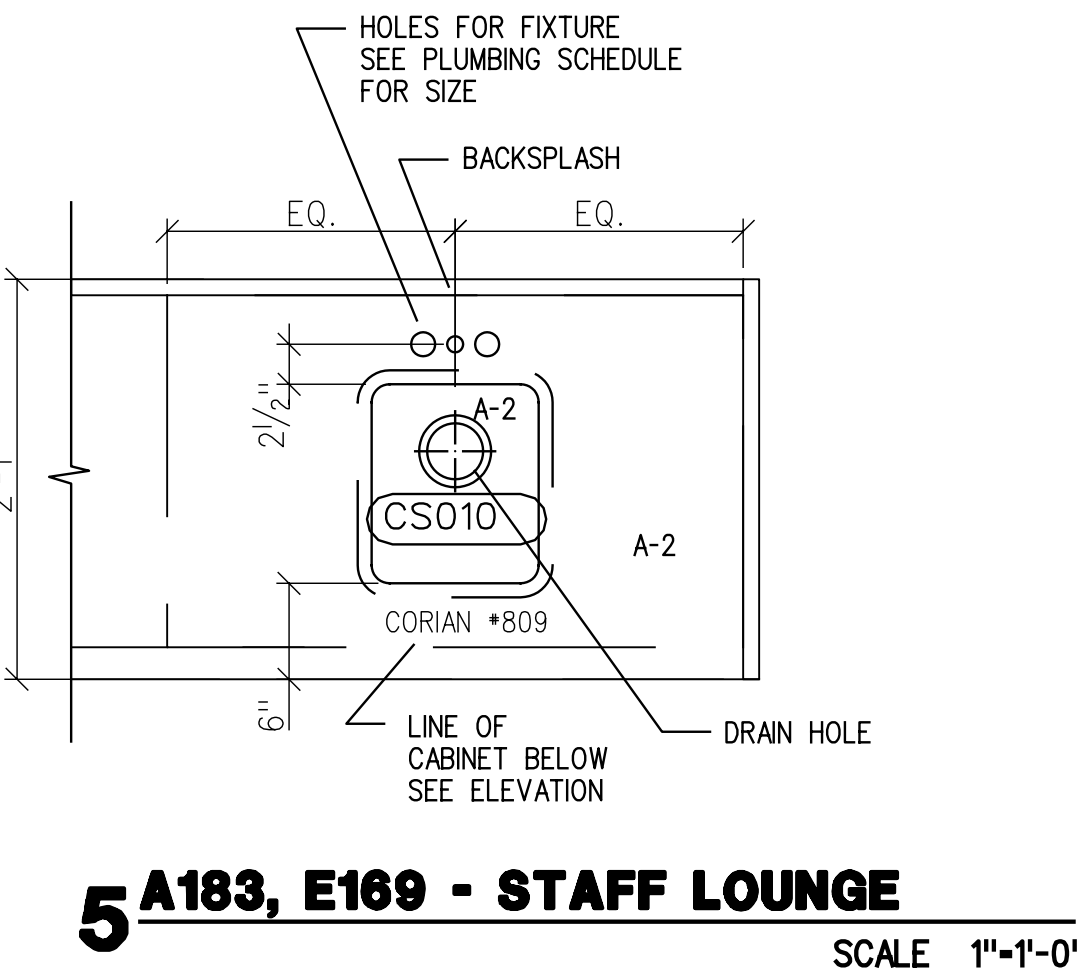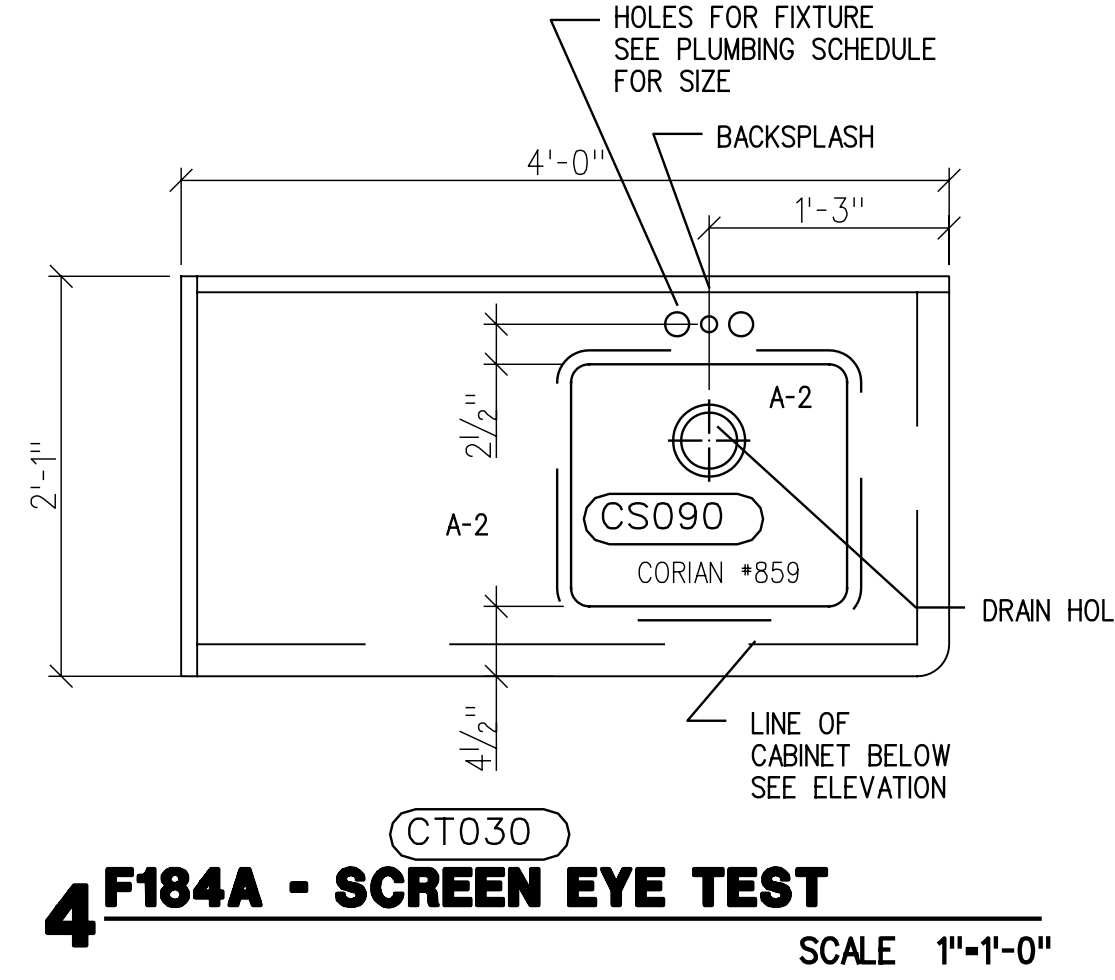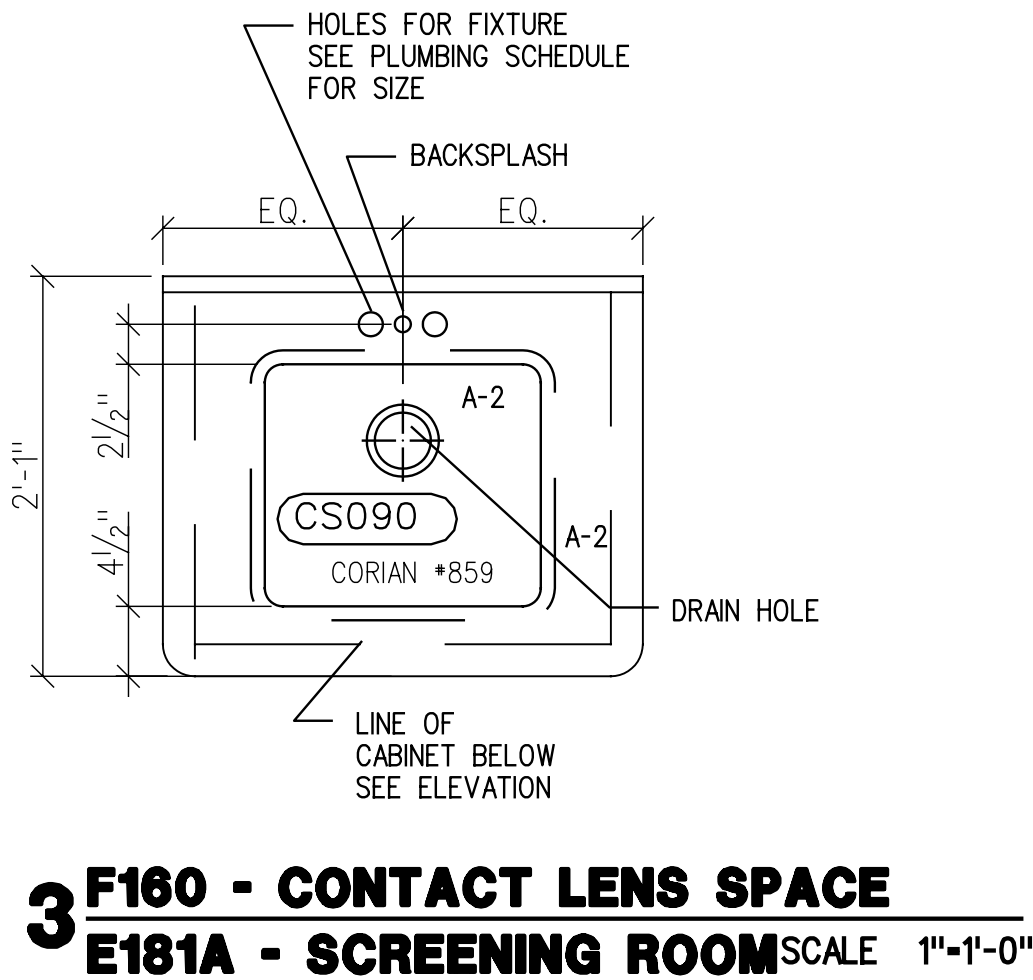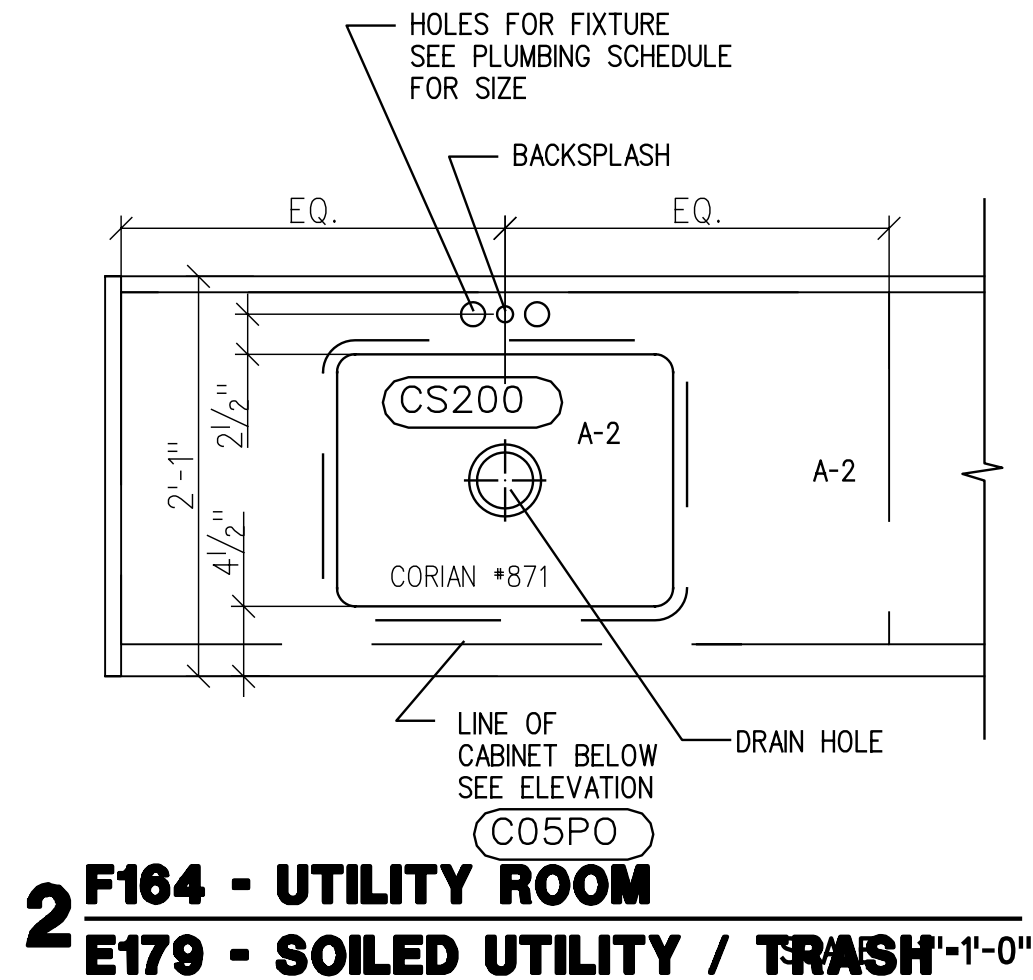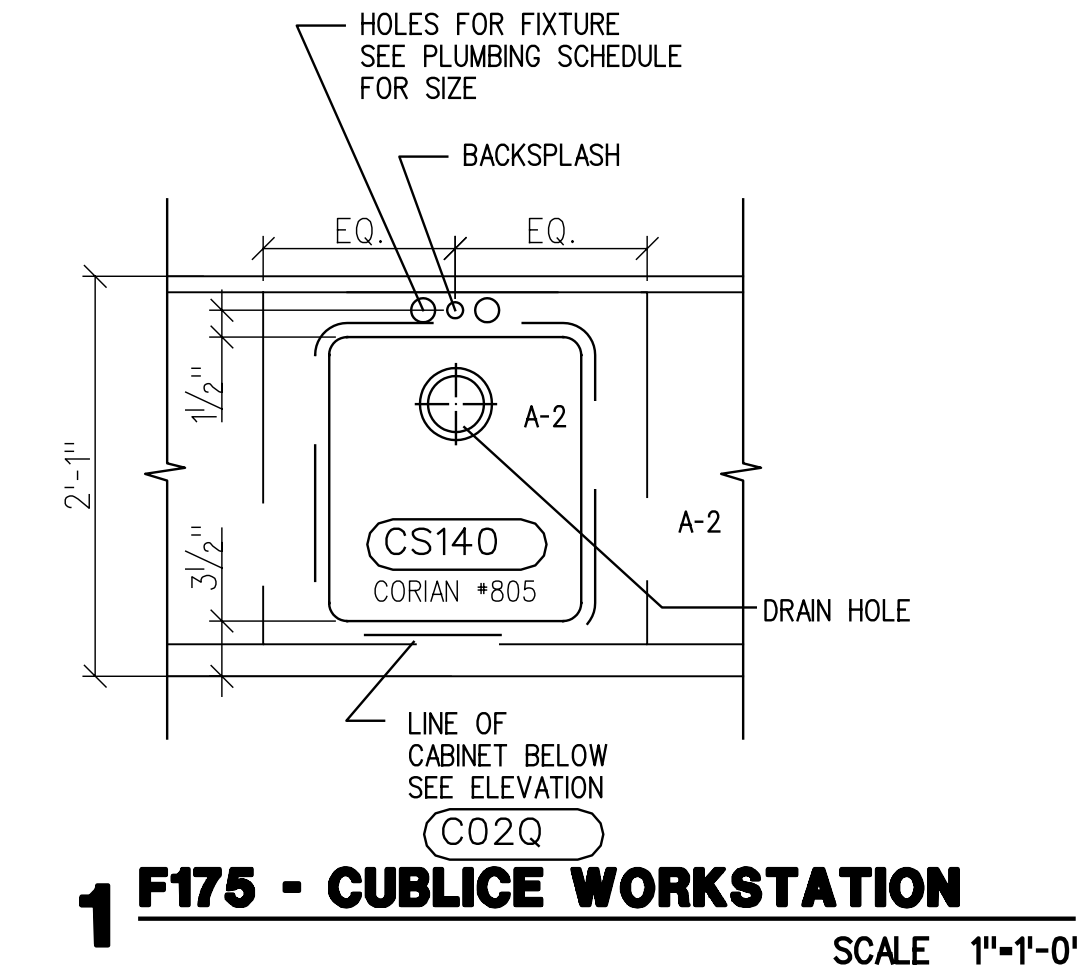

NOTES:

- SINKS AND BASE CABINETRY ARE LABELED WITH EQUIPMENT NUMBERS. SEE EQUIPMENT SCHEDULE Q4.00 AND Q4.01 FOR FURTHER INFORMATION.
- COUNTERTOPS ARE TO BE SOLID SURFACE A-1 WITH INTEGRAL TO BE A-2 COUNTERTOPS W/A-2 INTEGRAL SINKS.