


PLUMBING FIXTURE SCHEDULE								
MARK	DESCRIPTION	MFGR. & MODEL	ACCESSORIES, FAUCETS & FITTINGS	TRAP	WASTE	COLD	HOT	REMARKS
P-1	ADA WALL HUNG LAVATORY	AM STANDARD 0356.XXX	PROVIDE WITH CHICAGO 404-317SW LAVATORY FAUCET WITH WRIST BLADE HANDLES, AERATOR, McGUIRE PROWRAP PW2125WC WITH 8872 P-TRAP AND McGUIRE 155WC OFFSET GRID STRAINER AND TAILPIECE, McGUIRE 2166 WHEEL HANDLE ANGLE SUPPLY STOPS. VERIFY EXISTING CONDITIONS AND PROVIDE CONCEALED ARMS STYLE OR PROVIDE WALL HANGER STYLE WITH ADDITIONAL BACKERBOARDS AT WALL HANGER BRACKET BETWEEN METAL STUDS FOR WALL HANGER PLATE.	1 1/4"	2"	1/2"	1/2"	MOUNT TOP OF RIM AT 34" AFF. INSTALL SUPPLY COVERS FURNISHED WITH PROWRAP ON HOT AND COLD WATER SUPPLY STOPS, SUPPLY LINES AND DRAIN LINES.
P-2	ADA SHOWER	CRANE A3636.09F	SHOWER BODY SHALL BE A ONE-PIECE, HIGH GLOSS, CAST ACRYLIC, OPEN TOP, BARRIER-FREE SHOWER MODULE, 36" x 36" INSIDE DIMENSIONS, 39-1/2"W x 38-1/2"D x 76-1/2"H OVERALL DIMENSIONS WITH (2) INTEGRAL SOAP SHELVES, (2) STAINLESS STEEL GRAB BARS, FOLD-UP BENCH AND STAINLESS STEEL CURTAIN ROD; INSTALL PER MANUFACTURER'S WRITTEN INSTALLATION INSTRUCTIONS. PROVIDE WITH SYMMONS C-96-500-B30-V-X PRESSURE-BALANCING MIXING VALVE WITH LEVER HANDLE, INTEGRAL SERVICE STOPS, ADJUSTABLE STOP SCREW TO LIMIT HANDLE TURN, DIVERTER VALVE WITH INTEGRAL VOLUME CONTROL, WALL/HAND SHOWER WITH FLEXIBLE METAL HOSE, IN-LINE VACUUM BREAKER, WALL CONNECTION AND FLANGE AND 30" SLIDE BAR. WITH ADJUSTABLE, ALL BRASS, SPRAY SHOWER HEAD WITH ARM, FLANGE AND INTEGRAL 2.5 GPM FLOW RESTRICTOR.	2"	2"	1/2"	1/2"	INSTALL SHOWER ARM AT 78" AFF. INSTALL MIXING VALVES AT 42" AFF. INSTALL TOP OF SLIDE ARM FOR HAND HELD SHOWER AT 70" AFF. REFER TO SCHEDULE NOTE #1.
P-3	SINGLE COMPARTMENT SINK (UNDER COUNTER MTD.)	JUST US-1620-A	18"x14" ID 7-1/2" DEPTH UNDER MOUNT STAINLESS STEEL SINK. PROVIDE WITH CHICAGO 201-AGN8E3-317XK SINK FAUCET, 8" CENTERS, WITH 8" SWING GOOSENECK SPOUT, AERATOR, WRIST BLADE HANDLES, ELKAY LK35 DRAIN WITH STAINLESS STEEL STRAINER BASKET, McGUIRE 8912 P-TRAP, McGUIRE 2166 WHEEL HANDLE ANGLE SUPPLY STOPS	1 1/2"	2"	1/2"	1/2"	REFER TO SCHEDULE NOTE #3.
P-4	ADA ELECTRIC DRINKING FOUNTAIN (WALL MOUNTED)	OASIS P8ACSL	UNIT SHALL BE SPLIT-LEVEL. 1/4 HP, 120V, 4.6FLA. PROVIDE WITH APRON FOR UPPER UNIT, WALL MOUNTING BRACKET, McGUIRE 2166 WHEEL HANDLE ANGLE SUPPLY STOP AND McGUIRE 8872 P-TRAP. PROVIDE ADDITIONAL BACKERBOARDS AT WALL HANGER BRACKET BETWEEN METAL STUDS. FINISH COLOR BY ARCHITECT.	1-1/4"	2"	1/2"	-	INSTALL WITH TOP OF UPPER UNIT AT 37-1/2" AFF.
P-5	ADA WALL HUNG WATER CLOSET	AM STANDARD 2257.103	PROVIDE WITH SLOAN REGAL FLUSH VALVE MODEL 111 (1.6 GPF). PROVIDE CARRIER SYSTEM AS REQUIRED FOR ADA MOUNTING HEIGHT.	INTEGRAL	4"	1"	-	MOUNT TOP OF SEAT BETWEEN 17" AND 19" AFF
P-6	SERVICE SINK	AM STANDARD 7745.811	28"x28"x13" ENAMELED CAST IRON SERVICE SINK WITH VINYL RIM GUARD. PROVIDE WITH AMERICAN STANDARD 8344.112 FAUCET WITH TOP BRACE, STOPS AND VACUUM BREAKER.	3"	3"	3/4"	3/4"	SEAL PERIMETER OF SINK WITH WHITE SILICONE SEALANT

FLOOR DRAIN & FLOOR SINK SCHEDULE					
MARK	DESCRIPTION	MFGR. & MODEL	TRAP	WASTE	REMARKS
FD-1	FLOOR DRAIN	ZURN Z415B WITH TYPE 'B' ROUND STRAINER	2"	2"	DURA-COATED CAST IRON BODY w/BOTTOM OUTLET, COMBINATION INVERTIBLE MEMBRANE CLAMP AND ADJUSTABLE COLLAR WITH 6" DIAMETER POLISHED NICKEL BRONZE STRAINER AND 1/2" TRAP PRIMER CONNECTION. INSTALL STRAINER PLUMB AND FLUSH WITH FINISH FLOOR, COORDINATE FINAL STRAINER INSTALLATION HEIGHT WITH FLOOR FINISH; REFER TO ARCHITECTURAL SHEETS FOR TYPE.
FD-2	FLOOR DRAIN	ZURN Z415B WITH TYPE 'B' ROUND STRAINER AND OVAL FUNNEL	2"	3"	DURA-COATED CAST IRON BODY w/BOTTOM OUTLET, COMBINATION INVERTIBLE MEMBRANE CLAMP AND ADJUSTABLE COLLAR WITH 6" DIAMETER POLISHED NICKEL BRONZE STRAINER, OVAL FUNNEL AND 1/2" TRAP PRIMER CONNECTION. INSTALL STRAINER PLUMB AND FLUSH WITH FINISH FLOOR, COORDINATE FINAL STRAINER INSTALLATION HEIGHT WITH FLOOR FINISH; REFER TO ARCHITECTURAL SHEETS FOR TYPE.

PLUMBING EQUIPMENT SCHEDULE				
MARK	DESCRIPTION	MFGR. & MODEL	SPECIFICATIONS	REMARKS
IMO-1	REFRIGERATOR ICE MAKER OUTLET BOX	GUY GRAY BIM875	20 GAUGE UNPAINTED HOT DIPPED GALVANIZED STEEL OUTLET BOX WITH 18 GAUGE UNPAINTED HOT DIPPED GALVANIZED STEEL FACEPLATE, 1/2" FIPx1/4"O.D. COMPRESSION OUTLET ANGLE VALVE WITH WHEEL HANDLE. PAINT FACE PLATE WITH PRIMER COAT FOR FINAL FINISH BY ARCHITECT.	INSTALL AT 48" AFF BEHIND ICEMAKER LOCATION. REFER TO SCHEDULE NOTES.

- SCHEDULE NOTES
- AT ONE-PIECE SHOWER STALL PROVIDE McGUIRE 2" FIP HEAVY CAST BRASS BODY SHOWER STALL STRAINER WITH STAINLESS STEEL GRID AND INSTALL PER MANUFACTURER'S WRITTEN INSTALLATION INSTRUCTIONS.
 - AT ICEMAKER OUTLET BOX, MAKE FINAL CONNECTION TO RELOCATED ICEMAKER PER MANUFACTURER'S WRITTEN INSTALLATION INSTRUCTIONS,
 - AT SINGLE COMPARTMENT SINKS PROVIDE GUARDIAN G1806 DECK MOUNTED, SWIVEL EYE WASH STATION MOUNTED TO COUNTER TOP. FURNISH AND INSTALL McGUIRE 2166 HOT AND COLD WATER WHEEL HANDLE STOPS ADJACENT TO SINK STOPS. CONNECT TO EYE WASH STATION THRU SYMMONS 5-120 THERMOSTATIC MIXING VALVE. ADJUST THERMOSTATIC MIXING VALVE AND SET PER ANSI STANDARDS. MAKE ALL FINAL CONNECTIONS. INSTALL ALL SIGNAGE PROVIDED WITH EYE WASH STATION.

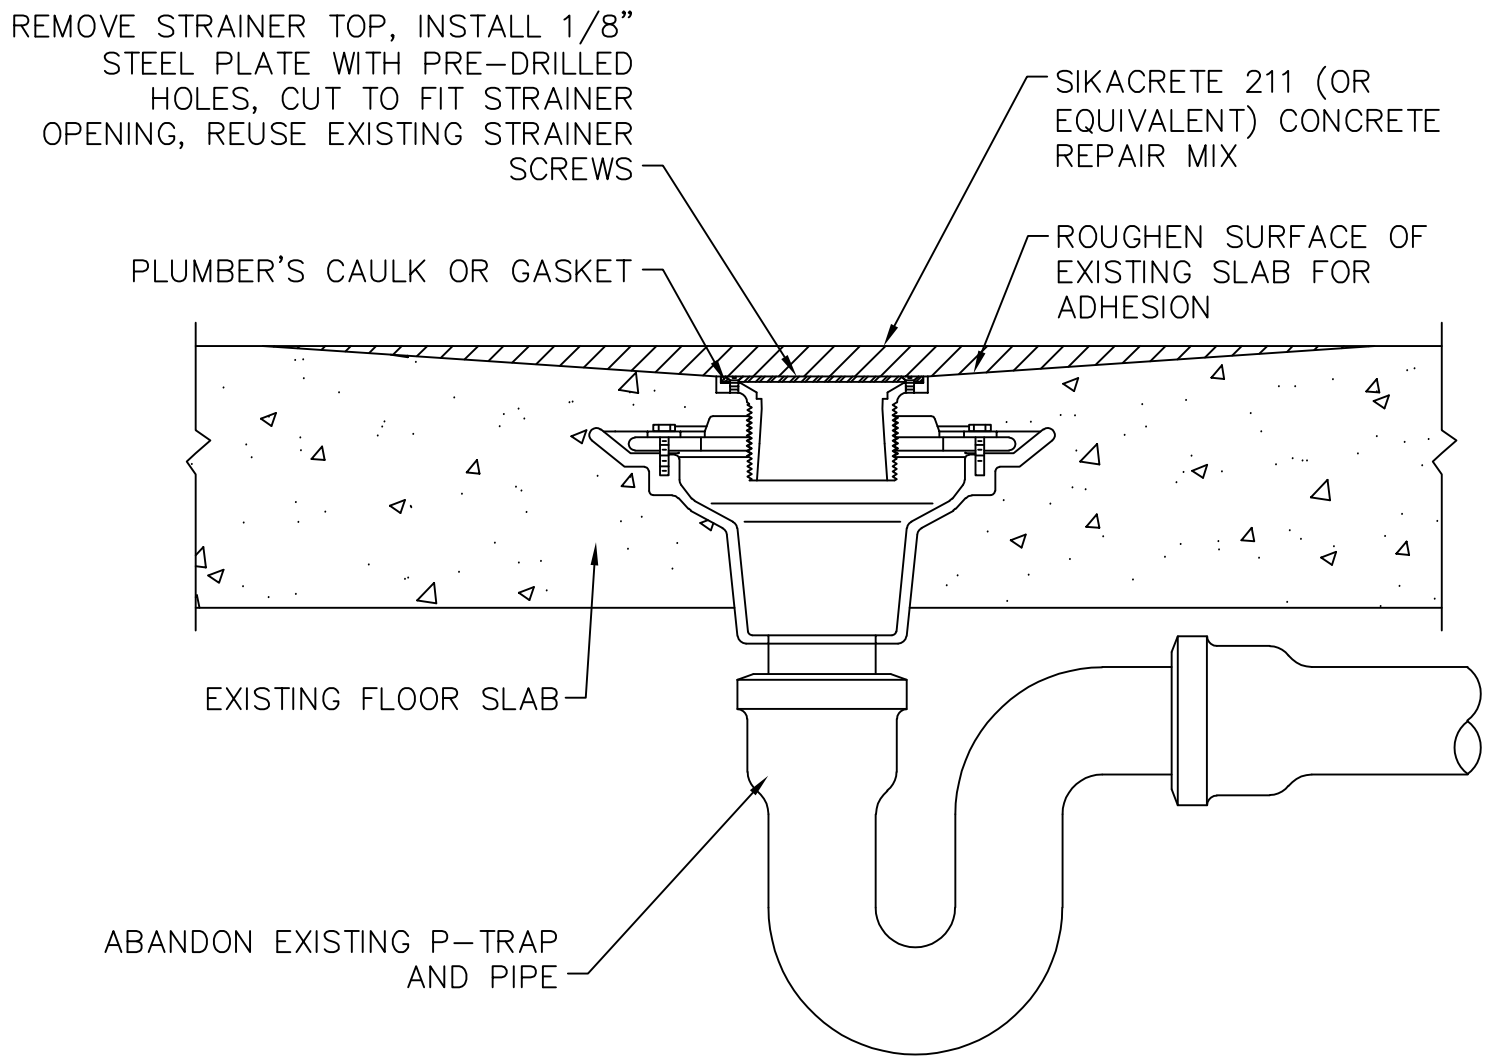

1 FLOOR PENETRATION FLOOR PATCH
P-301 SCALE: NONE



LITTLE ROCK A.F.B.
ARKANSAS

GARVERENGINEERS

1010 BATTERY STREET
LITTLE ROCK, ARKANSAS 72202
www.garverengineers.com
(501) 376-3633

CROMWELL
ARCHITECTS ENGINEERS

101 SOUTH SPRING ST
LITTLE ROCK AR 72201
TELEPHONE 501-372-2900
FACSIMILE 501-372-0482

								APP'D
								BY
								Date
								Revision/Issue
								No.

PROJECT TITLE REPAIR & RENOVATE MEDICAL CLINIC PH IV LITTLE ROCK AIR FORCE BASE JACKSONVILLE, ARKANSAS 100% SUBMITTAL	PLUMBING SCHEDULES AND DETAILS	
	PROJECT NUMBER NKAK#06-8006-4	PROJECT NUMBER NKAK#06-8006-4
	DESIGNED BY JCF	DESIGNED BY JCF
	DATE JULY 1, 2008 AS SHOWN	DATE JULY 1, 2008 AS SHOWN