


REVISIONS	DATE	DESCRIPTION
1	8/07/2005	ISSUED FOR FINAL WORK PLAN
2	10/31/2003	ISSUED FOR BID
3	10/17/2003	AMENDMENT
4		AMENDMENT
5		AMENDMENT
DESIGNED BY: DATE: 08/04/2003	PROJECT NO: 6503
DRAWN BY: C.S.	CHECKED BY: R.W.H.
REVIEWED BY: SOLICITATION NUMBER:	
U.S. ARMY ENGINEERING AND SUPPORT CENTER CORPS OF ENGINEERS HUNTSVILLE, ALABAMA	FLM T E C H 202 Huntsville, AL 35894-0001

RENOVATE CLINIC
BUILDING 1090
LITTLE ROCK AFB, ARKANSAS


**ZONE A
WASTE & VENT PLAN
AS-BUILT**

SHEET
REFERENCE
NUMBER:
P1.11
SHEET X OF XX

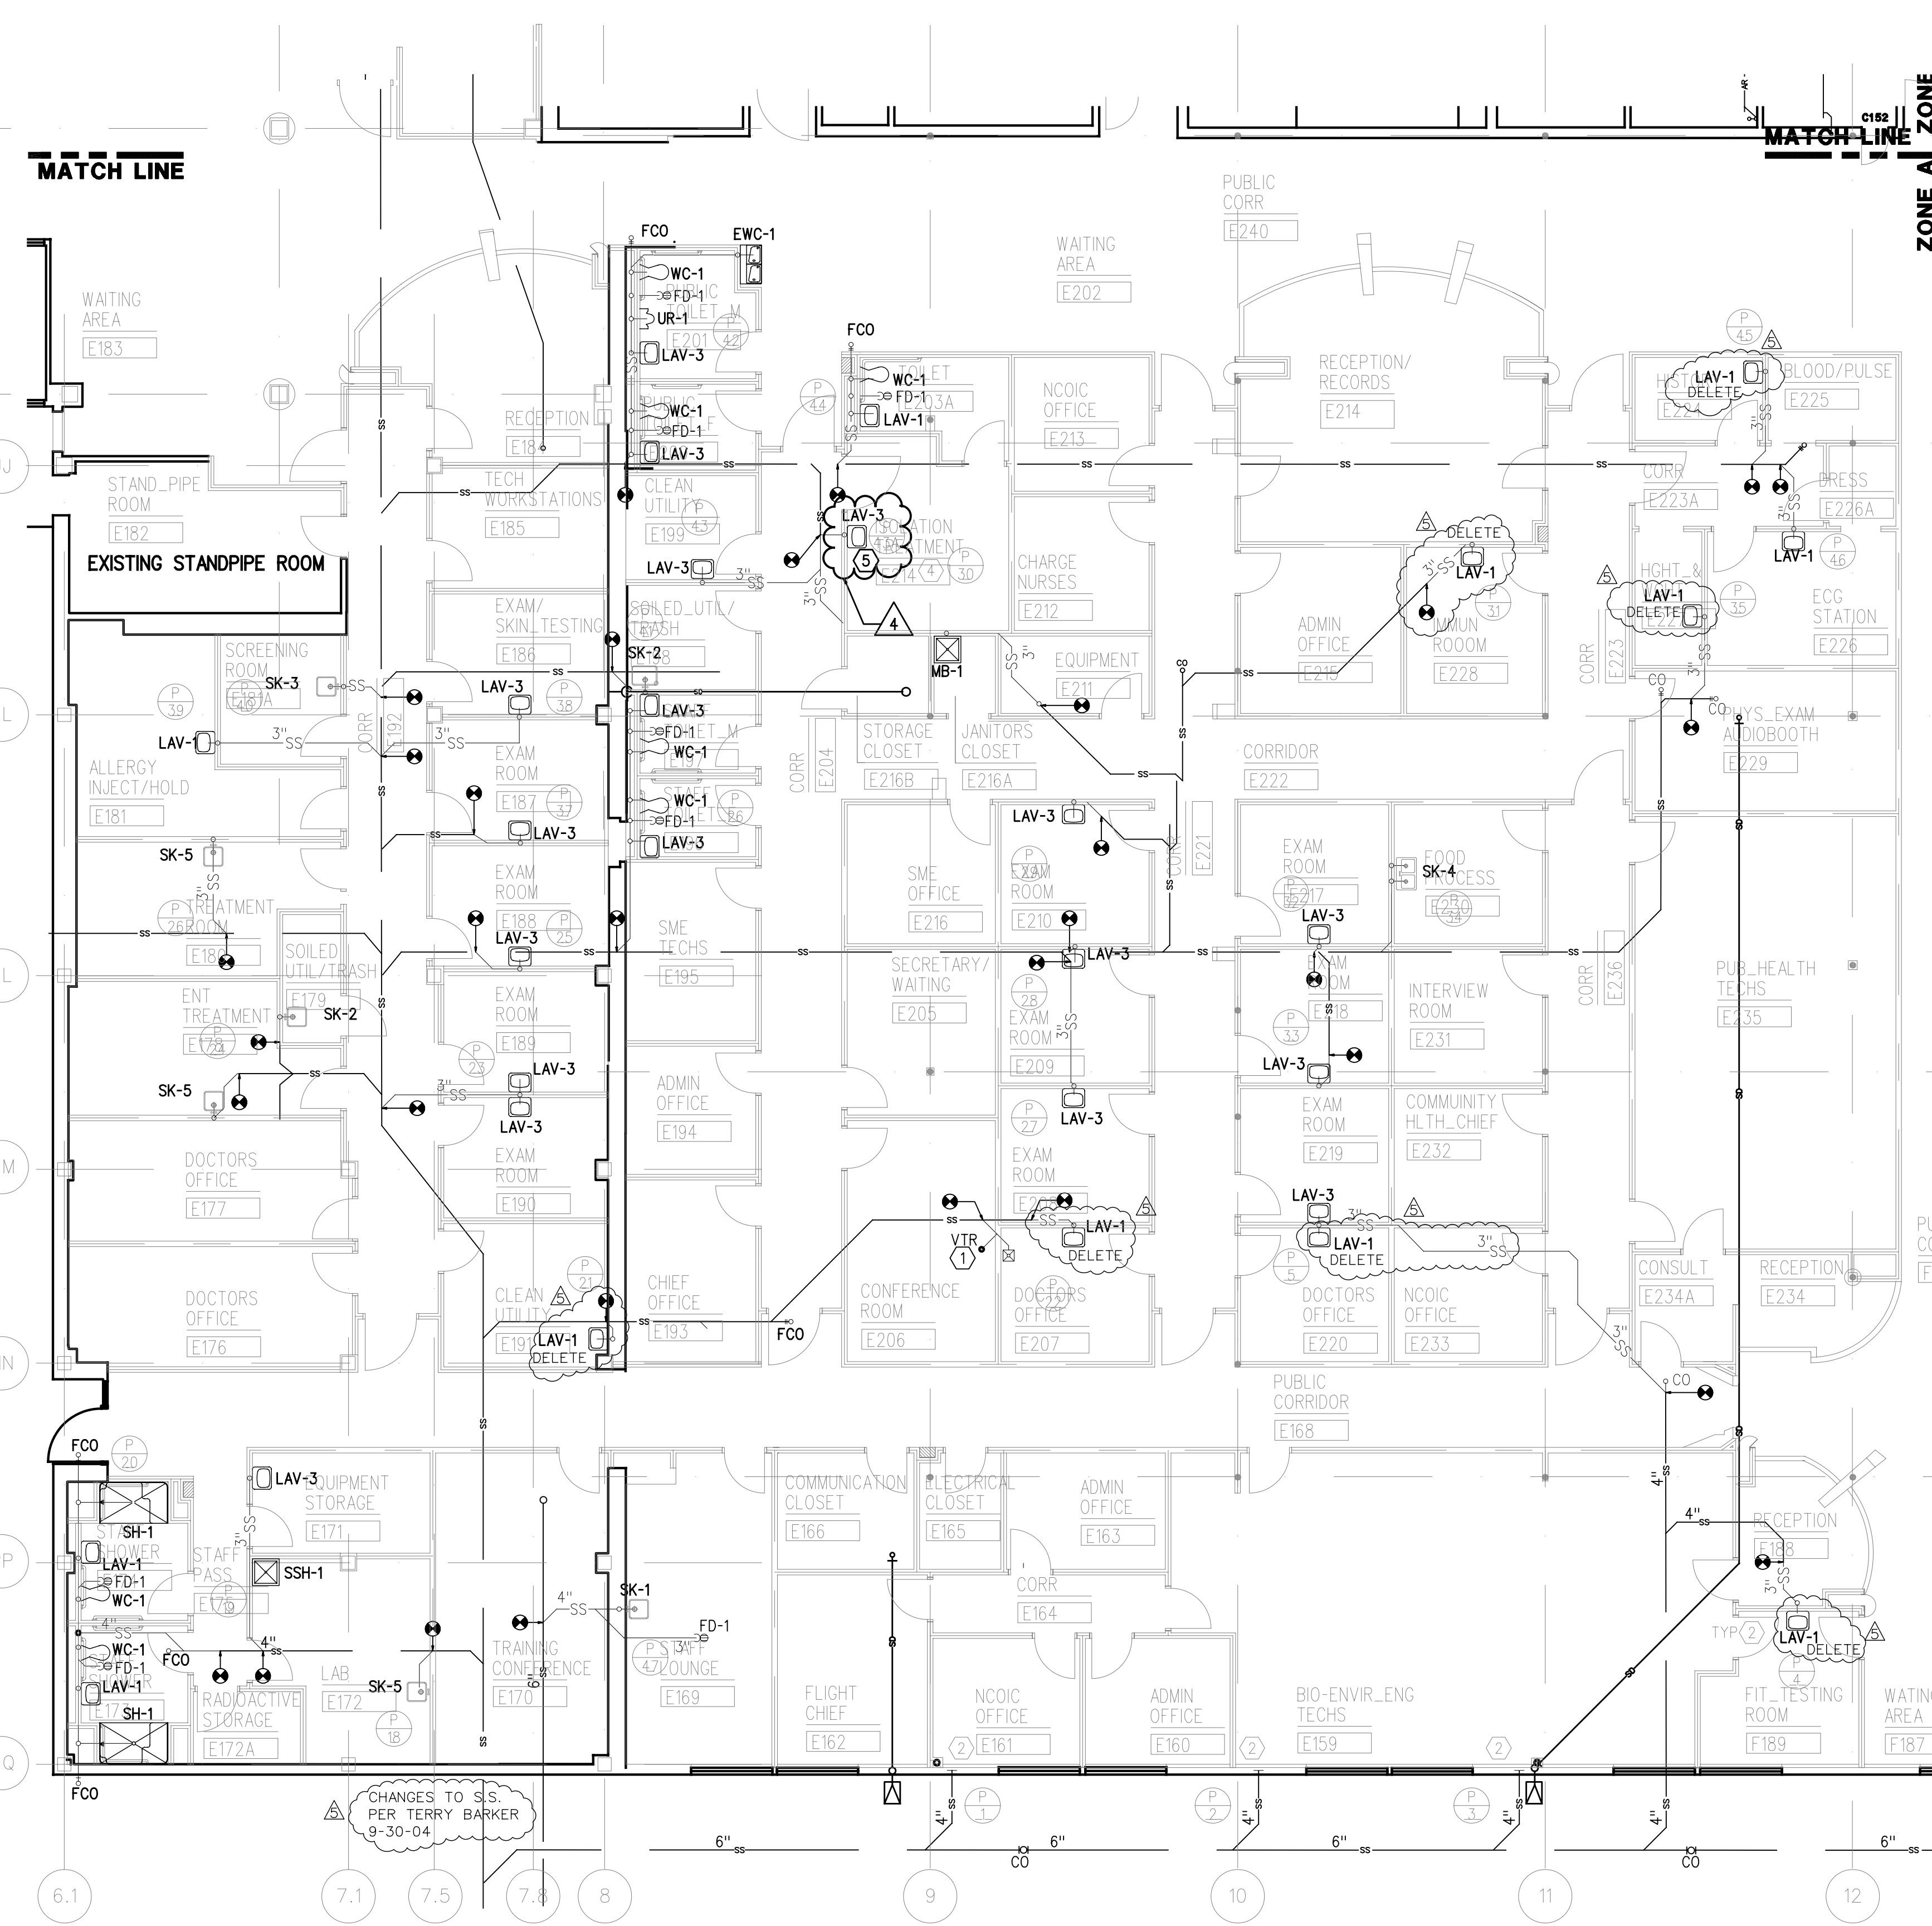

2 ZONE A PLAN

- PLAN NOTES**
- NEW ROOF DRAIN IN THE PENTHOUSE. RUN 2" DRAIN PIPE & VENT THROUGH ROOF.
 - CAP OFF SANITARY PIPE.
 - FOR VENT THRU ROOF SEE WASTE & VENT RISER DIAGRAM P1.13.
 - EYE WASH TO BE INSTALLED ABOVE LAV-3. PROVIDE AN EXTRA HOLE ON LAV-3 FOR CONNECTION.
 - RELOCATE SINK LAV-3 AS SHOWN. INSTALL SANITARY AND VENT PIPES.

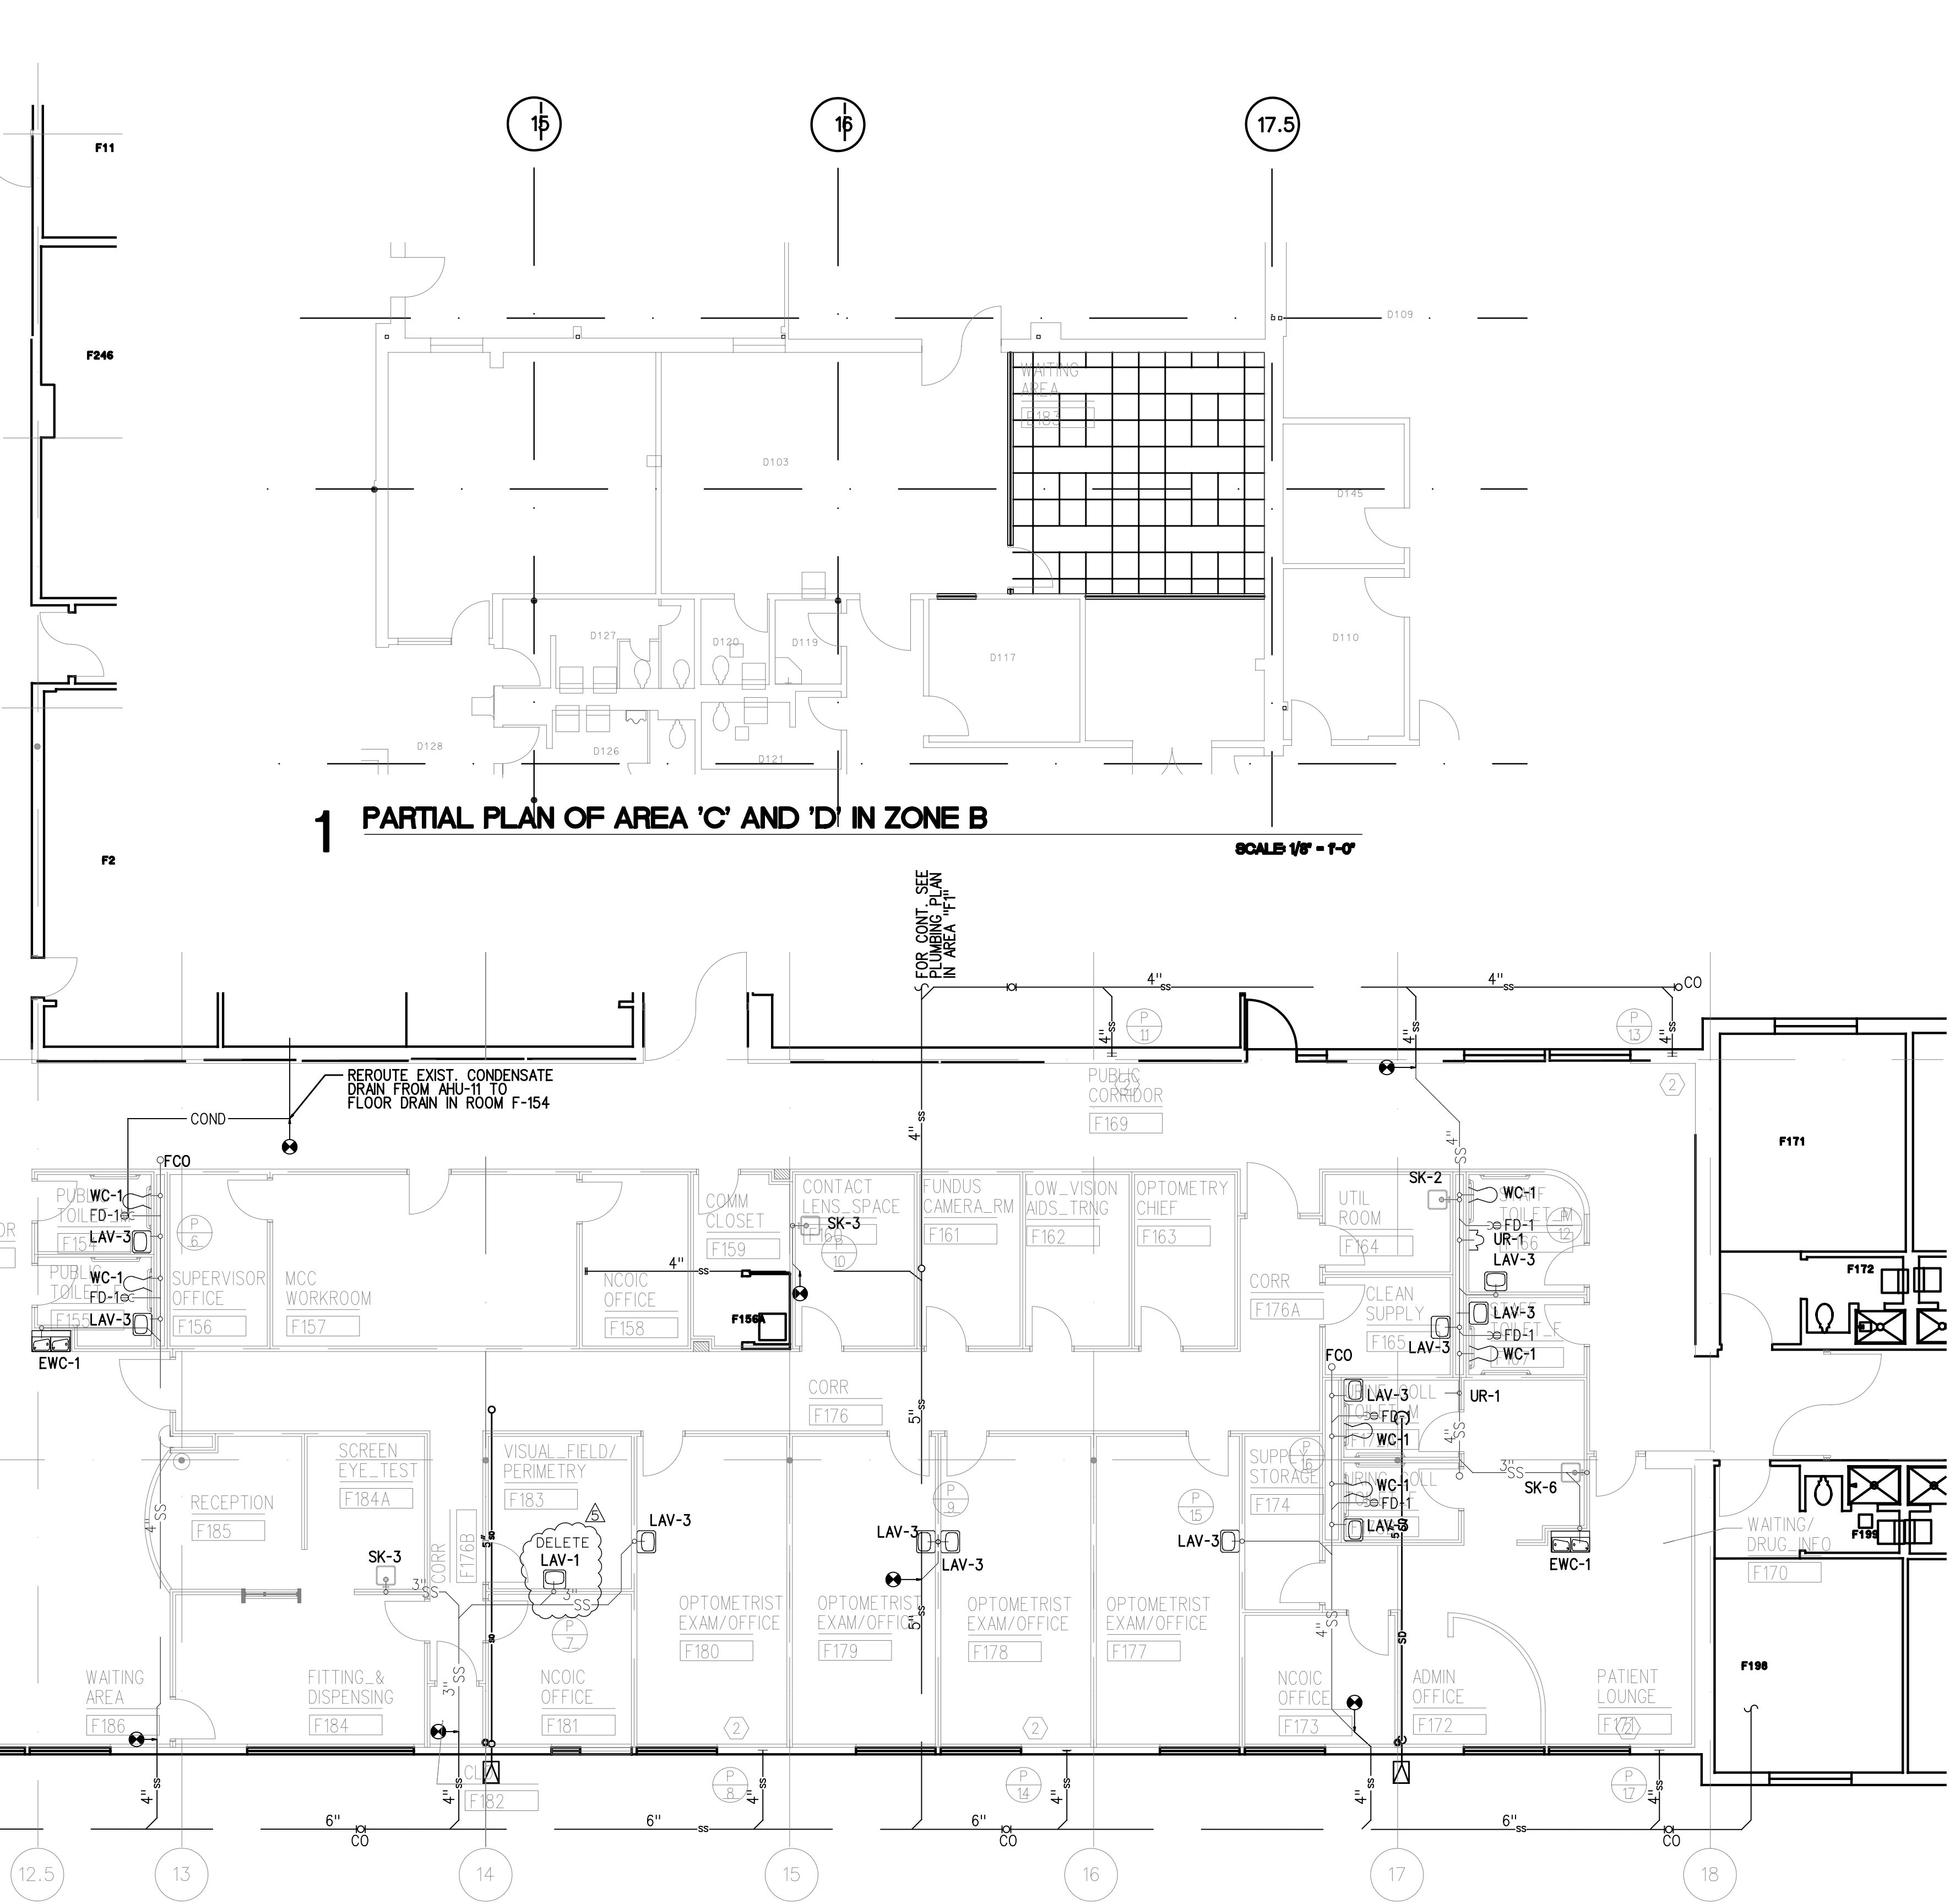

1 PARTIAL PLAN OF AREA 'C' AND 'D' IN ZONE B

PROJECT RENOVATE CLINIC BUILDING 1090
LITTLE ROCK AFB, ARKANSAS

DRAWING TITLE

DRAWING APPLIES TO
CONTRACT DOCUMENTS, SHEETS:

PROJ. NO. 02209800
DATE 9/27/04

DR. BY
CHK. BY

SUPPLEMENTAL
DRAWING NO.
SD-5

SHEET
OF

