



MATCH LINE



- 1 1-1/4" HARD COPPER PIPE ROUTED ABOVE CEILING.
SLOPE AT 1% TOWARDS DRAIN OUTLET.
- 2 INSTALL 24"x36" STAINLESS STEEL ACCESS DOOR.
WILLIAMS BROTHERS CORP. OF AMERICA MODEL
WB-DW OR EQUIVALENT.
- 3 CONNECT DOMESTIC WATER AND DRAIN FOR NEW SINK
TO EXISTING CONNECTIONS.



LITTLE ROCK A.F.B.
ARKANSAS




1010 Battery St.
Little Rock, AR
72202

501-376-3633

www.GarverUSA.com

CROMWELL
ARCHITECTS ENGINEERS


101 SOUTH SPRING ST
LITTLE ROCK AR 72201
TELEPHONE 501-372-2900
FACSIMILE 501-372-0482

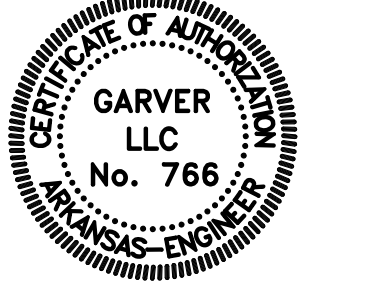[illegible]

PROJECT TITLE
REPAIR & RENOVATE MED. CLINIC PH IV A
LITTLE ROCK AIR FORCE BASE
JACKSONVILLE, ARKANSAS

PLUMBING INSTALLATION PLAN

DRAWN BY BMS	LEAD DESIGNER JCF
TECH REVIEWER JCF	PROJECT NUMBER NKAK 06-8006 4A
DESIGNED BY JCF	SHEET P-201
DATE 13 MAY 2009	
SCALE AS SHOWN	35 OF 51

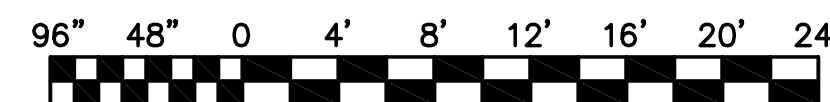

SCALE: 1/8" = 1'-0"

