


REVISIONS AS-BUILT	DATE	APPROVED	SYMBOL	AMENDMENT DESCRIPTION
8/07/2005				
10/31/2003				
10/17/2003				
ISSUED FOR FINAL WORK PLAN				
ISSUED FOR BID				
AMENDMENT				



DESIGNED BY: DATE: 08/04/2003	PROJECT NO: 6503	CHECKED BY: DRAWING CODE:	REVIEWED BY: SOLICITATION NUMBER:
S.A.L.	C.S.	R.W.H.	
U.S. ARMY ENGINEERING AND SUPPORT CENTER	CORPS OF ENGINEERS	HUNTSVILLE, ALABAMA	
EARTH	TECH	FLM	

RENOVATE CLINIC
BUILDING 1090
LITTLE ROCK AFB, ARKANSAS
**ZONE A & B
WATER RISER DIAGRAM
AS-BUILT**


SHEET
REFERENCE
NUMBER:
P1.16
SHEET X OF XX

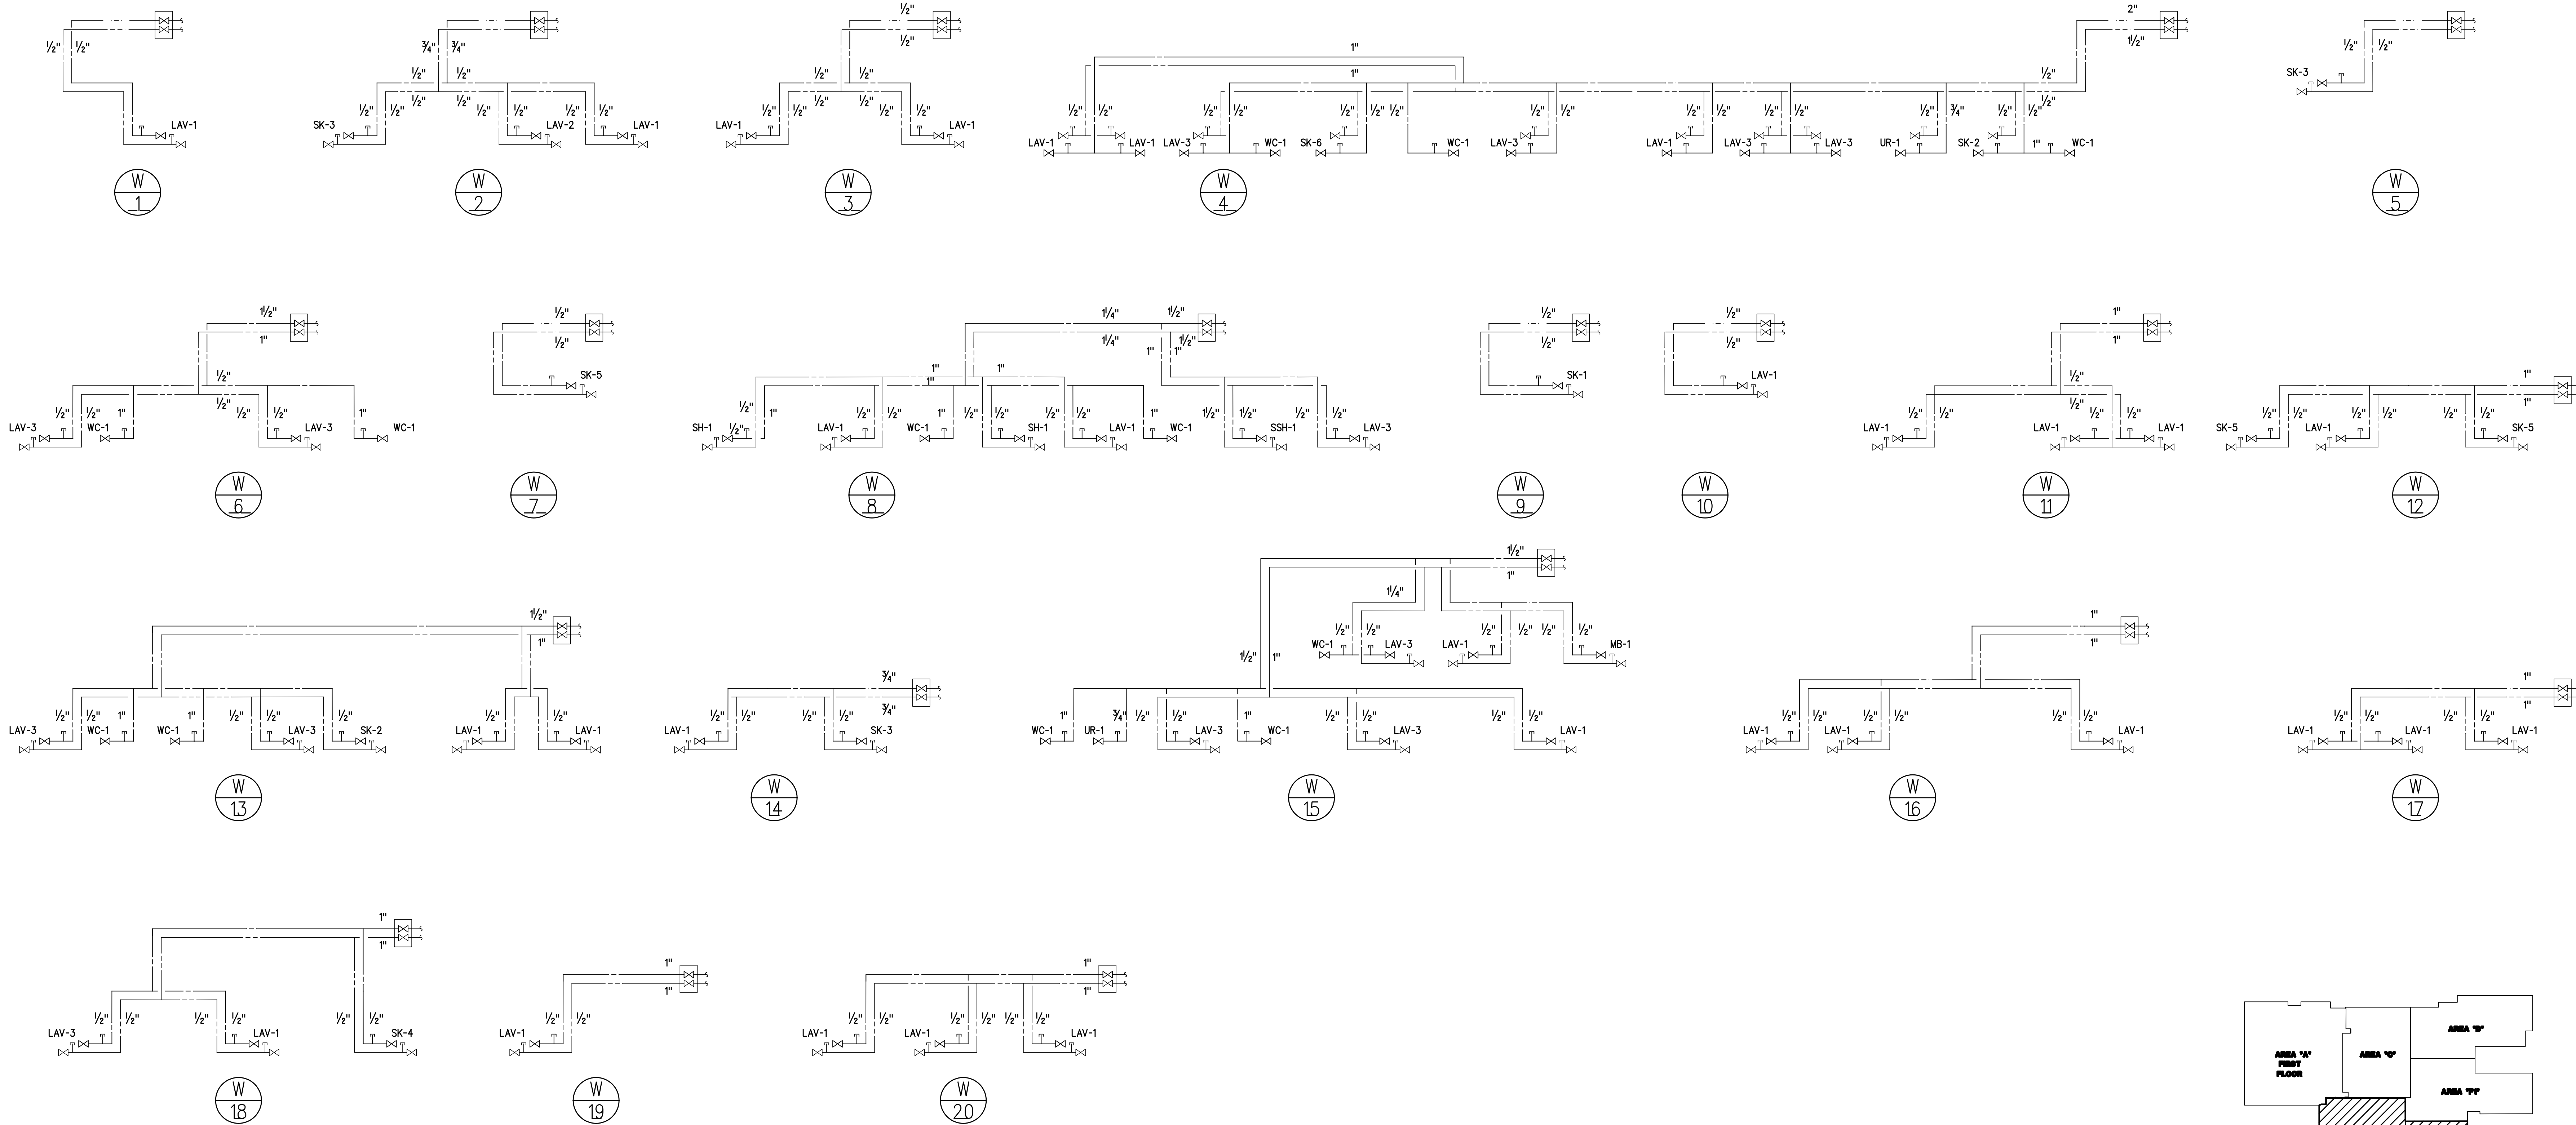

WATER RISER DIAGRAM ZONE A
NOT TO SCALE

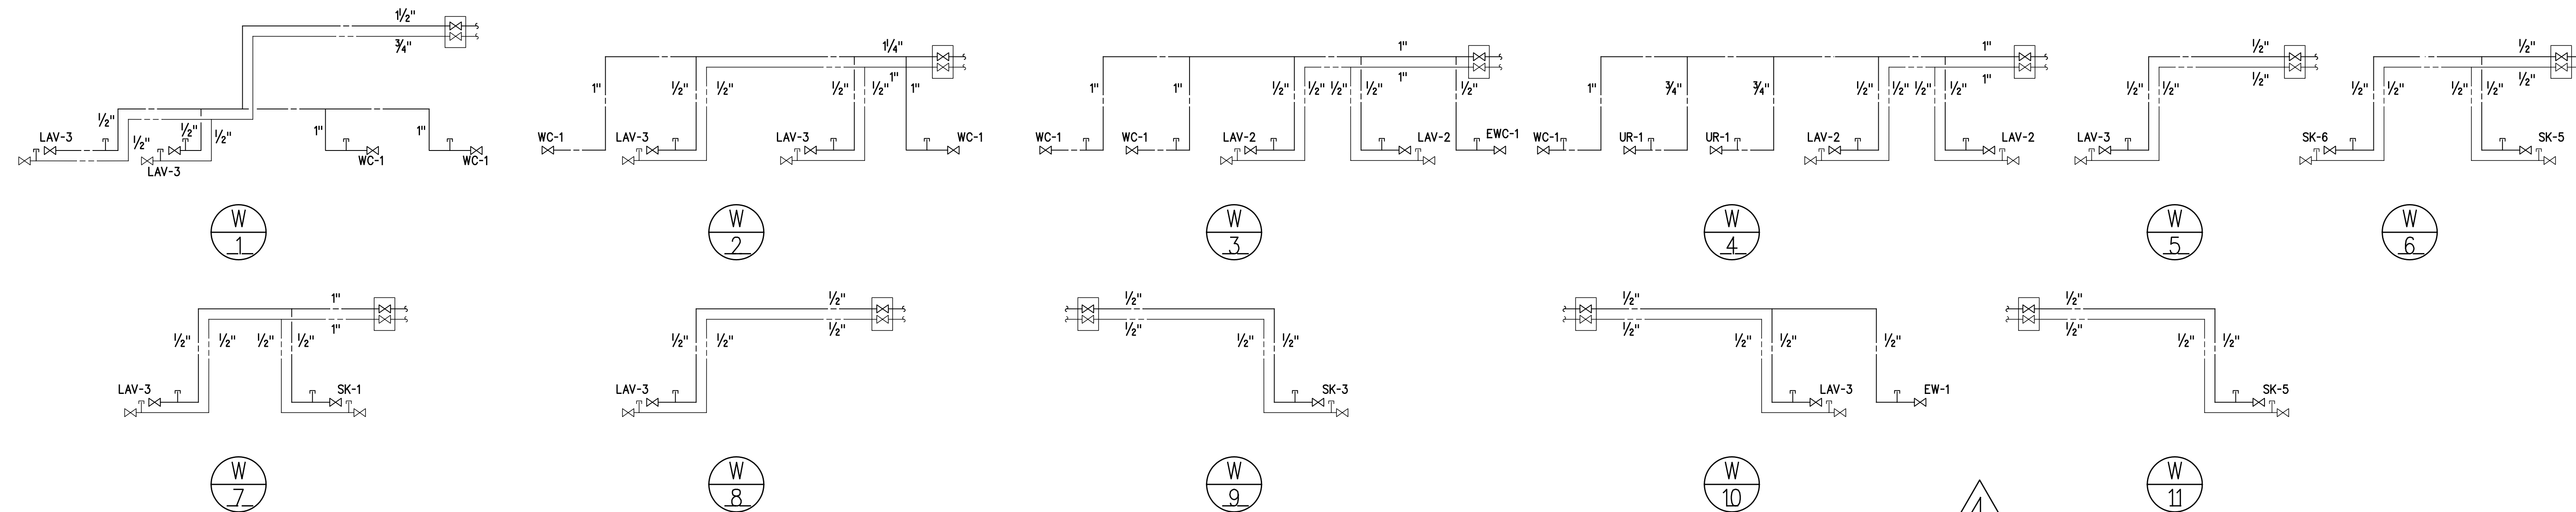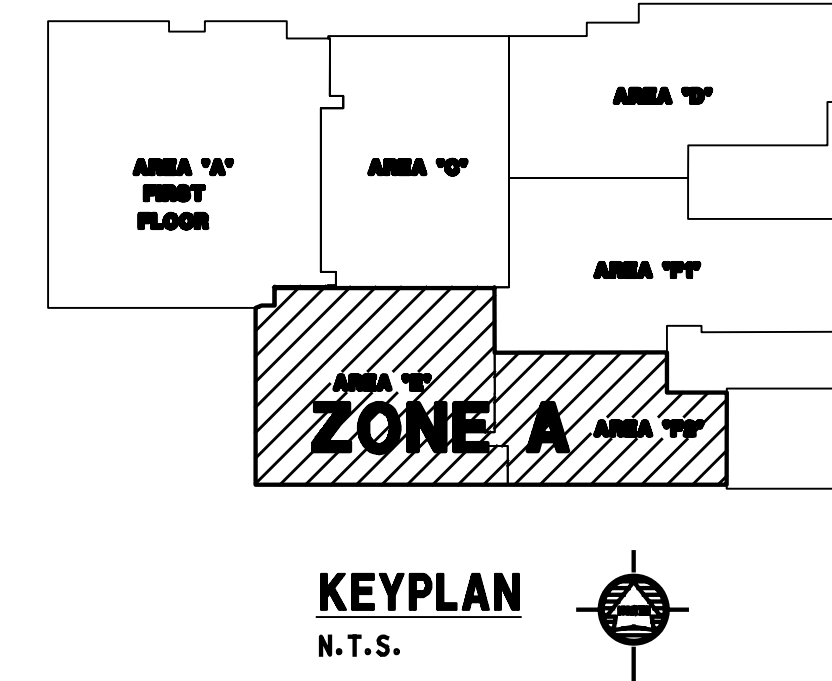

WATER RISER DIAGRAM ZONE B
NOT TO SCALE

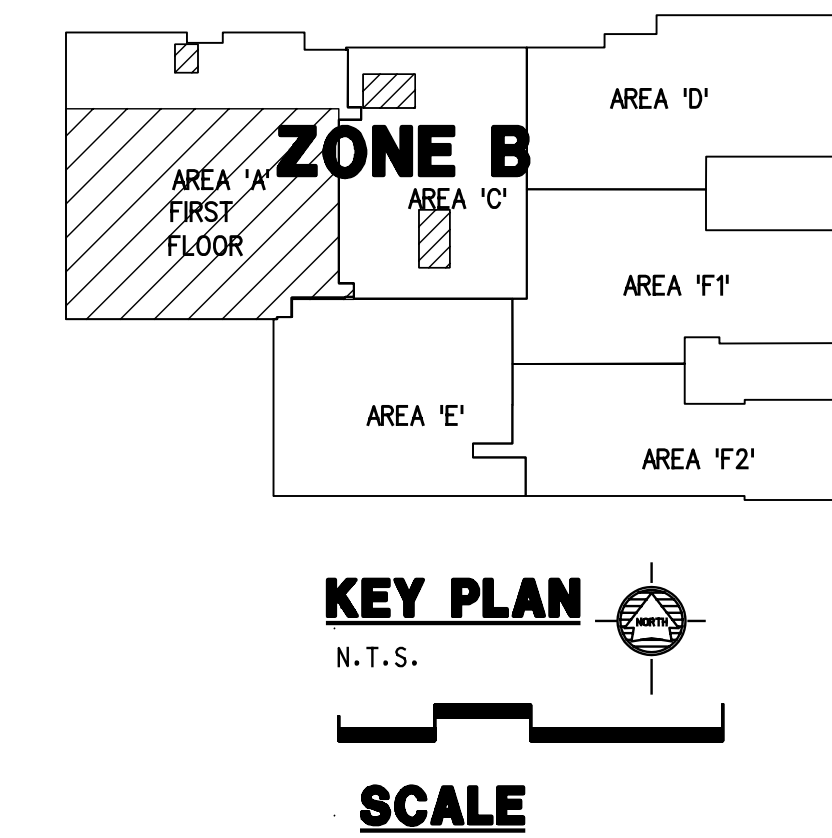

**ZONE B WORK DELETED FROM
SCOPE OF PROJECT**