



NOTE: CORNERS OF PAD ARE LOCATED WITH STAKES.

PLAN - DRILL PAD  
SCALE: 1" = 20'-0"

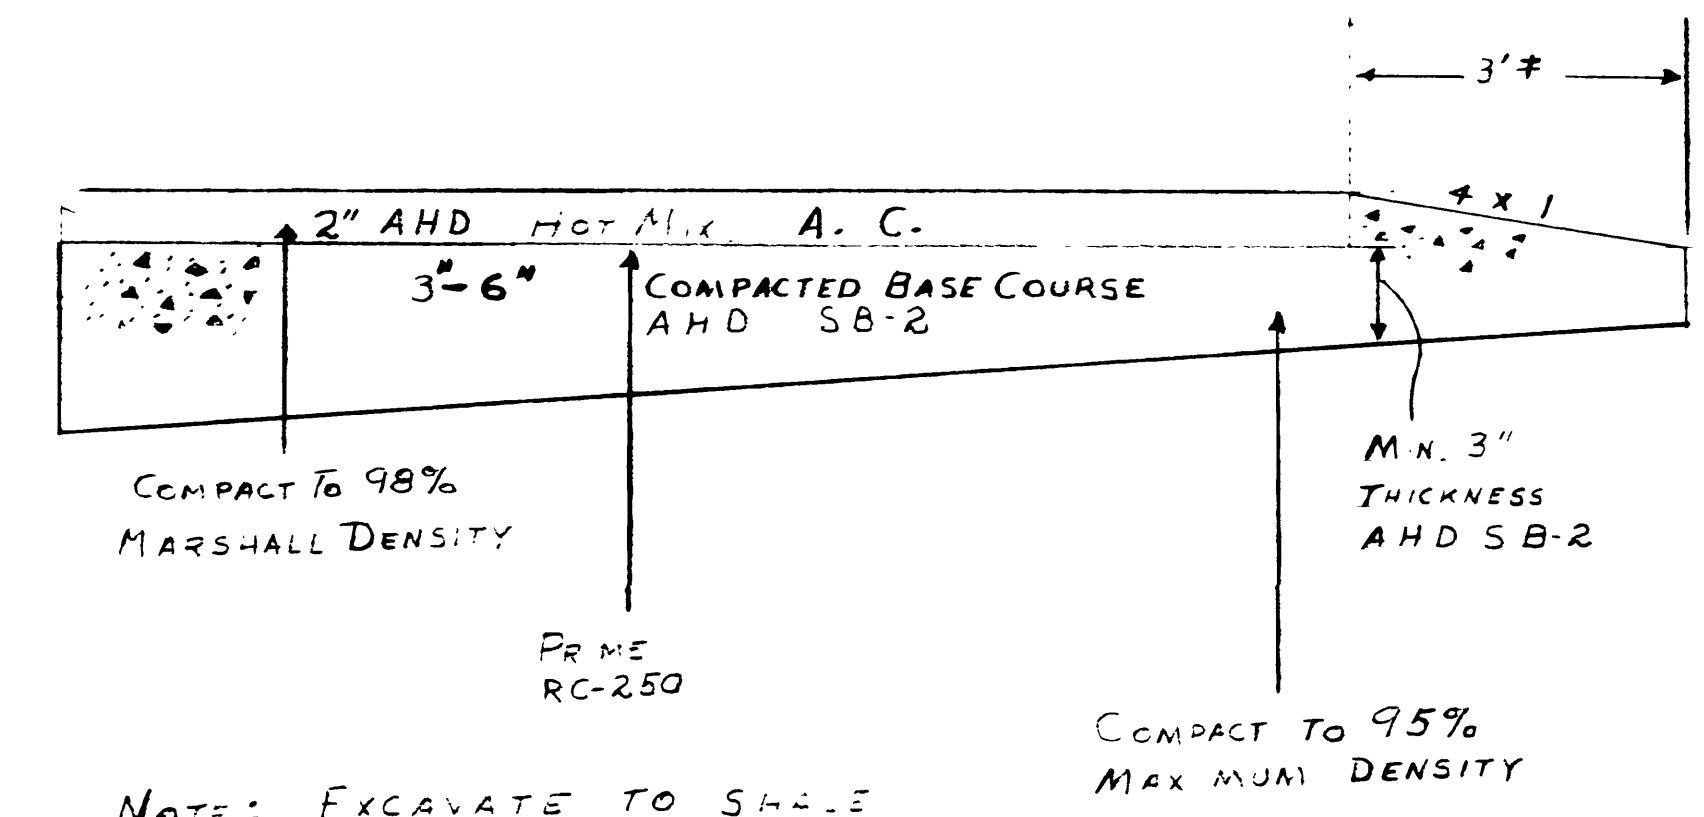


TYPICAL CROSS SECTION  
NOT TO SCALE

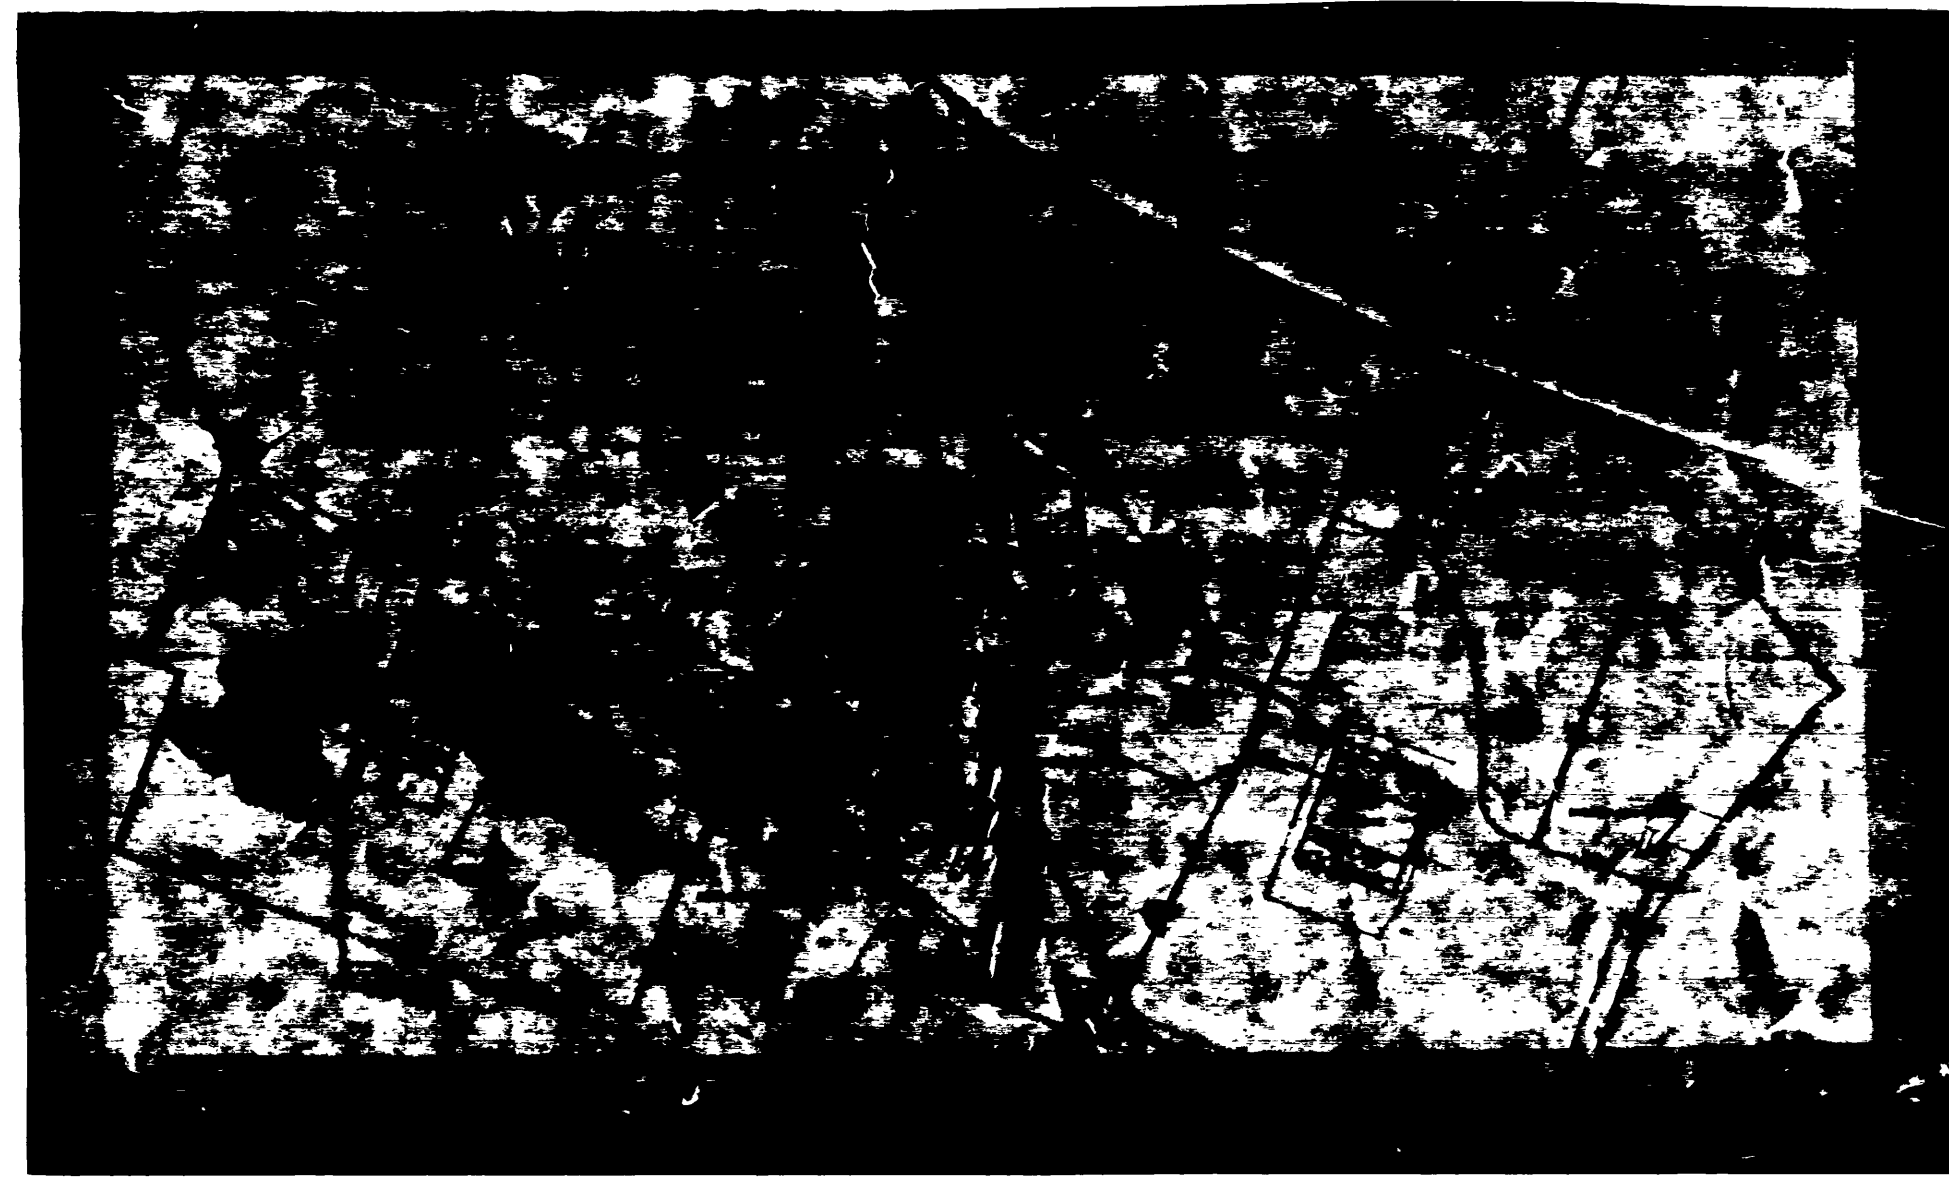

RECORD DRAWING AS CONSTRUCTED  
 Lee Farnsworth  
 CONST. ENG.  
 PROJECT NO. 172-5 DATE 12/2/75

<i>Walker</i> CHECKED OFFICE DATE		10 JAN 82 INSTALL GUARD RAILS & POSTS (25') S.S. 7-7-82 SIDE WALK AS TO WIO # 53222 MKV	DRAWN APP'D
<i>Lee Farnsworth</i> CONST. ENGR.		<b>MILITARY AIRLIFT COMMAND</b>	
N/A SECURITY POLICE		N/A SAFETY	
<i>Kurt H. Thoma</i> POLLUTION CONT. ENG.		N/A BIO-ENVIRONMENTAL ENG.	
N/A CORROSION ENG.		N/A BASE COMMUNICATIONS	
N/A PROTECTIVE COATING		N/A	
SUBMITTED CHIEF ENGINEER		APPROVED CIVIL ENGINEER	
DRAWN BY EVERETT G. BERRY		DESIGNED BY WALKER	
SCALE 1" = 20'		PROJECT NO. LK 172-5	
SHEET 1 OF 1		DRAWING NO. PH-1729	

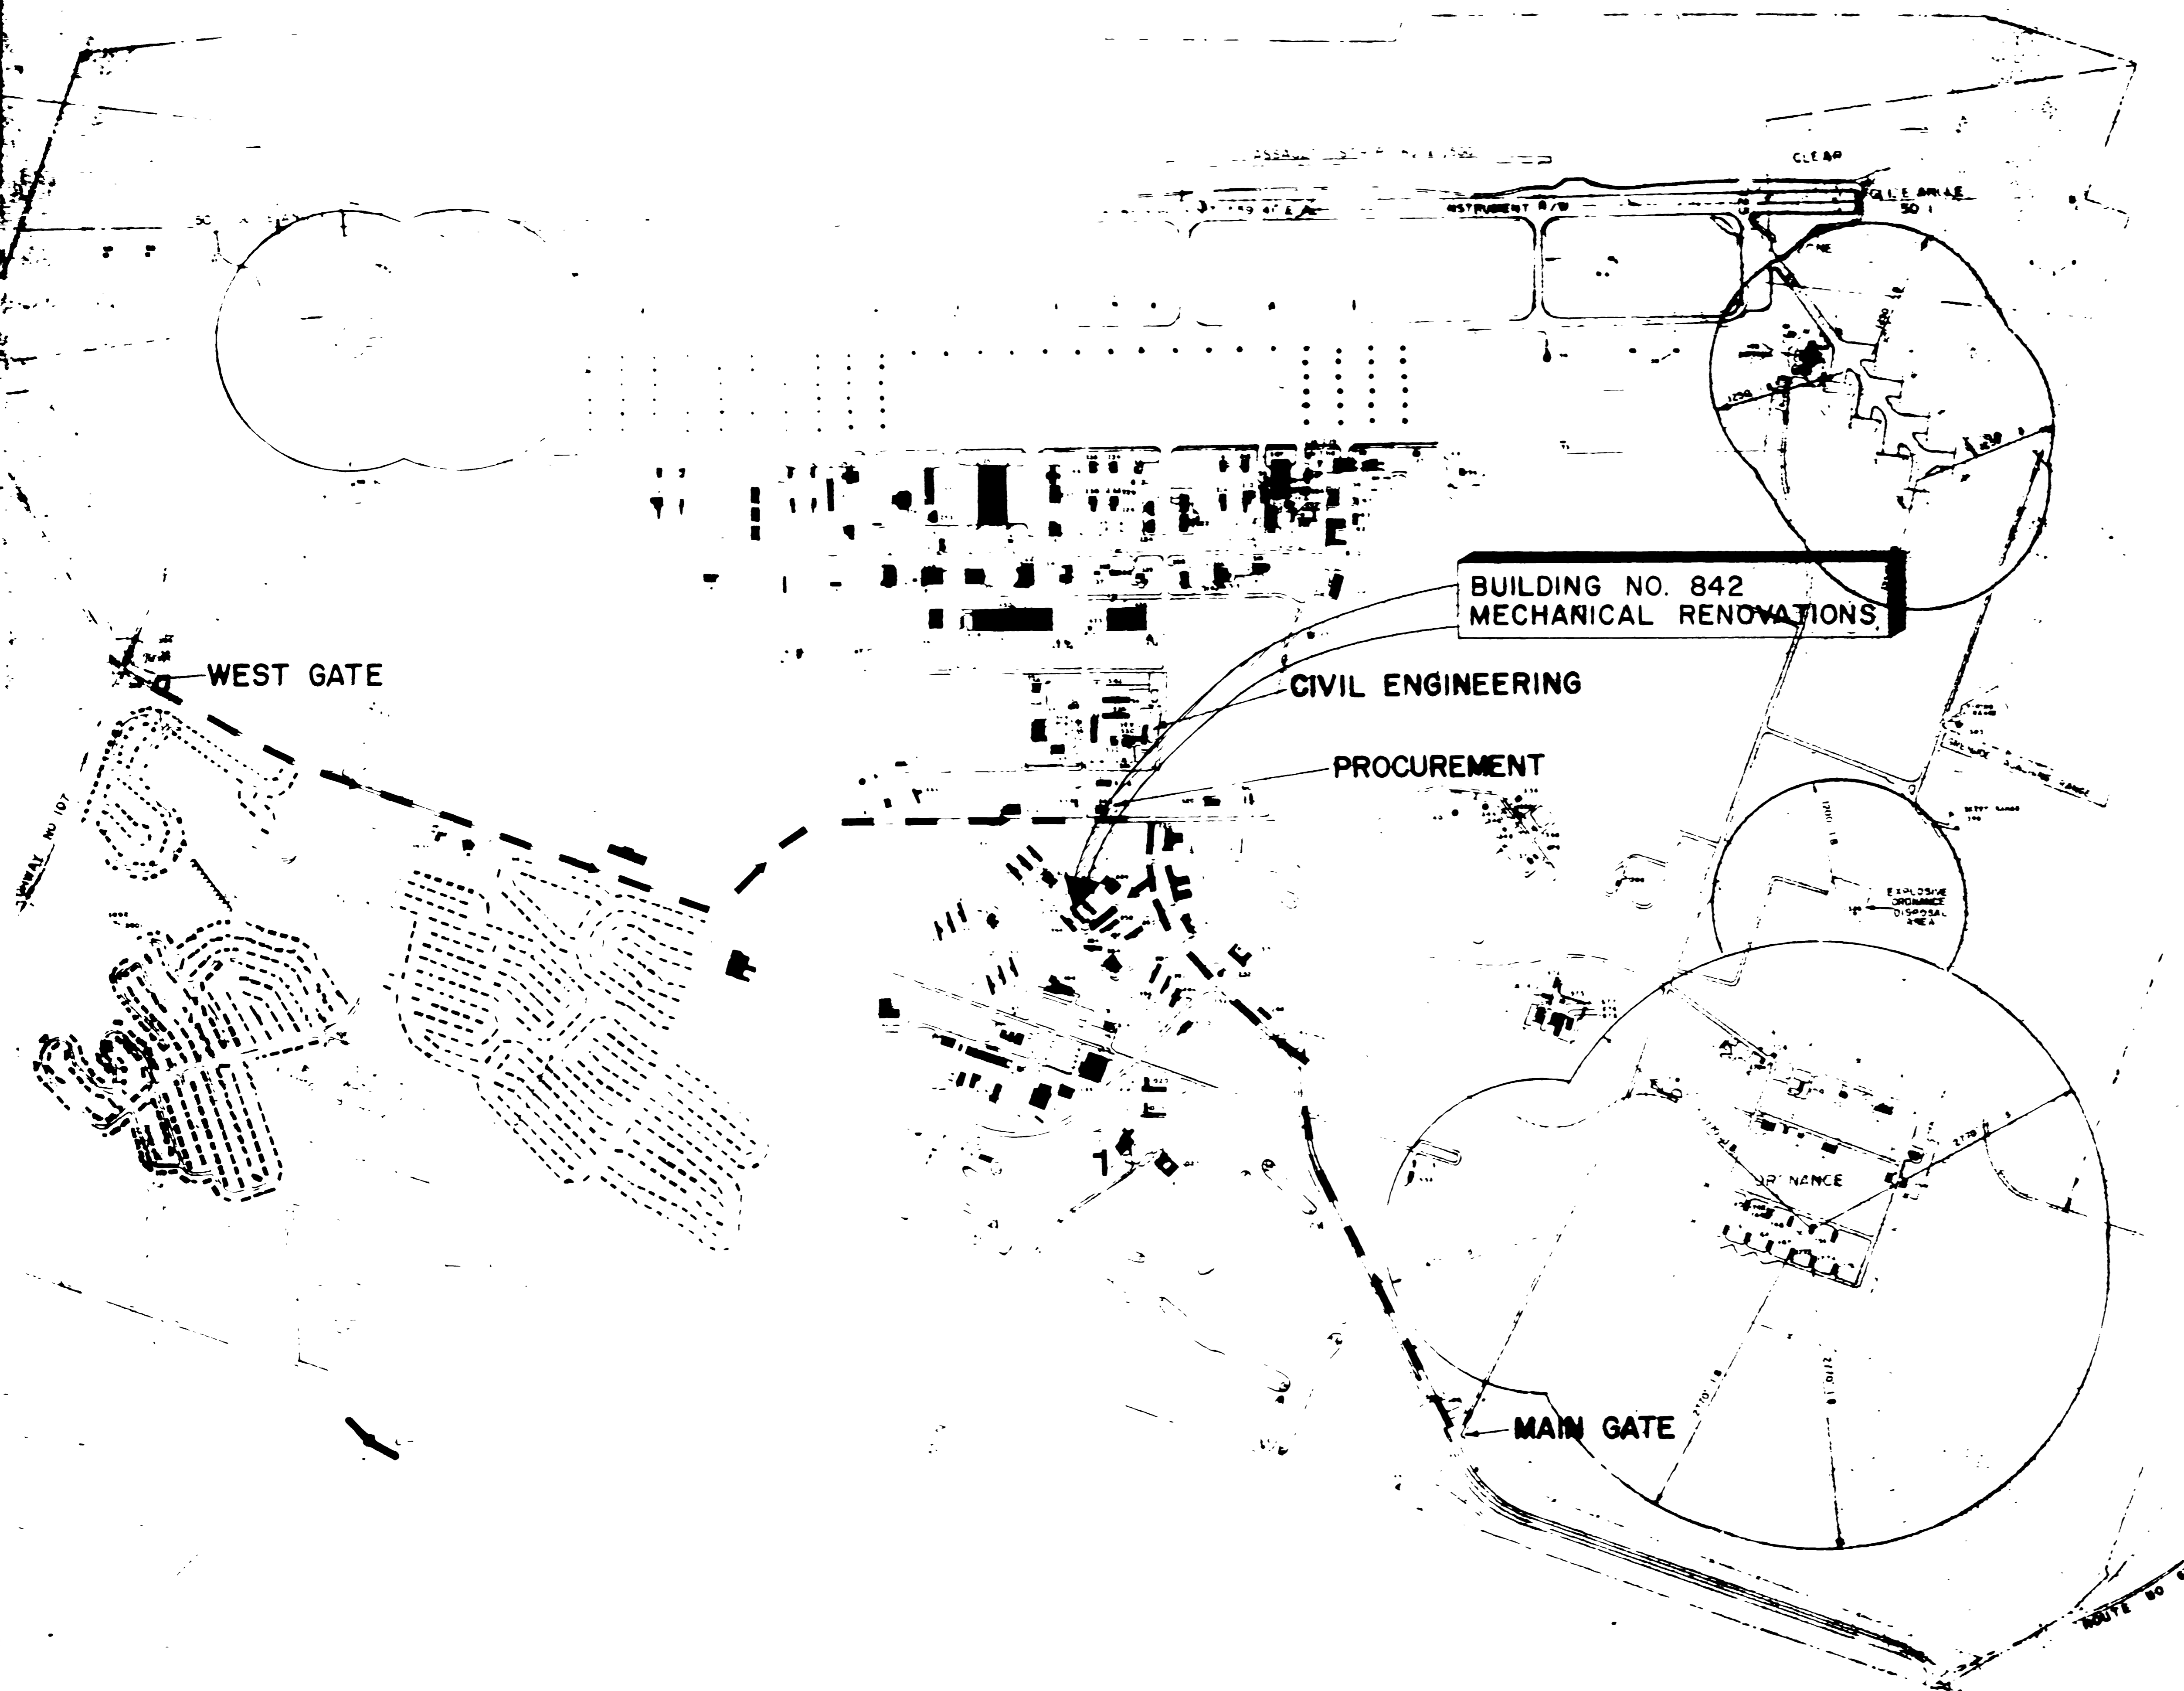

**BUILDING NO. 842  
MECHANICAL RENOVATIONS**

**CIVIL ENGINEERING**


**PROCUREMENT**

**MAIN GATE**





**WEST GATE**

**INDEX**

SHT. NO.	TITLE
1	VICINITY MAP, PROJECT LOCATION
2	LEGEND
3	ARCHITECTURAL REFLECTED CEILING
4	MECHANICAL & ELECTRICAL RENOVATIONS
5	MECHANICAL & ELECTRICAL RENOVATIONS
6	MECHANICAL & ARCHITECTURAL DETAILS

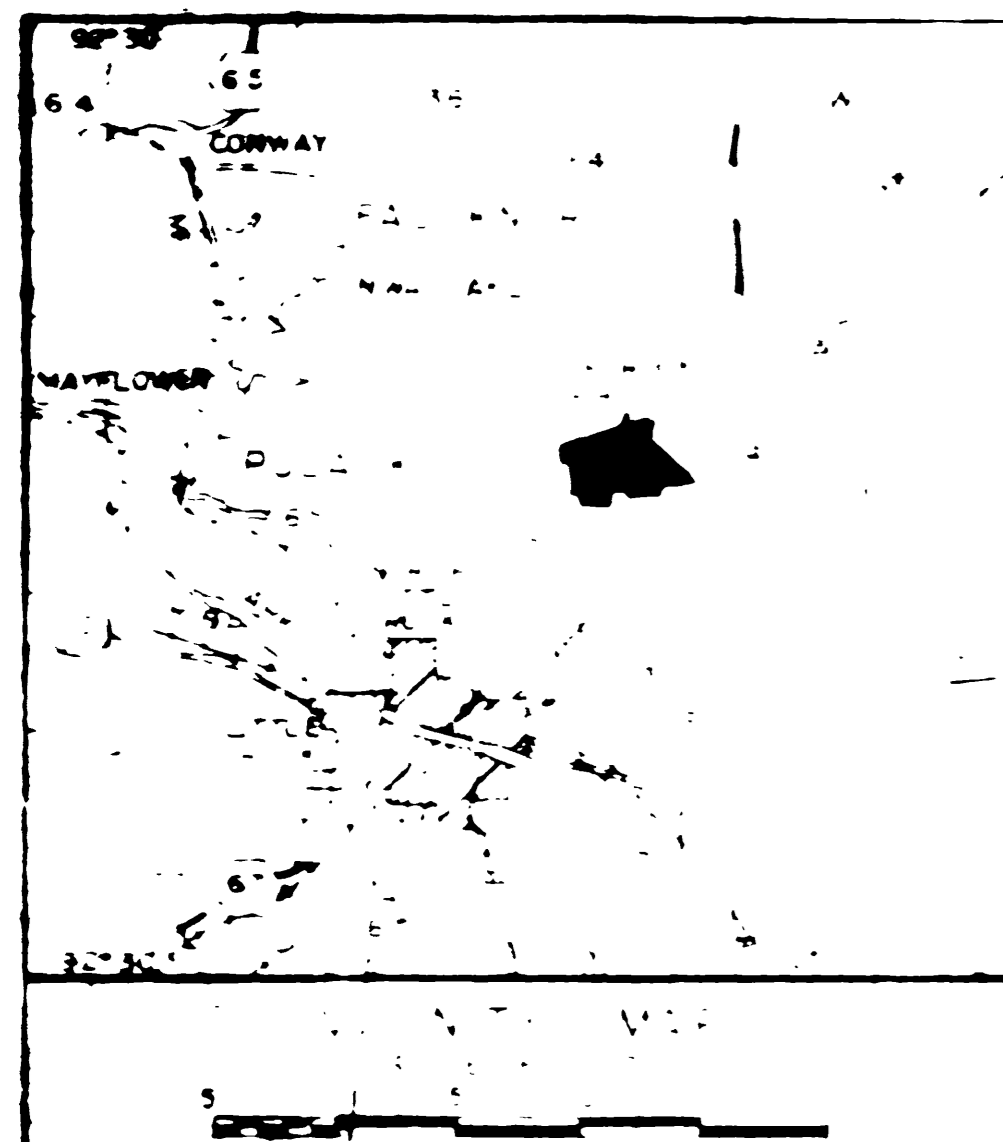

HAUL ROUTE

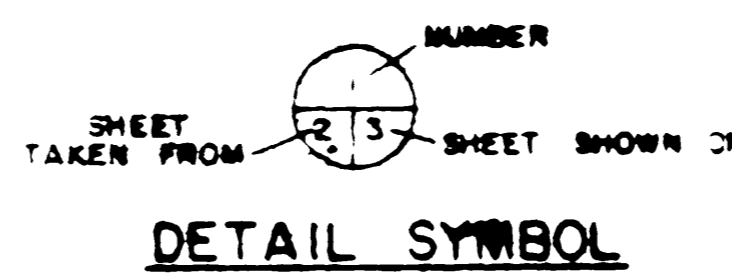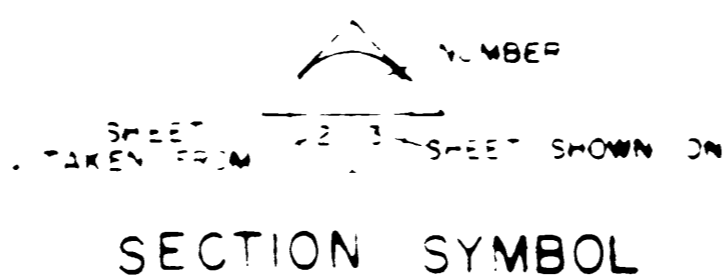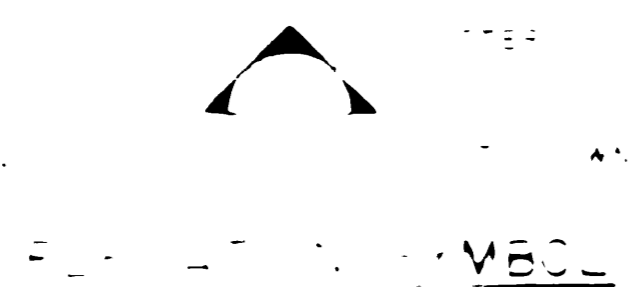
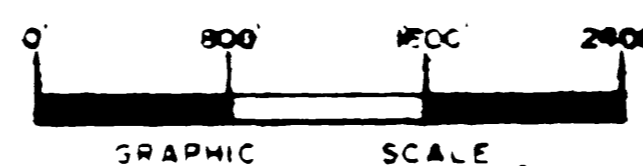






RECORD DELIVER AS CONSTRUCTED  
 CONST. MGT. ENGR. CONST. INSPECTOR  
 PROJECT NO. LRK-81-0046 DATE 5/1/80

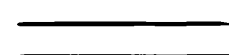
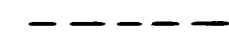






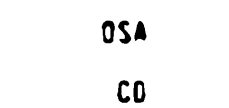

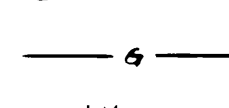
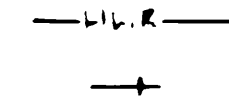
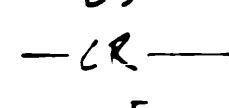
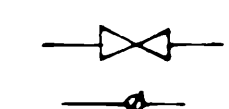
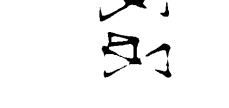



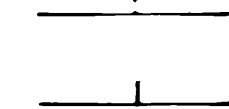

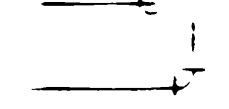
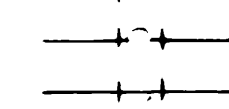
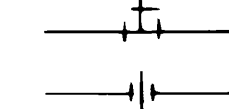





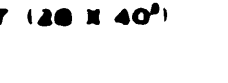
CORROSION ENGR. CHIEF CSM ENV. PROT. ENGR. COMMUNITY PLANNER CHIEF OF DESIGN CONTRACT MANAGER	FIRE PROTECTION SAFETY BIO-ENVIRONMENTAL ENGR. USNR AGENCY COMMUNICATIONS ENGINEER SECURITY POLICE	REV. DATE DESCRIPTION DRAWN APPROV. <b>MILITARY AIRLIFT COMMAND LITTLE ROCK AFB, ARK.</b> <b>REPLACE AIR CONDITIONING BLDG. 842</b> VICINITY MAP---PROJECT LOCATION---INDEX SUBMITTED APPROVED APPROVED CHIEF ENGINEER CIVIL ENGINEER COMMANDER DATE PROJECT NO. DRAWING NO. COMMANDER SHEET JUNE 80 LRK-81-0046 AC-2121 1 OF 6
--	---	--
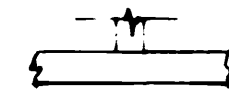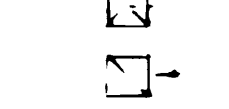
# LEGEND

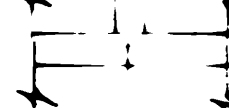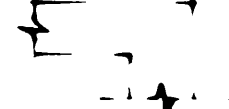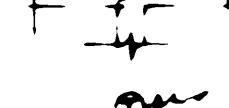
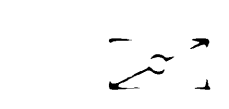
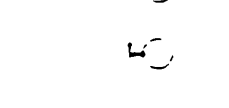
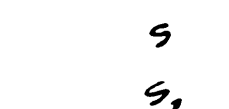
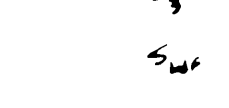
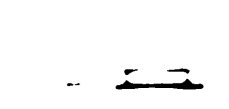
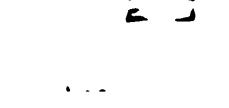
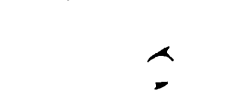

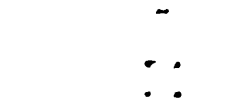

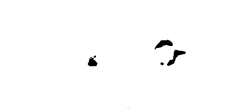

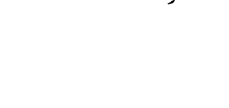












## ARCHITECTURAL

	EXISTING WALLS
	EXISTING WALLS TO BE REMOVED
	FILL WALL WITH SAME KIND
	CONCRETE BLOCK RUNNING BOND
	CONCRETE BLOCK RUNNING BOND IN EXTERIOR WALL PANEL PAINTED
	DRY WALL CONSTRUCTION WITH METAL STUDS AND GYPSUM BOARD

## MECHANICAL / PLUMBING


	WALL SUPPLY REGISTER SR
	CEILING DIFFUSER
	RETURN AIR GRILLE
	SUPPLY DUCT UP
	SUPPLY DUCT DOWN
	RETURN DUCT UP
	RETURN DUCT DOWN
	SQUARE TO ROUND TRANSITION
	OPPOSED BLADE DAMPER ODB
	FIRE DAMPER FD
	AIRFOIL BLADE TURNING VANES
	AIR EXTRACTOR
	THERMOSTAT
	DIAMETER
	CUBIC FEET PER MINUTE
	RETURN AIR
	OUTSIDE AIR
	CONDENSATE DRAIN
	FLEXIBLE PIPE CONNECTOR
	DOMESTIC COLD WATER
	DOMESTIC HOT WATER
	SANITARY SEWER
	NATURAL GAS
	HOT WATER SUPPLY
	HOT WATER RETURN
	NOSE BIBB
	CONDENSER SUPPLY
	CONDENSER RETURN
	AIR VALVE
	ANTI-SIPHON VALVE
	PRESSURE REDUCING VALVE
	AUTOMATIC AIRWAY CONTROL VALVE
	4-WAY AUTOMATIC CONTROL VALVE
	AIR SHAFING BALANCE VALVE
	ISOLATION VALVE
	CHECK VALVE
	PRESSURE & TEMPERATURE TAPPING
	COLUMN THERMOMETER
	PRESSURE GAUGE
	GAUGE COCK
	VALVE IN RISER
	PIPE ELBOW DOWN
	PIPE ELBOW SIDE
	PIPE ELBOW UP
	PIPE TEE UP
	PIPE TEE DOWN
	PIPE TEE SIDE
	UNION
	Y-STRAINER
	BLAST GATE
	CONNECT TO EXISTING

## ELECTRICAL

	FLUORESCENT FIXTURE
	FLUORESCENT STRIP FIXTURE
	FLUORESCENT TROFFER FIXTURE
	INCANDESCENT FIXTURE
	INCANDESCENT WALL BRACKET FIXTURE
	EXIT FIXTURE
	SWITCH - 2 POLE
	SWITCH - 3 POLE
	SWITCH - WATERPROOF
	SURFACE PANEL
	FLUSH PANEL
	DISTRIBUTION BOARD
	TELEPHONE CABINET
	TELEPHONE TERMINAL BOARD
	MOTOR
	FAN
	DISCONNECT SWITCH
	JUNCTION BOX
	MOTOR CONTROLLER
	PUSHBUTTON STATION
	DUPLEX RECEPTACLE
	30A RECEPTACLE 230V 1Ø
	CONDUIT UP
	CONDUIT DOWN
	CONDUIT HOMERUN TO PANEL NEUTRAL TWO HOT & 1Ø GROUND CONDUCTOR IN THAT ORDER
	CONDUIT STUB-UP WITH COUPLING


RECORD DEPARTMENT CONSTRUCTION  
 PROJECT NO. 81-0044 DATE 4 FEB 62

REV	DATE	DESCRIPTION	DRAWN	APPROD
<b>MILITARY AIRLIFT COMMAND LITTLE ROCK AFB. ARK. REPLACE AIR CONDITIONING BLDG. 842</b>				
<b>LEGEND</b>				
DRAWN BY ALLISON	TECH. CHECKER [Signature]	DESIGNED BY [Signature]	DATE JUNE 60	
SCALE AS NOTED	PROJECT NO. LEK-81-0044	DRAWING NO. AC-2121	SHEET 2 OF 6	




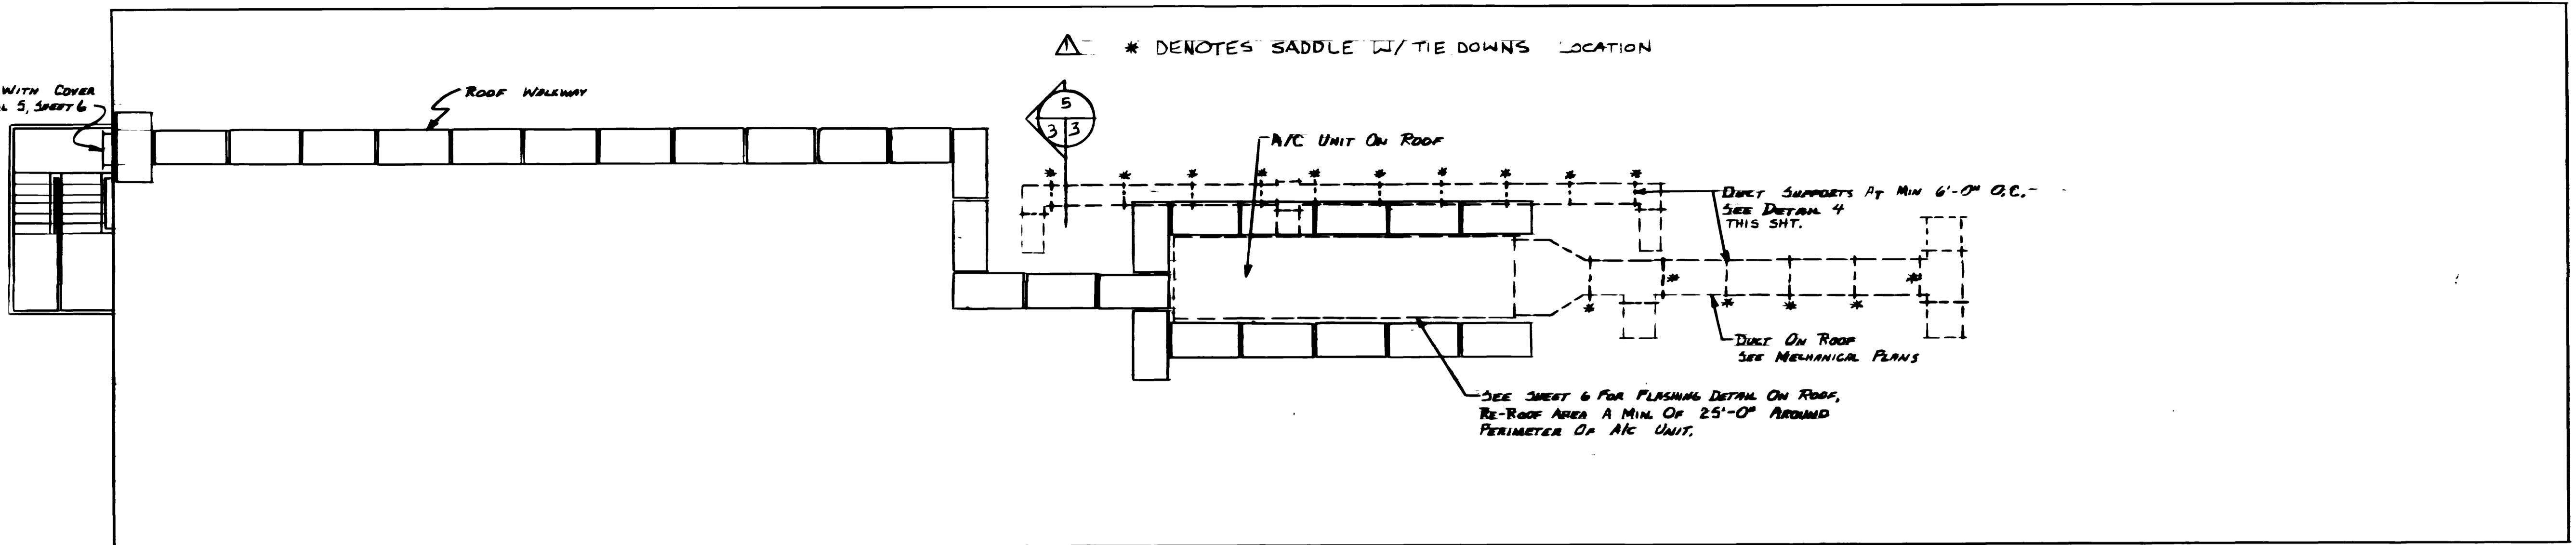


**ROOF PLAN**  
1/8"=1'-0"


**NOTES:**  
 1) ROOF WALKWAY SHALL BE TER-MASTIC ROOFWALK BY J & P PETROLEUM PRODUCTS OR EQUIVALENT, 1/2" S/P 72". SHIP ON LAGER CANALS, CLEAN ROOF WITH COMPRESSED AIR & METALL ROOFWALK IN ACCORDANCE WITH MANUFACTURER'S INSTRUCTIONS.

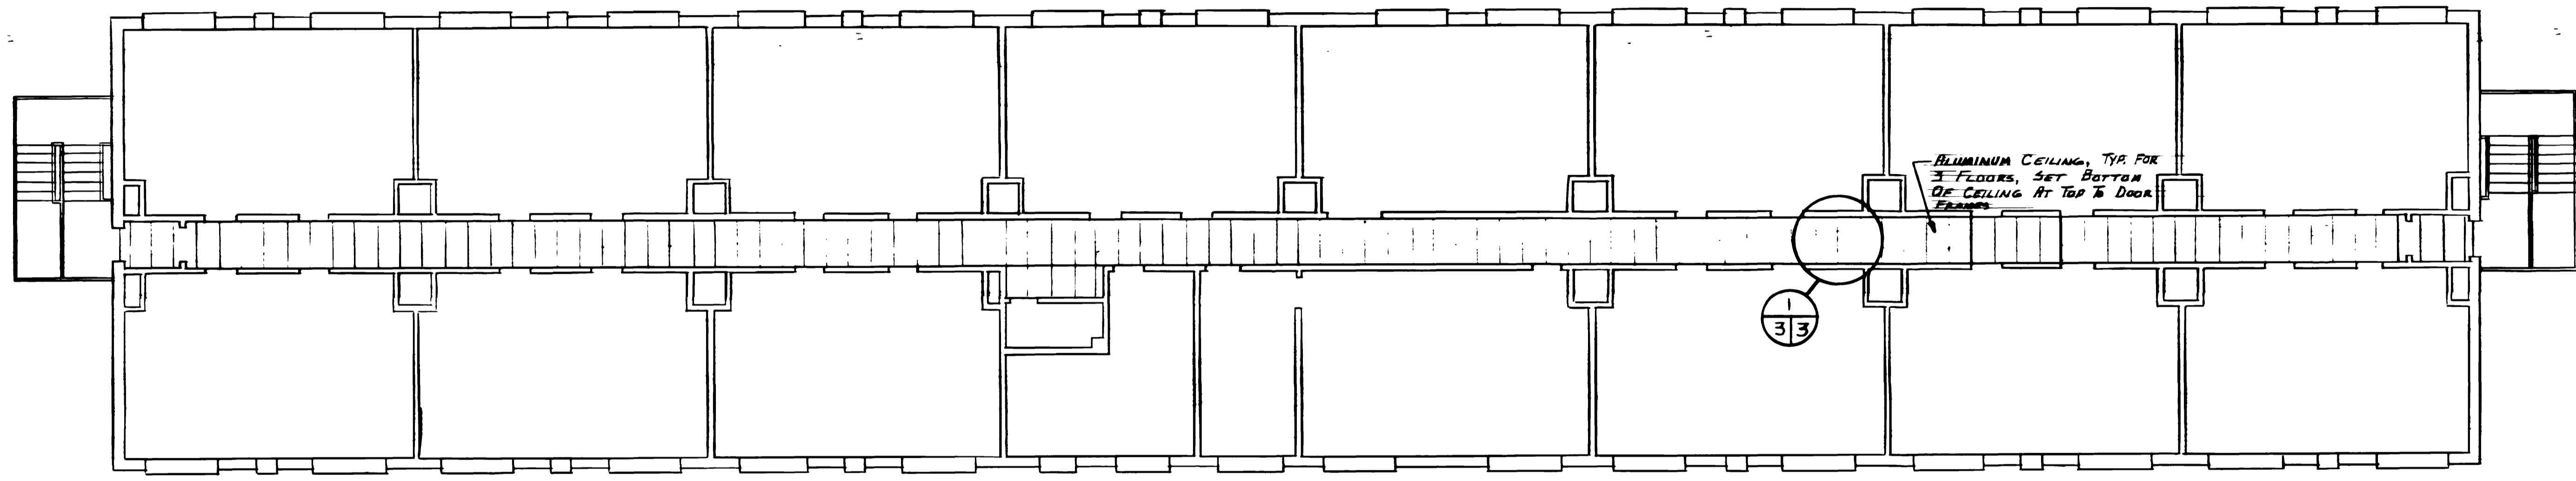


**TYPICAL REFLECTED CEILING PLAN**  
1/8"=1'-0"

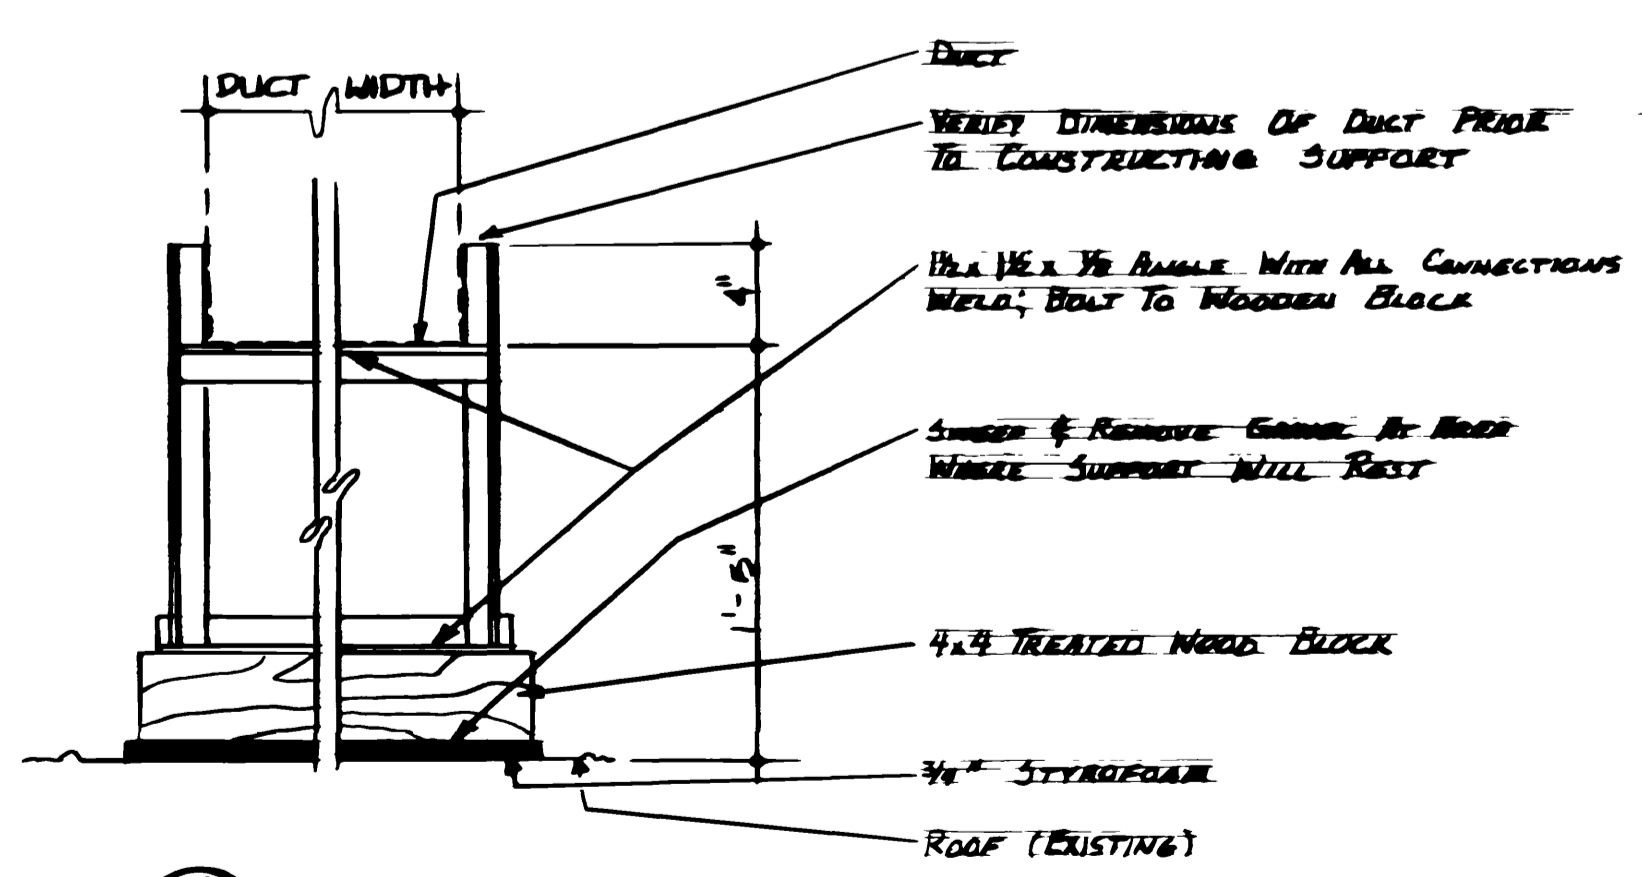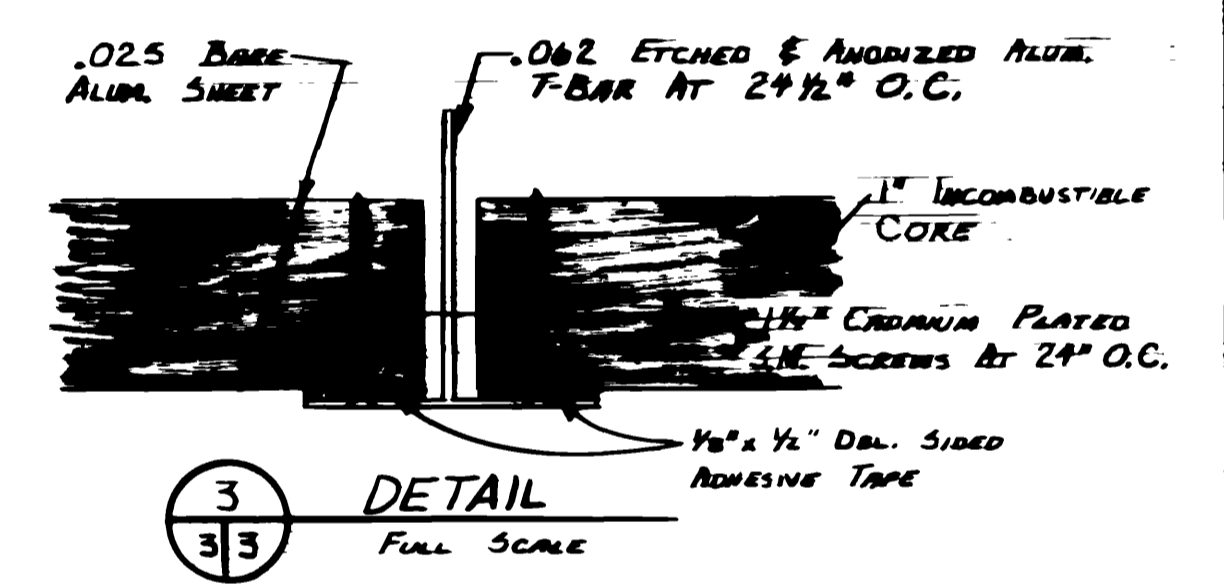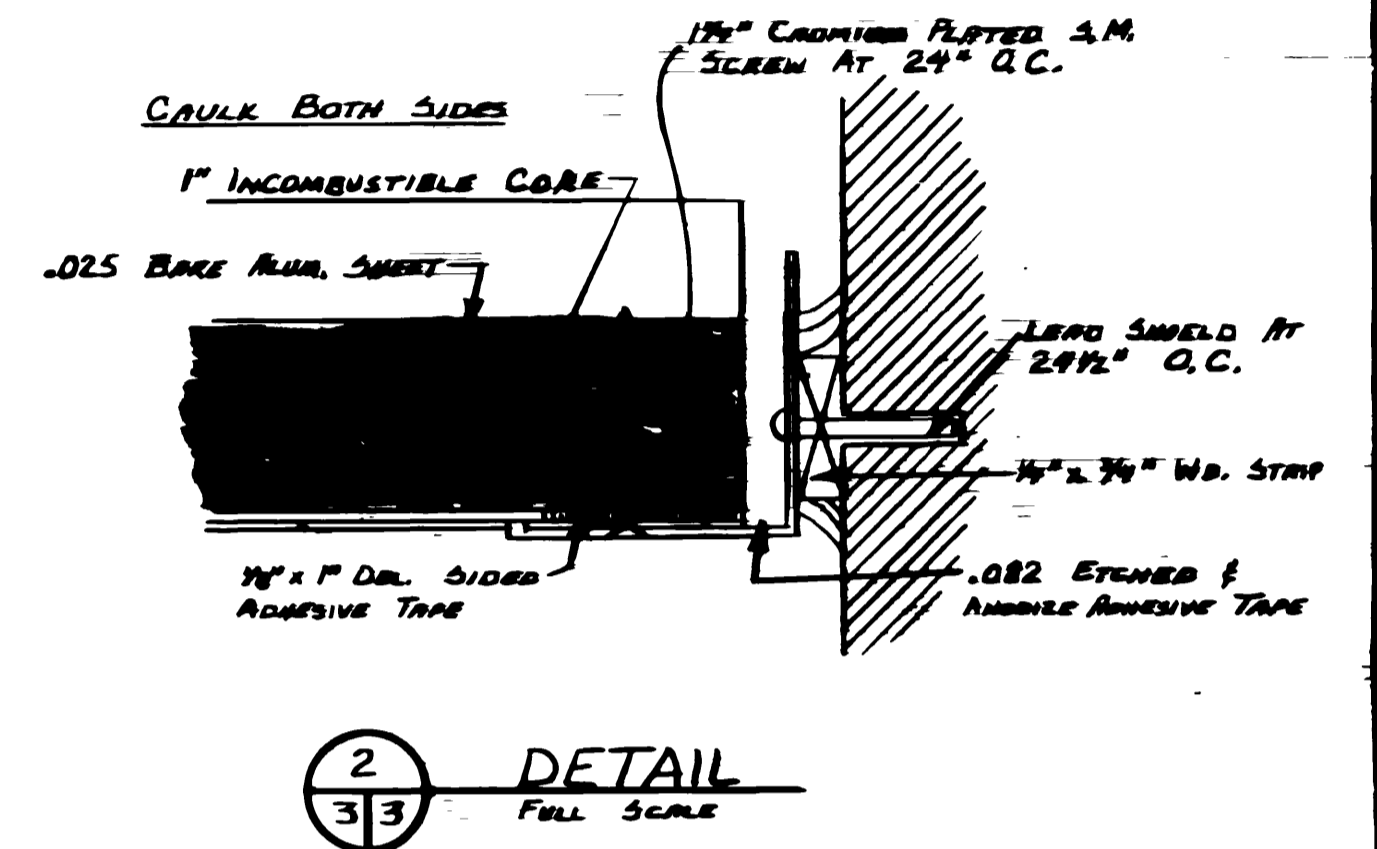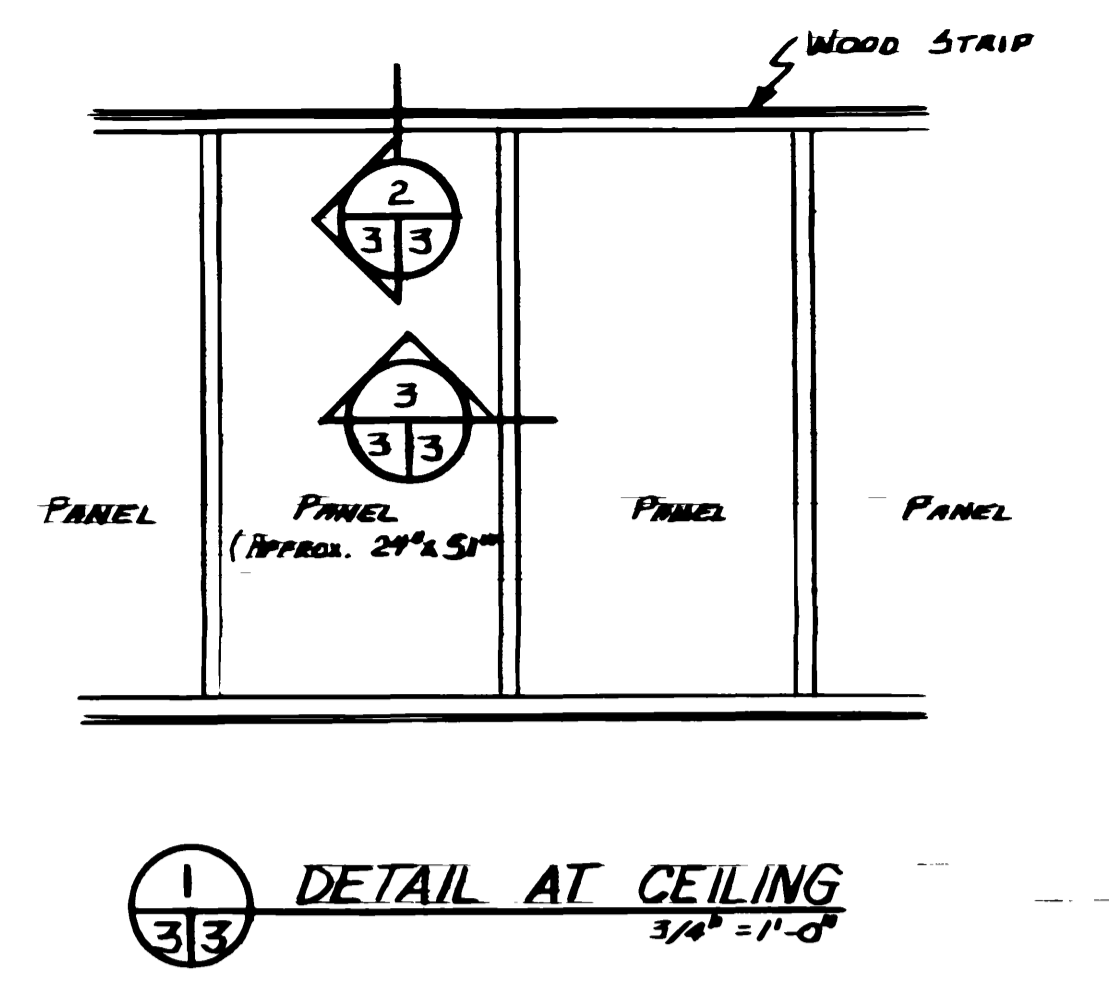

4  
3/3  
DETAIL  
1/2"=1'-0"

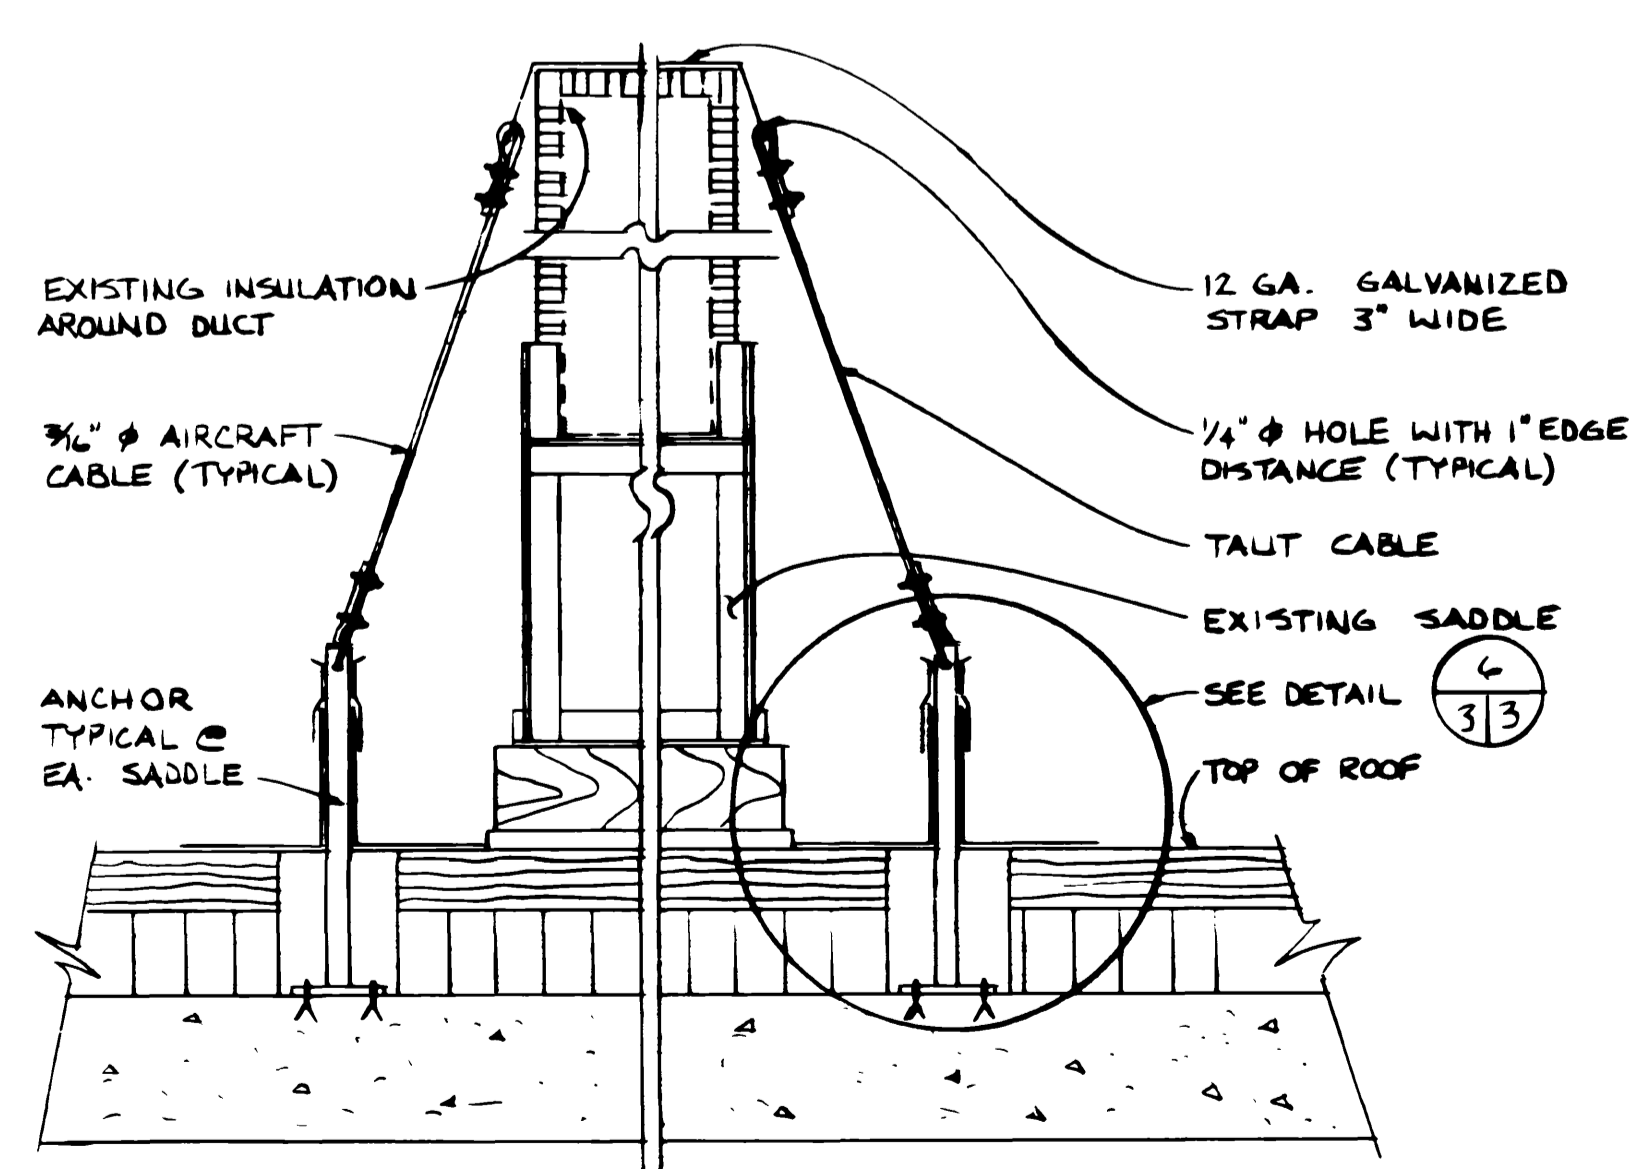

5  
3/3  
SADDLE TIE DOWNS  
SCALE 1 1/2"=1'-0"  
16 UNITS REQ'D

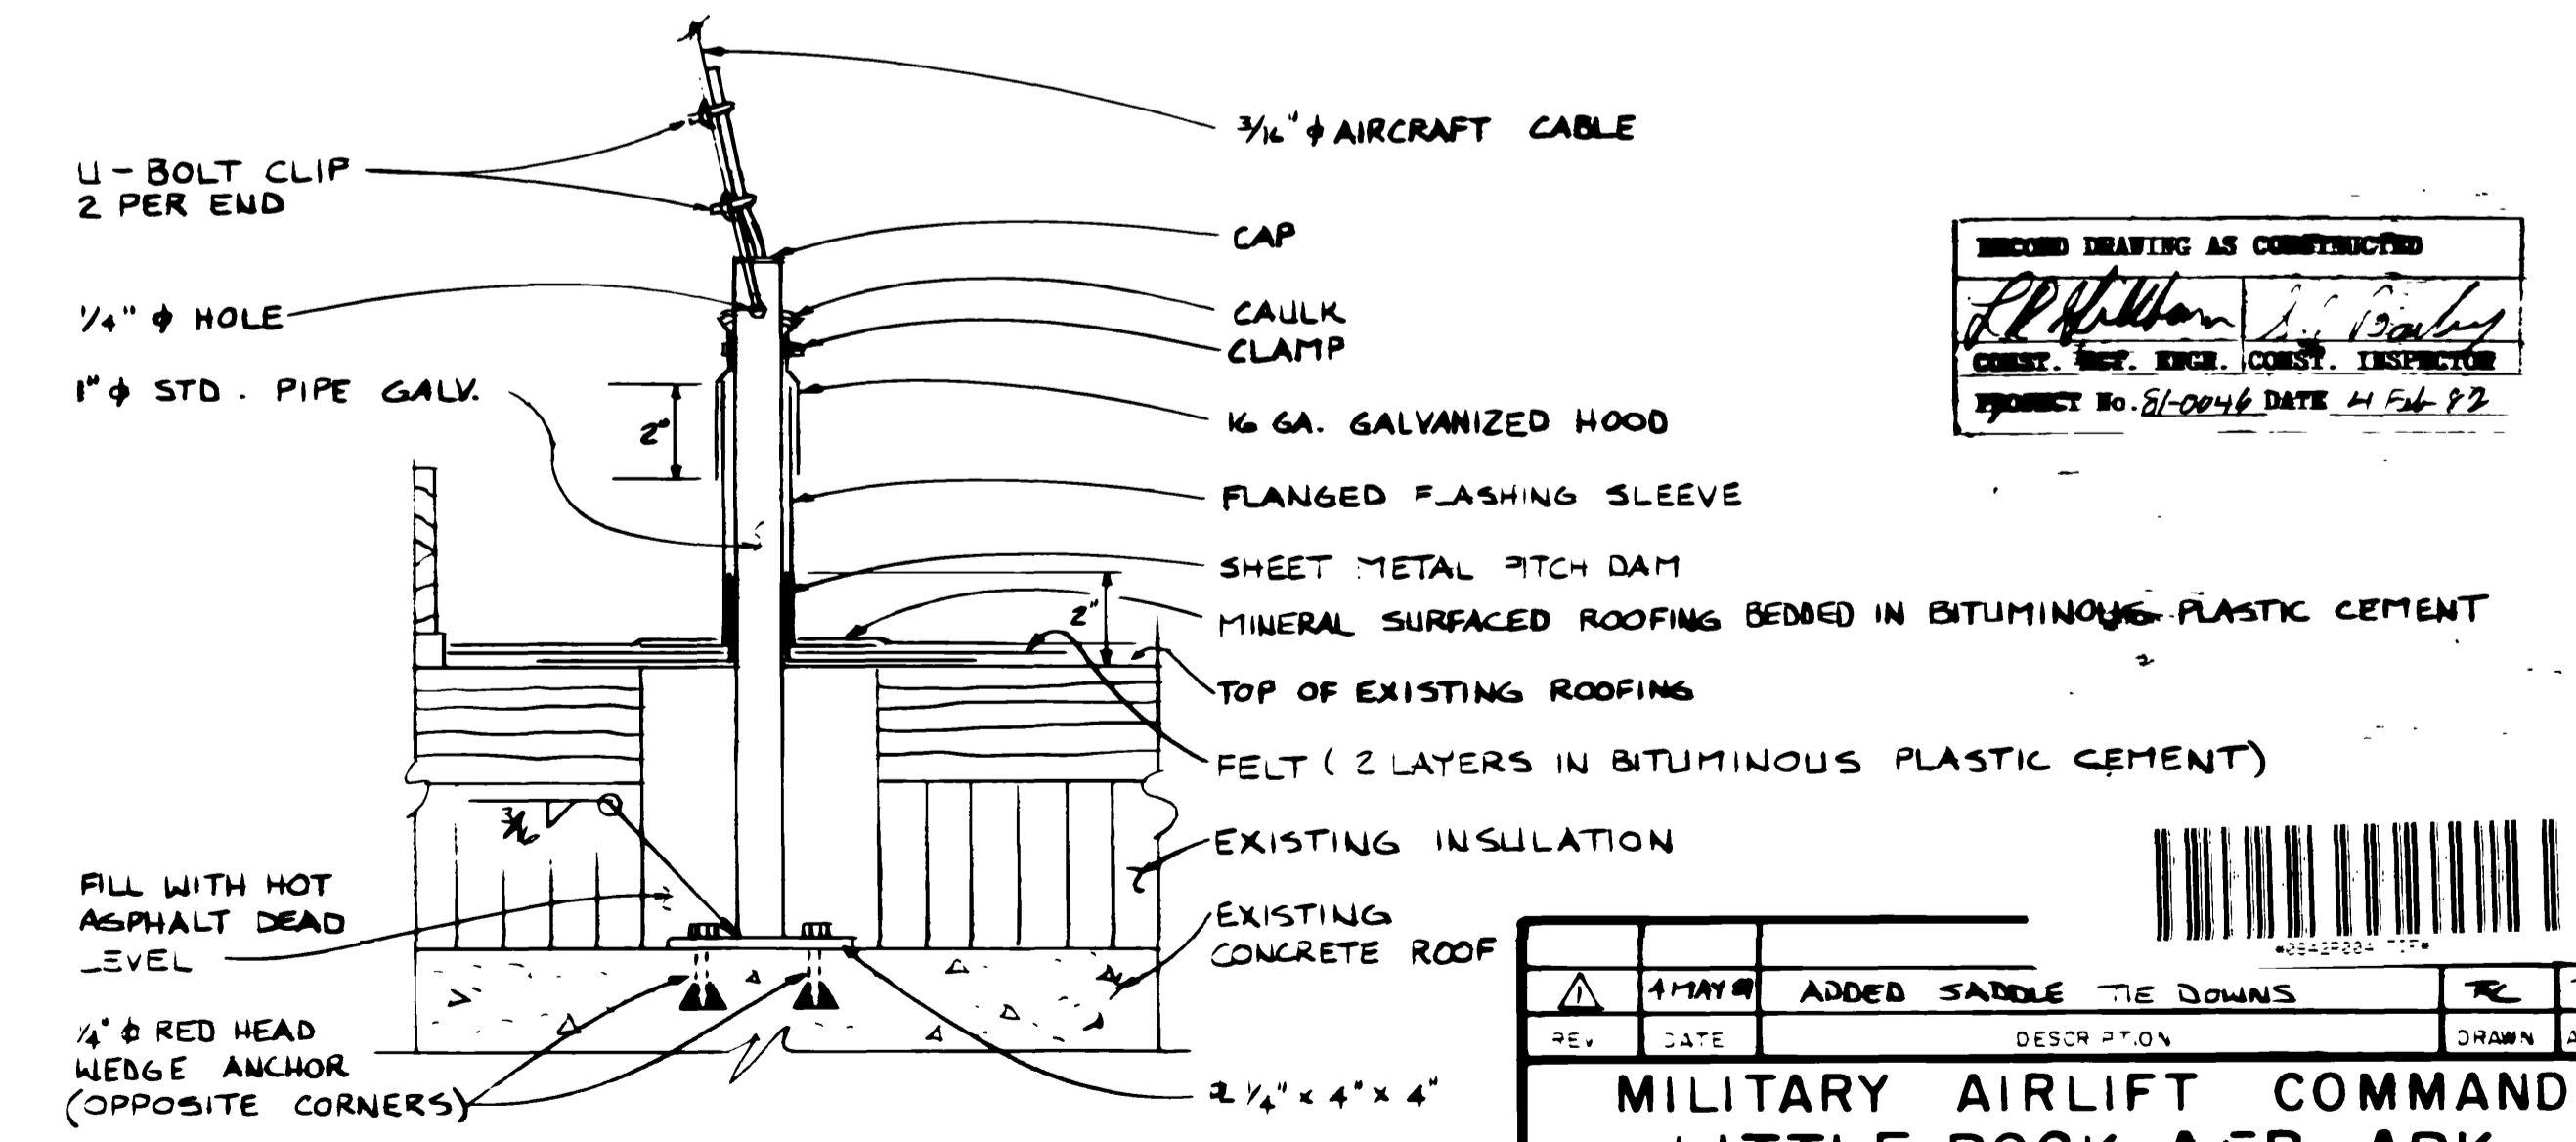


6  
3/3  
ANCHOR DETAIL  
SCALE 3"=1'-0"


RECORD DRAWING AS CONSTRUCTED

PROJECT NO. 81-0046 DATE 4/5/80


REV.	DATE	DESCRIPTION	DRAWN	APPROV.
1	4/11/80	ADDED SADDLE TIE DOWNS		
<b>MILITARY AIRLIFT COMMAND LITTLE ROCK AFB. ARK. REPLACE AIR CONDITIONING BLDG. 842</b>				
<b>ARCHITECTURAL REFLECTED CEILING &amp; ROOF PLAN</b>				
DRAWN BY	TECH. REVIEWER	DESIGNED BY	LEAD DESIGNER	DATE
ELLISON				JUNE 80
SCALE	PROJECT NO.	DRAWING NO.	SHEET	
AS NOTED	LRR-81-0046	AC-2121	3 OF 6	

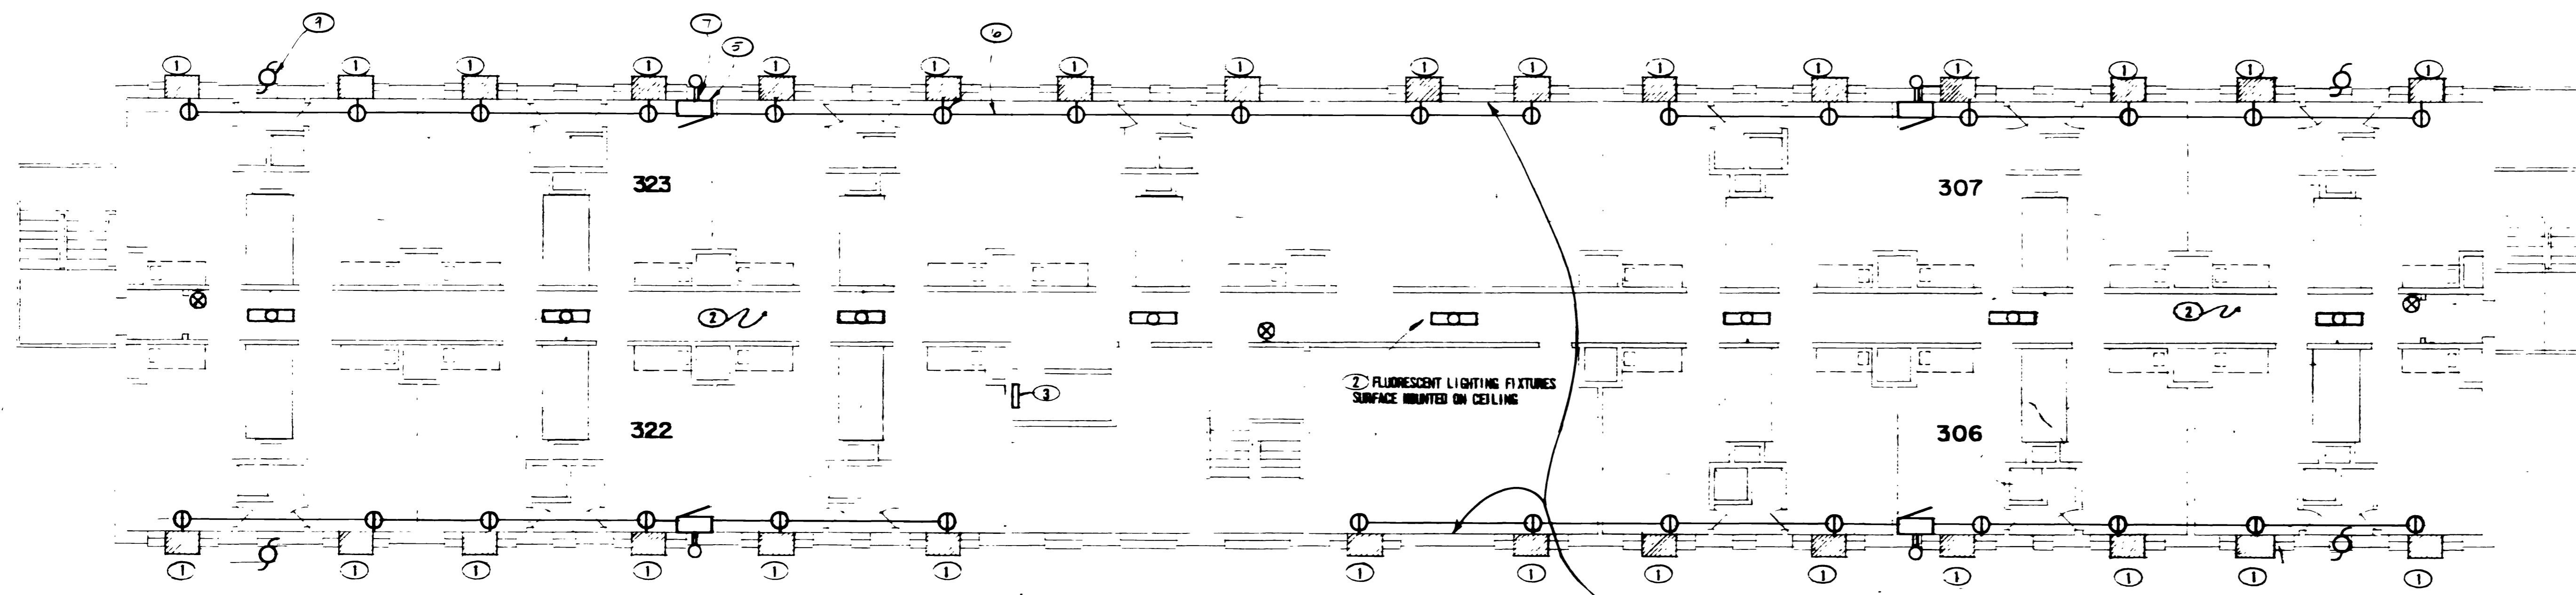

DEMOLITION THIRD FLOOR PLAN  
1/8"=1'-0"

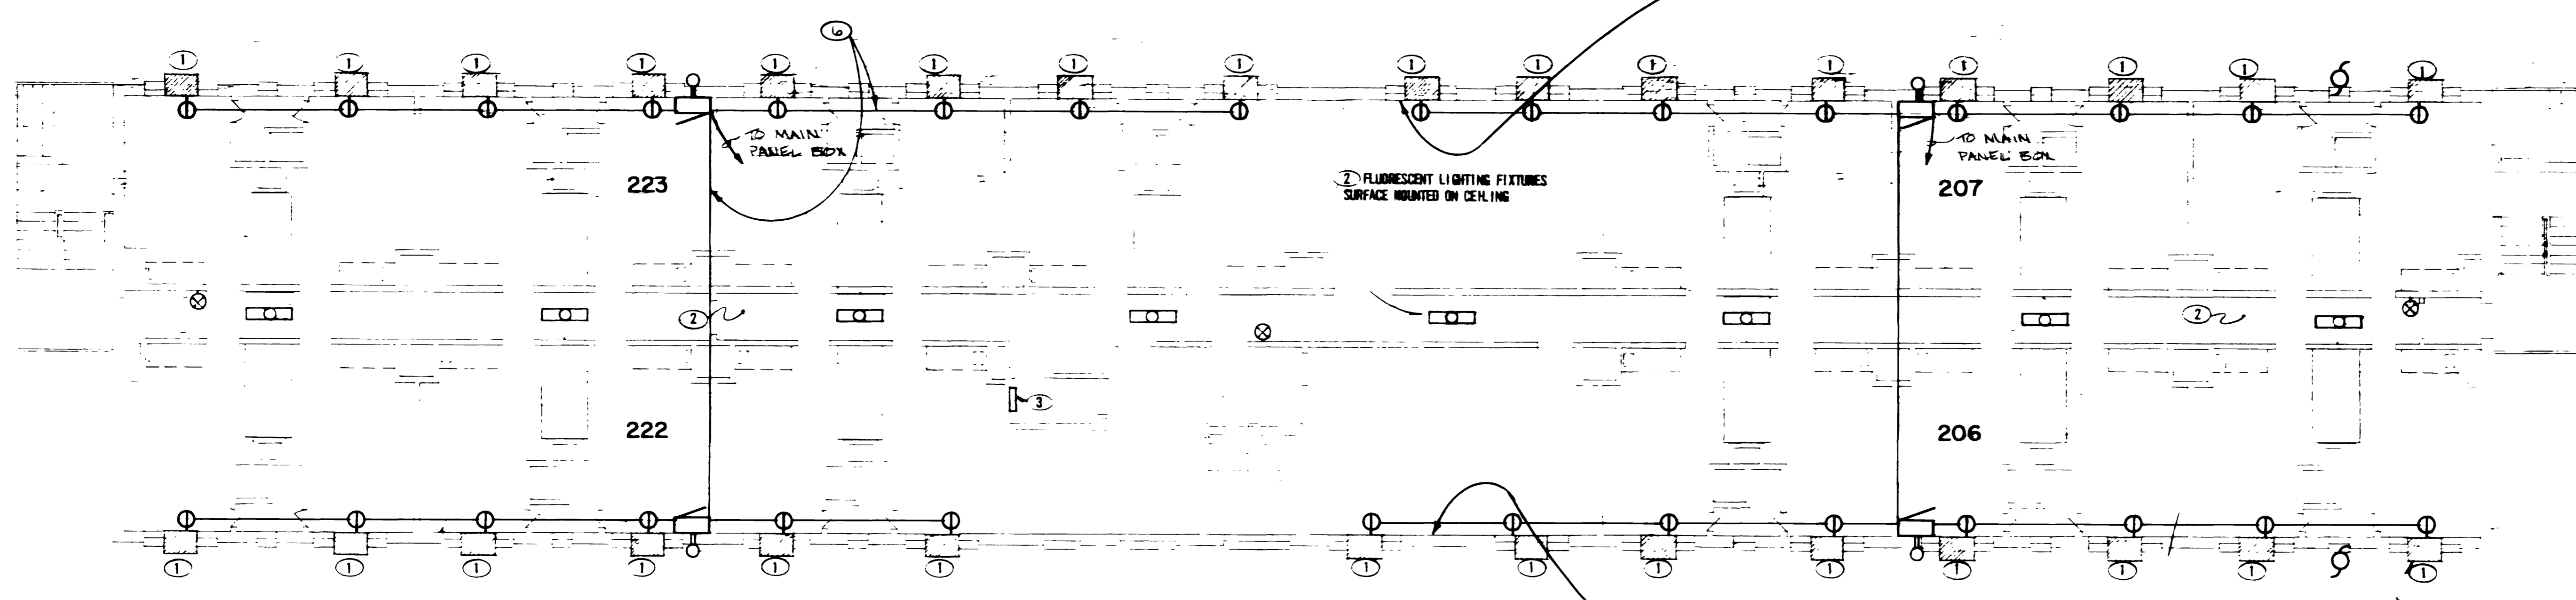

DEMOLITION SECOND FLOOR PLAN  
1/8"=1'-0"

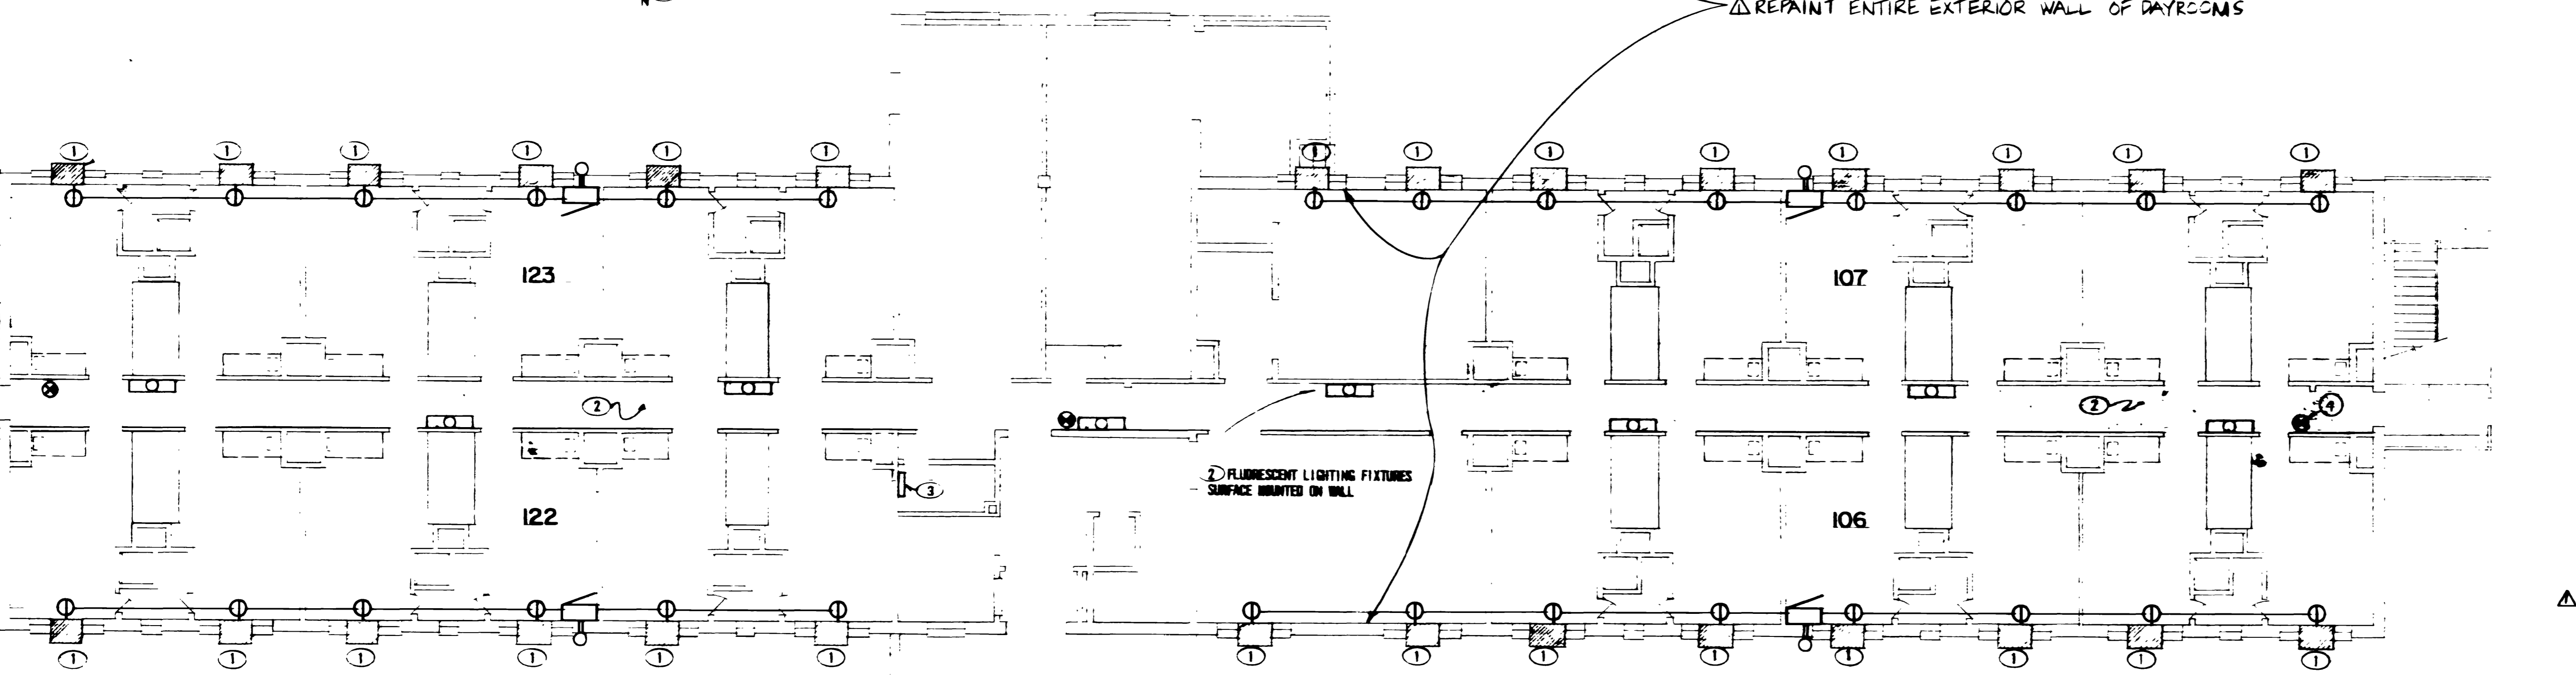

DEMOLITION FIRST FLOOR PLAN  
1/8"=1'-0"

DEMOLITION NOTES

- ① REMOVE WINDOW A/C UNITS. AIR FORCE TO REPLACE SCREENS. A/C UNITS TO REMAIN PROPERTY OF AIR FORCE. DELIVER TO BLDG 570
- ② REMOVE EXISTING LAY-IN CEILING FLUORESCENT LIGHTING FIXTURES & HEAT DETECTORS FOR ENTIRE CORRIDOR (SHARED AREA). ALL WALL MOUNTED LIGHT FIXTURES & HEAT DETECTORS SHALL BE REUSED. CONTRACTOR SHALL FIELD VERIFY ALL ELECTRIC CIRCUITS PRIOR TO DEMOLITION. EXISTING CIRCUITS SHALL BE REUSED.
- ③ EXISTING ELECTRIC PANELS.
- ④ TYPICAL REMOVE ENT LIGHT. SEE NOTE 14 SHEET 5076.
- ⑤ REMOVE & DISPOSE OF 12 1/2" BREAKER PANEL BOARDS LOCATED IN ROOMS 106, 107, 122, 123, 206, 222, 223, 306, 307, 322, & 323.
- ⑥ REMOVE ALL OLD SURFACE MOUNTED CONDUIT, WIRE, & 220V RECEPTACLES FROM EACH DOWN ROOM ALONG EXTERIOR WALL.
- ⑦ REMOVE 2" CONDUIT FROM OUTSIDE THAT CONNECTS PANELS ON FLOORS 1, 2, & 3. THERE ARE FOUR (4) LOCATIONS. SEE ELECTRIC DEMOLITION PLAN THIS SHEET.
- ⑧ DO NOT REMOVE DRYER HOOK-UP IN LAUNDRY ROOM.
- ⑨ REMOVE EXHAUST FANS FROM ROOMS 210, 211, 310, 311 AND 326.

△ ADDITIONAL DEMOLITION NOTES


REPAIR NOTES

- 1 PATCH & PAINT ALL HOLES IN WALLS WHERE CONDUITS WERE REMOVED.
- 2 PROVIDE & INSTALL NEW WINDOWPANE ON 2 & 3<sup>RD</sup> FLOORS WHERE EXHAUST FANS WERE REMOVED.
- 3 PATCH & PAINT WALLS WHERE PANEL BOARDS ARE REMOVED.
- 4 SEAL CONDUIT WHERE IT PASSES THROUGH AN AIR CHASE WITH AN A-T TIGHT PATCH.
- 5 VMC PATCHES SHALL MATCH EXISTING.
- △ 6. WORK AREAS AND TIME OF WORK SHALL BE COORDINATED WITH USER IN ADVANCE.

LEGEND

- ⊕ FAN
- PANEL BOX
- ⊙ 220V RECEPTICAL OUTLET
- CONDUIT

TYPICAL WINDOW A/C UNITS



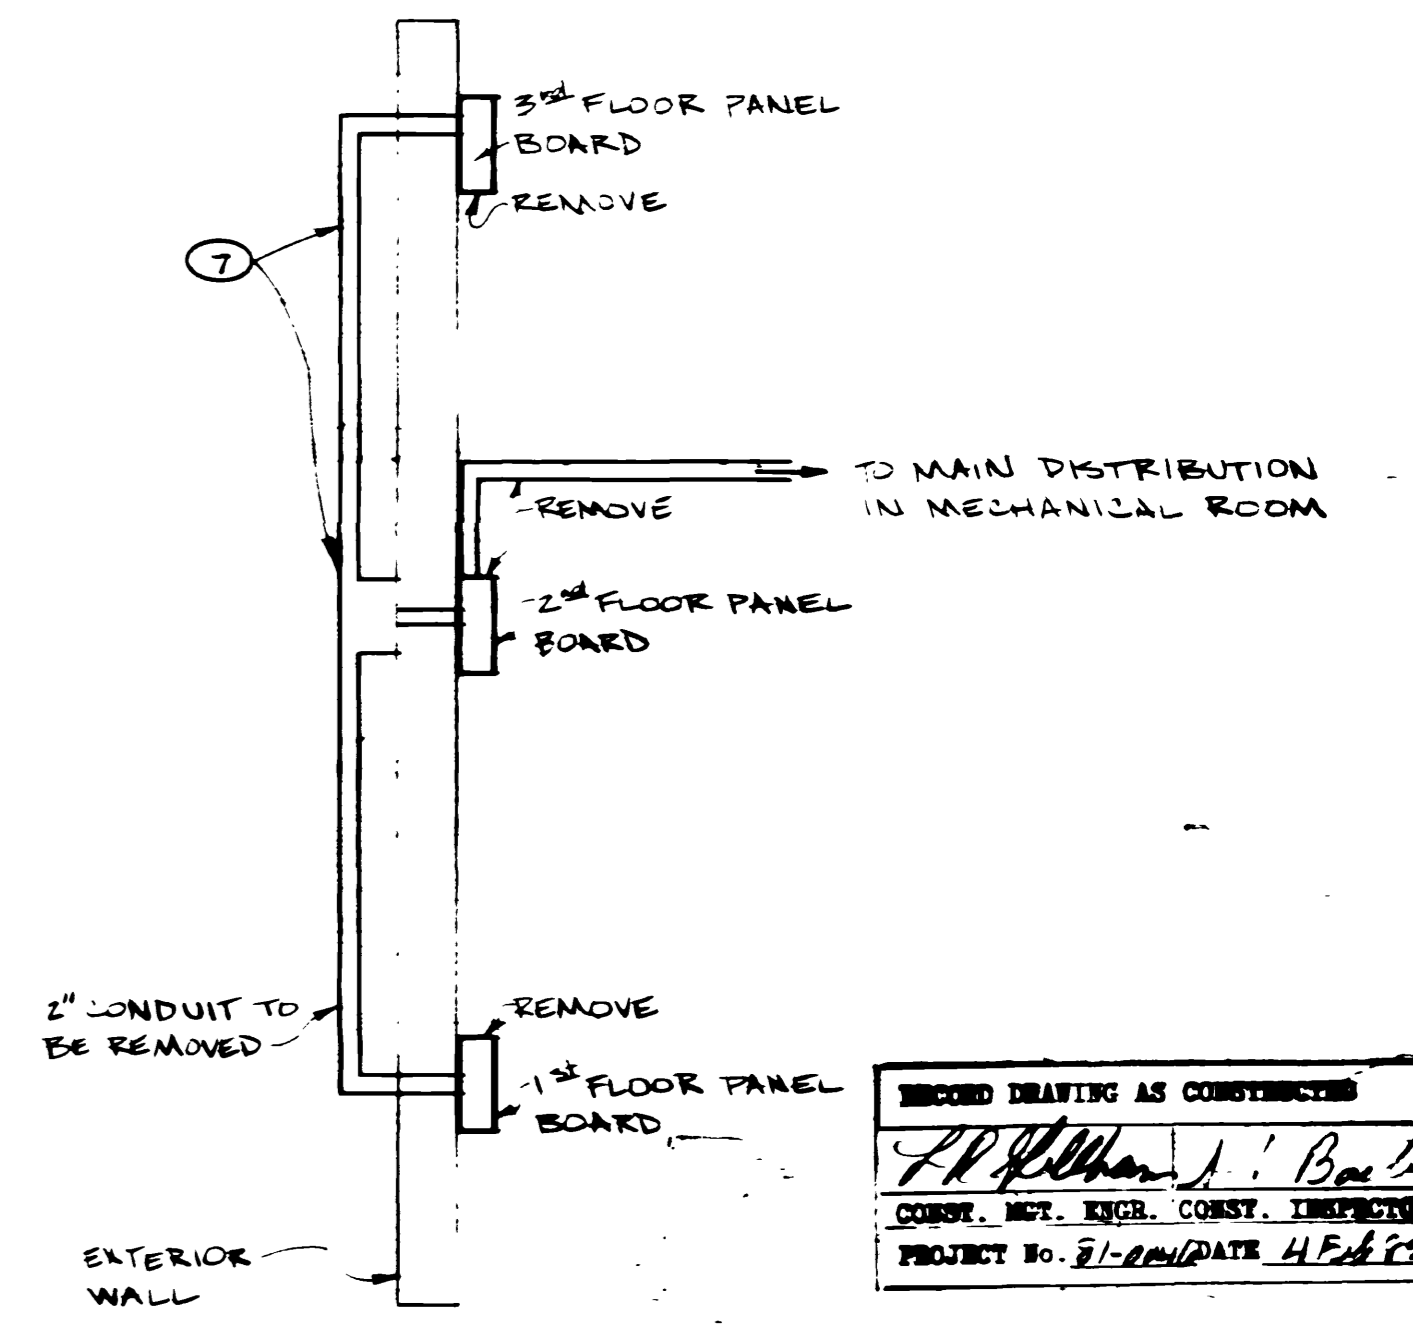


△ ELECTRICAL DISTRIBUTION PLAN

RECORD DRAWING AS CONTAINED  
*[Signature]*  
 COURSE, MTC, ECRH, CONST. IMPROVEMENT  
 PROJECT NO. 81-0004 DATE 4/28/80

NTS			
REV	DATE	DESCRIPTION	DRAWN / APPROD
1		POSTER BOARD REMOVAL OF CONDUIT, PANEL BOARDS, PANELS	
<b>MILITARY AIRLIFT COMMAND          LITTLE ROCK AFB. ARK.          REPLACE AIR CONDITIONING          BLDG. 842          MECHANICAL &amp; ELECTRICAL          DEMOLITION PLAN</b>			
DRAWN BY ELLISON	TECH REVIEWER <i>[Signature]</i>	DESIGNED BY <i>[Signature]</i>	DATE JUNE 80
SCALE AS NOTED	PROJECT NO. LRK-81-0004	DRAWING NO. AC-2121	SHEET 4 OF 6




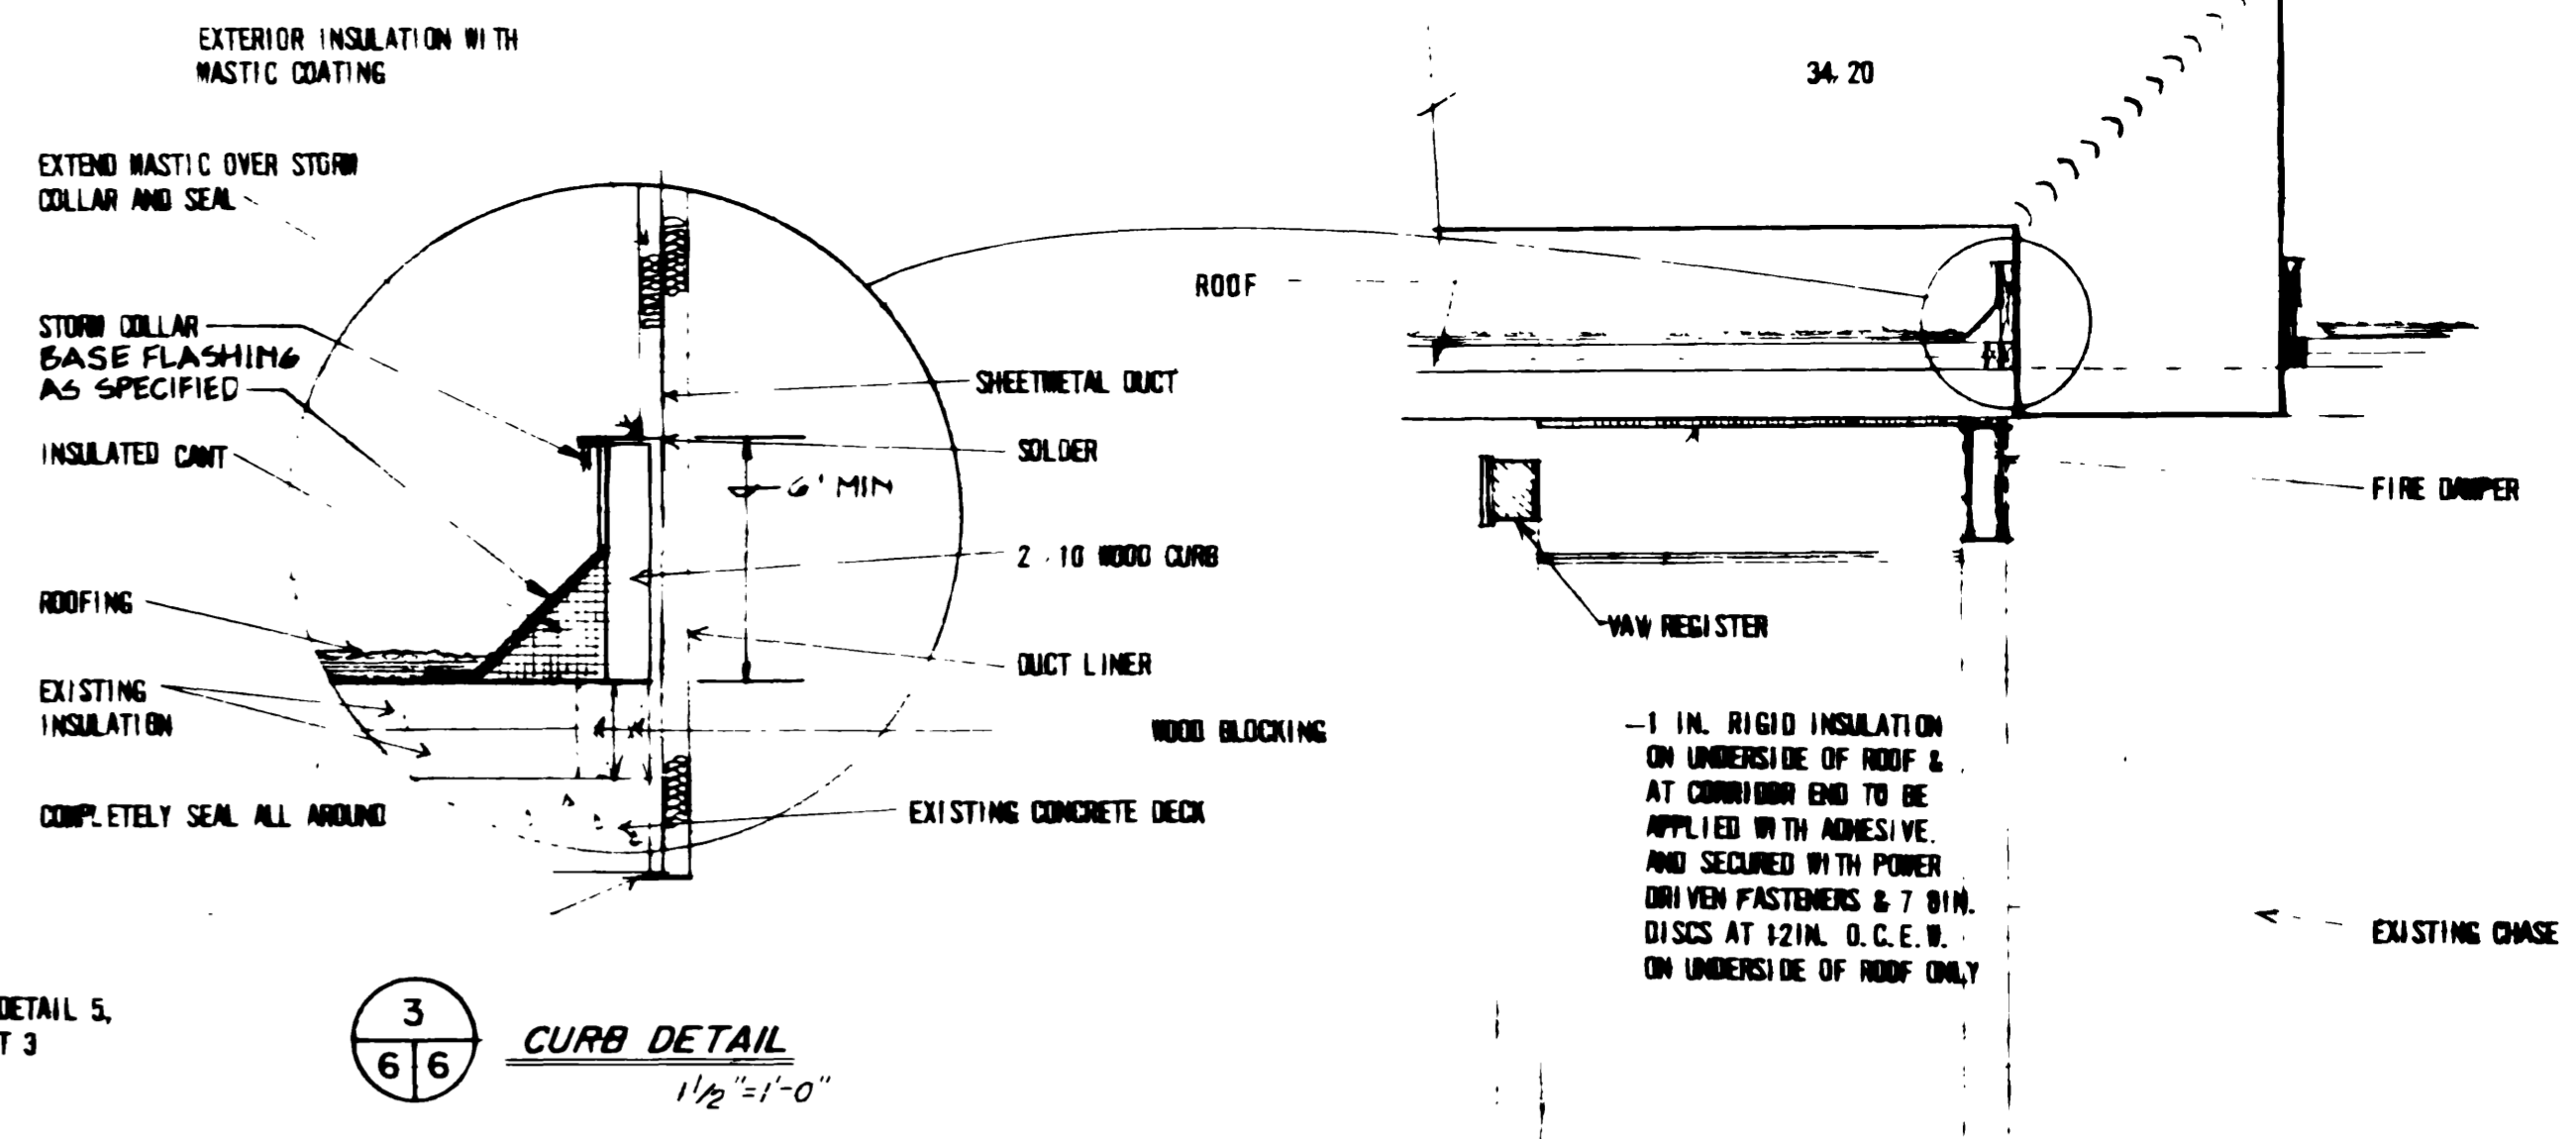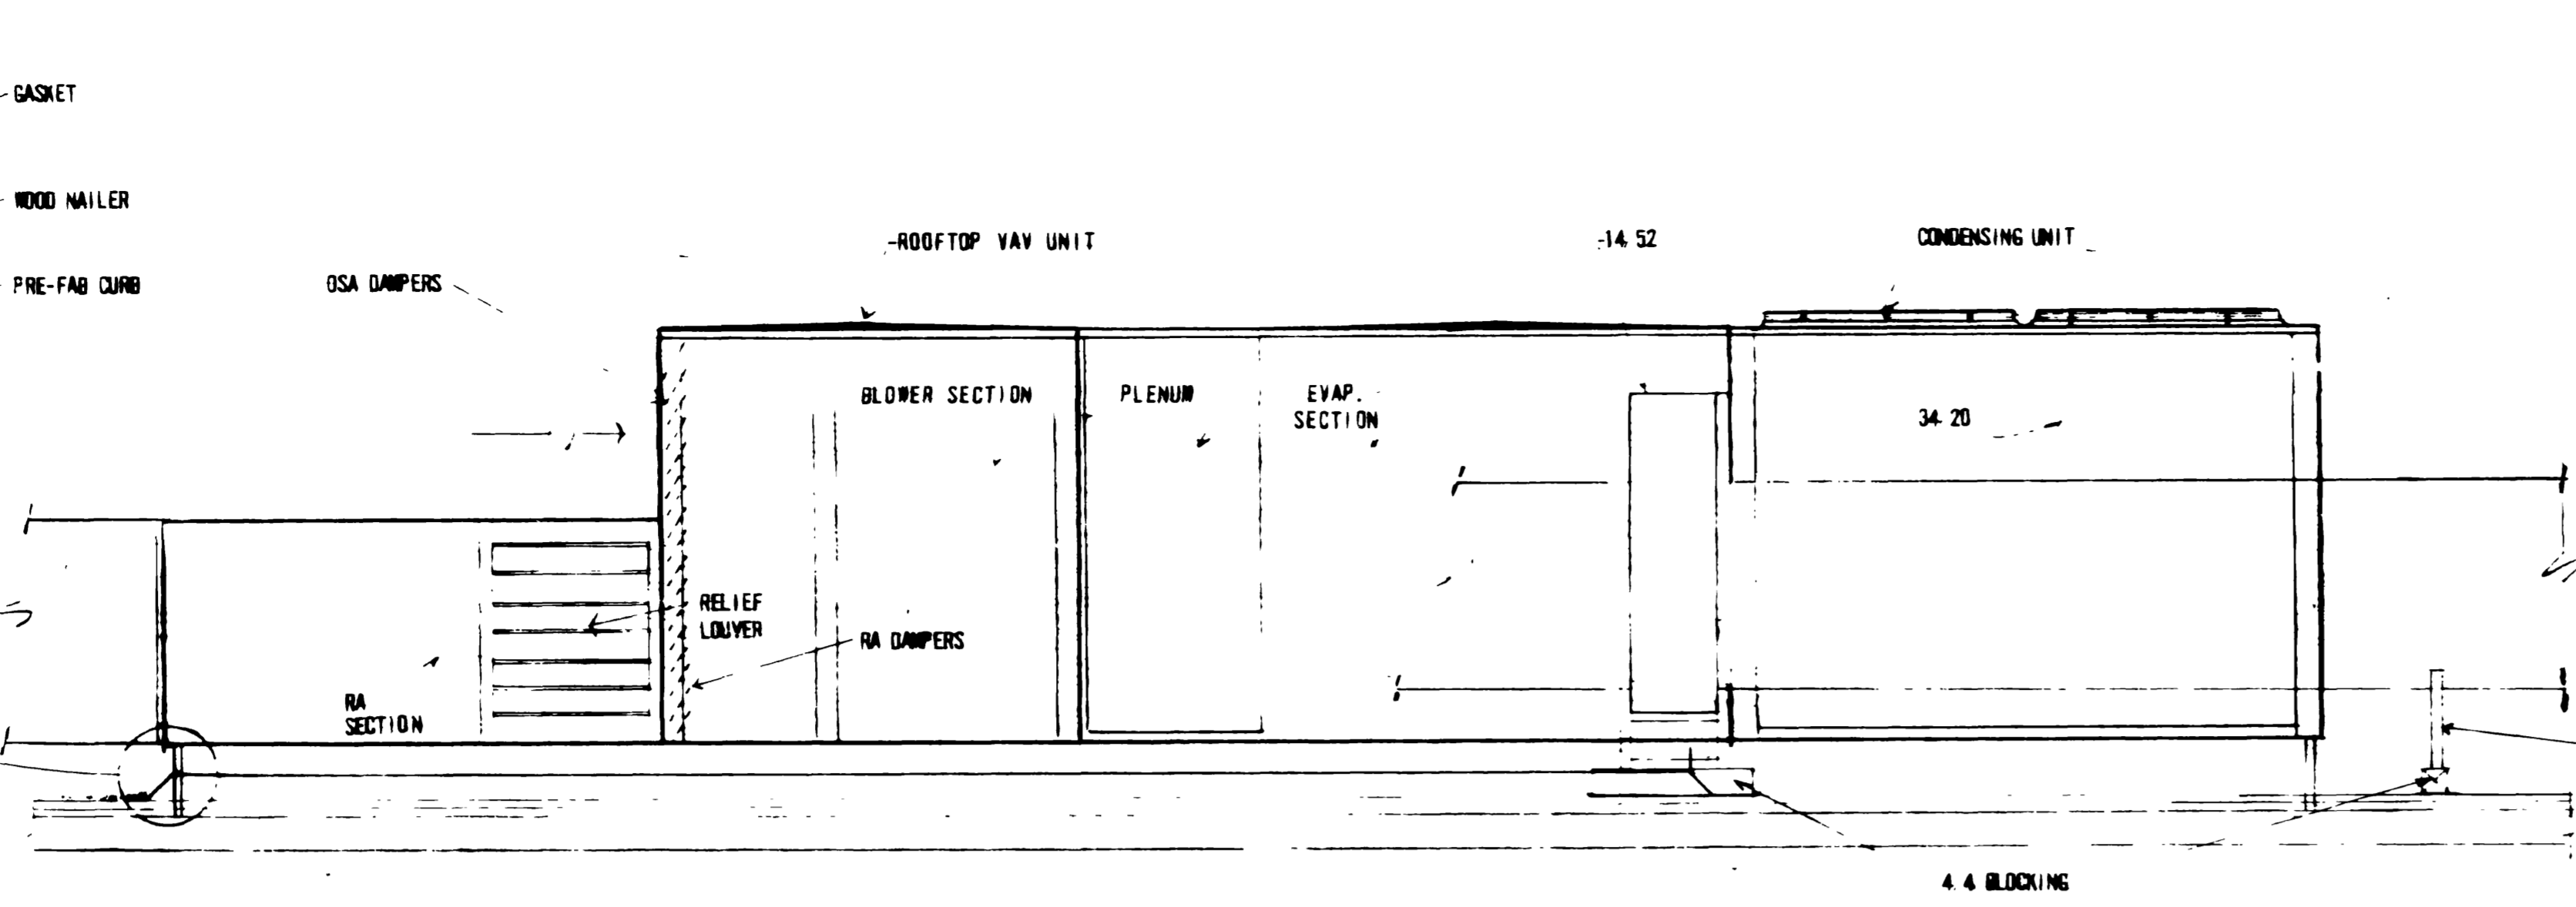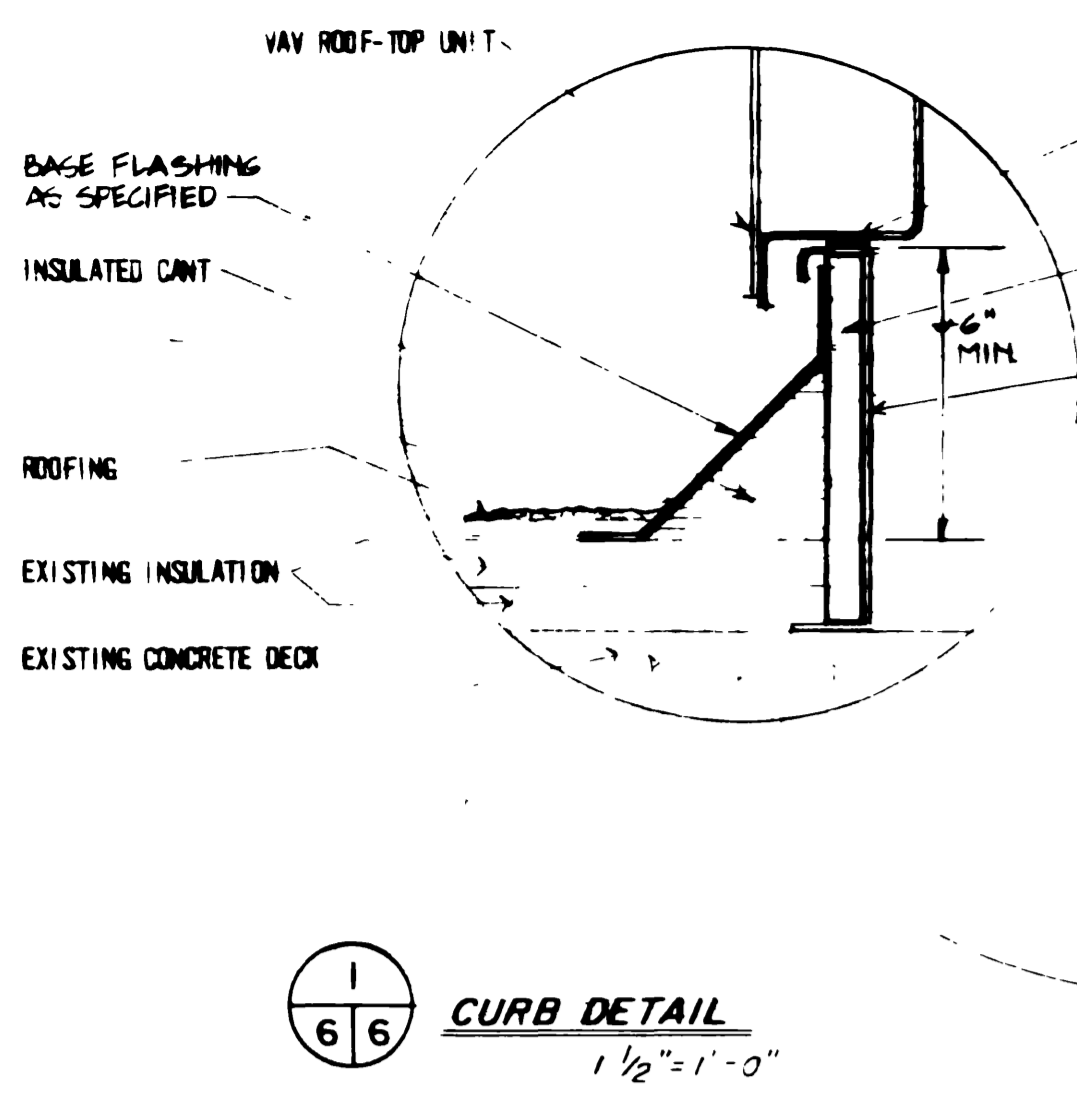

1/6/6 CURB DETAIL  
1/2" = 1'-0"

3/6/6 CURB DETAIL  
1/2" = 1'-0"

2/5/6 VAV ROOFTOP DETAIL  
1/2" = 1'-0"

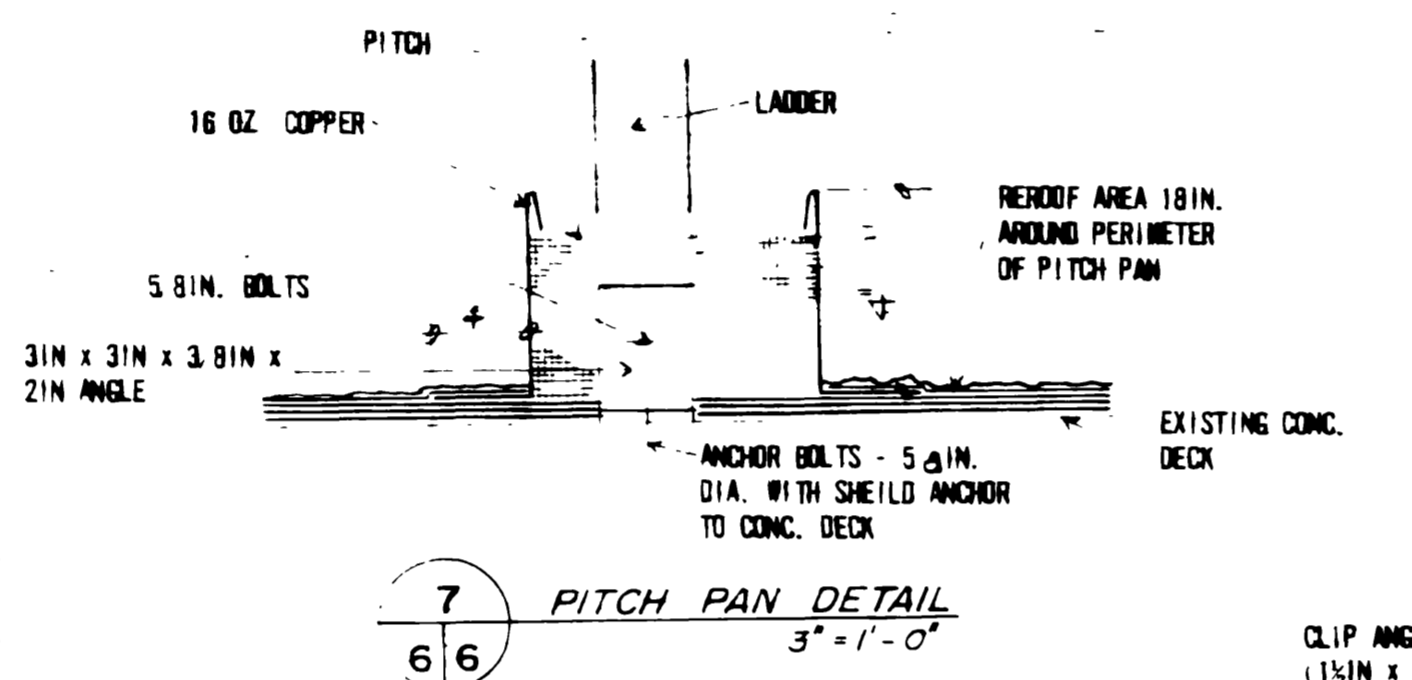


7/6/6 PITCH PAN DETAIL  
3'-1'-0"


ENERGY MONITORING & CONTROL SYSTEM														
I/O SUMMARY														
SCHEDULE	GENERAL	ANALOG DISPLAY & INDICATION			ALARMS				CONTROLS					
LEGEND	INTERCOM	TEMPERATURE (°F)	PRESSURE (PSIG)	REL. HUMIDITY (%RH)	STATUS (ON-OFF)	DAMPER POSITION	LO PRESS	HI TEMP. ANALOG	LO TEMP. ANALOG	HI % RH ANALOG	LO % RH ANALOG	HI PRESS	NW DEMAND - HIGH	NW DEMAND - LOW
C = CRITICAL ALARM														
X = REQUIRED														
BLDG	X													
VAV ROOF TOP		X	X	X	X		X	X	X	X	X	X	X	X

HVAC EQUIPMENT SCHEDULE


- ROOF TOP VAV UNIT**  
 HAMMOTH ADAPT-AIRE CEB 2067-302, 11-470CFM@1 2 IN. TSP, 3 4 IN. ESP, 8 BHP WITH 10 HP BLOWER MOTOR, 354,000 BTUH TOTAL AND 245,000 BTUH SENSIBLE CAPACITY AT CONDITIONS OF 80.29 67.2 W.B. ENTERING EVAPORATOR AND 95° AIR ENTERING CONDENSER, 59.1 57.4 W.B. LEAVING EVAPORATOR COIL, 164 FLA AT 208V 3 Ø. ACCEPTABLE MANUFACTURERS CONSIDERED AS EQUAL SHALL BE MC QUAY AND EGS.
- VAV REGISTER**  
 CONNOR CV-74 BPG, BPP CASING WITH FLAT BLACK FINISH AND GSL-GRILLE WITH BAKED ALUMINUM FINISH. MINIMUM INLET SP-0.05 INCHES. MAXIMUM INLET SP-0.20 INCHES.
- RETURN GRILLE**  
 TITUS 52-FS 1/2 1/2 CUBE CORE WITH FLANGE FRAME, BAKED ALUMINUM FINISH. ACCEPTABLE MANUFACTURERS CONSIDERED AS EQUAL SHALL BE BARBER COLEMAN AND KRUGER.
- FIRE DAMPER**  
 RUSKIN 1802 WITH A TYPE SLEEVE. ACCEPTABLE MANUFACTURERS CONSIDERED AS EQUAL SHALL BE AMERICAN WARMING AND VENTILATING & ACTION AIR.

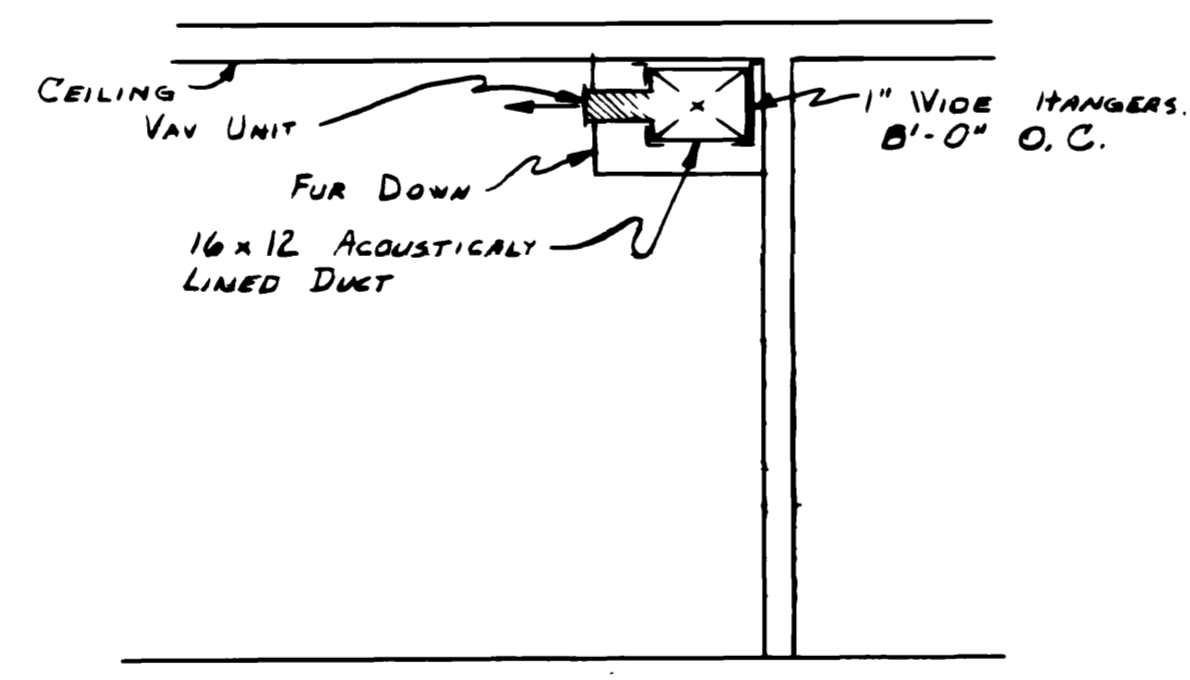


8/5/6 VAV UNIT  
SCALE: 3/8" = 1'-0"

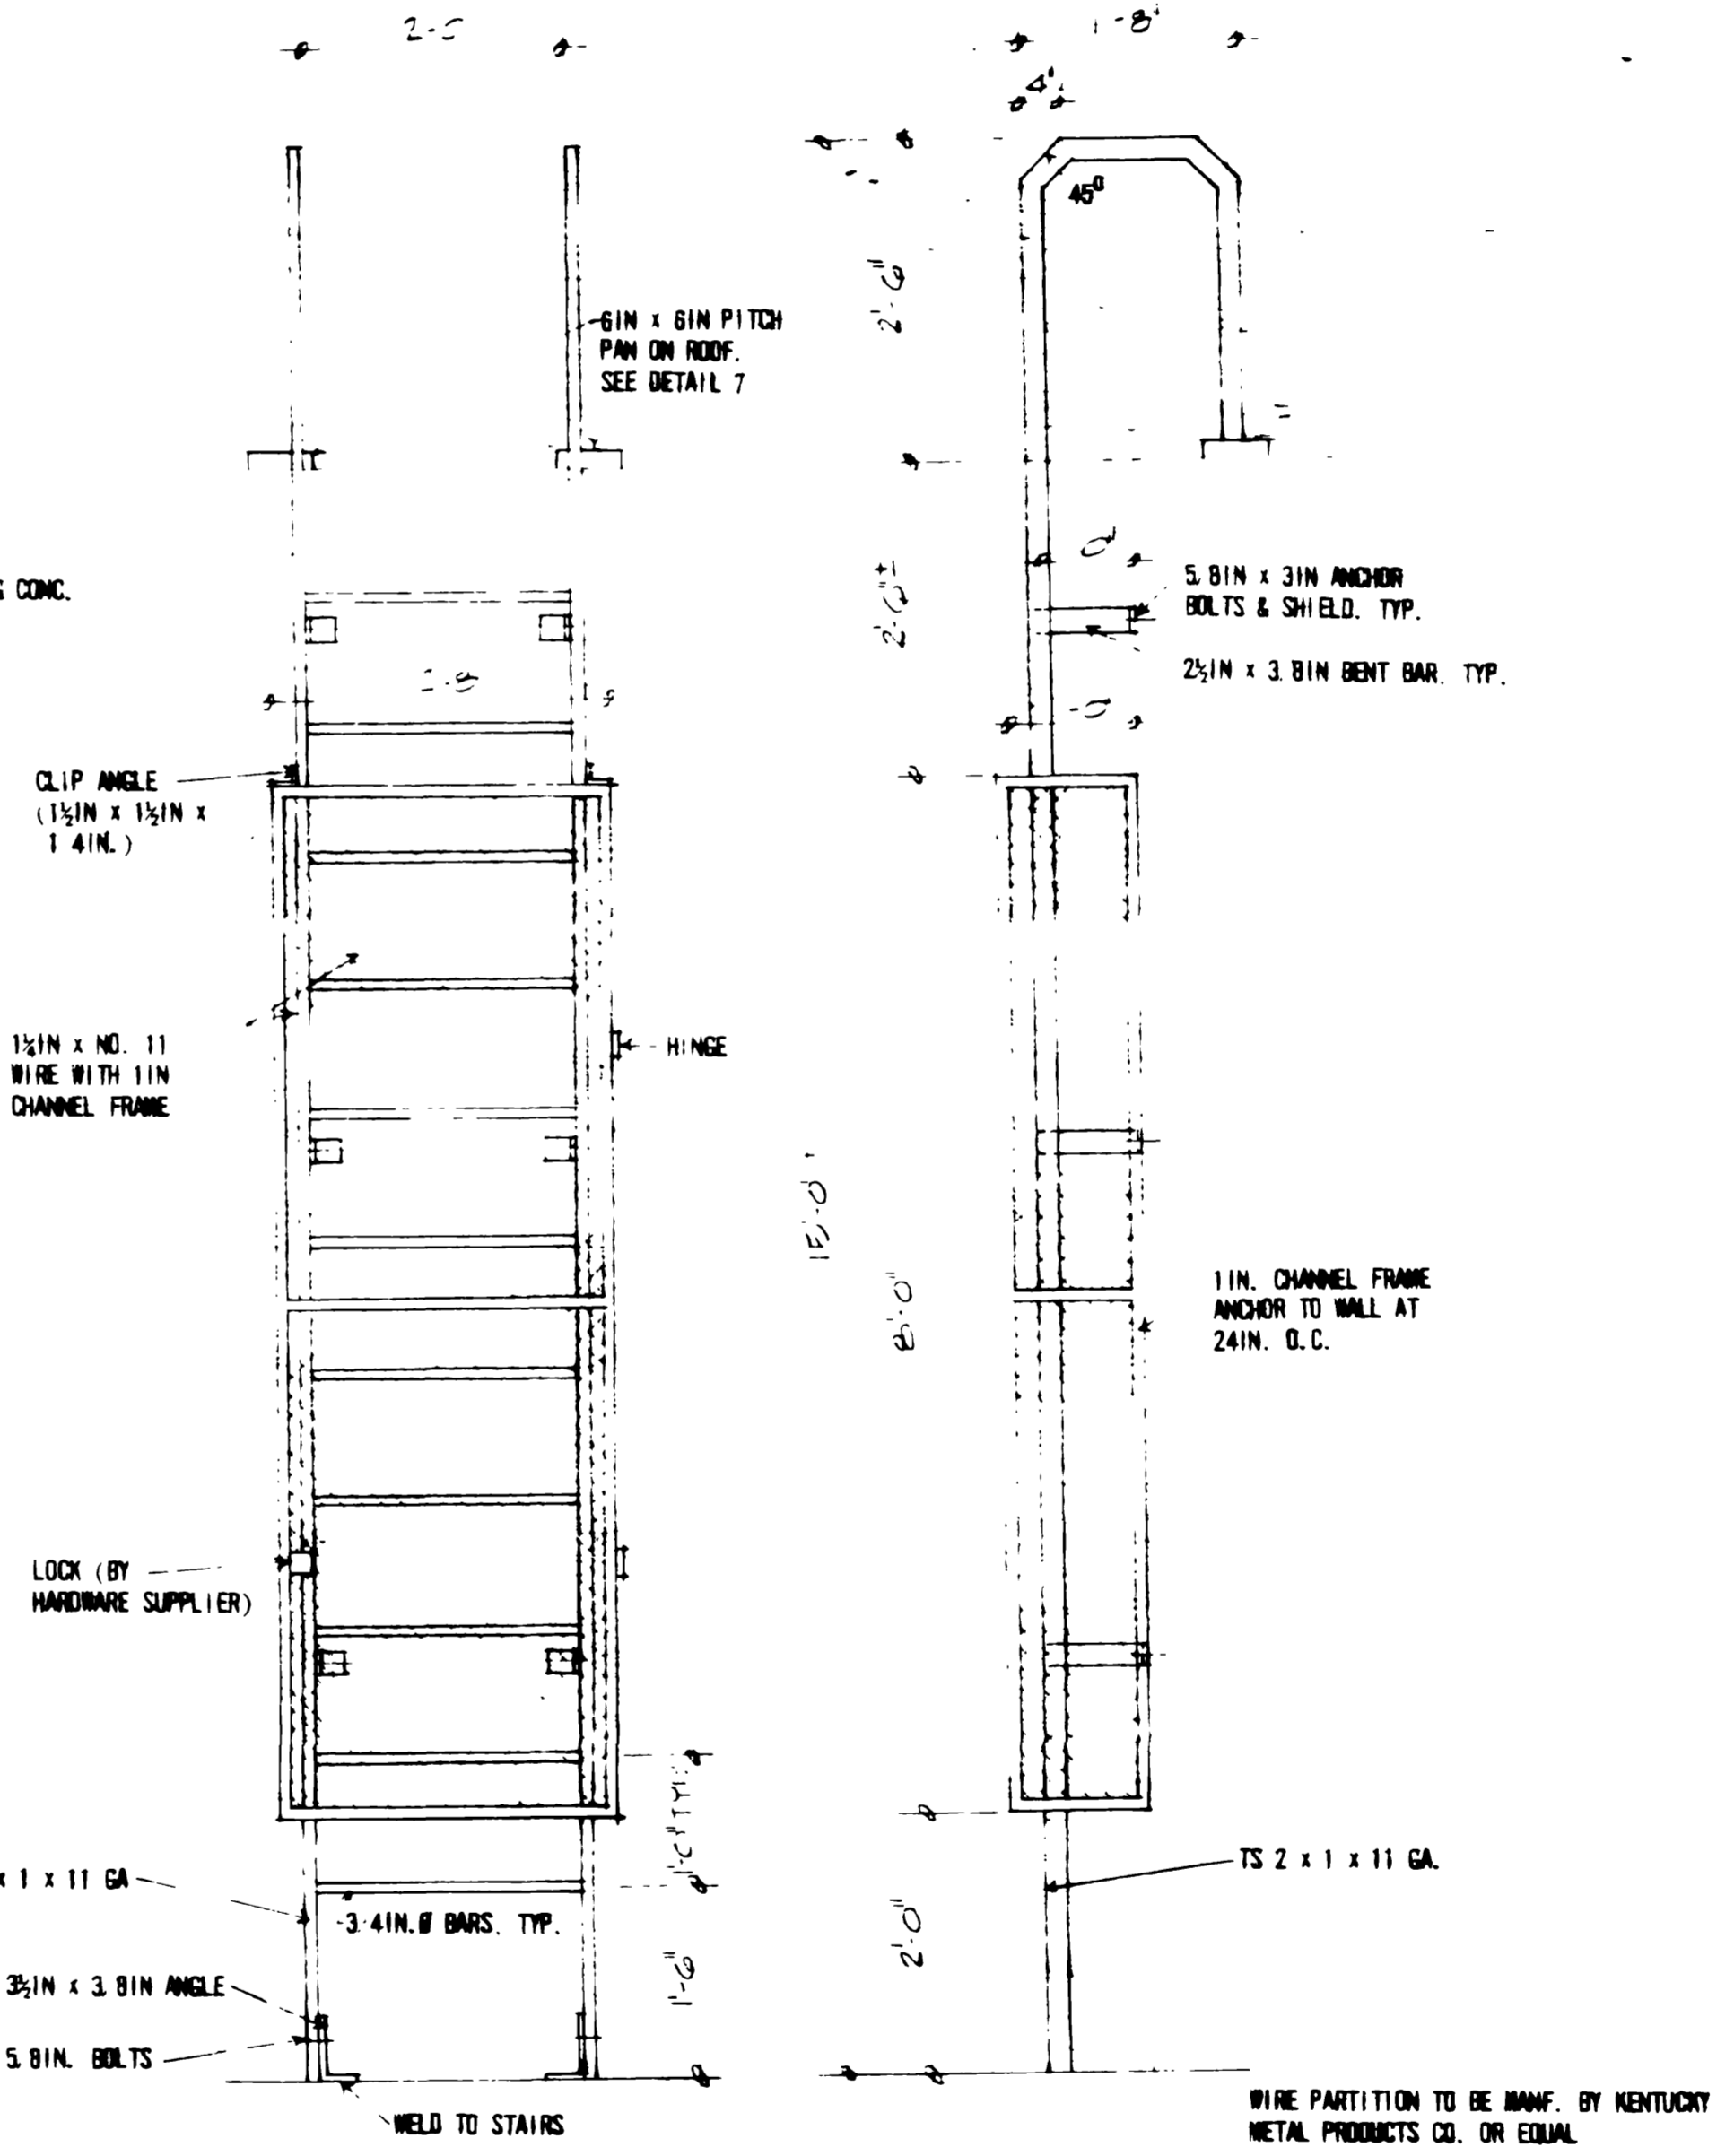

5/3/6 ELEVATION-LADDER & COVER  
3/4" = 1'-0"

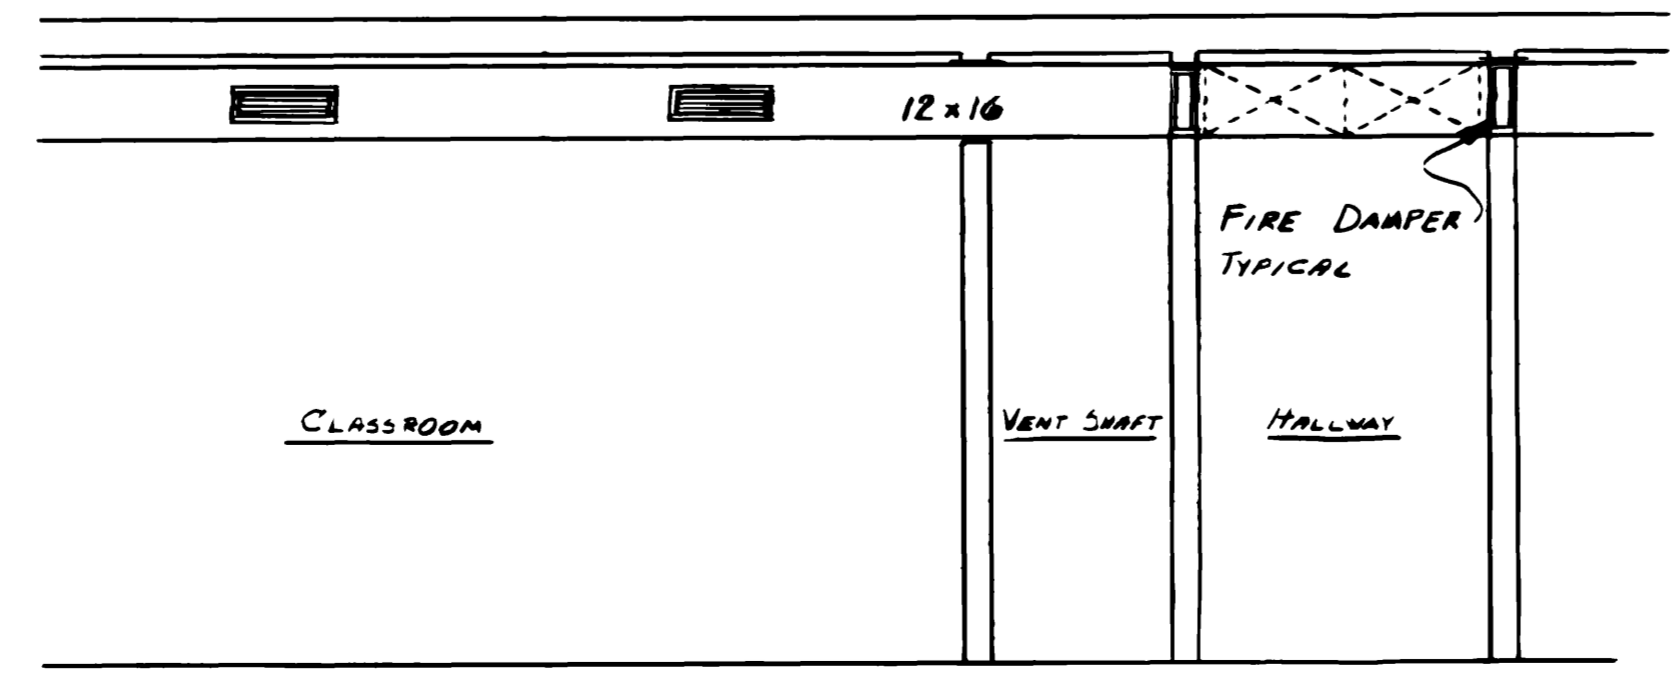

9/5/6 DUCT DETAIL  
SCALE: 3/8" = 1'-0"

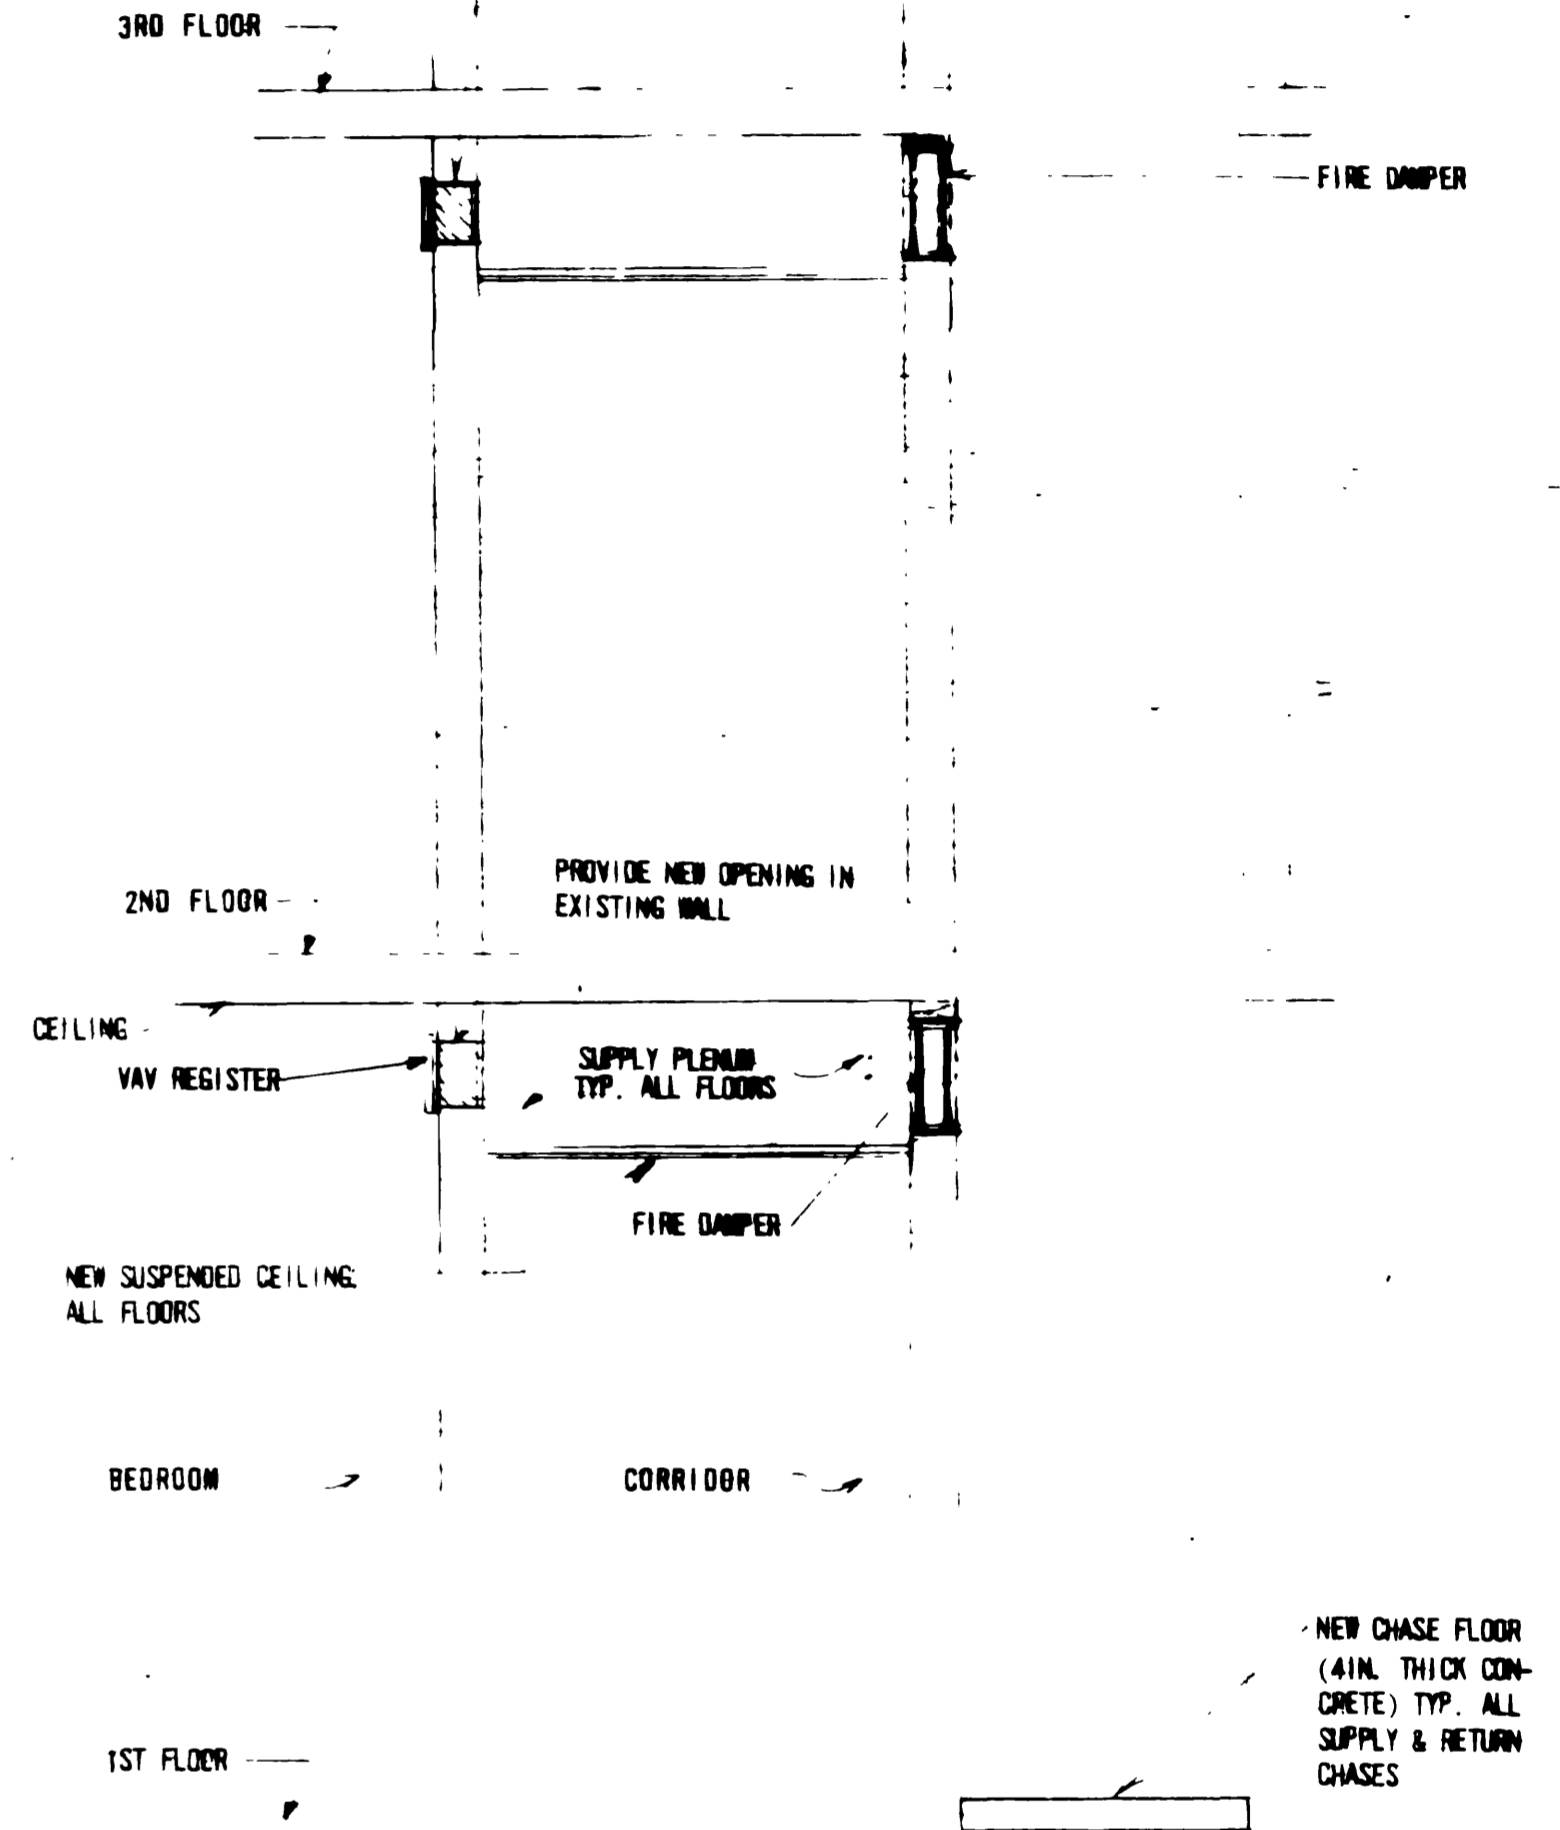


6/5/6 SECTION THRU SUPPLY CHASE  
1/2" = 1'-0"

NOTES: 1 ALL CHASE OPENINGS SHALL BE SEALED AND CAULKED TO HOLD 3/4 IN. S.P. W.C.


RECORD DRAWING AS CONSTRUCTED  
 CONST. MGT. ENGR. CONST. INSPECTION  
 PROJECT NO. 21-0046 DATE 11/2/82

REV	DATE	DESCRIPTION	DRAWN	APPRD
<b>MILITARY AIRLIFT COMMAND LITTLE ROCK AFB. ARK. REPLACE AIR CONDITIONING BLDG. 842</b>				
<b>MECHANICAL &amp; ARCHITECTURAL DETAILS</b>				
DRAWN BY ELLISON	DESIGNED BY O. Paulson	DATE JUNE 80		
SCALE AS NOTED	PROJECT NO. LEK-81-0046	DRAWING NO. RC-2121	SHEET 6 OF 6	

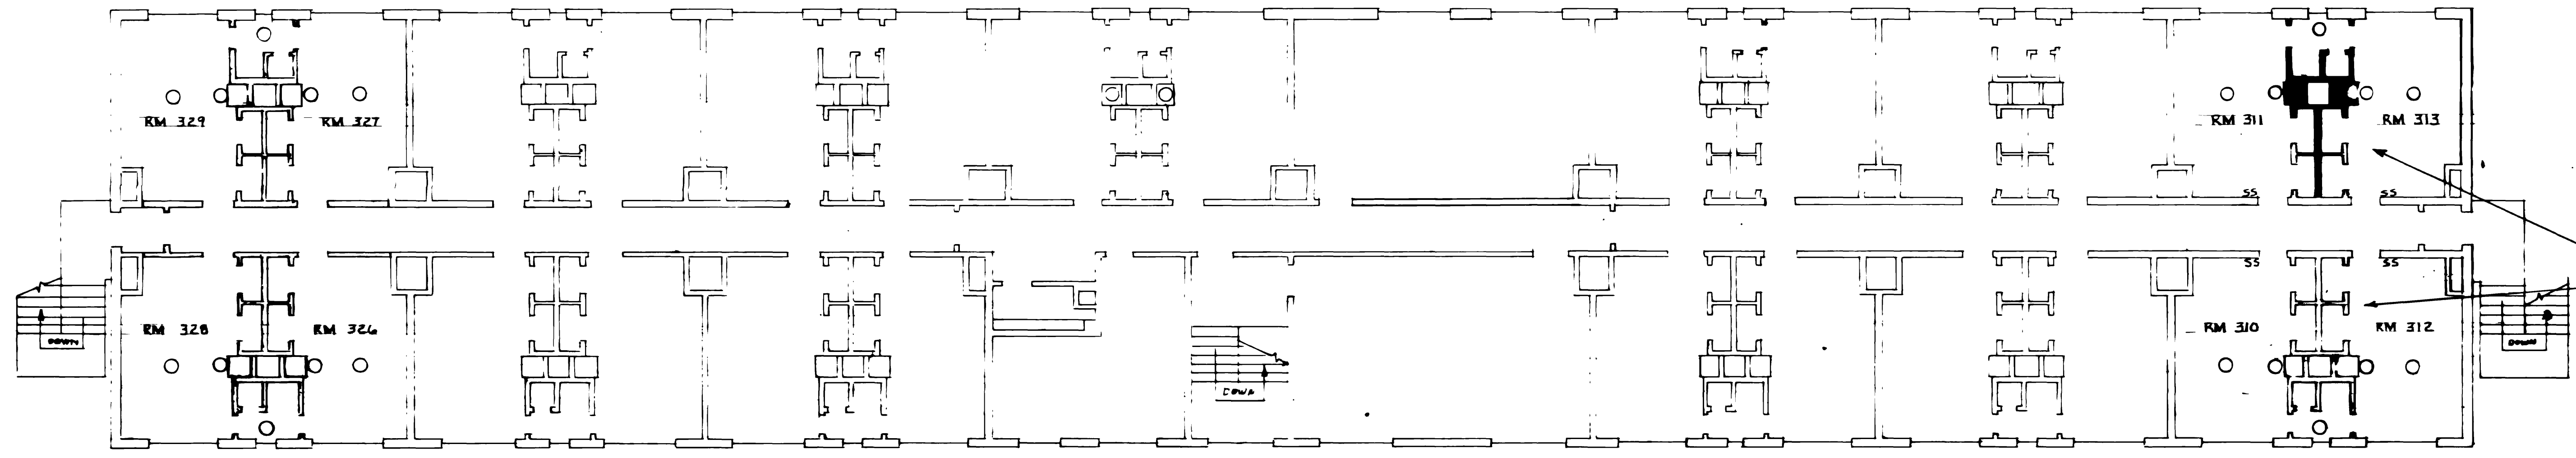


THIRD FLOOR

EXISTING WALLS, LIGHTING FIXTURES, CERAMIC TILE, PLUMBING TO BE REMOVED. SMOOTH FLOOR, CEILING, WALLS FOR FINISH SURFACES. (TYP) SEE SHT. 2 FOR EXISTING CONDITIONS.

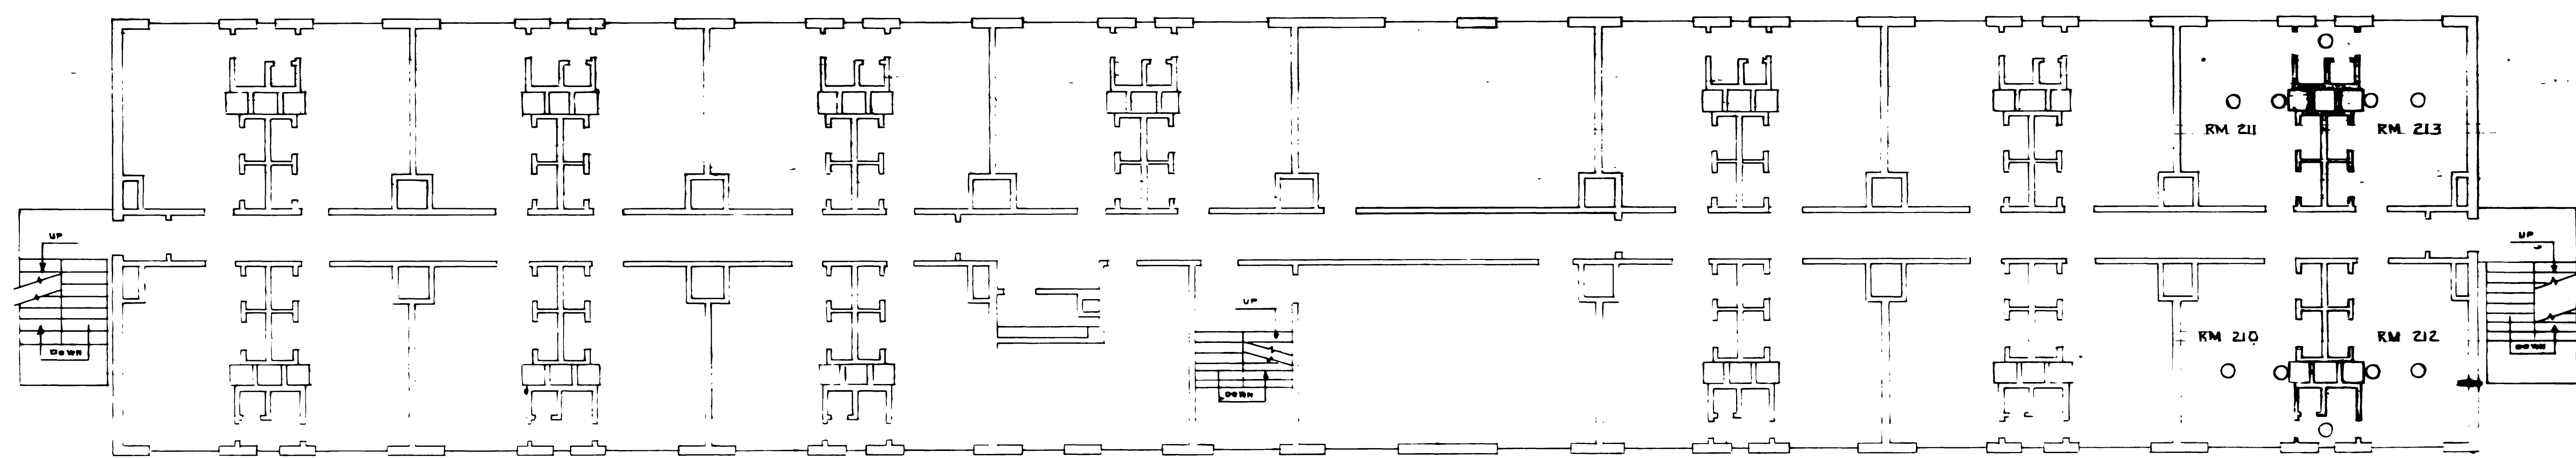

SECOND FLOOR


LEGEND  
 [Symbol] WALLS TO BE REMOVED

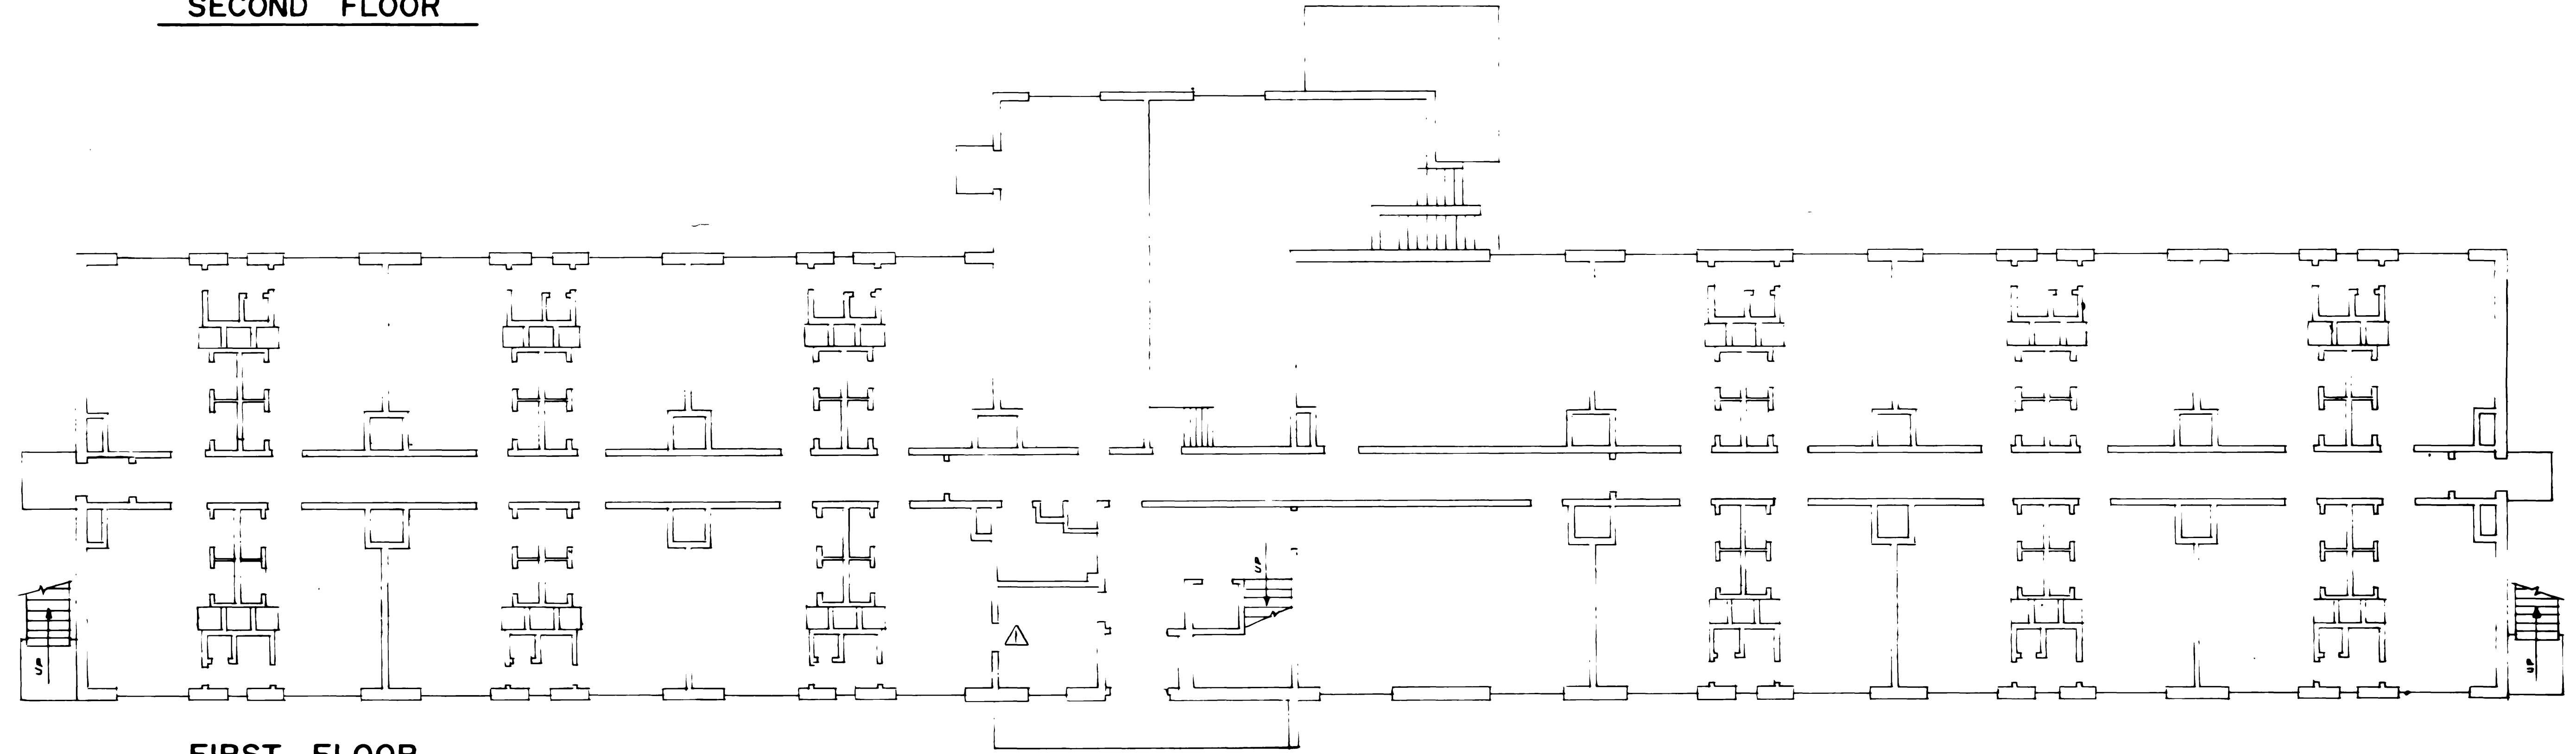


FIRST FLOOR

DESIGNED DRAWING AS CONSTRUCTED  
 [Signature]  
 CONST. MGT. ENGR. CONST. INSPECTOR  
 PROJECT NO. 79-0090 DATE 11/18/80

REV	DATE	DESCRIPTION	DRAWN	APPROV
1	DEC 89	ADDED DOOR W/C #13300		DB
<b>MILITARY AIRLIFT COMMAND</b> <b>LITTLE ROCK AFB. ARK.</b> <b>CONSTRUCT CLASSROOMS,</b> <b>NCO ACADEMY</b> BLDG 842 DEMOLITION PLAN				
DRAWN BY	TECH REVIEWER	DESIGNED BY	DATE	
DAUGHERTY				
SCALE	1/8" = 1' - 0"	79-0090	M - 2182	1 OF 5

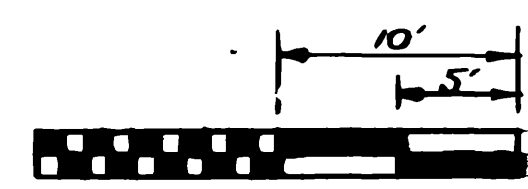


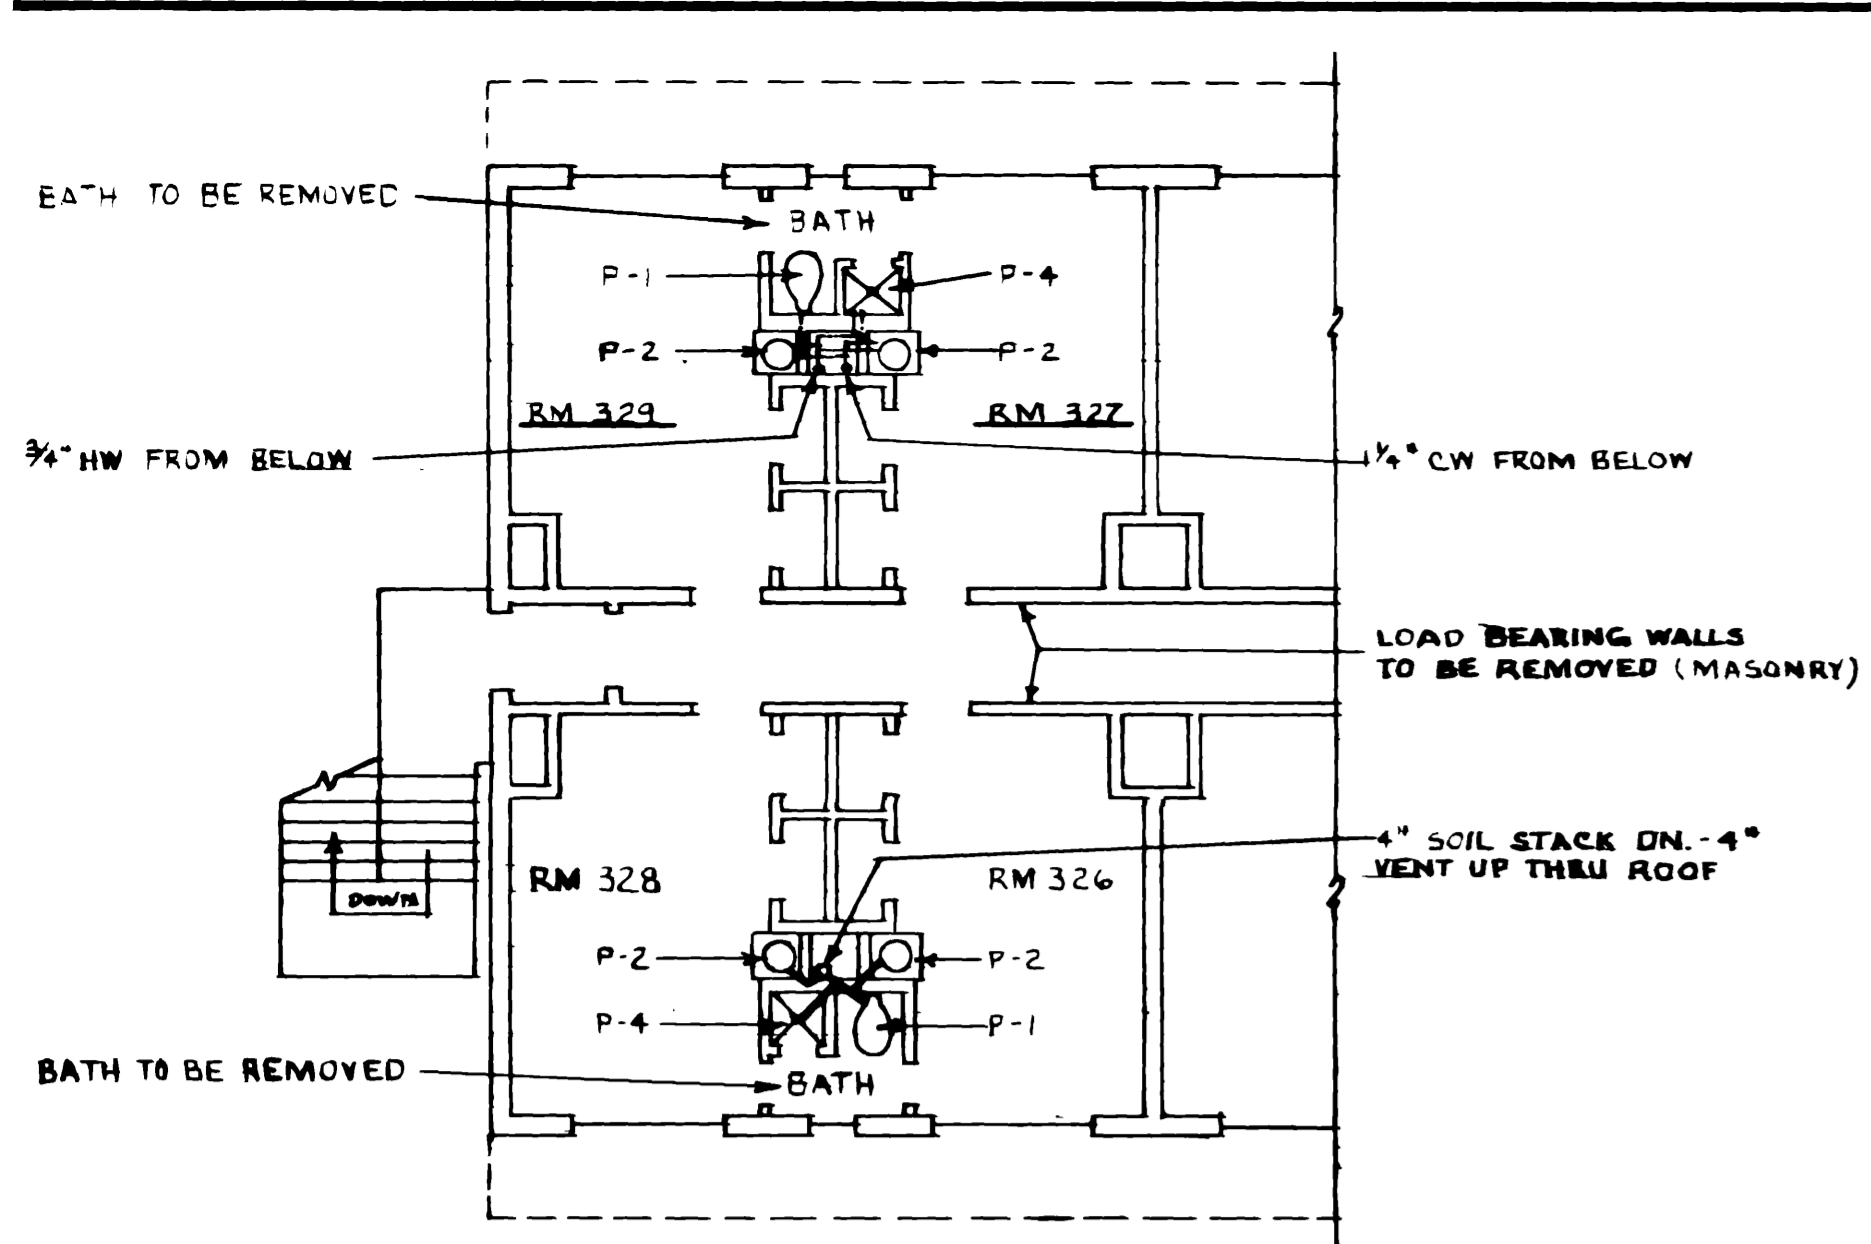

THIRD FLOOR SOUTH END

EXISTING PLUMBING PLAN


SCALE 1/8" = 1'-0"

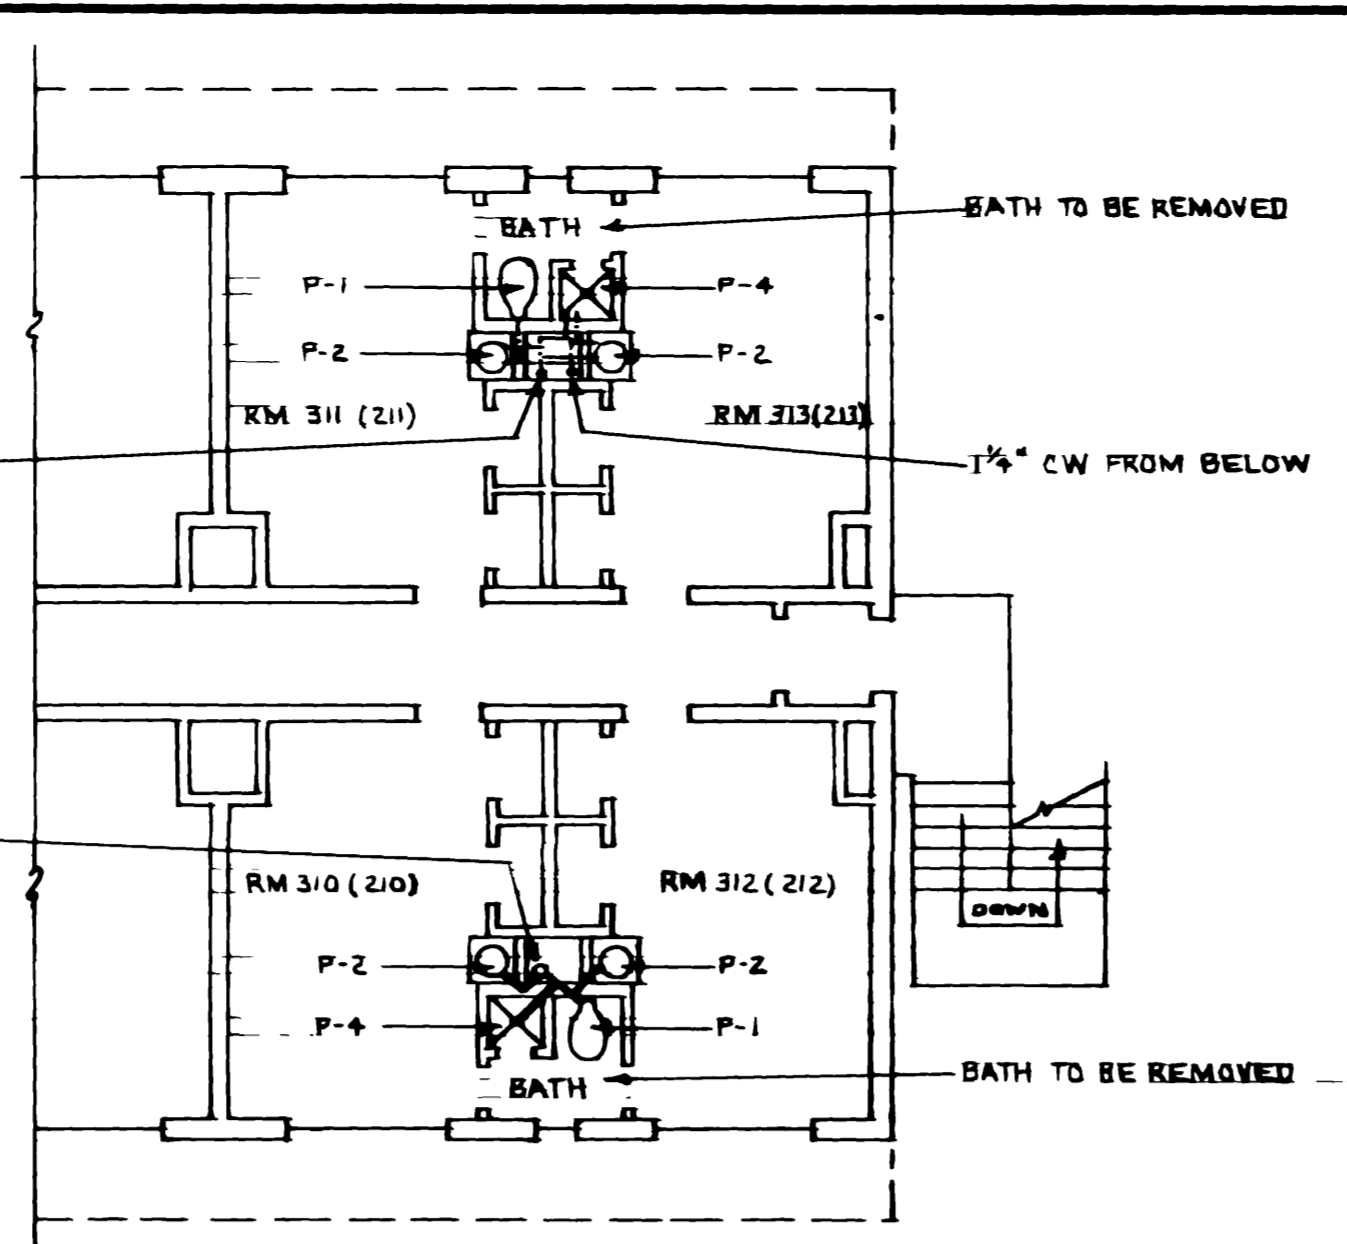

TYPICAL SECOND & THIRD FLOORS NORTH END


EXISTING PLUMBING PLAN

SCALE 1/8" = 1'-0"

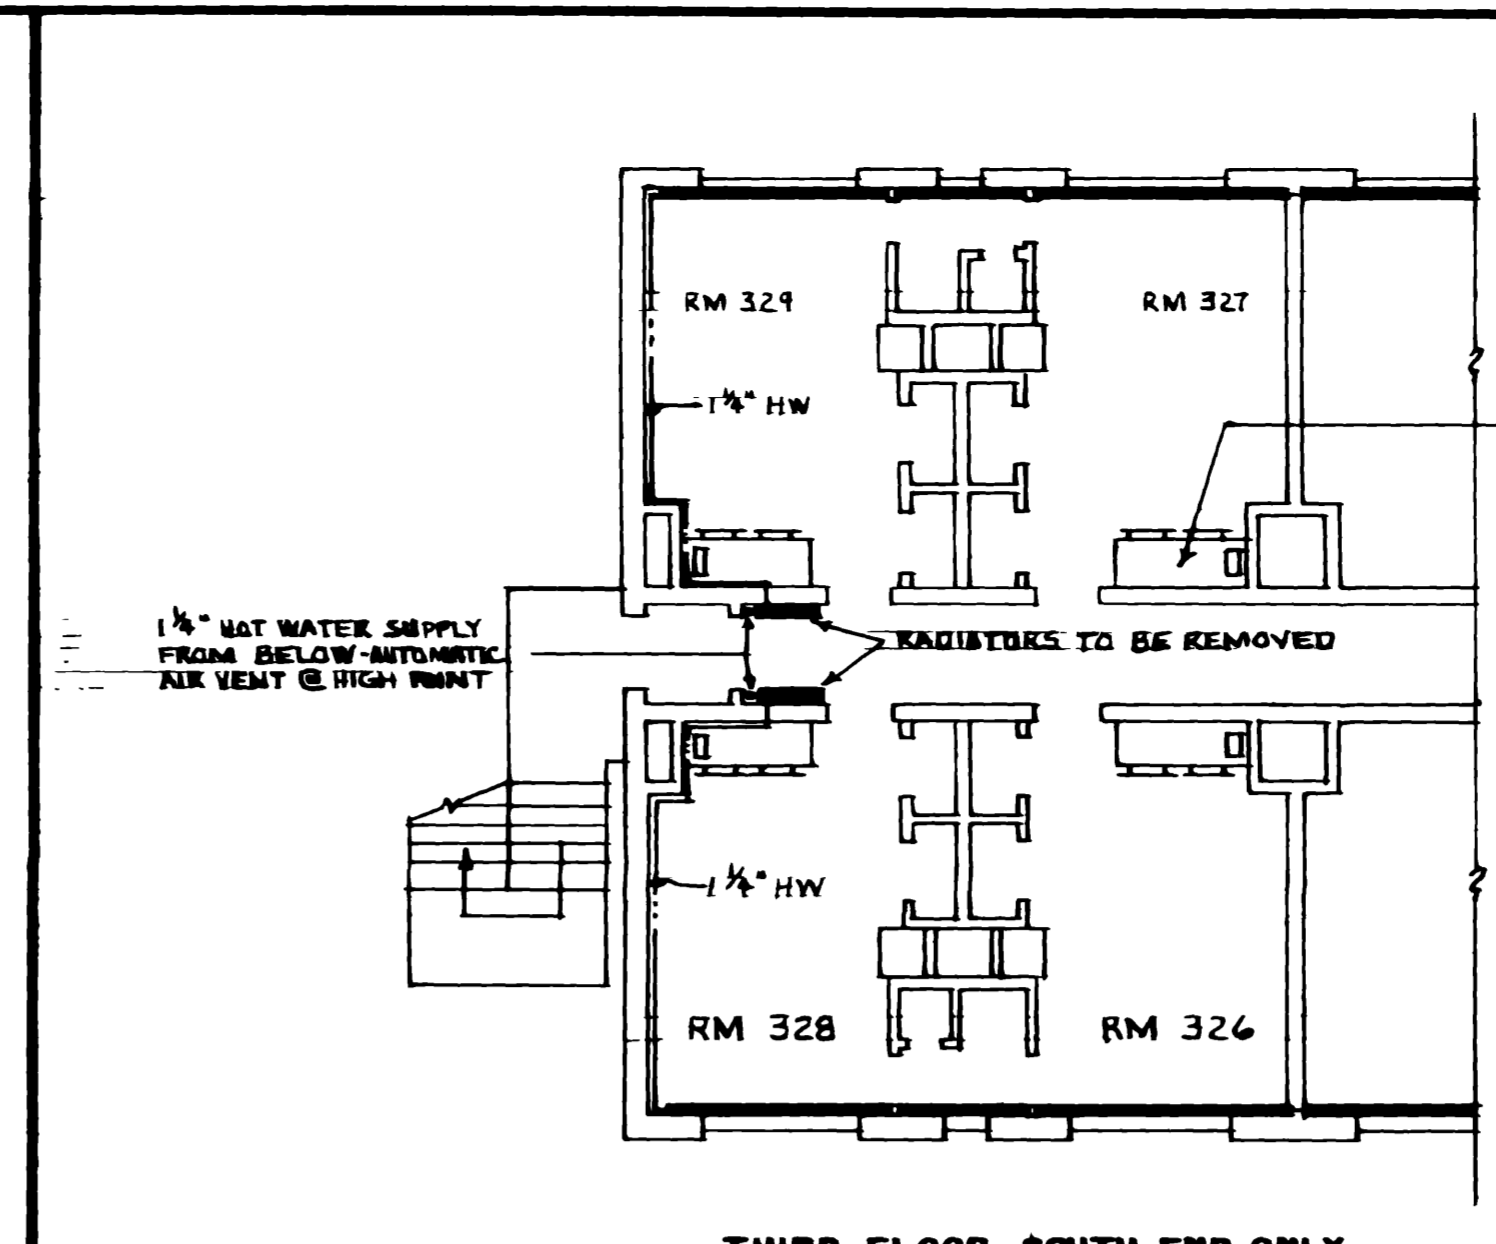


THIRD FLOOR SOUTH END ONLY  
EXISTING RADIATOR PLAN

SCALE 1/8" = 1'-0"

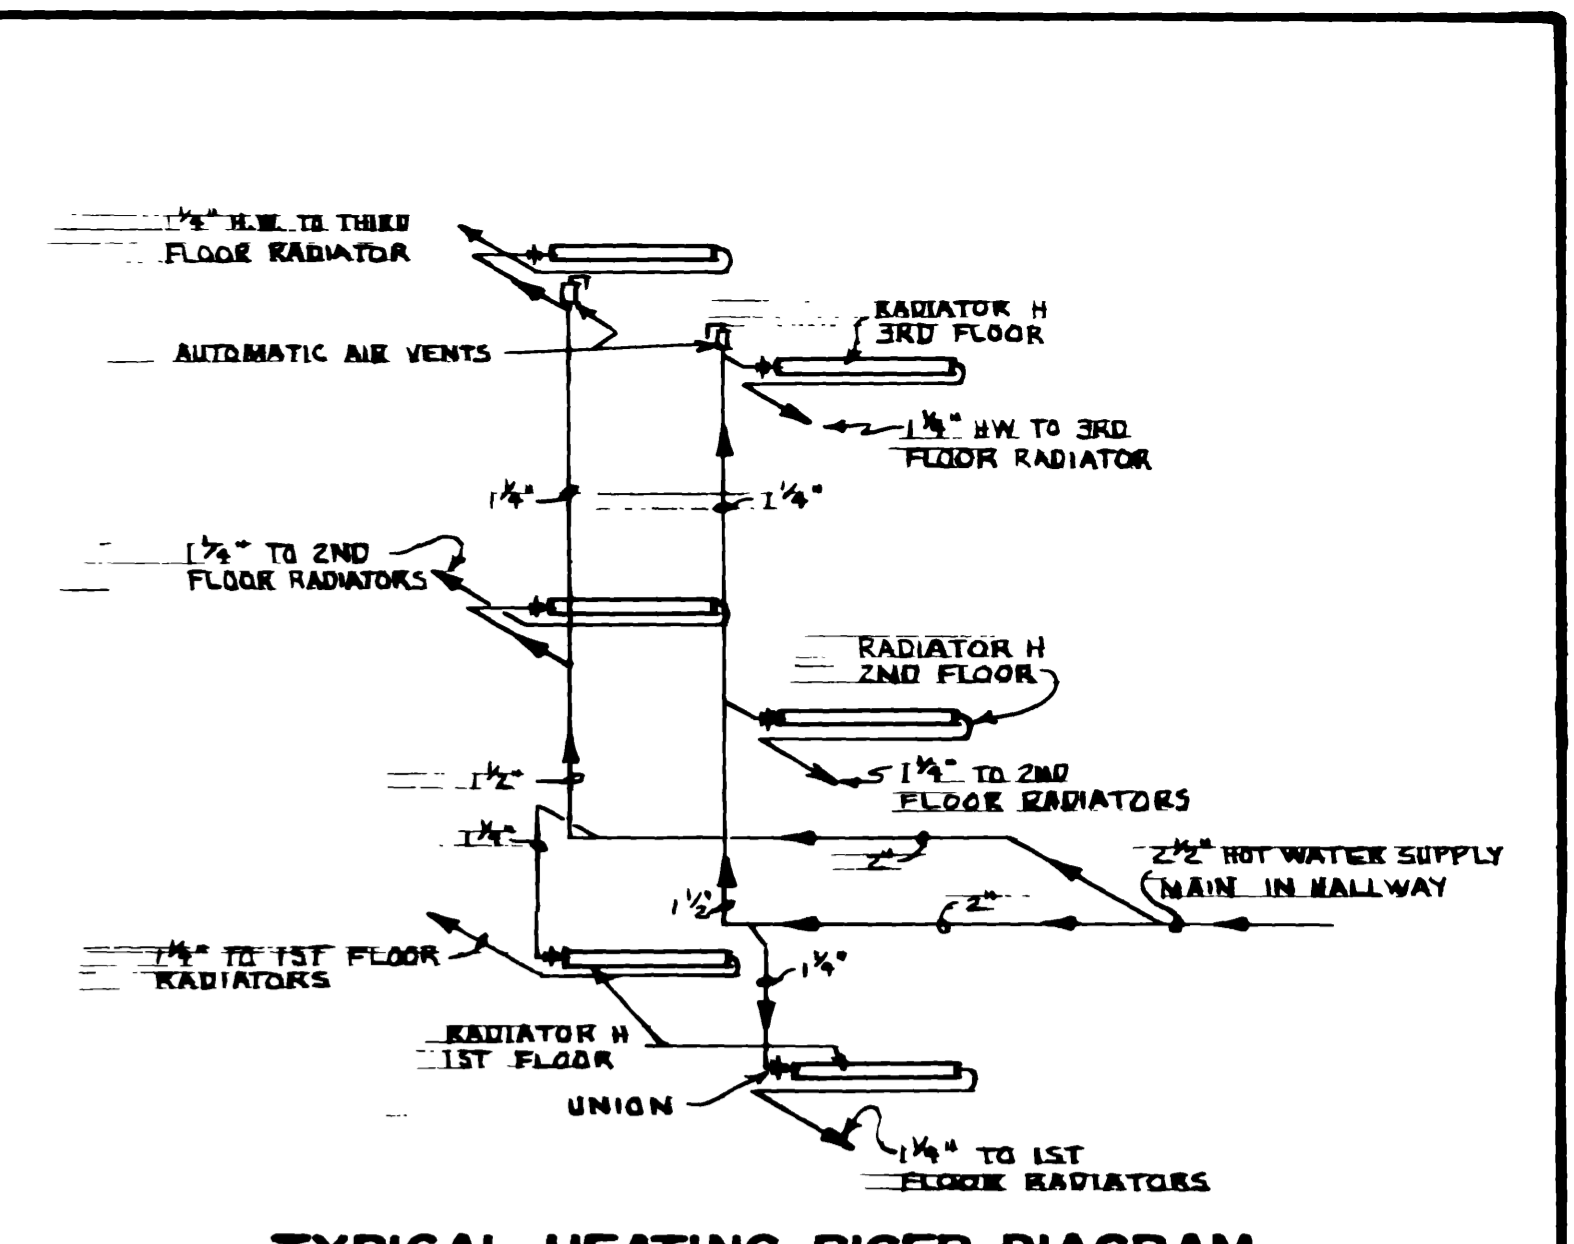

TYPICAL HEATING RISER DIAGRAM AT ENDS OF CORRIDOR (EXIST.)


NTS

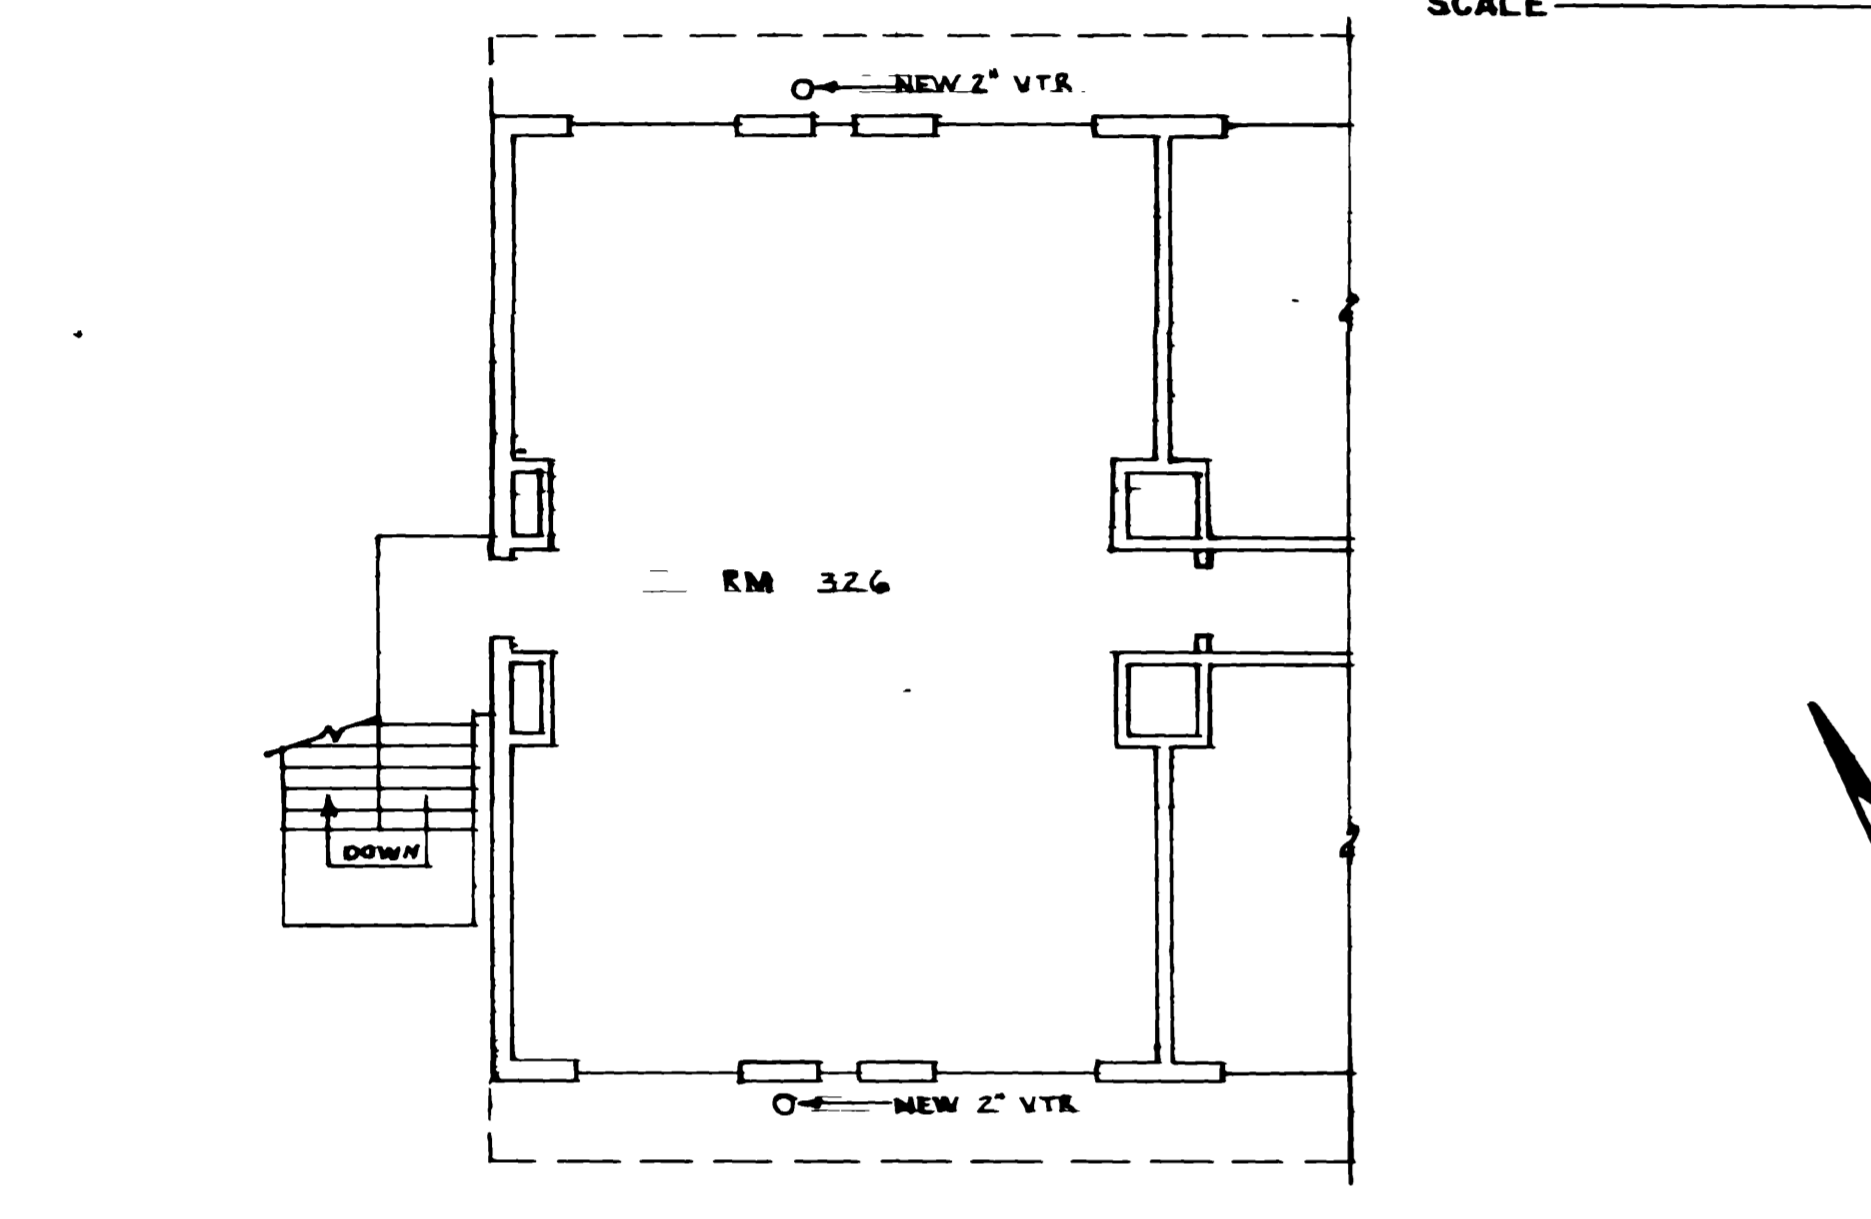

THIRD FLOOR SOUTH END

NEW PLUMBING PLAN


SCALE 1/8" = 1'-0"

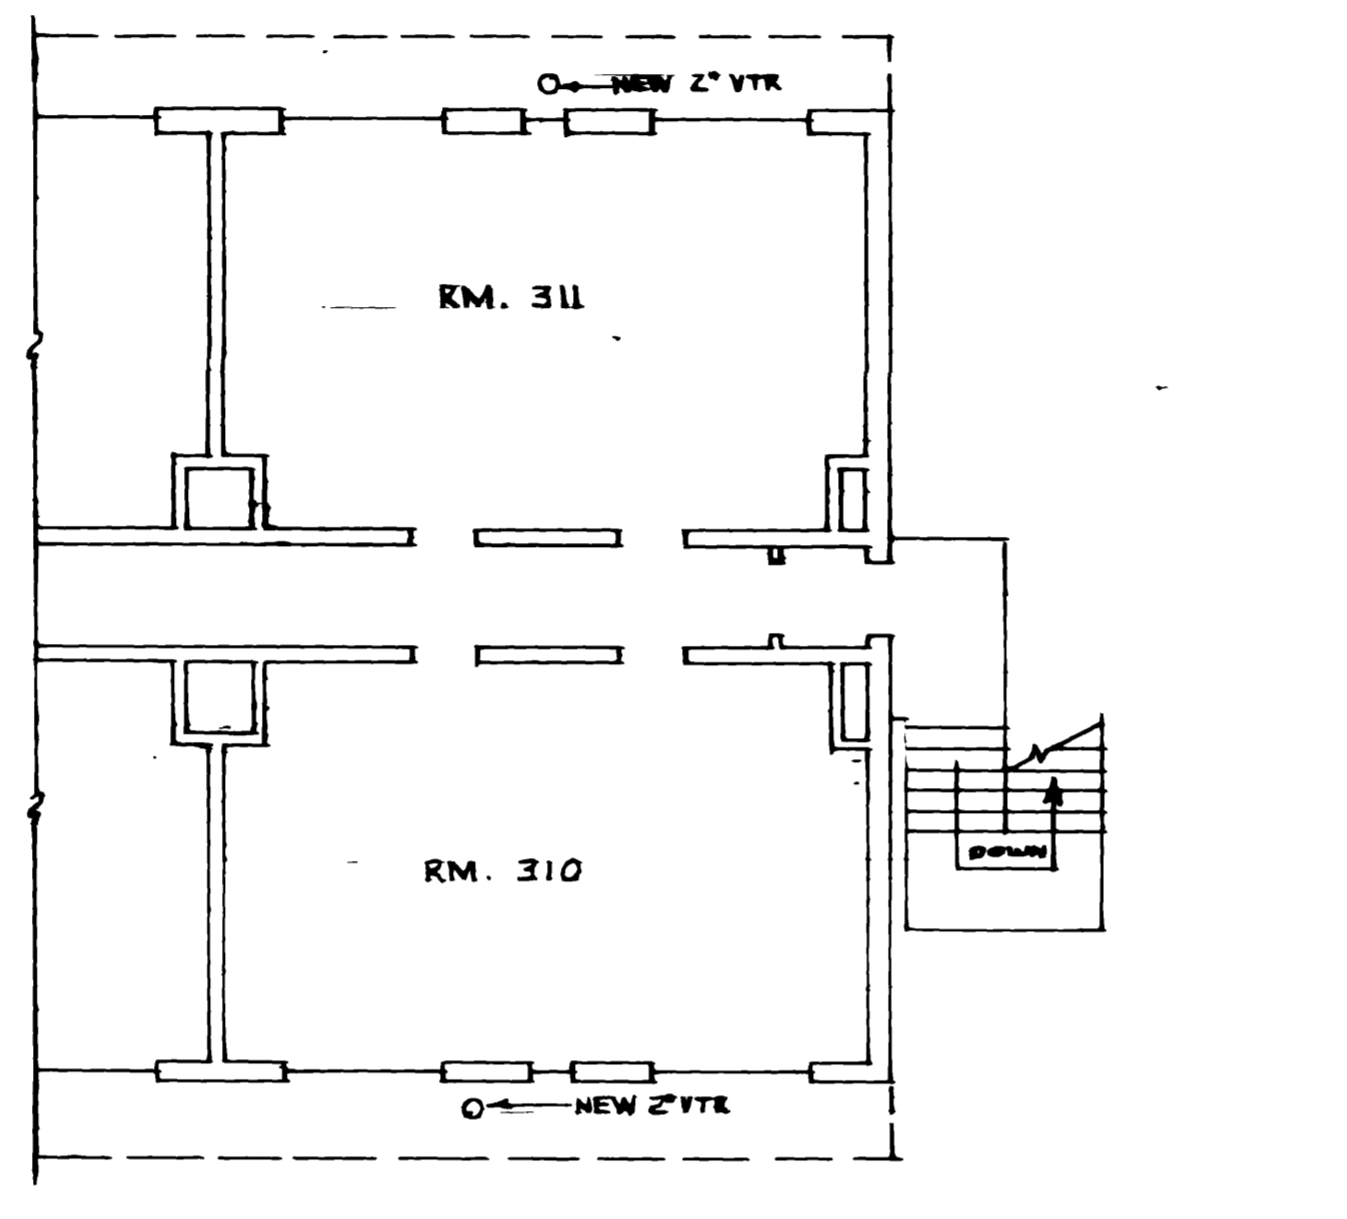

TYPICAL SECOND & THIRD FLOORS NORTH END


NEW PLUMBING PLAN

SCALE 1/8" = 1'-0"

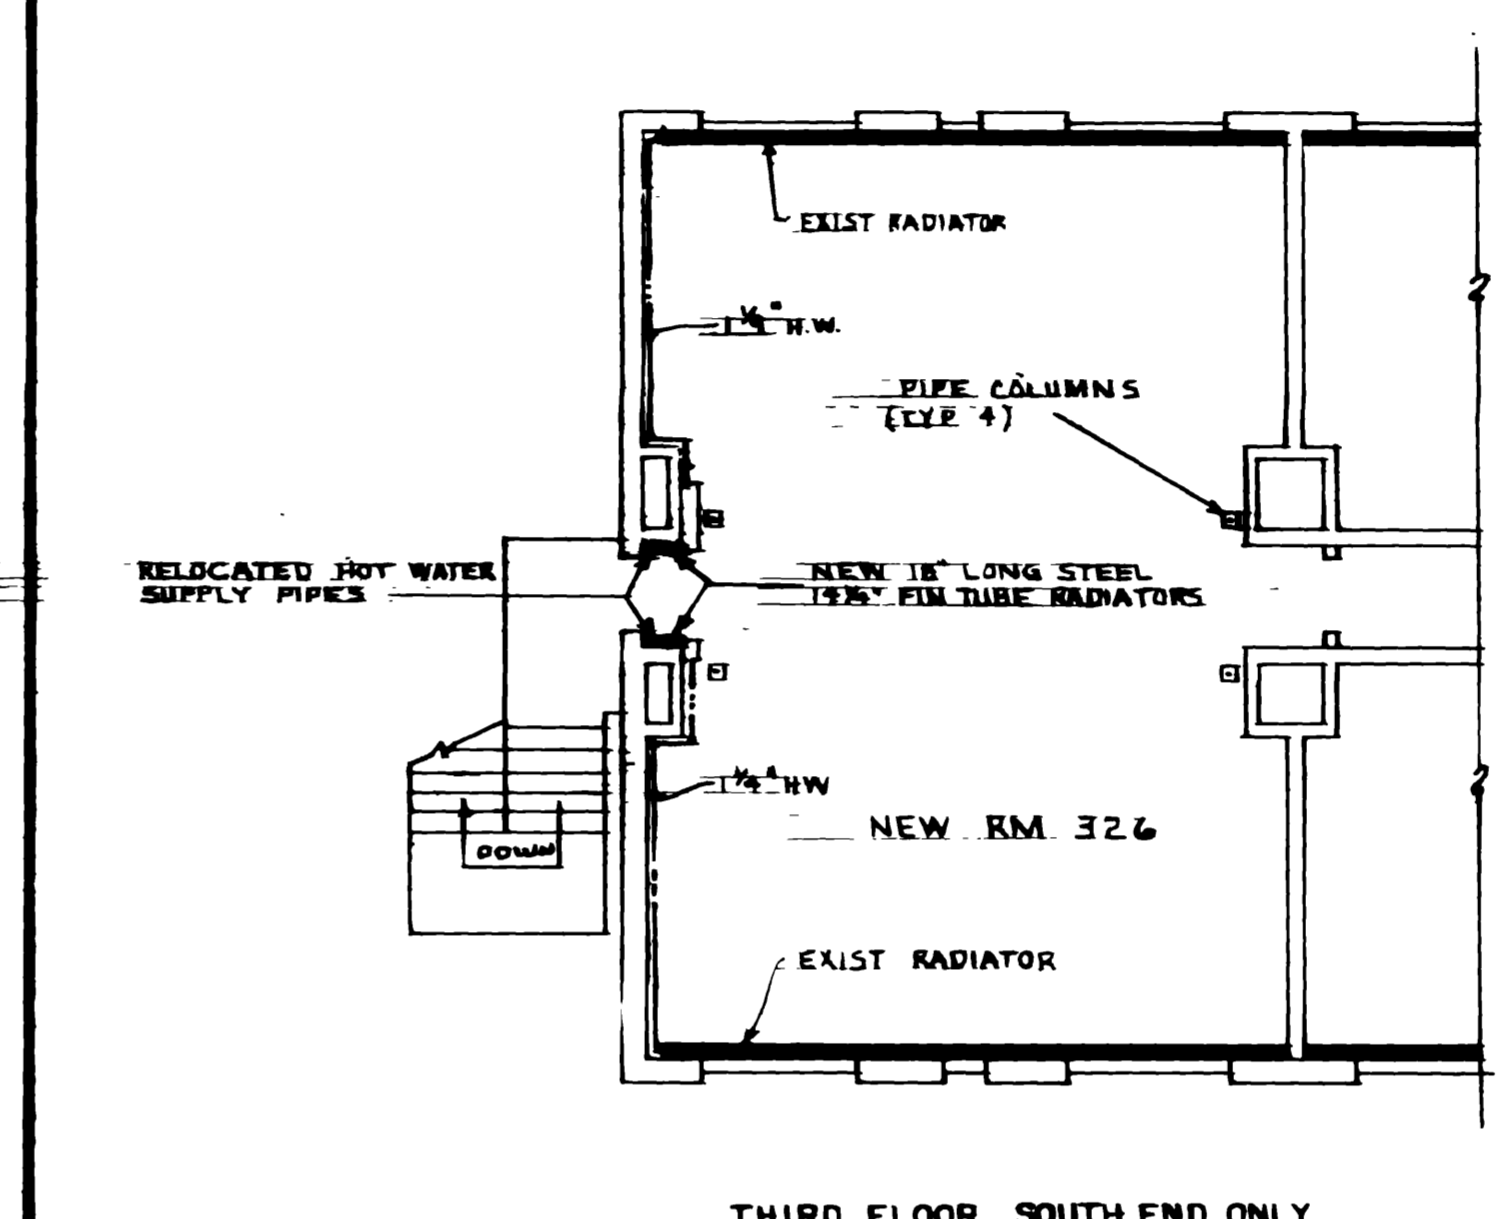

THIRD FLOOR SOUTH END ONLY  
NEW RADIATOR PLAN


SCALE 1/8" = 1'-0"

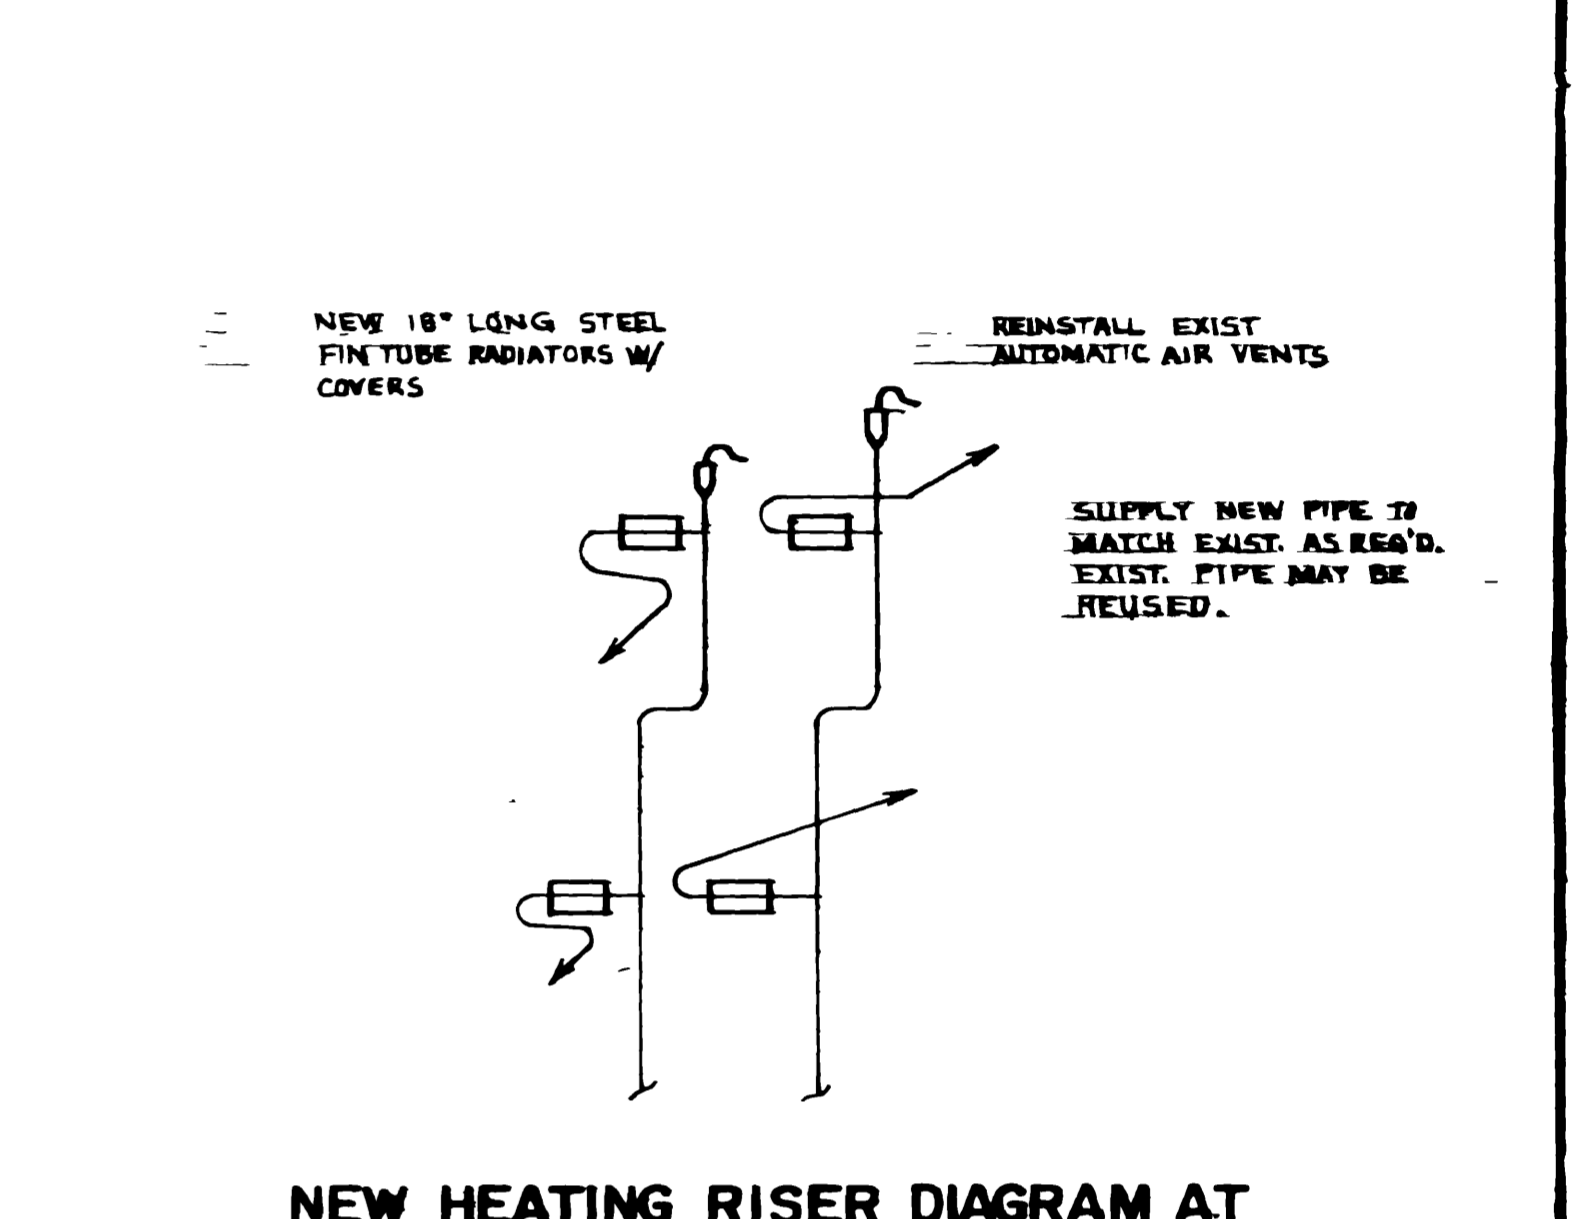

NEW HEATING RISER DIAGRAM AT END OF CORRIDOR IN NEW ROOM 326


NTS

MARK	FIXTURE NAME	CW	HW	WASTE
P-1	WATER CLOSET	1"		4"
P-2	LAVATORY	1/2"	1/2"	1 1/2"
P-3	BATH TUB	1/2"	1/2"	1 1/2"
P-4	SHOWER	1/2"	1/2"	2"
P-5	LAUNDRY TRAY	1/2"	1/2"	1 1/2"
P-6	SERVICE SINK	1/2"	1/2"	3"
P-7	ELECTRIC WATER COOLER	1/2"	1/2"	1 1/2"

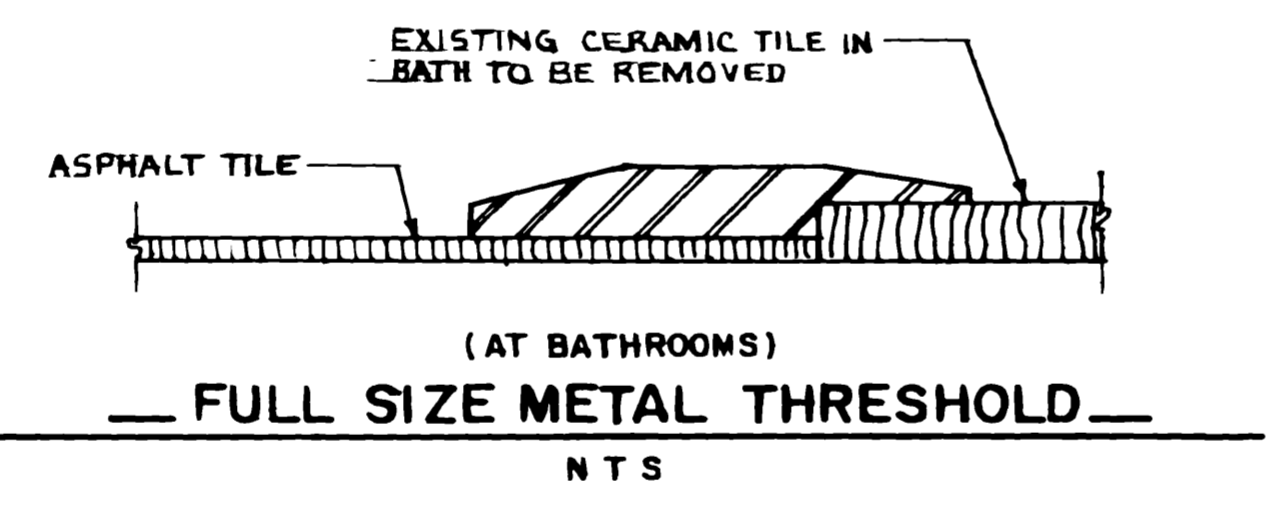

FULL SIZE METAL THRESHOLD

NTS

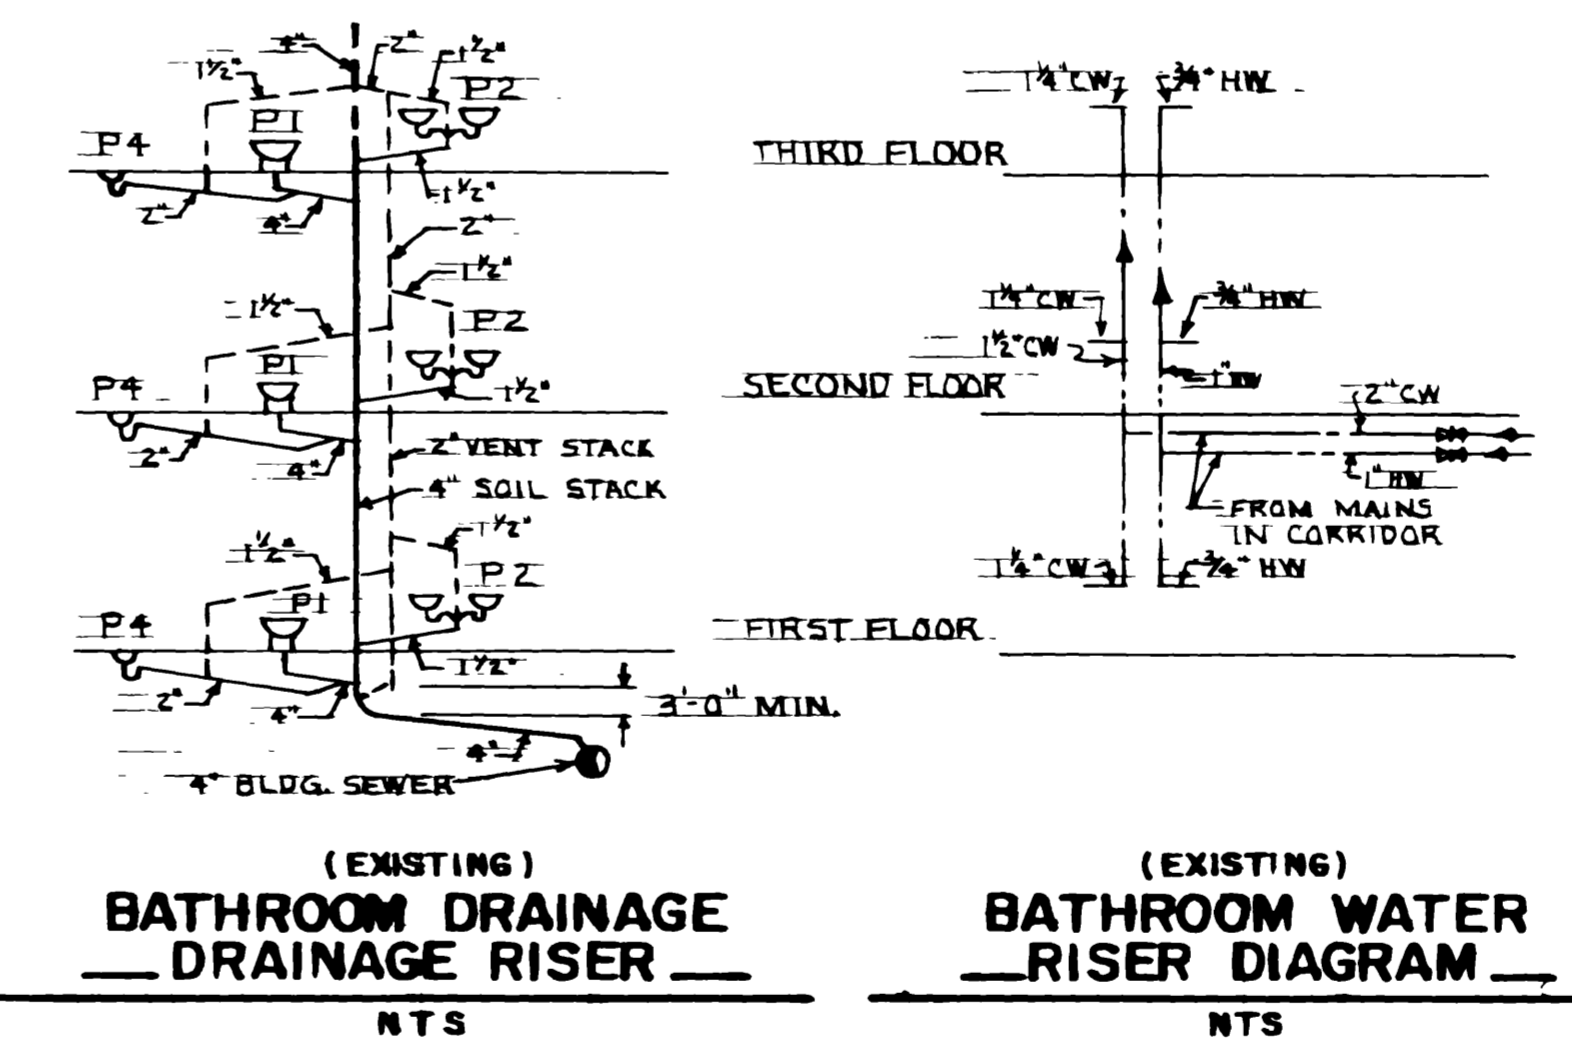


(EXISTING) BATHROOM DRAINAGE RISER

NTS

(EXISTING) BATHROOM WATER RISER DIAGRAM

NTS

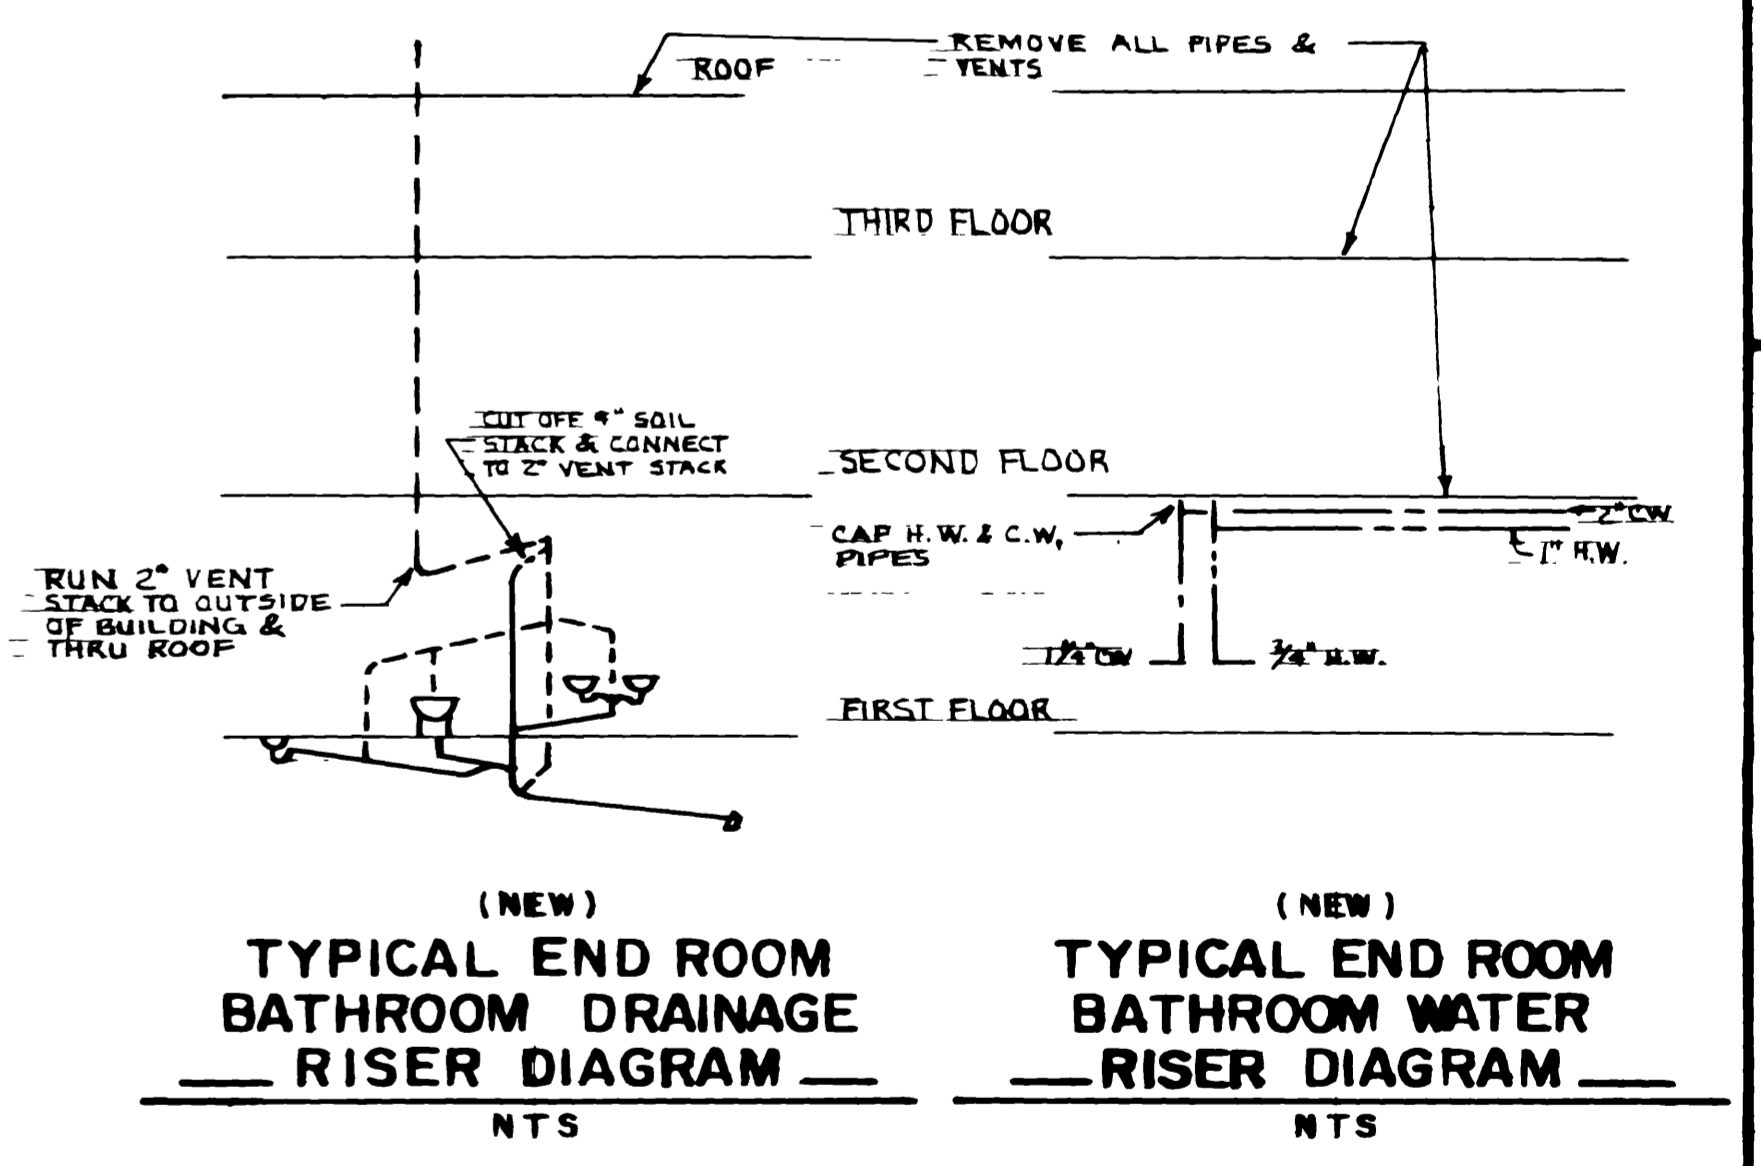


(NEW) TYPICAL END ROOM BATHROOM DRAINAGE RISER DIAGRAM

NTS


(NEW) TYPICAL END ROOM BATHROOM WATER RISER DIAGRAM

NTS

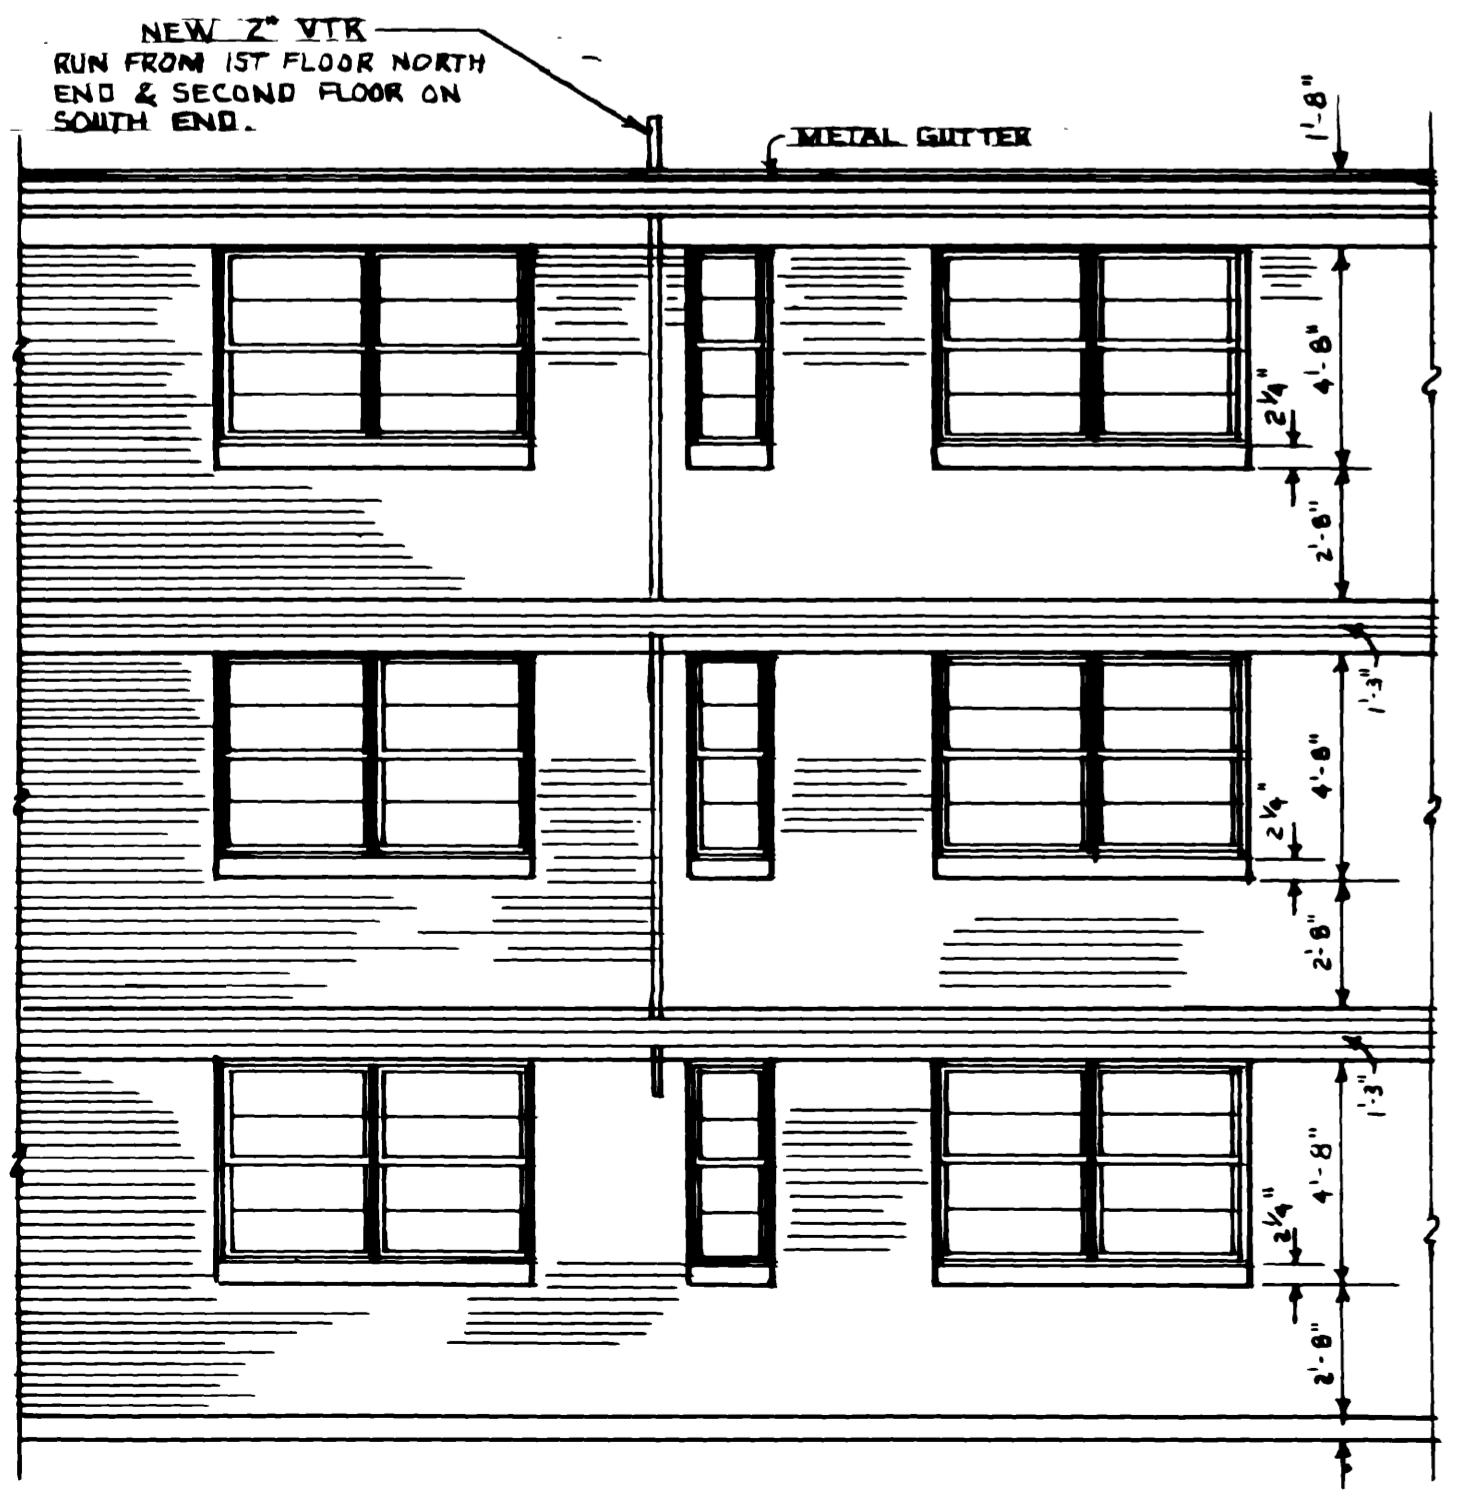


TYPICAL EXTERIOR ELEVATION

SCALE 1/4" = 1'-0"

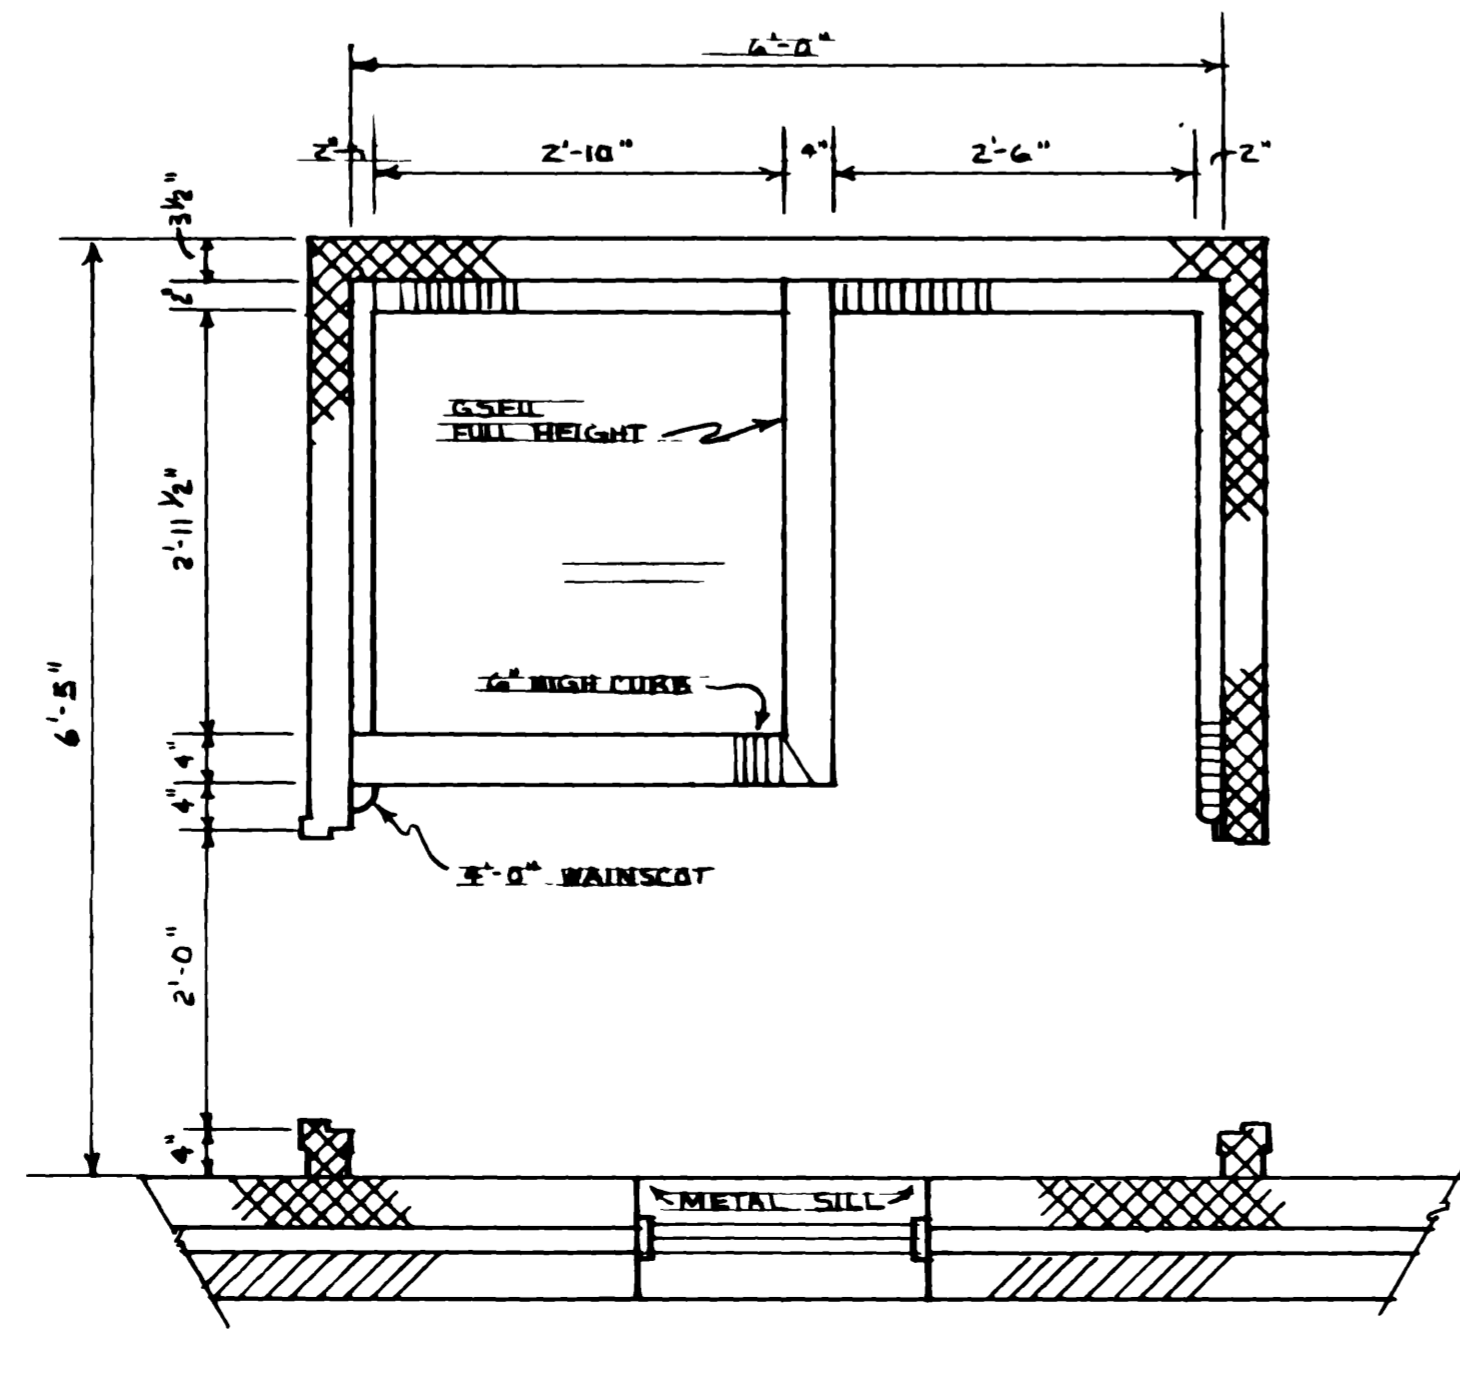

PLAN OF BATH TO BE REMOVED

SCALE 3/4" = 1'-0"

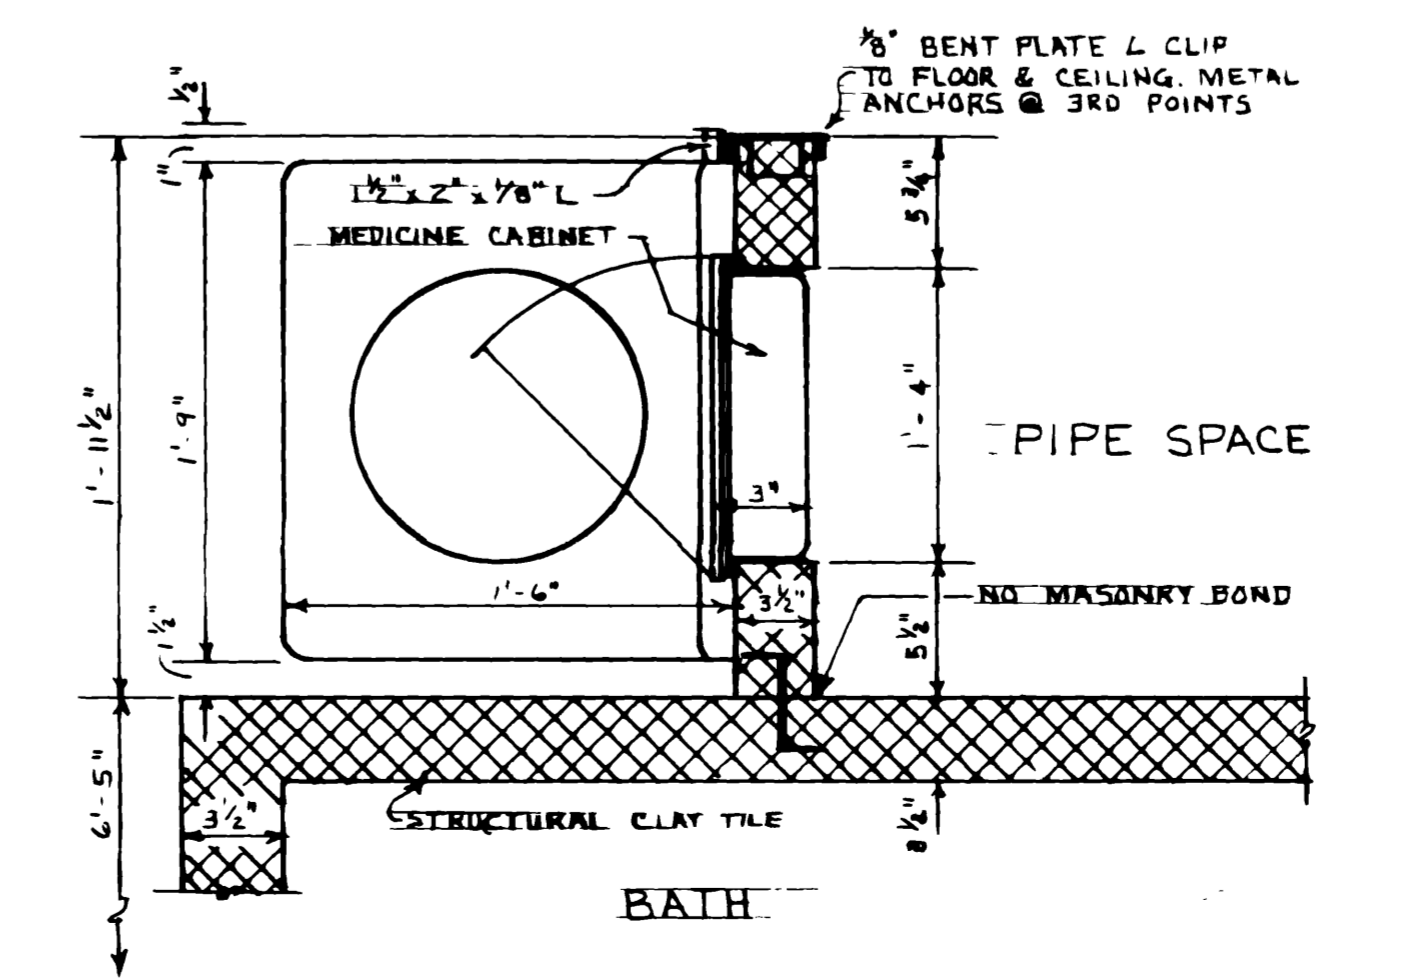


PLAN AT PIPE SPACE & WARDROBES

SCALE 1 1/2" = 1'-0"


RECORD DRAWING AS CONSTRUCTED  
*James J. Boyd*  
 CONST. M.T. ENGR. DATE 16 MAY 80  
 PROJECT NO. 79-100 DATE 4 FEB 79

REV	DATE	DESCRIPTION	DRAWN	APPROV
<b>MILITARY AIRLIFT COMMAND</b> <b>LITTLE ROCK AFB. ARK.</b> <b>CONSTRUCT CLASSROOMS,</b> <b>NCO ACADEMY</b> <b>BLDG 842</b> <b>PLANS &amp; DETAILS</b>				
DRAWN BY	SCALE	PROJECT NO.	DRAWING NO.	DATE
DAUGHERTY	AS SHOWN	LRK 79-0090	M-2182	16 MAY 80
				SHEET 2 OF 5

073 0842 842

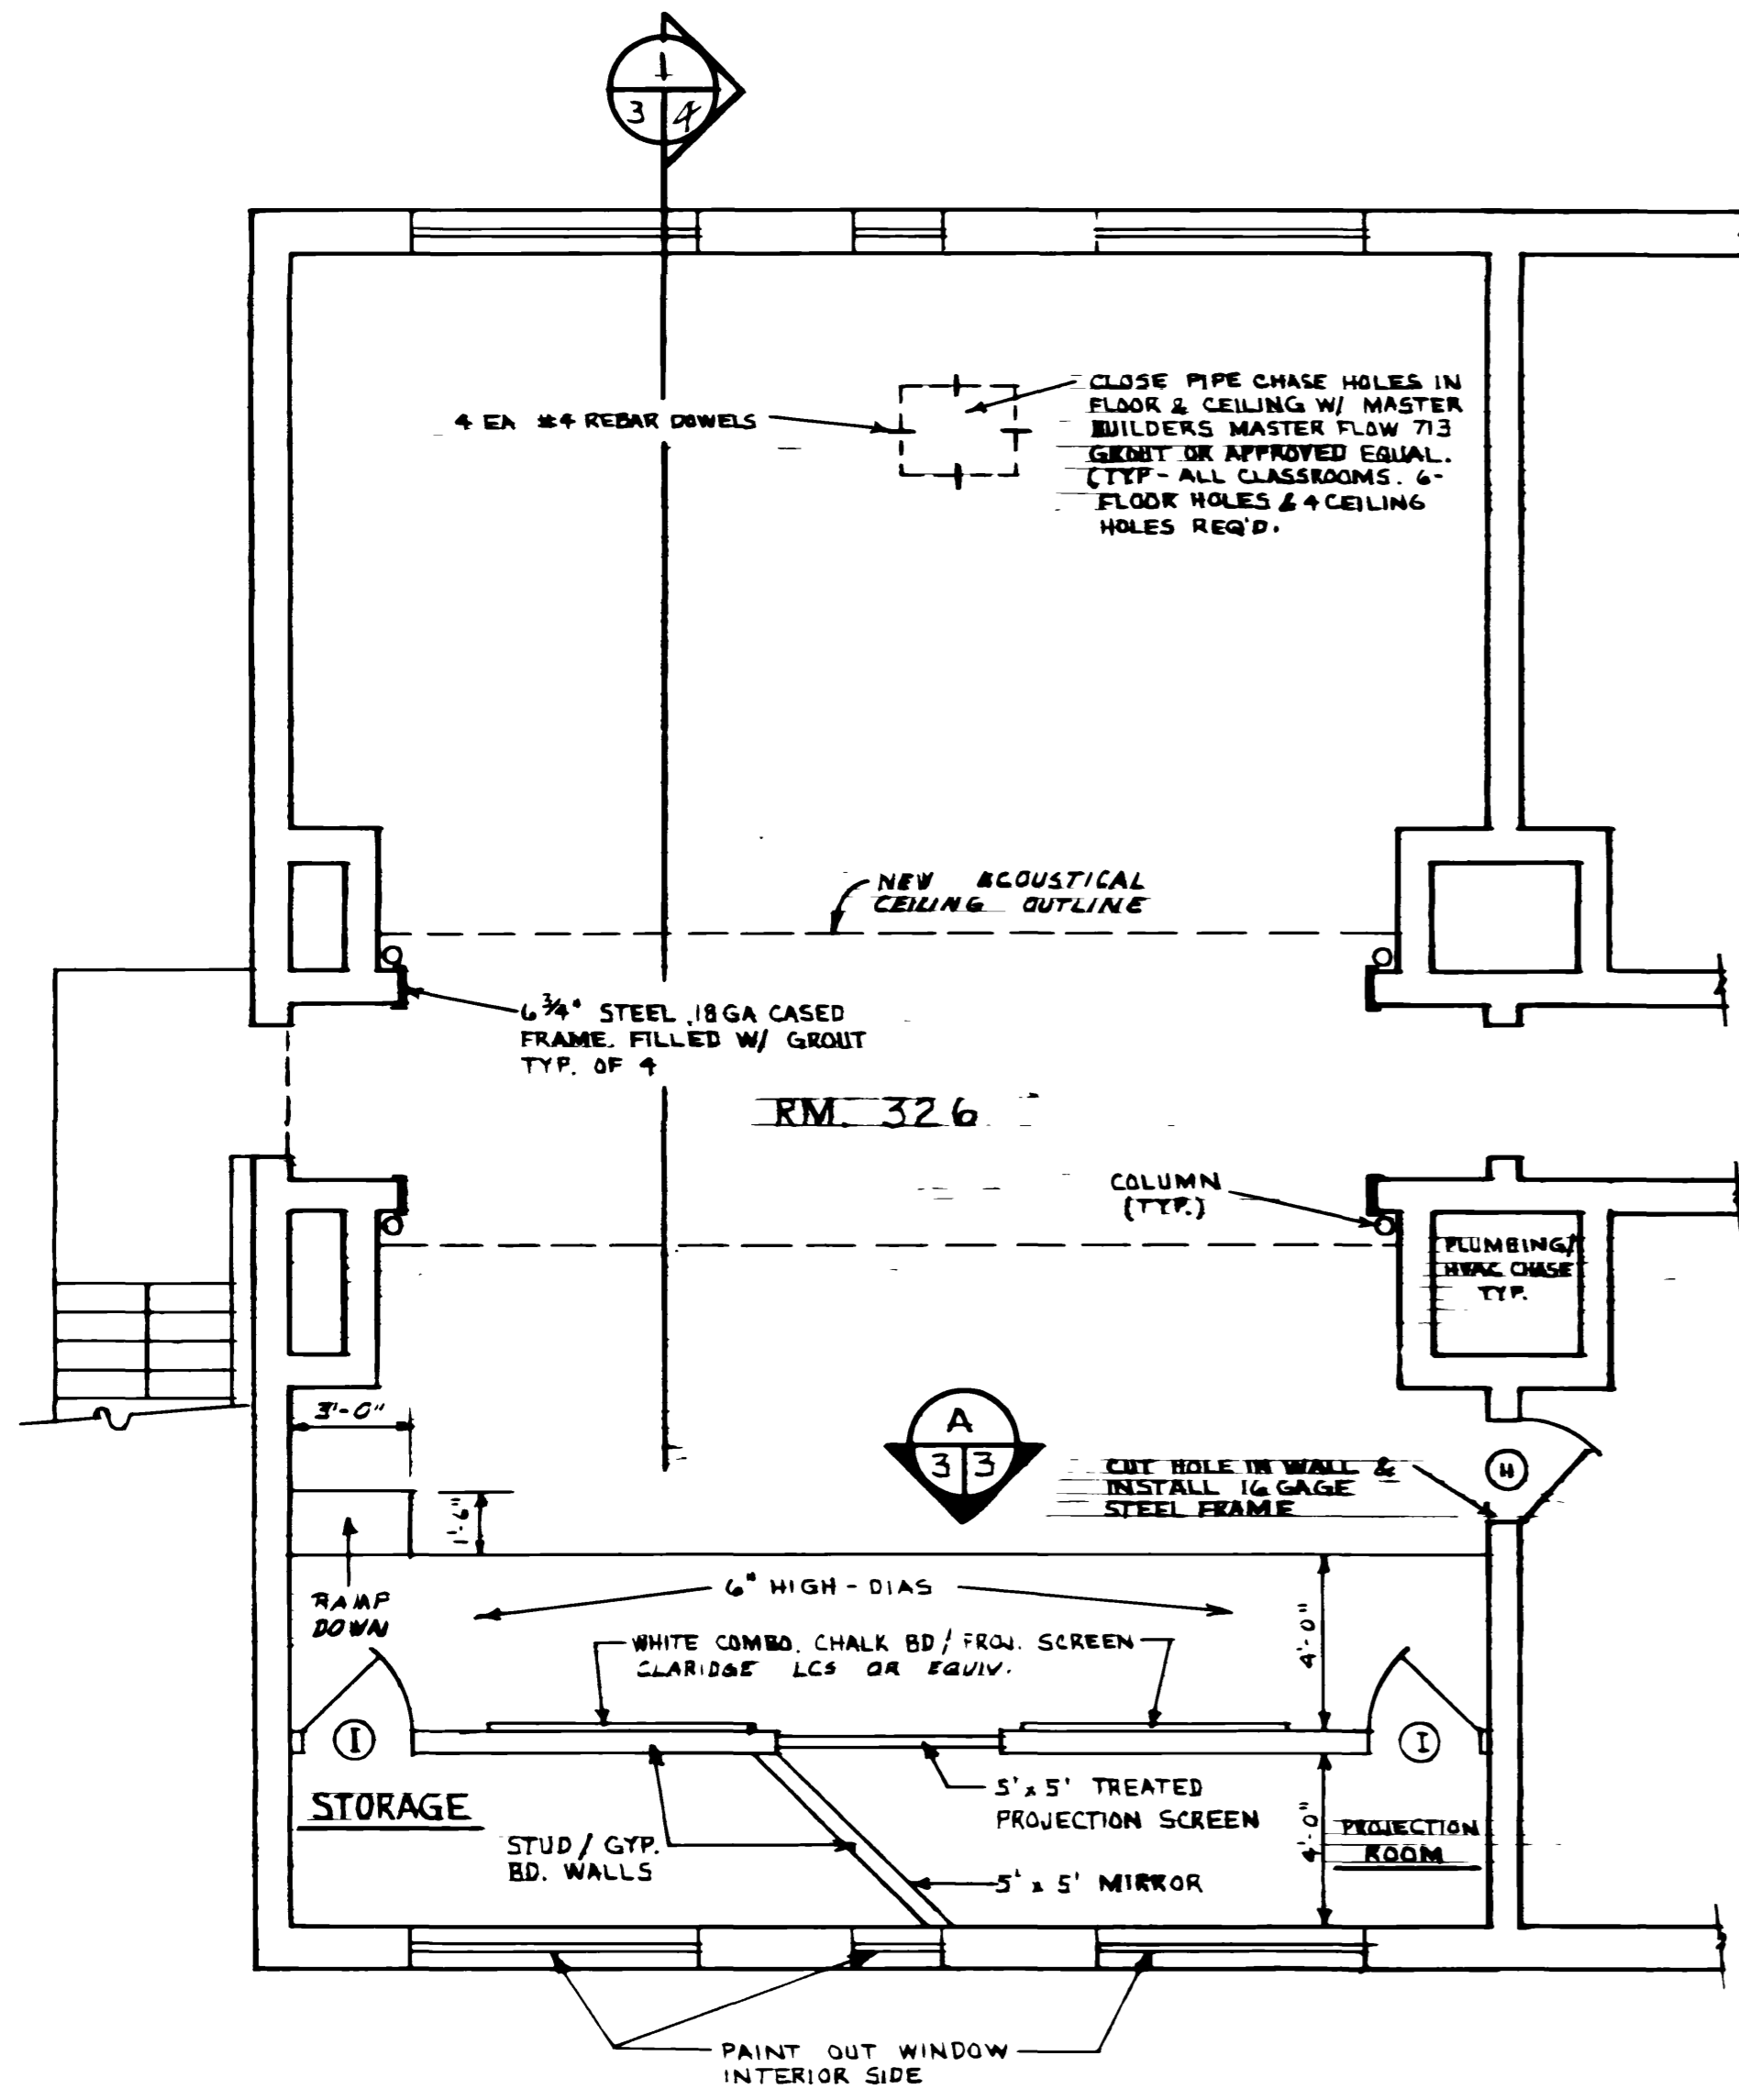


**FLOOR PLAN-LARGE CLASSROOM**  
SCALE 1/4" = 1'-0"

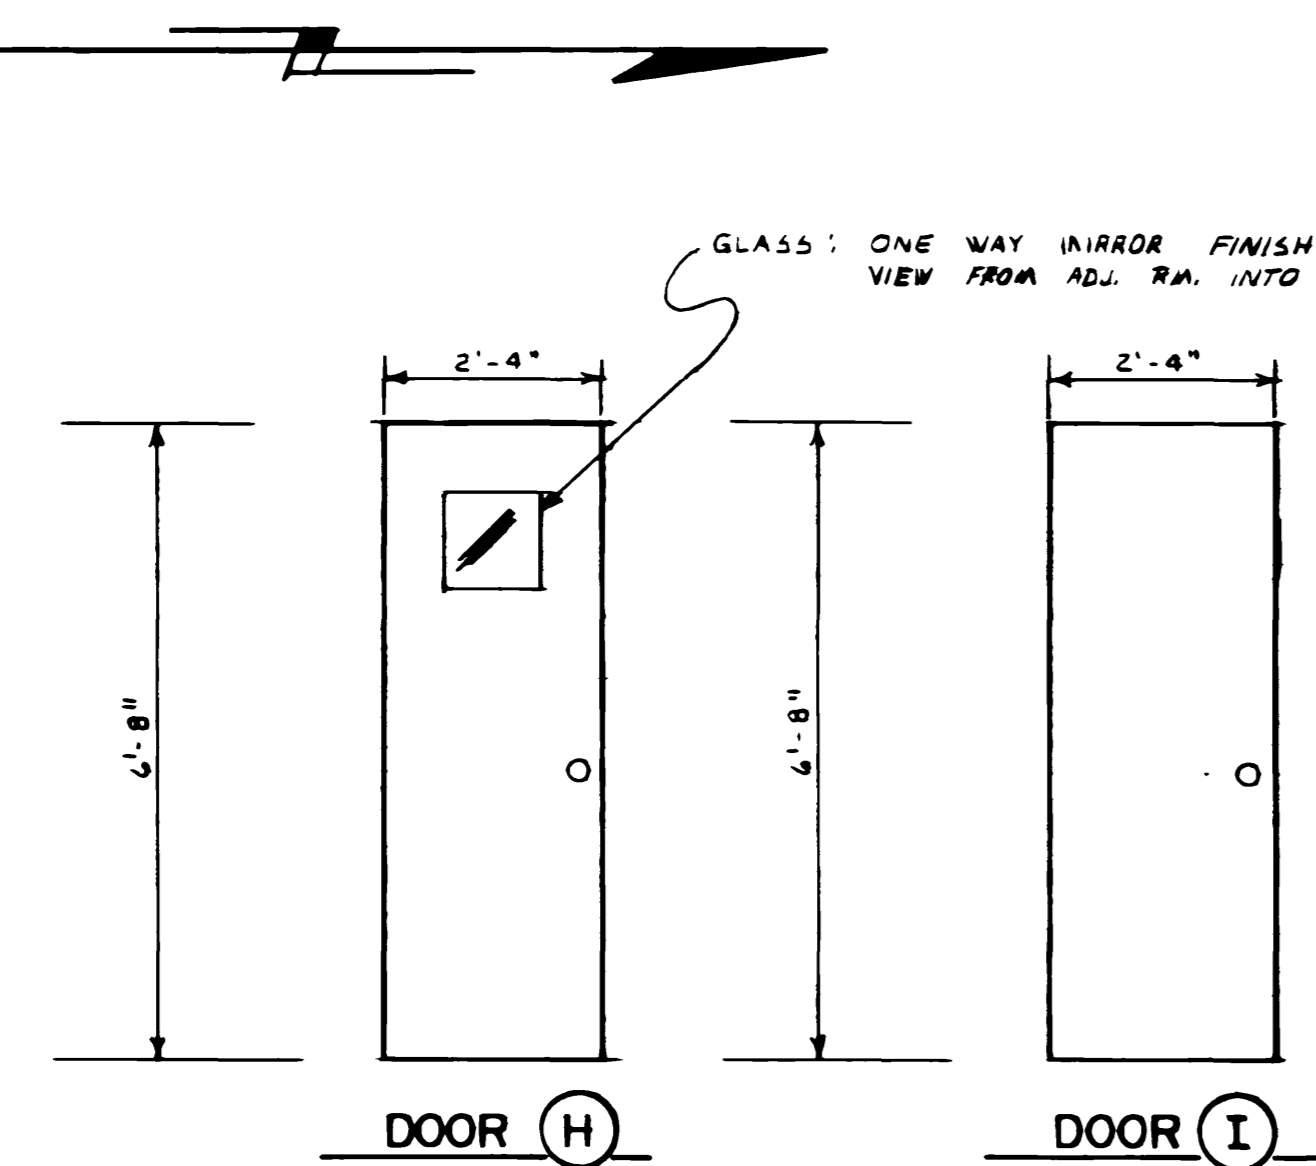

NOTE: BOTH DOORS TO BE 1 1/2" SOLID CORE WOOD DOOR W/ WILSONART GREENE PLASTIC LAMINATE FINISH OR APPROVED EQUAL.

**DOOR SCHEDULE**  
SCALE 1/2" = 1'-0"

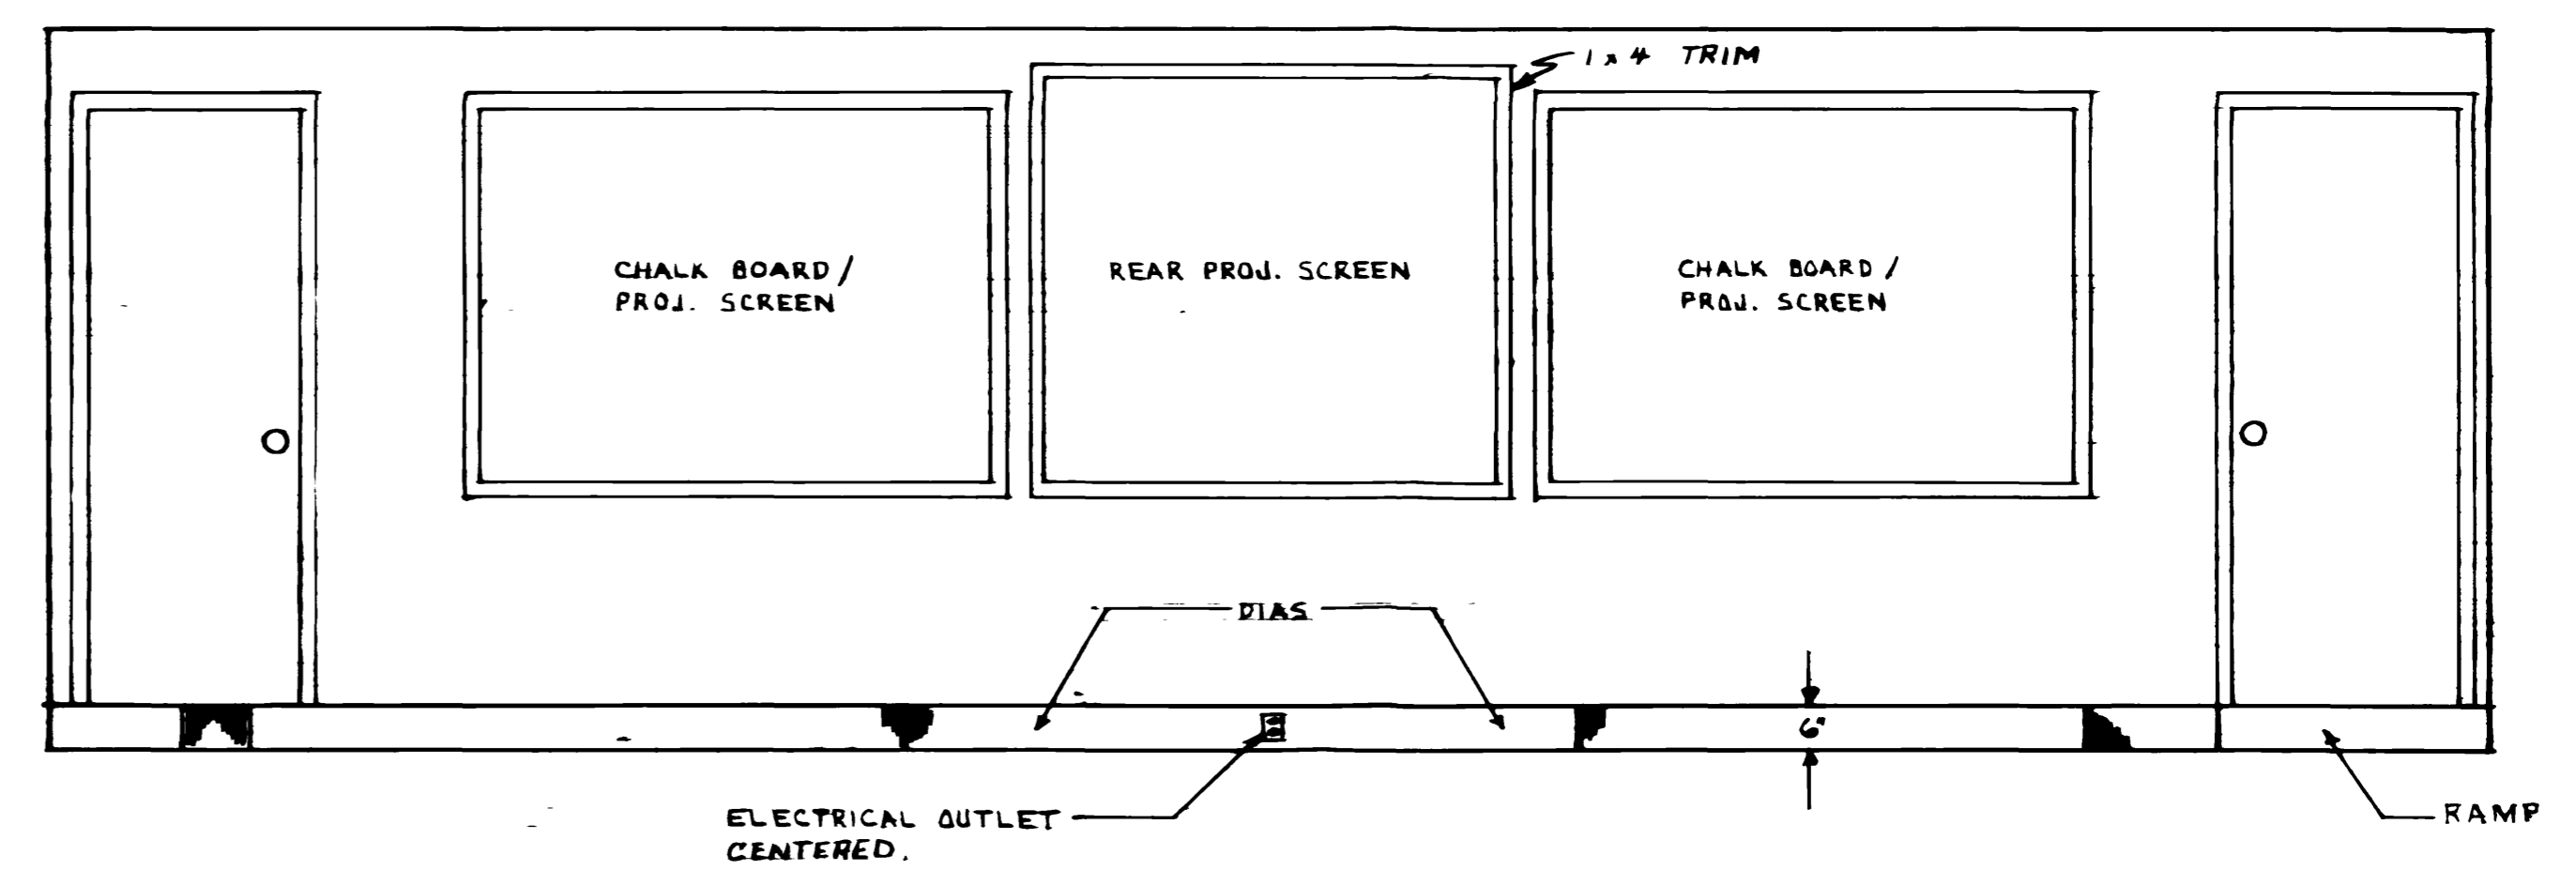

**A LARGE CLASSROOM**  
SCALE 1/2" = 1'-0"

ROOM #	CEILING	FLOOR	BASE	WALLS			
				NORTH	SOUTH	EAST	WEST
3 2 6	TEXTURED ACOUSTIC PAINT	CARPET	4" VINYL OR RUBBER	VWC	VWC	PAINT	PAINT
3 2 6 PROJECTION	UNFINISHED	VAT	4" VINYL OR RUBBER	PAINT	PAINT	PAINT	PAINT
3 2 6 STORAGE	UNFINISHED	VAT	4" VINYL OR RUBBER	PAINT	PAINT	PAINT	PAINT
2 1 0	TEXTURED ACOUSTIC PAINT	CARPET	4" VINYL OR RUBBER	VWC	VWC	PAINT	PAINT
2 1 1	TEXTURED ACOUSTIC PAINT	CARPET	4" VINYL OR RUBBER	VWC	VWC	PAINT	PAINT
3 1 0	TEXTURED ACOUSTIC PAINT	CARPET	4" VINYL OR RUBBER	VWC	VWC	PAINT	PAINT
3 1 1	TEXTURED ACOUSTIC PAINT	CARPET	4" VINYL OR RUBBER	VWC	VWC	PAINT	PAINT

RECORD DRAWING AS CONSTRUCTED

*Signature*

PROJECT NO. 79-0090 DATE 14 JUL 80

REV.	DATE	DESCRIPTION	DRAWN	APPROV.


MILITARY AIRLIFT COMMAND  
LITTLE ROCK A.F.B. ARK.

**CONSTRUCT CLASSROOMS,  
NCO ACADEMY**

BLDG. 842  
PLANS & SCHEDULES

DRAWN BY DAUGHERTY	TECH. REVIEWER <i>Signature</i>	DESIGNED BY <i>Signature</i>	DATE 14 JULY 80
SCALE AS SHOWN	PROJECT NO. LRK 79-0090	DRAWING NO. M-2182	SHEET 3 OF 5



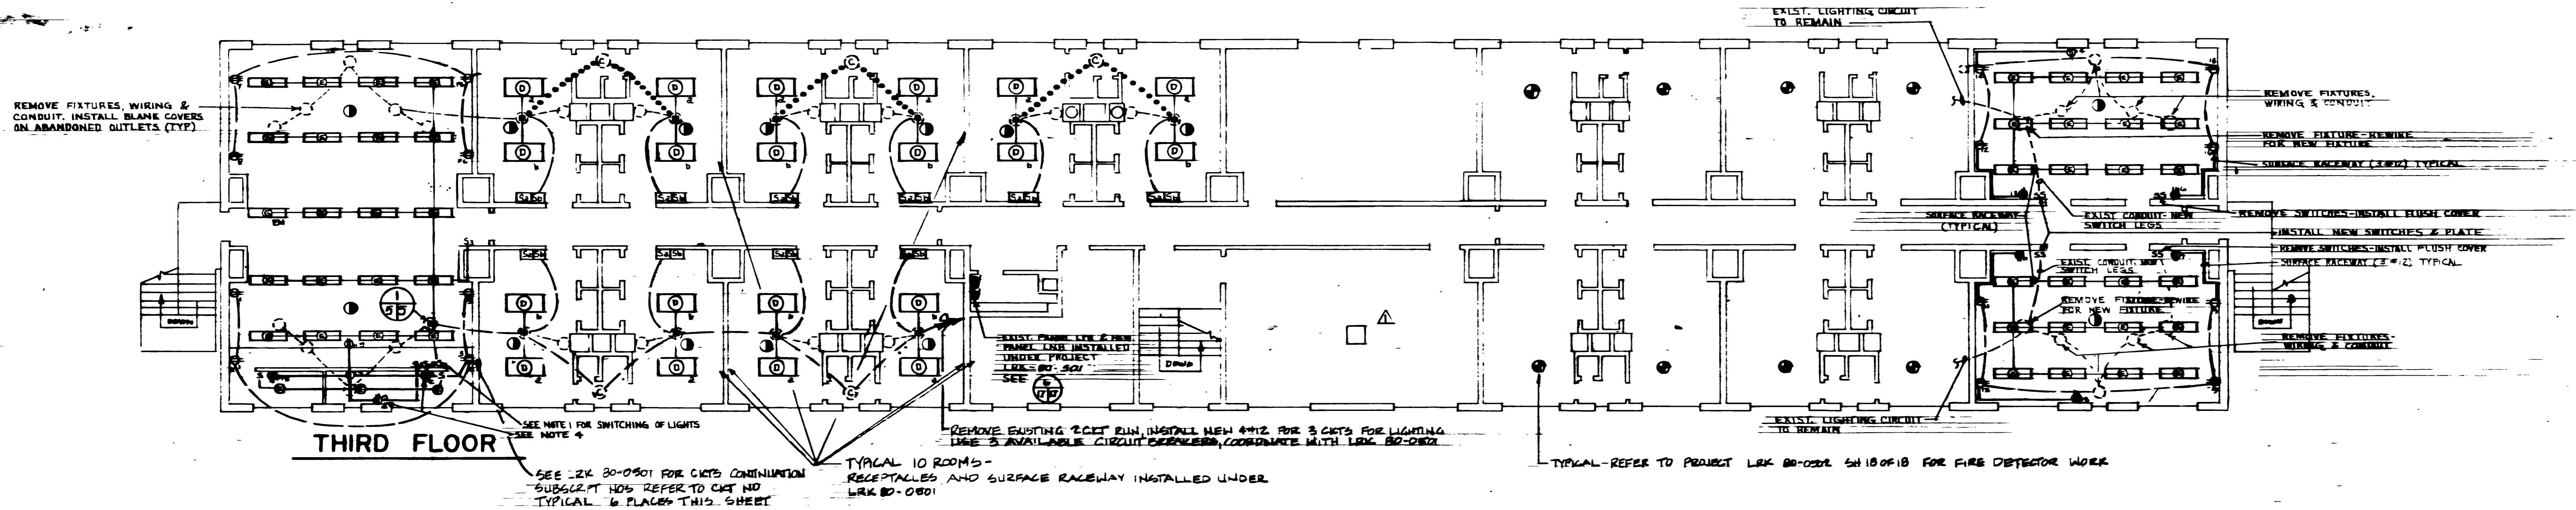

**ELECTRICAL LEGEND**

- ⓪ 2 FLUORESCENT FIXTURE - ⓪ INDICATES TYPE PER SCHEDULE, 2 INDICATES SWITCHING
- Ⓜ INCANDESCENT FIXTURE - M INDICATES TYPE PER SCHEDULE
- Ⓢ FIXTURE INSTALLED UNDER LRK 74-0500 III, SEE SHT. 17 OF 18
- Ⓢ FIXTURE TO BE REMOVED, INSTALL BLANK OUTLET COVER.
- S<sub>2</sub> SINGLE POLE SWITCH; 2 INDICATES SWITCHING
- S<sub>3</sub> THREE WAY SWITCH
- D DIMMER SWITCH
- S SWITCH INSTALLED UNDER LRK 74-0500 III, SEE SHT. 17 OF 18
- NEW SURFACE RACEWAY & CONDUCTORS (SEE NOTE 2)
- ..... EXISTING WIRING & CONDUIT TO REMAIN
- WIRING & CONDUIT TO BE REMOVED
- EXISTING - REWIRE AS SHOWN IN EXISTING CONDUIT
- Ⓛ DUPLEX OUTLET - SEE NOTE 3
- Ⓢ SURFACE RACEWAY JUNCTION - SEE Ⓢ
- Ⓢ HEAT DETECTOR INSTALLED UNDER LRK 80-0502, SEE SHT. 18 OF 18
- Ⓢ SMOKE DETECTOR INSTALLED UNDER LRK 80-502, SEE SHT. 18 OF 18


FIXTURE SCHEDULE			
MARK	DISCRIPTION	LAMPS	MFG.
D	SURFACE FLUORESCENT - PRISMATIC CONTROL LENS NOMINAL 16" x 48"	4 - F40LW/R5/WM	MILLER 'H40120'
E	SURFACE FLUORESCENT - NOMINAL 1' x 4', ALUMINUM PARABOLIC REFLECTOR	2 - F40 CW	LIGHTOLIER HVP SERIES OR APPROVED EQUAL
F	SURFACE INCANDESCENT PORCELAIN LAMP HOLDER	1 - 100W A	
G	RECESSED FLUORESCENT 1' x 4', ALUMINUM PARABOLIC REFLECTOR	2 - F40 CW	LIGHTOLIER HVP SERIES OR APPROVED EQUAL

**SPECIFICATIONS - FIXTURES 'E' & 'G'**


- REFER TO FIXTURE SCHEDULE.
- PROVIDE SUITABLE DIMMING BALLASTS FOR FIXTURES. 2 LAMP BALLASTS SHALL BE INSTALLED WITH DIMMING BALLAST IN ALTERNATE FIXTURES. TANDAM WIRING SHALL BE USED TO OBTAIN THE REQUIRED DIMMING/SWITCHING ARRANGEMENT.

**NOTES**

- ONE LAMP IN EACH FIXTURE SHALL BE SWITCHED THE OTHER LAMP SHALL BE DIMMED. SEE FIXTURE Ⓢ & Ⓢ SPECIFICATIONS THIS SHEET. SW. - UNDIMMED LAMPS W/ 2-THREE WAY SWITCHES AS SHOWN.
- WHERE RACEWAY IS CONCEALED, CONDUIT MAY BE USED IN LIEU OF MANUFACTURED SURFACE RACEWAY.
- PROVIDE SURFACE RACEWAY OUTLET BOX & FITTINGS COMPATIBLE WITH & OF THE SAME MANUFACTURER AS THE RACEWAY.
- UPPER OUTLET OF DUPLEX IS TO BE SWITCHED AS SHOWN.

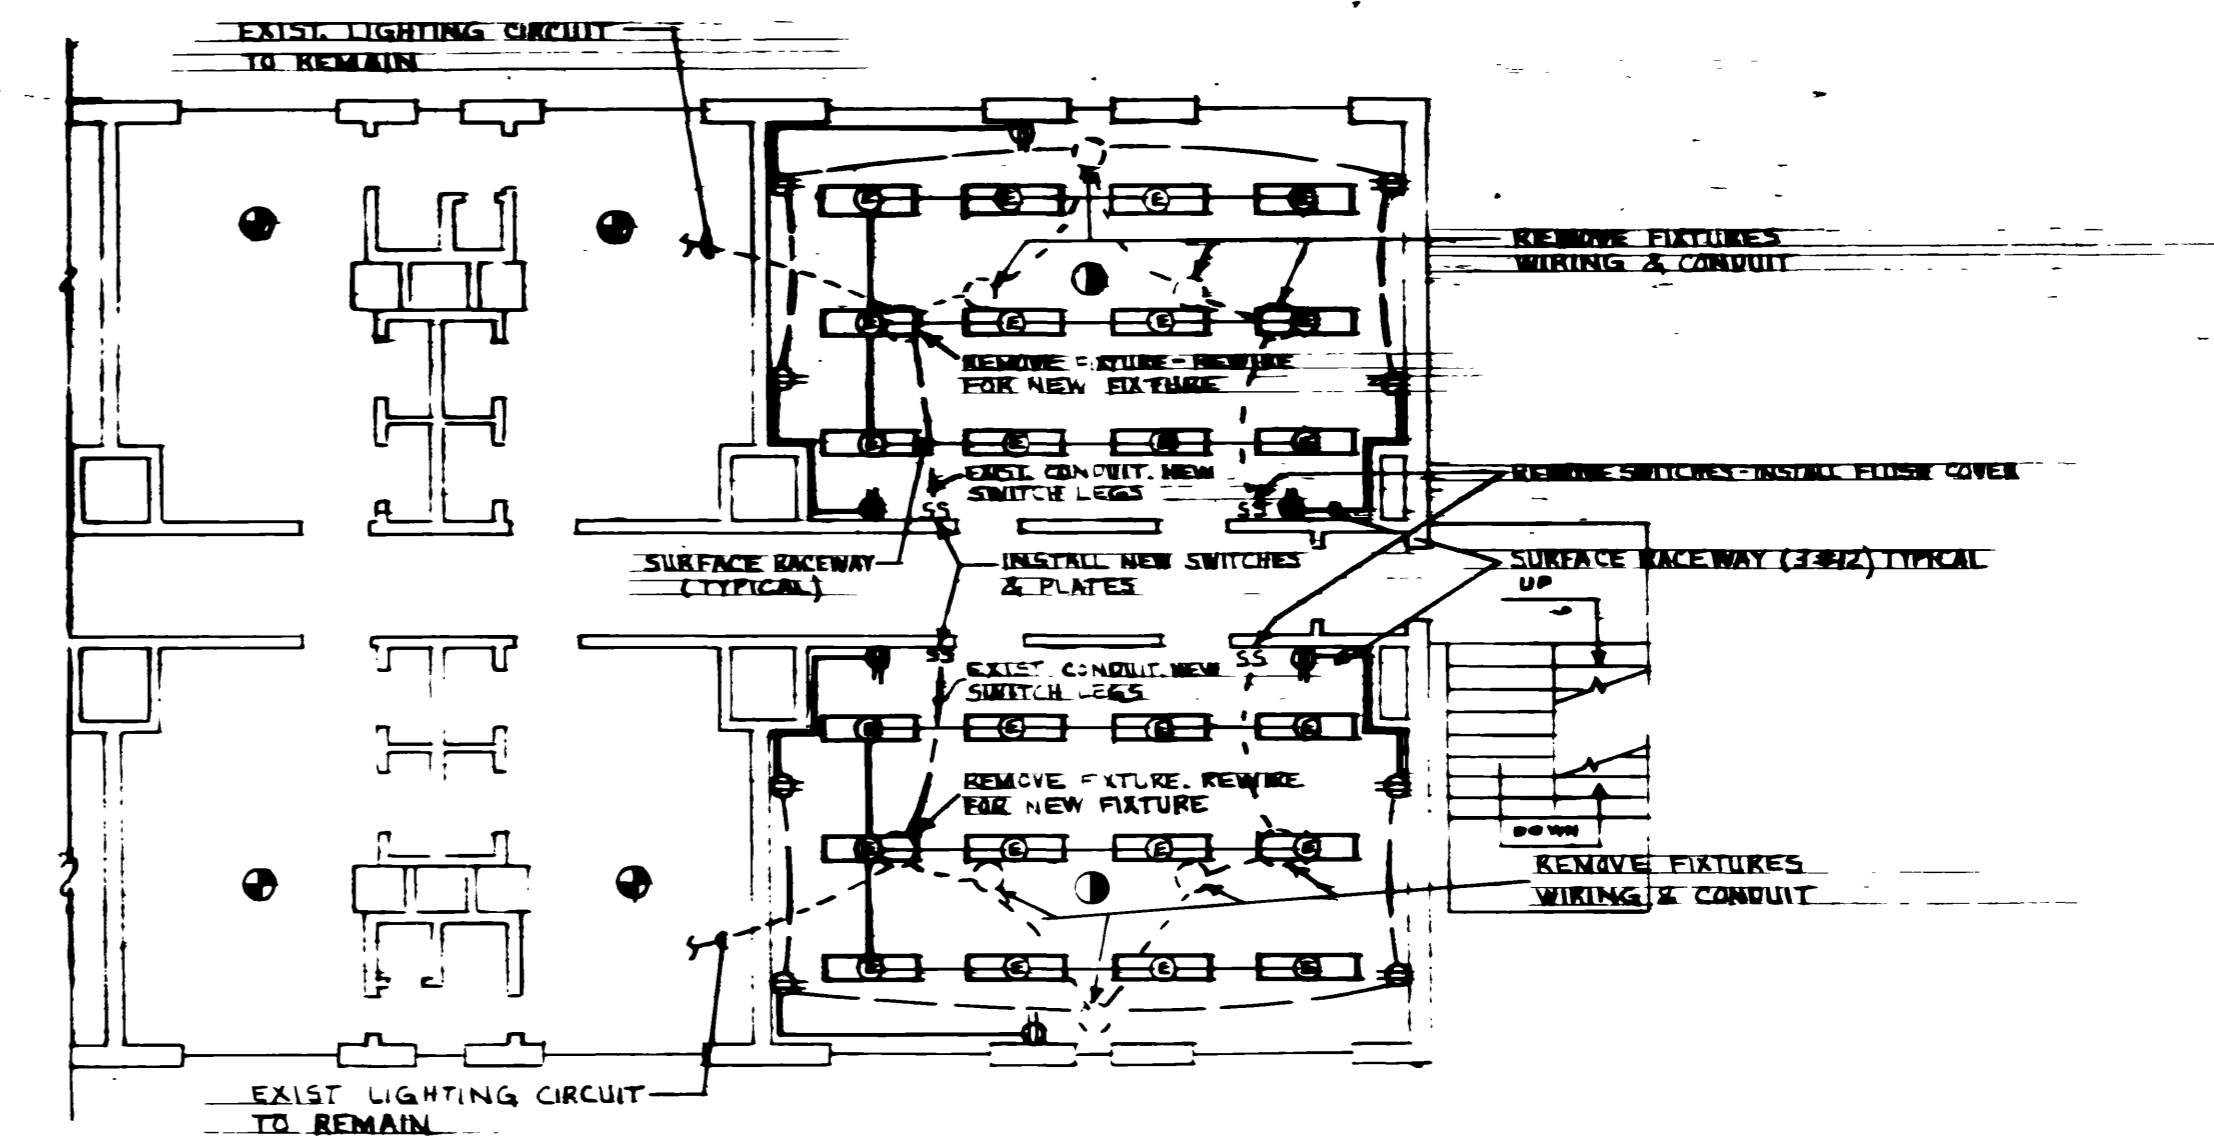

**SECOND FLOOR - PARTIAL PLAN**

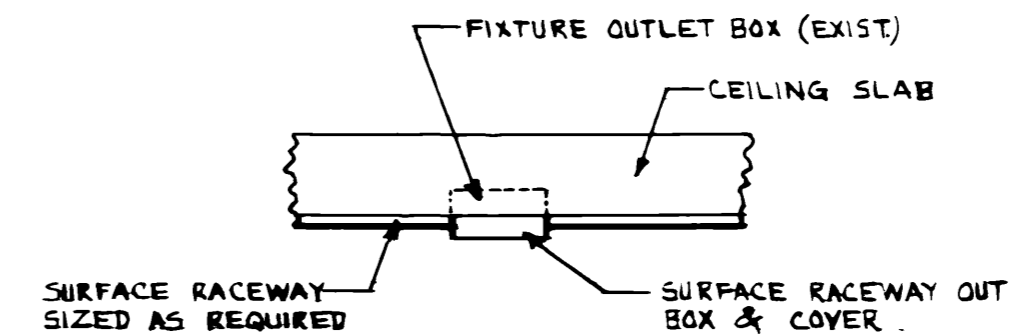


**SURFACE RACEWAY JUNCTION**  
NTS

RECORDED IN THE RECORDS SECTION  
*Joseph L. Baker*  
 PROJECT NO. 75-0090  
 DATE 12-20-72

REV.	DATE	DESCRIPTION	BY	APP'D
1	11/10/72	ADDED GENT FAN	RES	


**MILITARY AIRLIFT COMMAND  
LITTLE ROCK AFB, ARK.  
CONSTRUCT CLASSROOMS,  
NCO ACADEMY  
BLDG 842  
ELECTRICAL**

DRAWN BY DAUGHERTY  
 SCALE 1/8" = 1' - 0"  
 PROJECT NO. 75-0090  
 DRAWING NO. M-2182  
 SHEET 5 OF 5

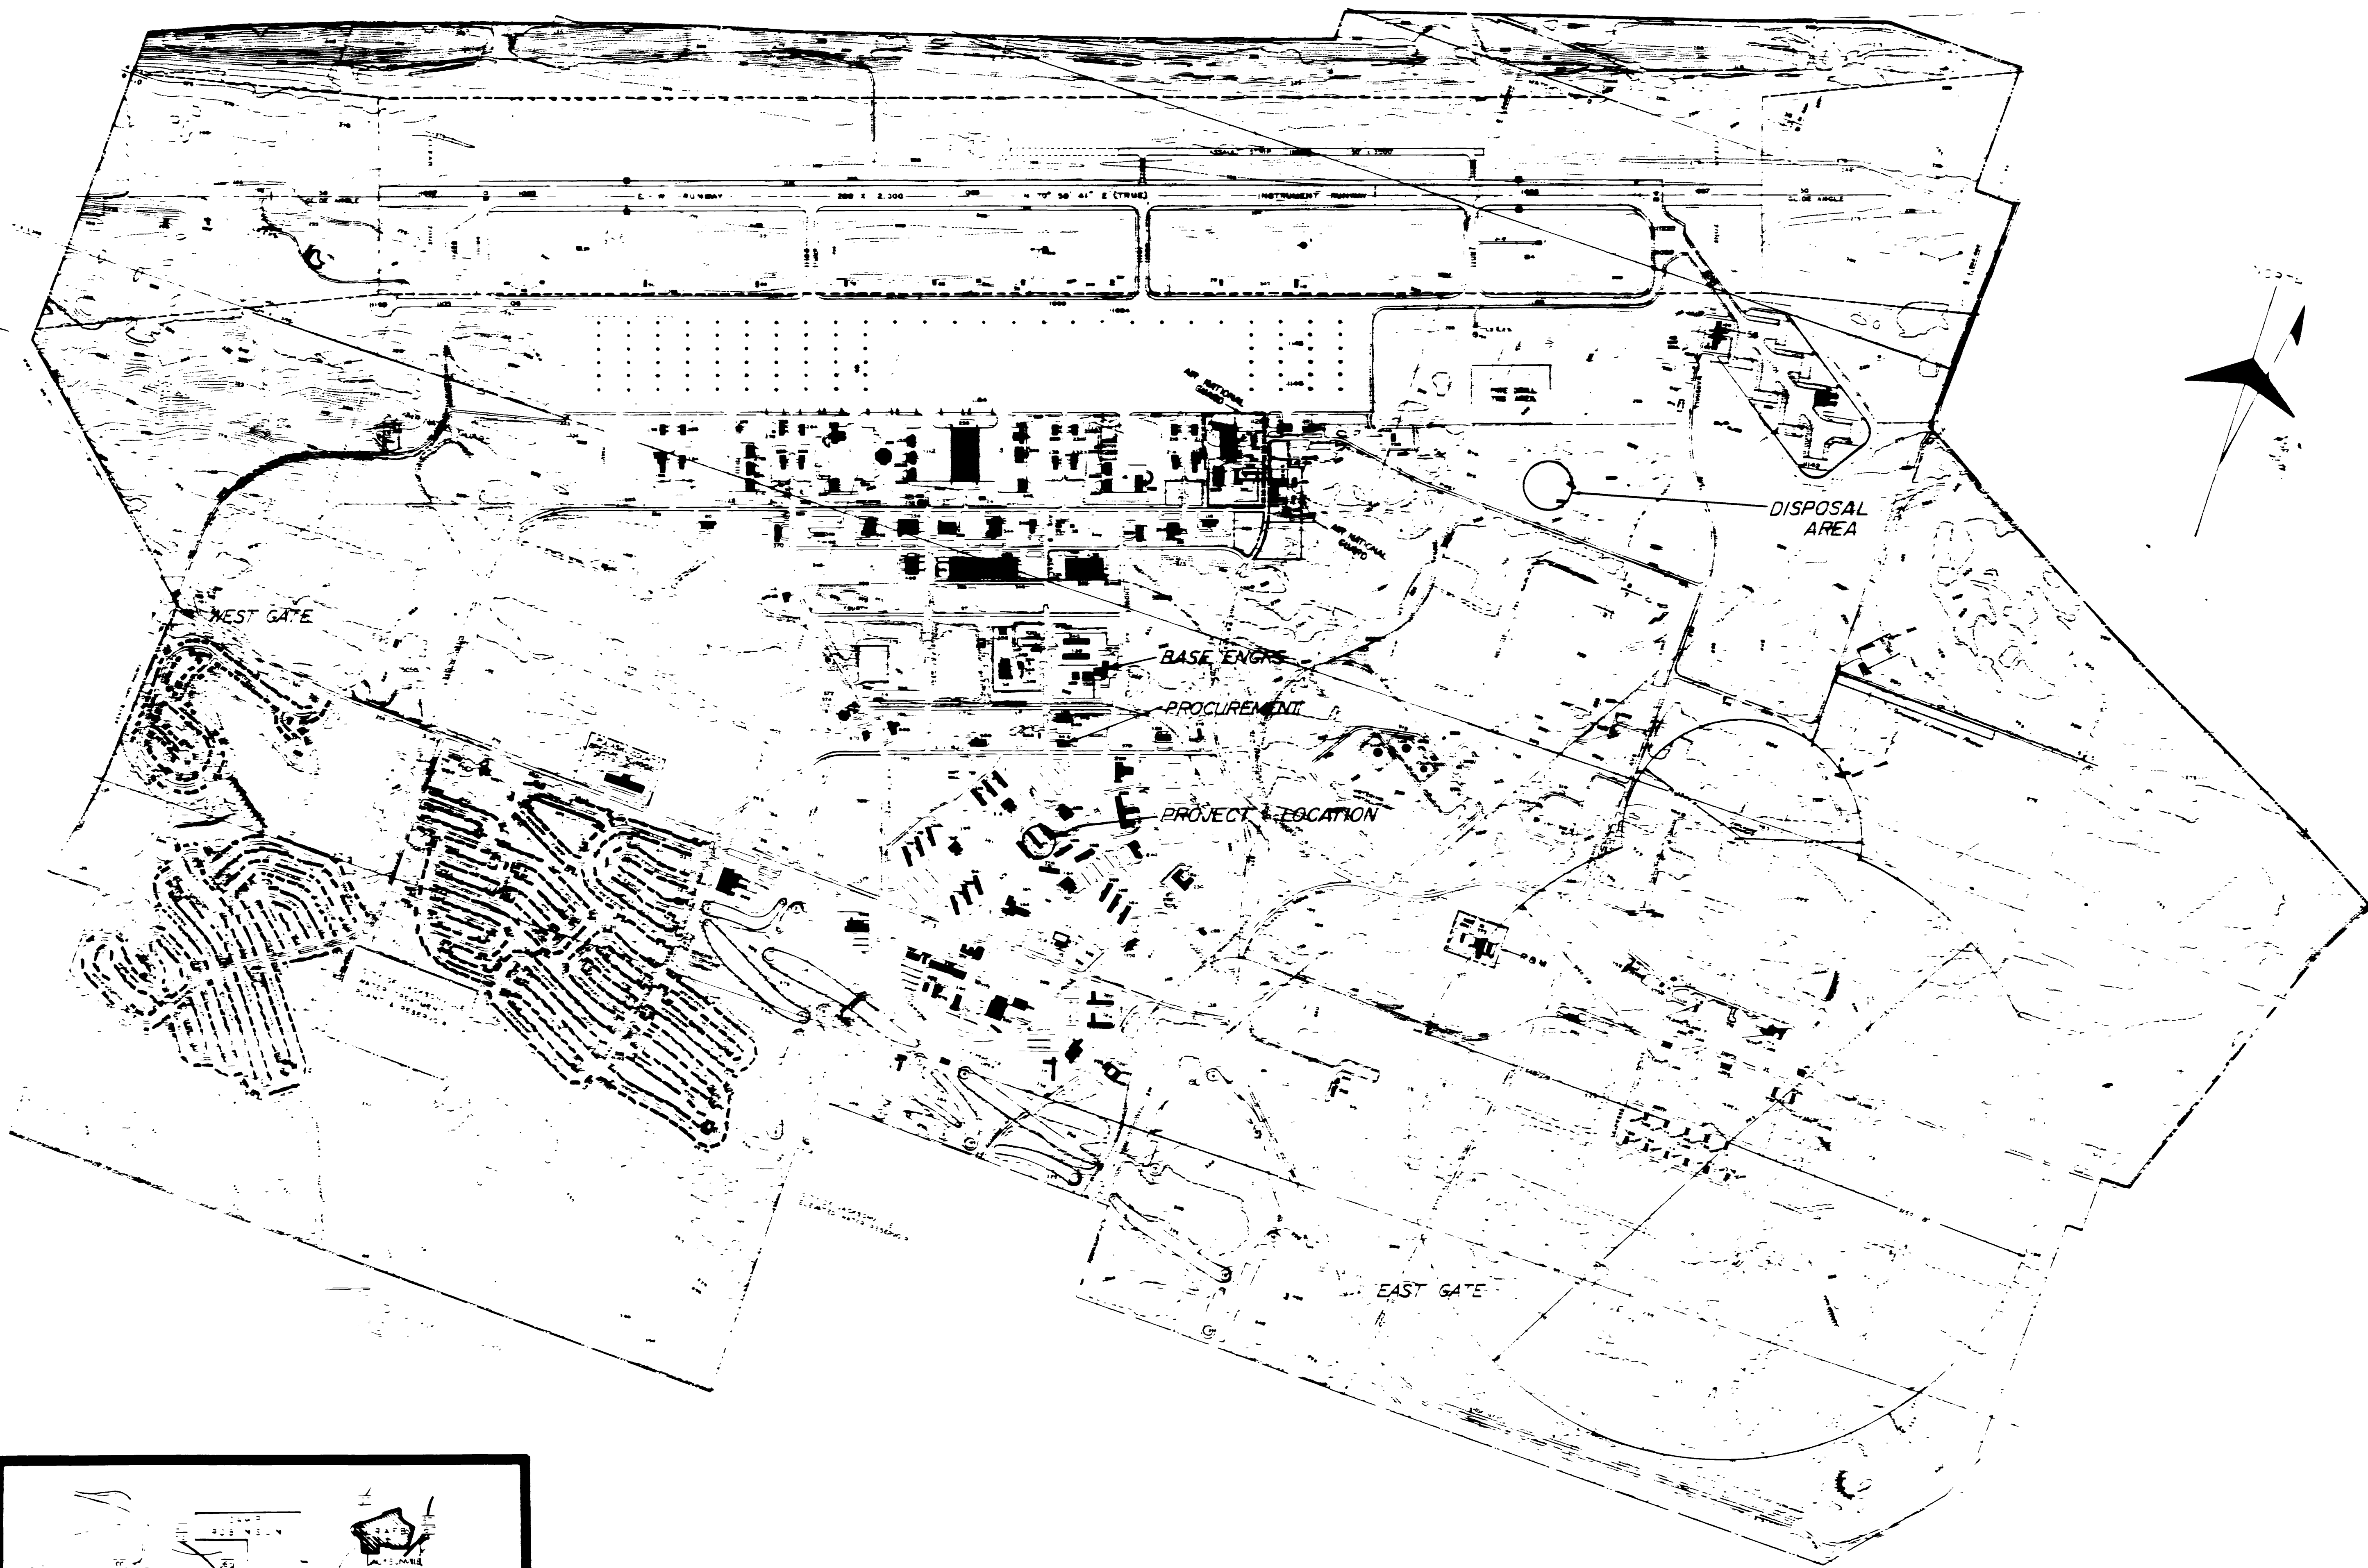




**INDEX**

SHEET NO.	TITLE
1	VICINITY MAP, PROJECT LOCATION, & INDEX
2	ROOF PLAN, DETAILS & SECTIONS

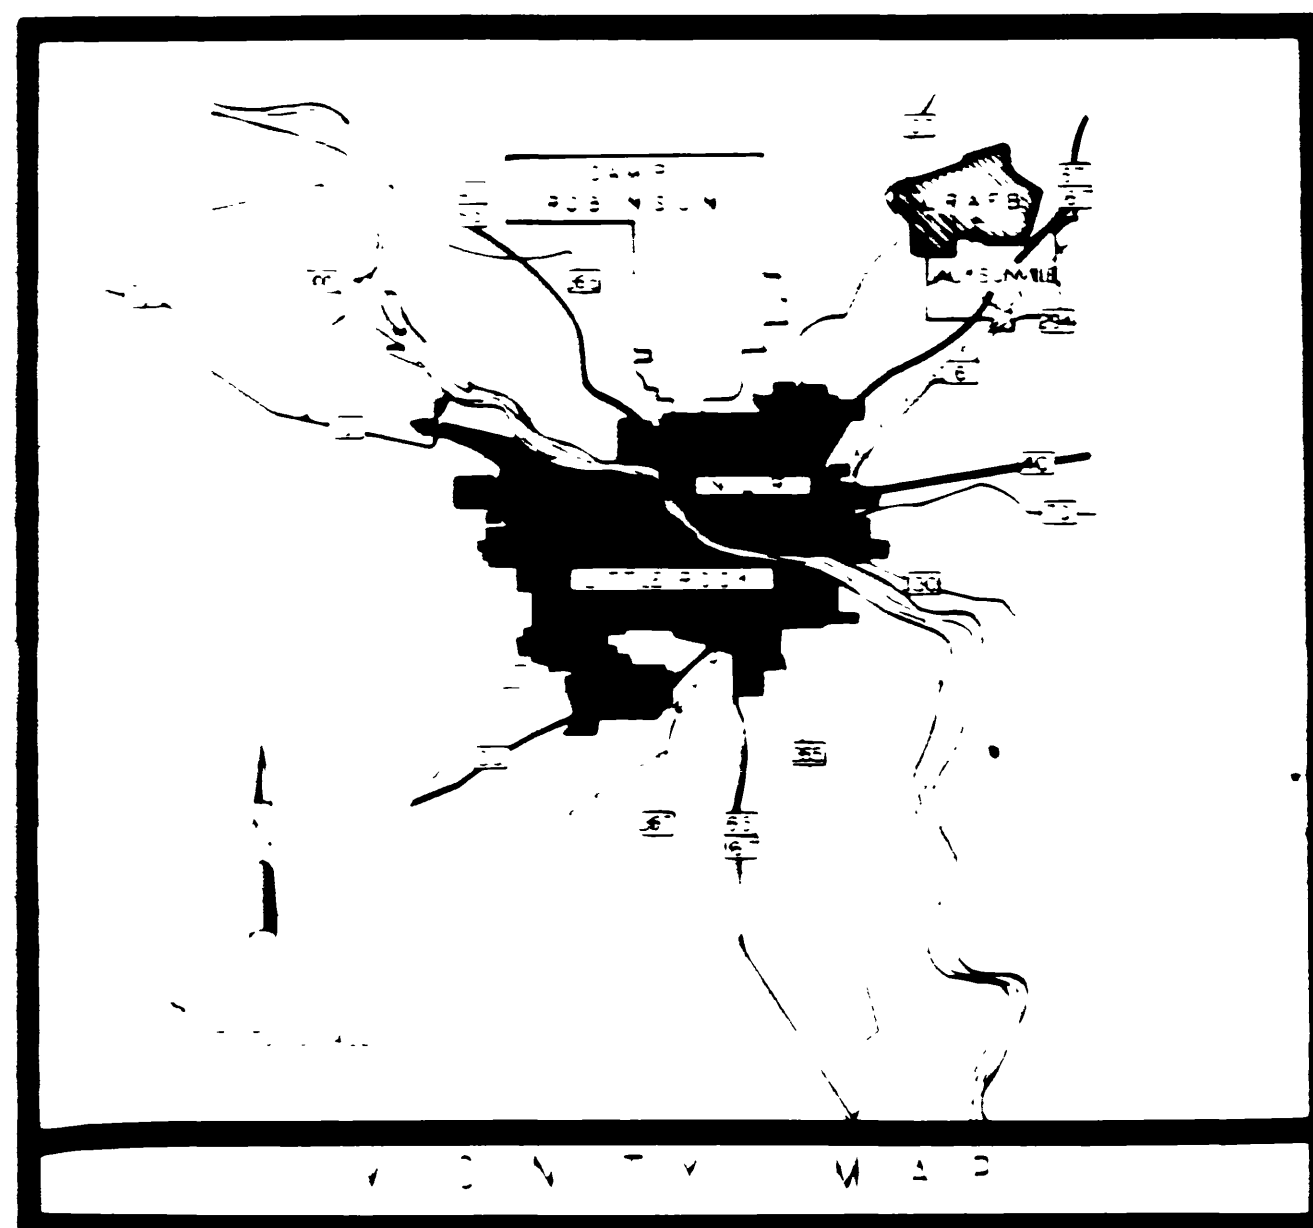

COORDINATION		REV. DATE DESCRIPTION DRAWN APPR. 2	
<i>Curt Mohler</i> CHECKED BY	OFFICE	DATE	
<i>W. J. ...</i> DESIGNED BY	FIRE CHIEF		
SECURITY POLICE	SAFETY		
REPAIR ROOF, BLDG. 842		VICINITY MAP, PROJECT LOCATION, & INDEX	
<i>Curt Mohler</i> POLLUTION CONT. ENG.	<i>...</i> SIG. ENVIRONMENTAL ENG.	SUBMITTED	APPROVED
N/A	<i>...</i> USING AGENCY	<i>...</i> CHIEF ENGINEER	<i>...</i> CIVIL ENGINEER
<i>...</i> CORROSION ENG.	<i>...</i> BASE COMMUNICATIONS	DATE	SHEET
<i>...</i> PROTECTIVE COATING	N/A	20 OCT 75	OF 2
SCALE	PROJECT NO.	DRAWING NO.	
1" = 800'	LRK 8-6 PT. 1	LRK-M-1830	



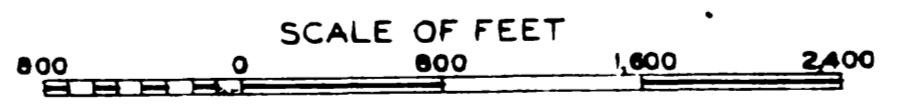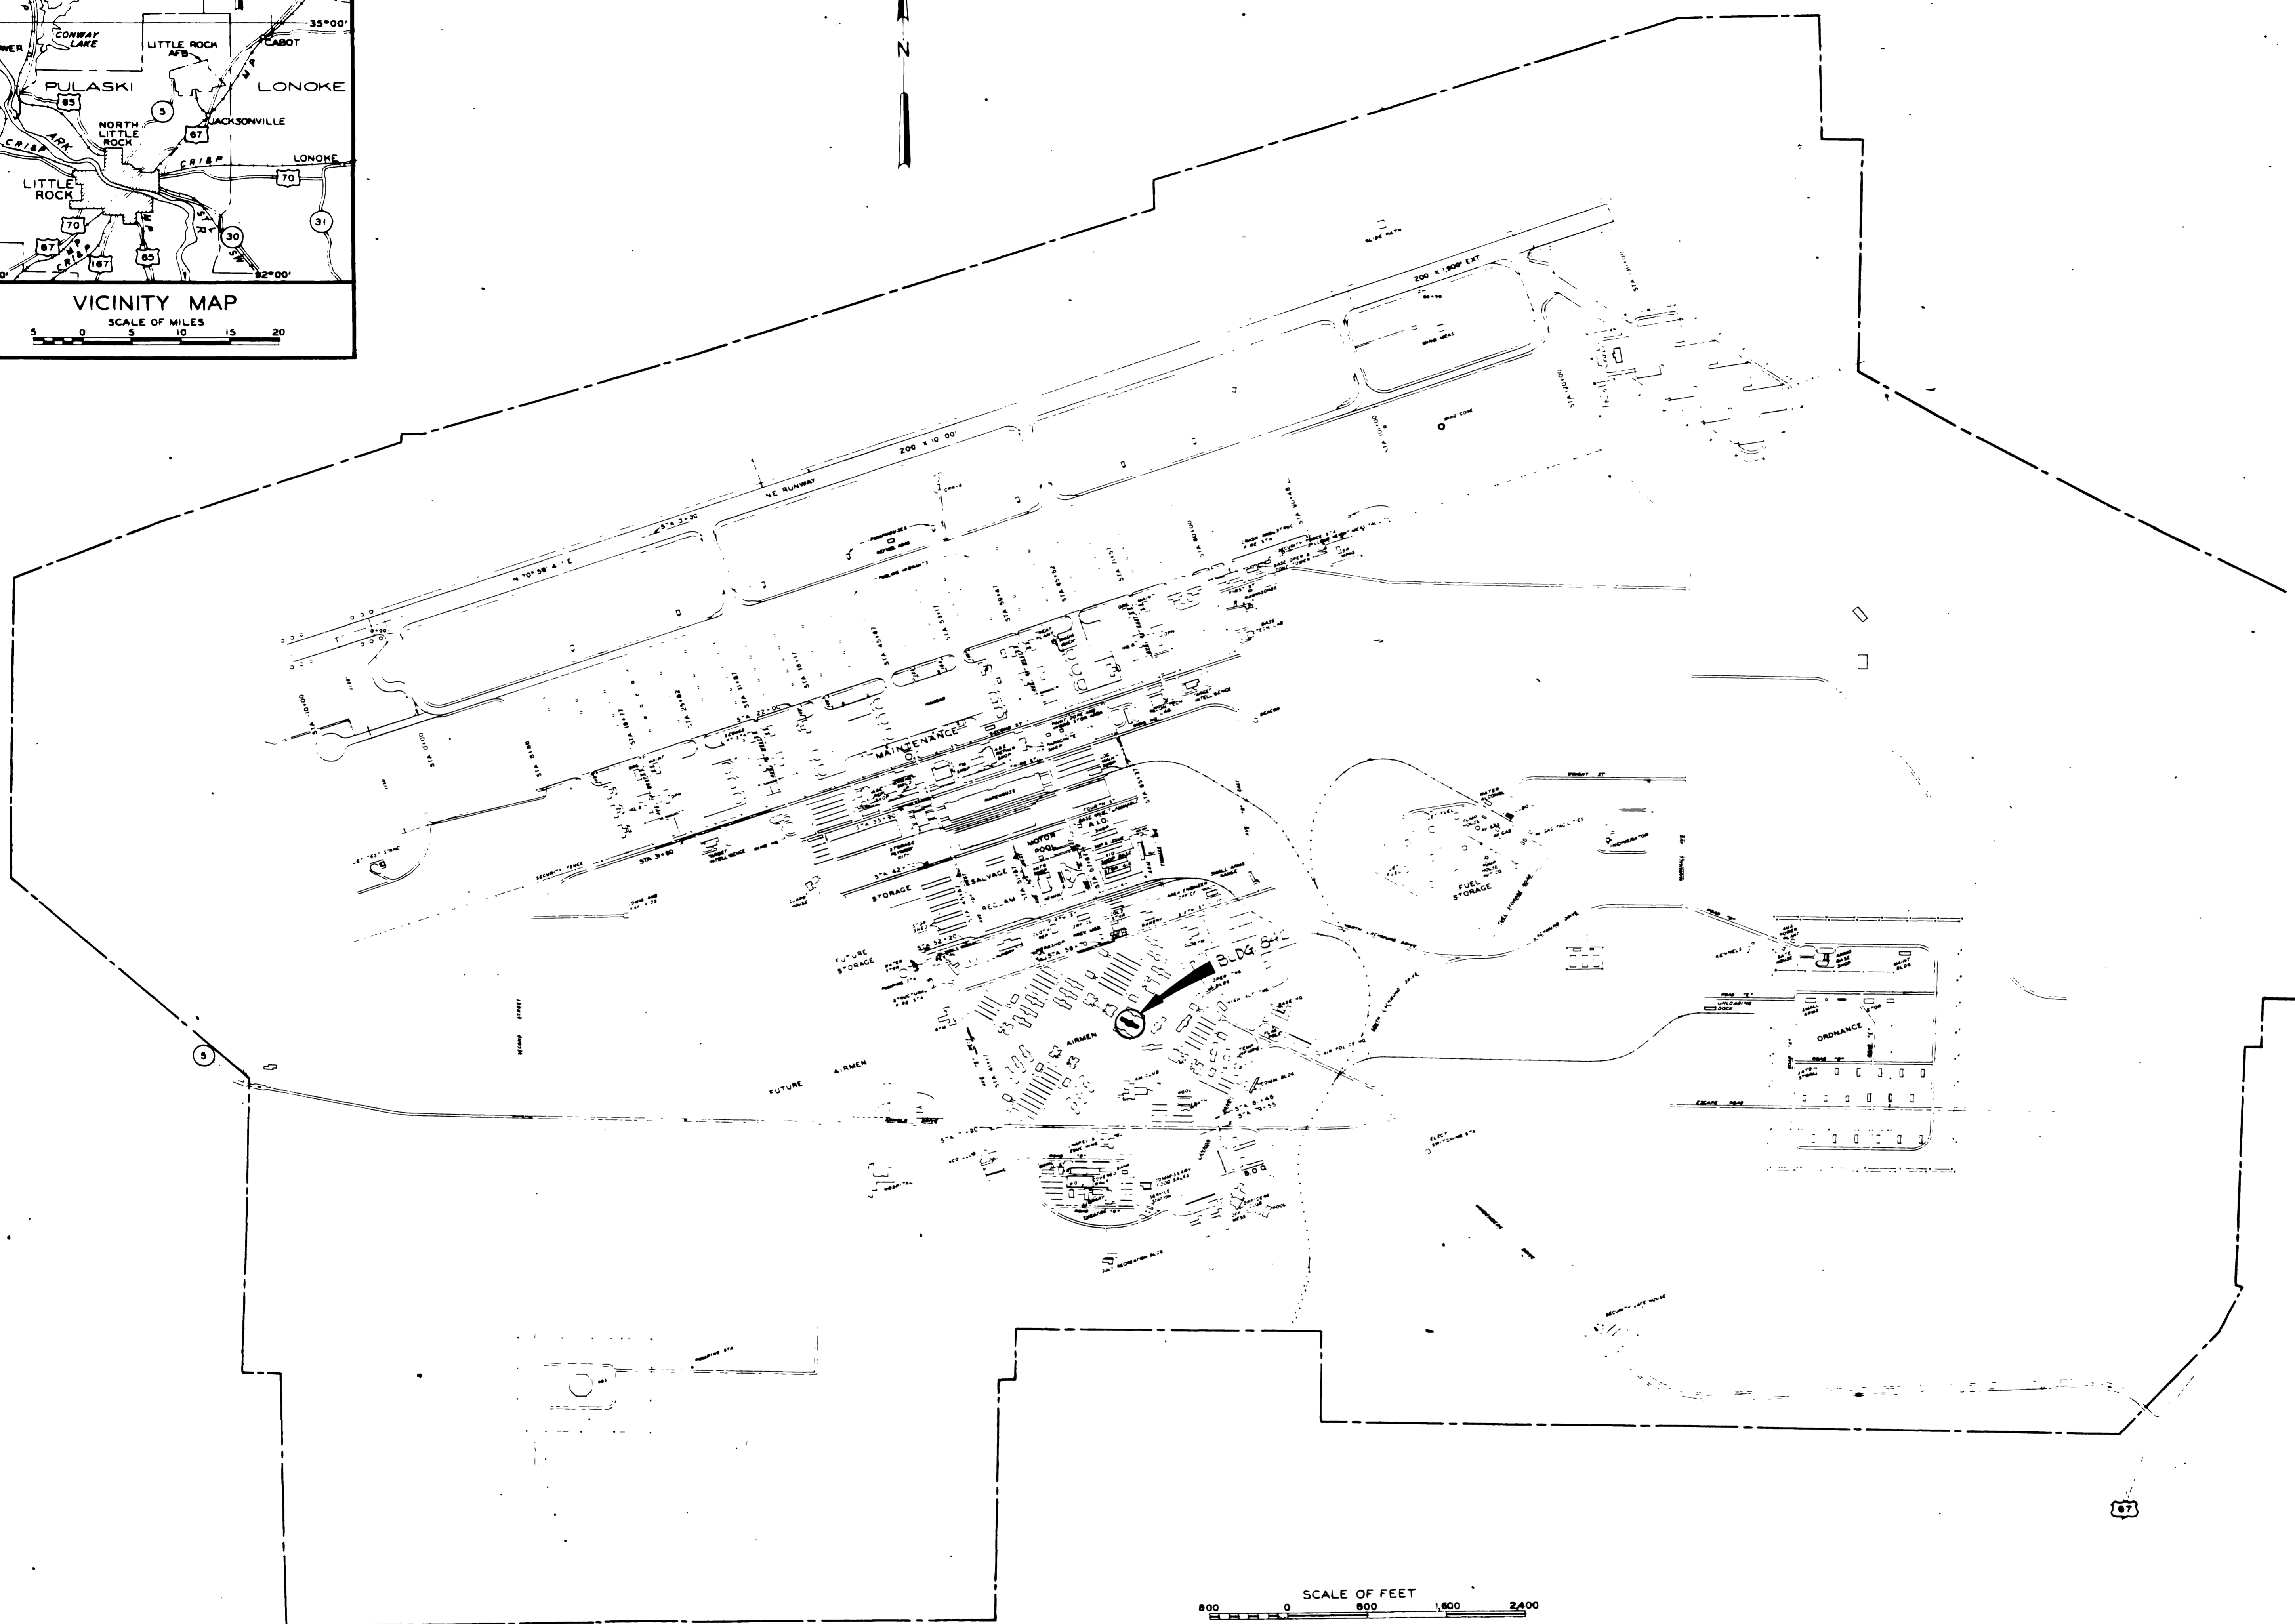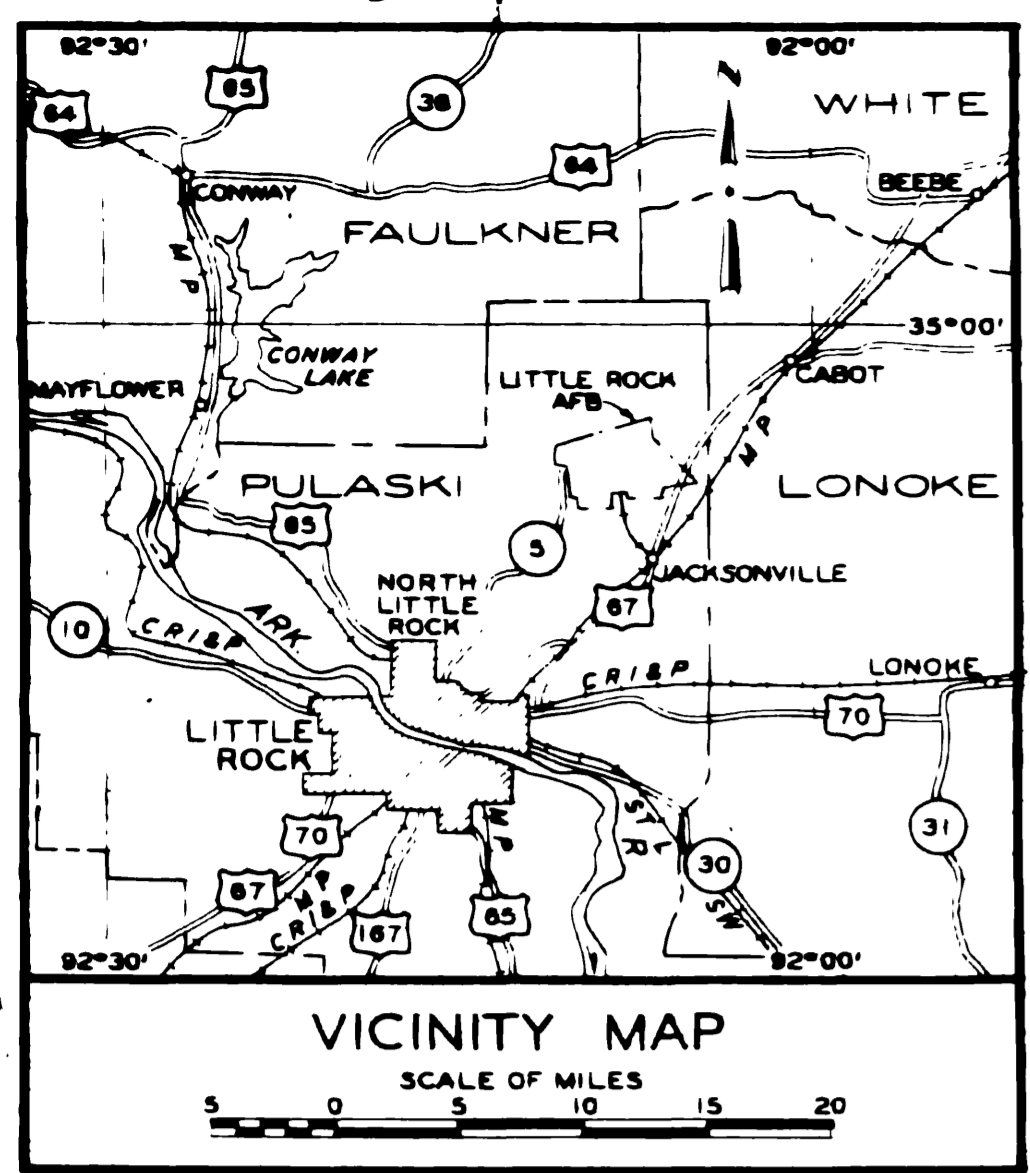

INDEX TO DRAWINGS

SHEET	TITLE
1 of 4	LOCATION MAP & INDEX
2 of 4	FLOOR PLANS & SCHEDULES
3 of 4	ELECTRICAL
4 of 4	MISC. DETAILS

RECEIVED  
PROJECT NO. L.R.K. 10-1


NO.	DATE	REVISION	BY	CK'D	AP'D

**STRATEGIC AIR COMMAND**  
JACKSONVILLE, ARKANSAS  
**LITTLE ROCK AIR FORCE BASE**  
MCD. BLDG. 342  
MISSILE ADMN. OFFICE  
LOCATION MAP & INDEX

SCALE: 1" = 800'	PROJECT NO. L.R.K. 10-1
DESIGNED: <i>[Signature]</i> CHIEF ENGINEER	RECOMMENDED: <i>[Signature]</i> D/C CIVIL ENGINEER
CHECKED: <i>[Signature]</i> DATE: <i>[Date]</i>	APPROVED: <i>[Signature]</i> DATE: <i>[Date]</i> COMMANDER
FIRE CHIEF	USING AGENCY
DRAWING NUMBER: L.R.K.-AC-832	SHEET 1 OF 4

RECORD DRAWING AS SHOWN  
DATE: 12/13/64  
BY: *[Signature]*


DATE: 12/13/64  
BY: *[Signature]*  
FIRE CHIEF

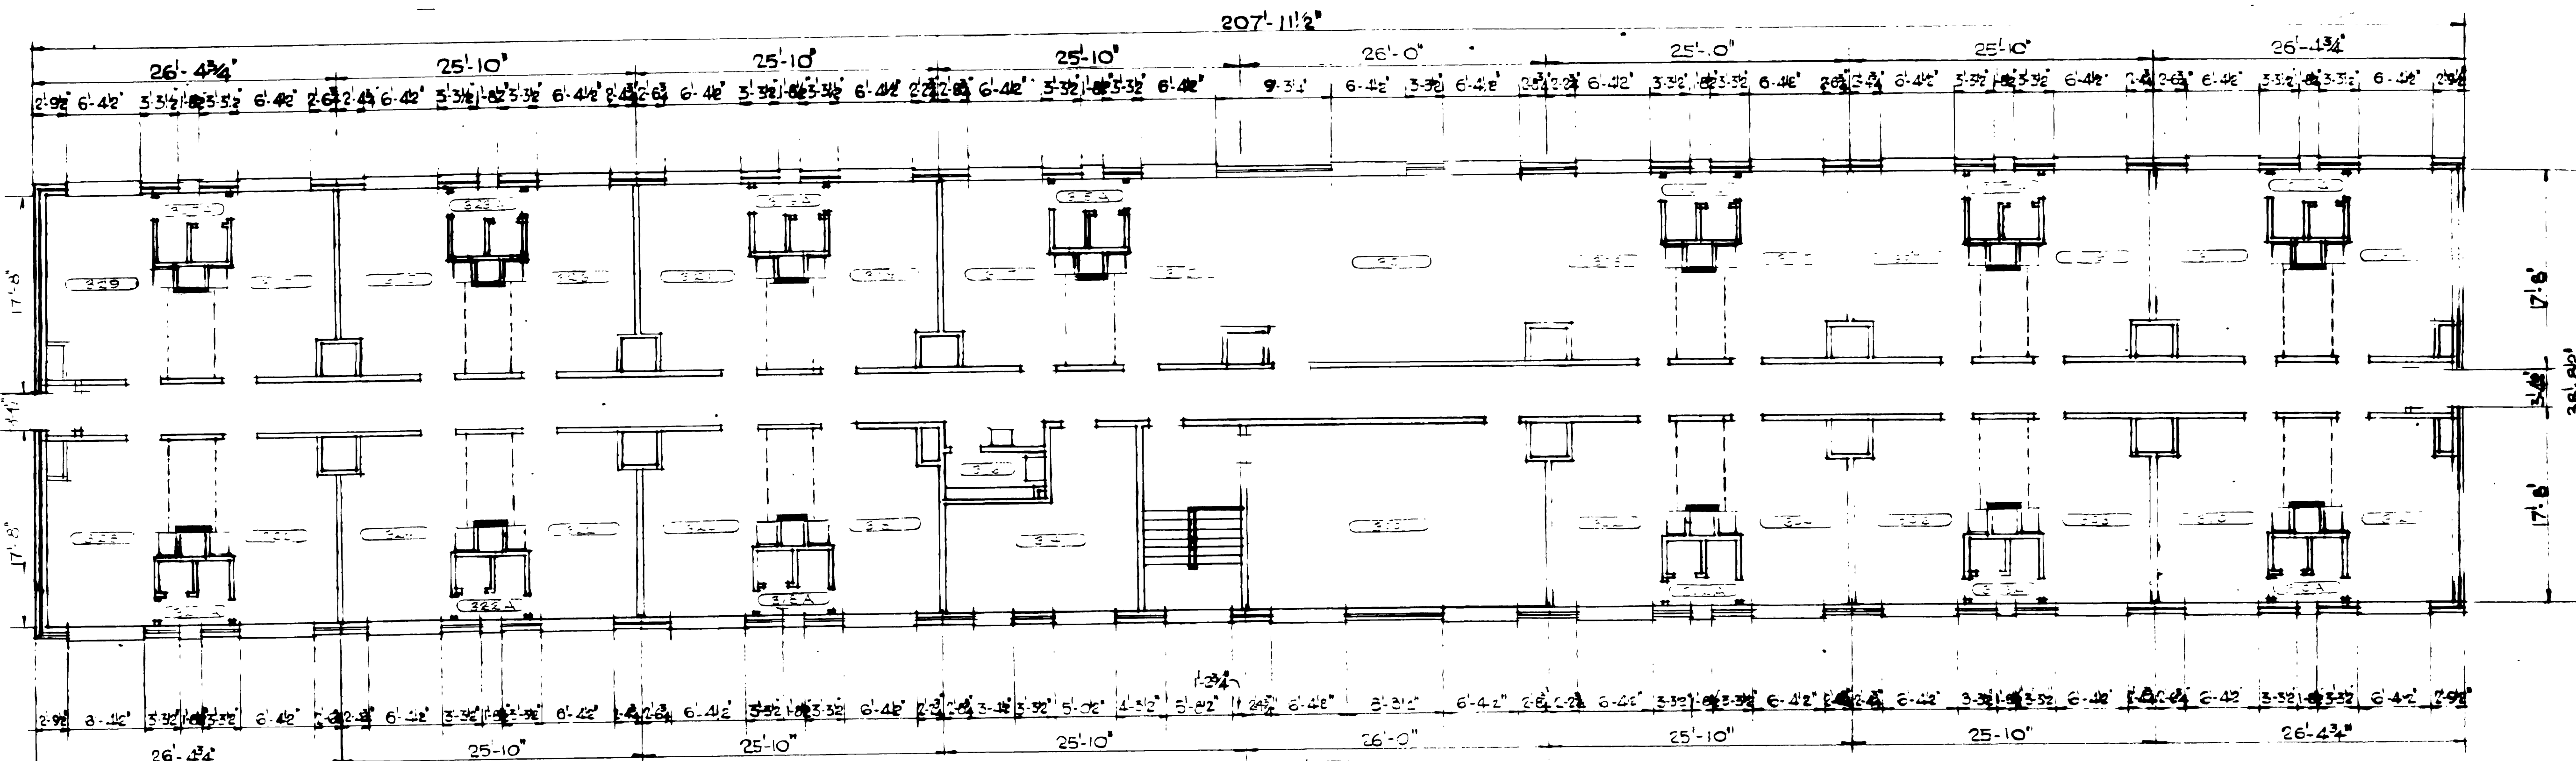

THIRD FLOOR PLAN SCALE: 1/8" = 1'-0"


NOTE:  
DOTTED LINES ON FLOOR PLANS  
INDICATE AREAS WHERE WALL LOCKERS  
ARE TO BE REMOVED

— INDICATES NEW WALL - 1/2" GYP BOARD  
ON 2x4 STUD WALL

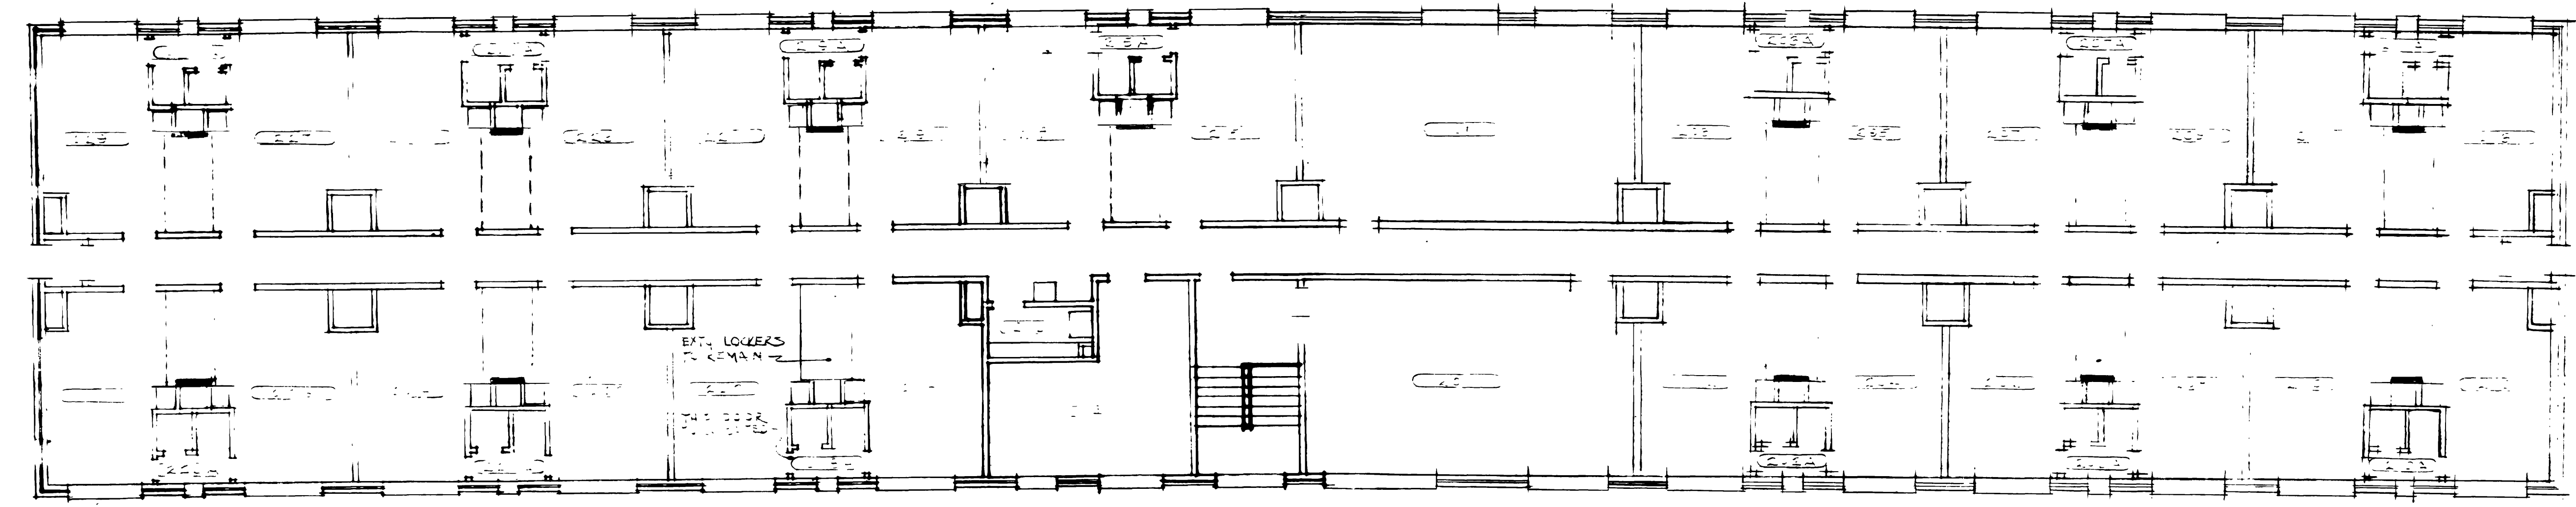

SECOND FLOOR PLAN SCALE: 1/8" = 1'-0"

REMOVE INSTALLED EQPT (SINKS & WASHERS)  
IN 201 & 202 CAP. DELIVER ALL  
EQPT, PIPING & FITTINGS TO BASE SUPPLY OFF.

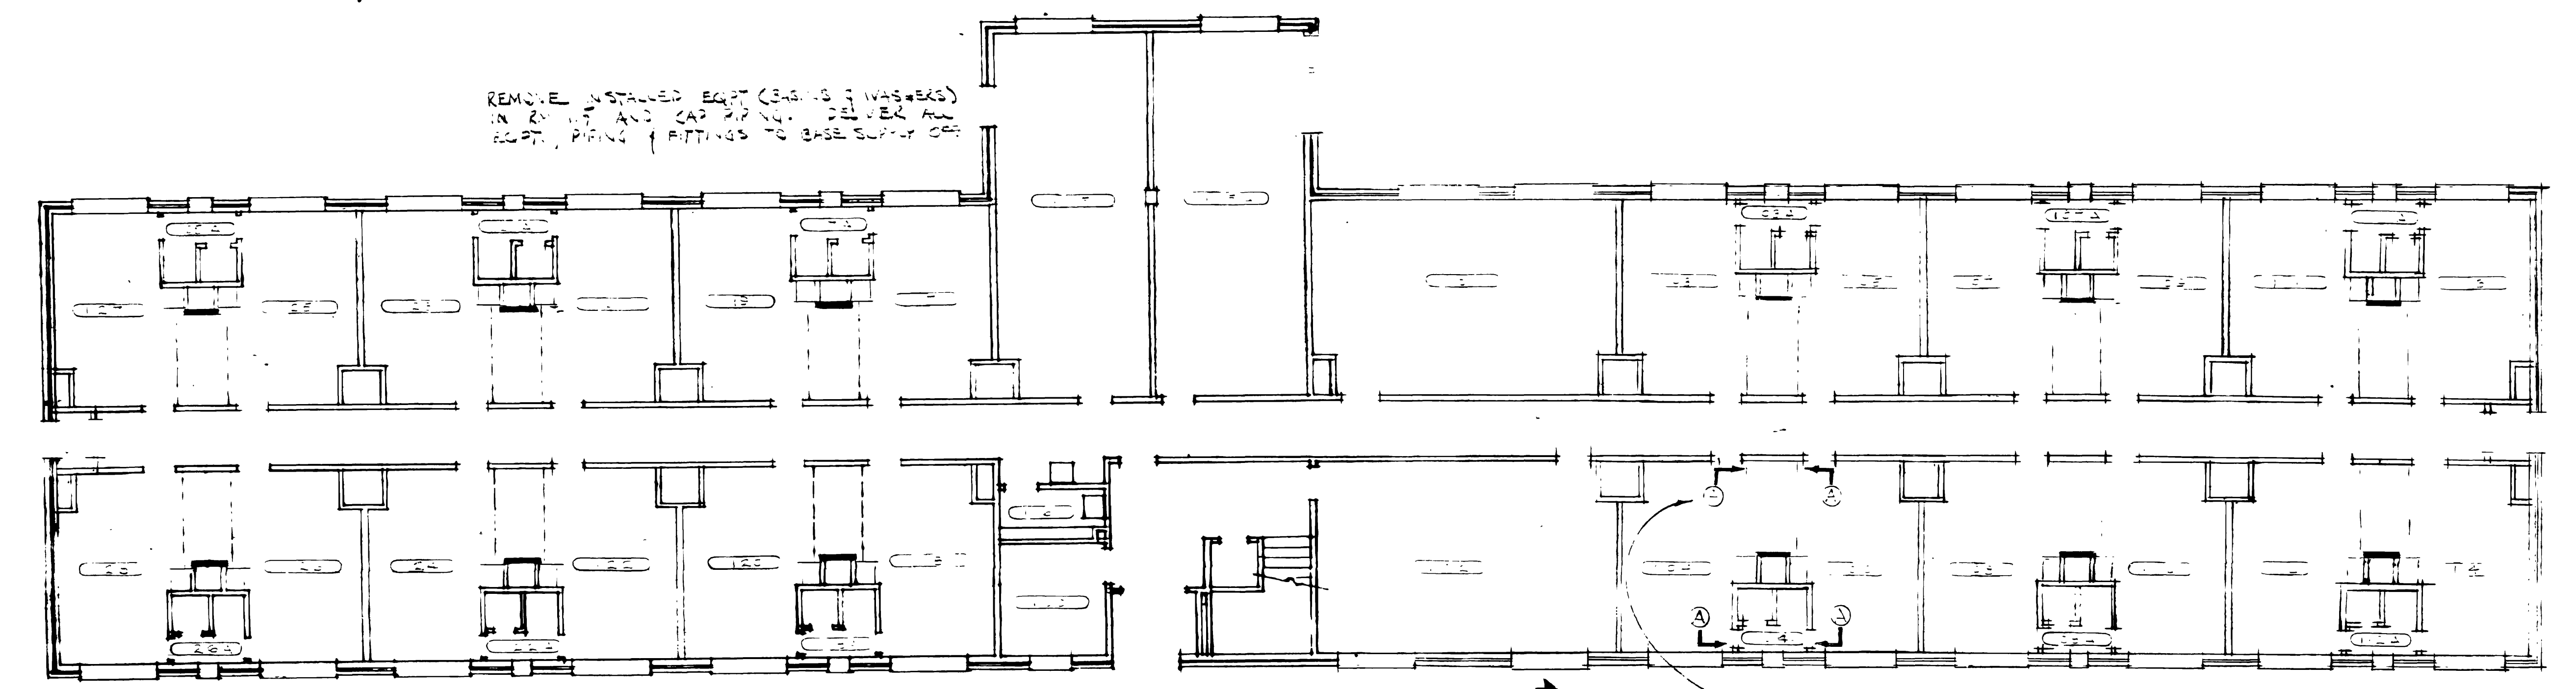

FIRST FLOOR PLAN SCALE: 1/8" = 1'-0"

SEE NOTES 1 AND 2 THIS SHEET  
FOR REMOVAL OF WARDROBES SEE SHEETS 4 & 4

- GENERAL NOTES:
- Contractor will remove prefabricated metal wardrobes where indicated on plans, and deliver to Base Salvage Officer for storage.
  - In areas where wardrobes have been removed, the following work will be required:
    - Asphalt tile floor to match existing floor on finish slab (underlayment is not required).
    - 1/4-inch plywood furring, trim, and 2x4 nailers at ceiling will be removed.
  - Dry-wall partitions will be provided where shown.

ROOM INDEX - PROPOSED MODIFICATION

MARK	ROOM UTILIZATION	MARK	ROOM UTILIZATION	MARK	ROOM UTILIZATION
100	Vending Machines	200	Office	300	Office
101	Office	201	Office	301	Office
102	Office	202	Office	302	Office
103	Office	202A	Toilet	302A	Toilet
103A	Toilet	203	Office	303	Office
104	Office	203A	Toilet	303A	Toilet
104A	Toilet	204	Office	304	Office
105	Office	205	Office	305	Office
106	Office	206	Office	306	Office
107	Office	206A	Toilet	306A	Toilet
107A	Toilet	207	Office	307	Office
108	Office	207A	Toilet	307A	Toilet
108A	Toilet	208	Office	308	Office
109	Office	209	Office	309	Office
110	Office	210	Office	310	Office
111	Office	210A	Toilet	310A	Toilet
111A	Toilet	211	Office	311	Office
112	Office	211A	Toilet	311A	Toilet
112A	Toilet	212	Office	312	Office
113	Office	213	Office	313	Office
114	Office	214	Storage	314	Storage
115	Reproduction Rm	215	Office	315	Office
115A	Heating Exp.	215A	Toilet	315A	Toilet
116	Office	216	Office	316	Office
117	Office	217	Office	317	Office
117A	Toilet	218	Women's Lounge	318	Office
118	Office	218A	Toilet	318A	Toilet
118A	Toilet	219	Office	319	Office
119	Office	219A	Toilet	319A	Toilet
120	Office	220	Technical Library	320	Office
121	Office	221	Office	321	Office
121A	Toilet	222	Office	322	Office
122	Toilet	222A	Toilet	322A	Toilet
122A	Toilet	223	Office	323	Office
123	Office	223A	Toilet	323A	Toilet
124	Office	224	Office	324	Office
125	Office	225	Office	325	Office
125A	Toilet	226	Office	326	Office
126	Office	226A	Toilet	326A	Toilet
126A	Toilet	227	Office	327	Office
127	Office	227A	Toilet	327A	Toilet
128	Office	228	Office	328	Office
		229	Office	329	Office


RECORD DRAWING AS CONSTRUCTED  
 DRAWN: [Signature]  
 CHIEF ENGINEER: [Signature]  
 PROJECT NO: [Signature]  
 DATE: 9-1-64

APPROVED: [Signature]	APPROVED: [Signature]	CHECKED: [Signature]	APPROVED: [Signature]	DRAWING NUMBER: LSK-40-8-2
FIRE CHIEF	USING AGENCY	DATE: 8/24/64	COMMANDER	SHEET 3 OF 4

NO. 842	GENERAL	REVISION	BY	CHK'D	AP'D
<b>STRATEGIC AIR COMMAND</b> JACKSONVILLE, ARKANSAS					
<b>LITTLE ROCK AIR FORCE BASE</b>					
MOD. BLDG. 842					
MISSILE ADMIN. OFFICE					
FLOOR PLANS & SCHEDULES					
SCALE: AS NOTED	PROJECT NO. LRK 10-1				
DRAWN: [Signature]	SUBMITTED: [Signature]	RECOMMENDED: [Signature]			
DESIGNED: [Signature]	CHIEF ENGINEER: [Signature]	D/C CIVIL ENGINEER: [Signature]			
CHECKED: [Signature]	APPROVED: [Signature]	DATE: 8/24/64			

842-10-1-2


All branch wiring units to be 3/4" Tel. Co. Panel, 12" x 18" box for 120V, 15A breakers.

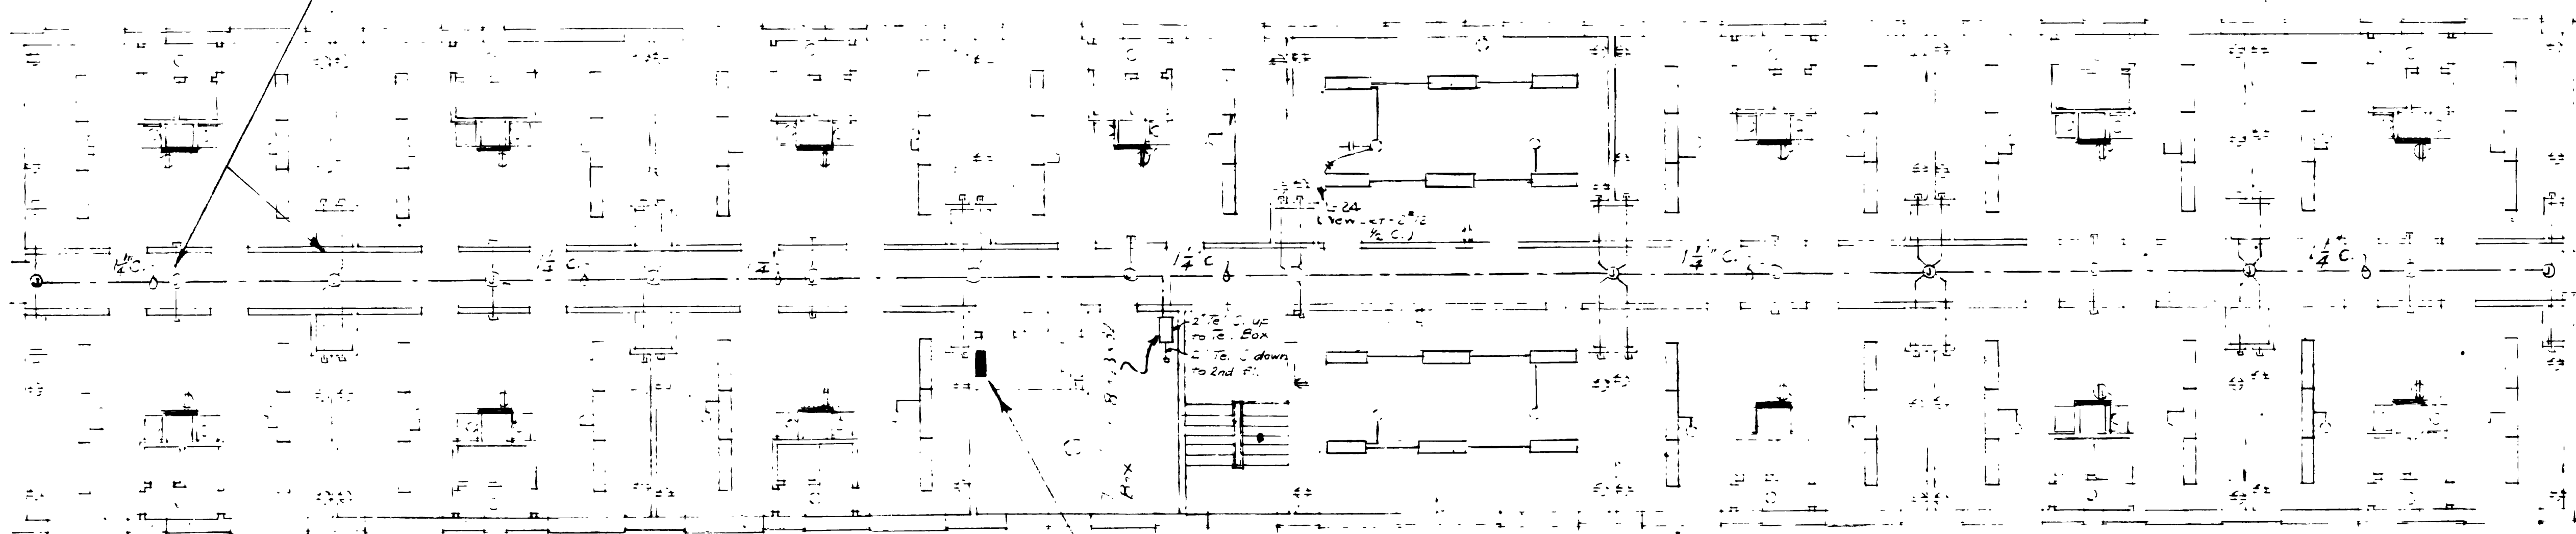

THIRD FLOOR PLAN

Provide 11-15A circuit breakers protecting fluorescent lighting with 20A breakers.


All branch wiring units to be 3/4" Tel. Co. Panel, 12" x 18" box for 120V, 15A breakers.

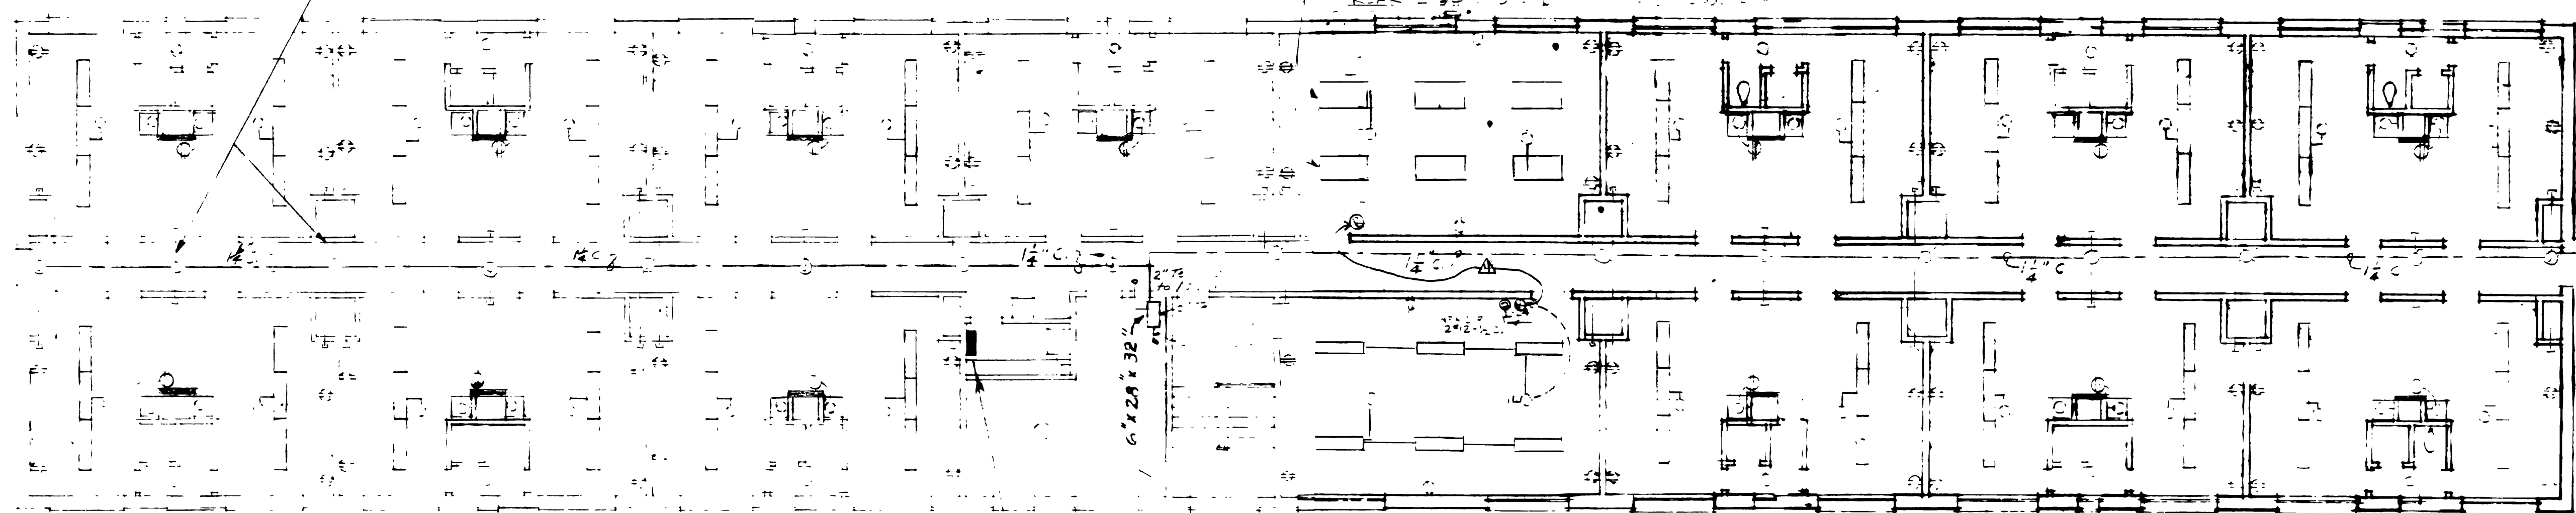

SECOND FLOOR PLAN

Provide 11-15A circuit breakers protecting fluorescent lighting with 20A breakers.

All branch wiring units to be 3/4" Tel. Co. Panel, 12" x 18" box for 120V, 15A breakers.

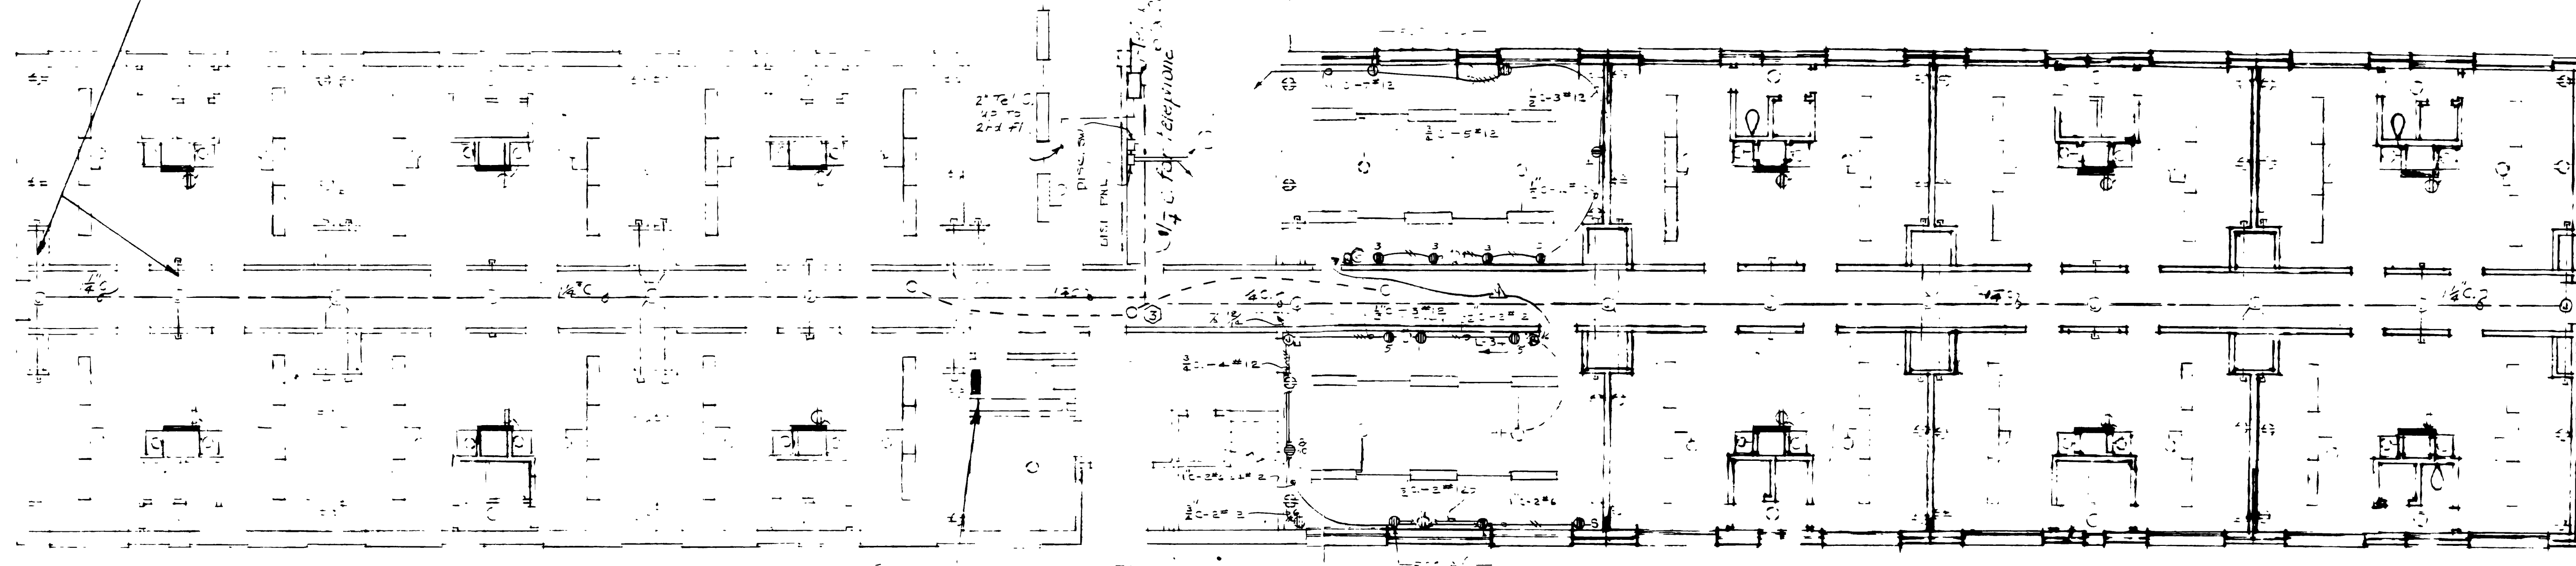

FIRST FLOOR PLAN

Provide 11-15A circuit breakers protecting fluorescent lighting with 20A breakers.

**LEGEND**

- ⊙ Existing Light Fixture
- ⊙ Existing duplex outlet
- Existing circuits or strip out
- New lighting circuit
- New telephone conduit or wiring
- Surface mounted fluorescent fixture (NEW) type F16, 2-40W rapid start lamps SEE SPEC. DIV. 5
- ⊕ New duplex receptacle
- Existing lighting panel box
- New panel box with 15 switch
- New telephone cabinet
- ⊕ TWO PORTABLE SWITCH WITH SWITCH RECEPTACLE SEE SPEC. DIV. 5
- ⊕ TELESTAT 400 #39019
- ⊕ NEW TELEPHONE JUNCTION BOX

**NOTES**


1. FOR ELECTRICAL SOURCE & INSTALLATION OF NEW LIGHTING FIXTURES SEE DETAIL OF MOUNTING LIGHTING FIXTURES SHEET 4-1-4
2. FOR TELEPHONE CONDUIT SYSTEM: Riser Diagram SEE SHEET 4-2-4
3. PROVIDE A TREATED TERRY WAL BENCH (APPROX 5' x 18" x 30" x 3/4") IN EACH TELEPHONE BOX.
4. PROVIDE RULLIN TELEPHONE CONDUIT (See Specs. Part 7-05.2.2)

5/17/77	REVISED APPROVED BY	DATE	BY
5/17/77	REVISED AS PER W/C # 2011		
1/24/76	GENERAL		
NO.	DATE	REVISION	BY


**STRATEGIC AIR COMMAND**  
**JACKSONVILLE, ARKANSAS**  
**LITTLE ROCK AIR FORCE BASE**  
 MOD. BLDG 94  
 MISSILE ADM. OFFICE  
 ELECTRICAL

RECORD DRAWING AS CONSTRUCTED  
 DRAWN: [Signature]  
 CHECKED: [Signature]  
 DATE: 9-16-74


SCALE: 1/8" = 1'-0"	PROJECT NO. LRR 10-1
DRAWN: [Signature]	RECOMMENDED: [Signature]
DESIGNED: [Signature]	BY: CIVIL ENGINEER
CHECKED: [Signature]	APPROVED: [Signature]
APPROVED: [Signature]	DRAWING NUMBER: [Signature]

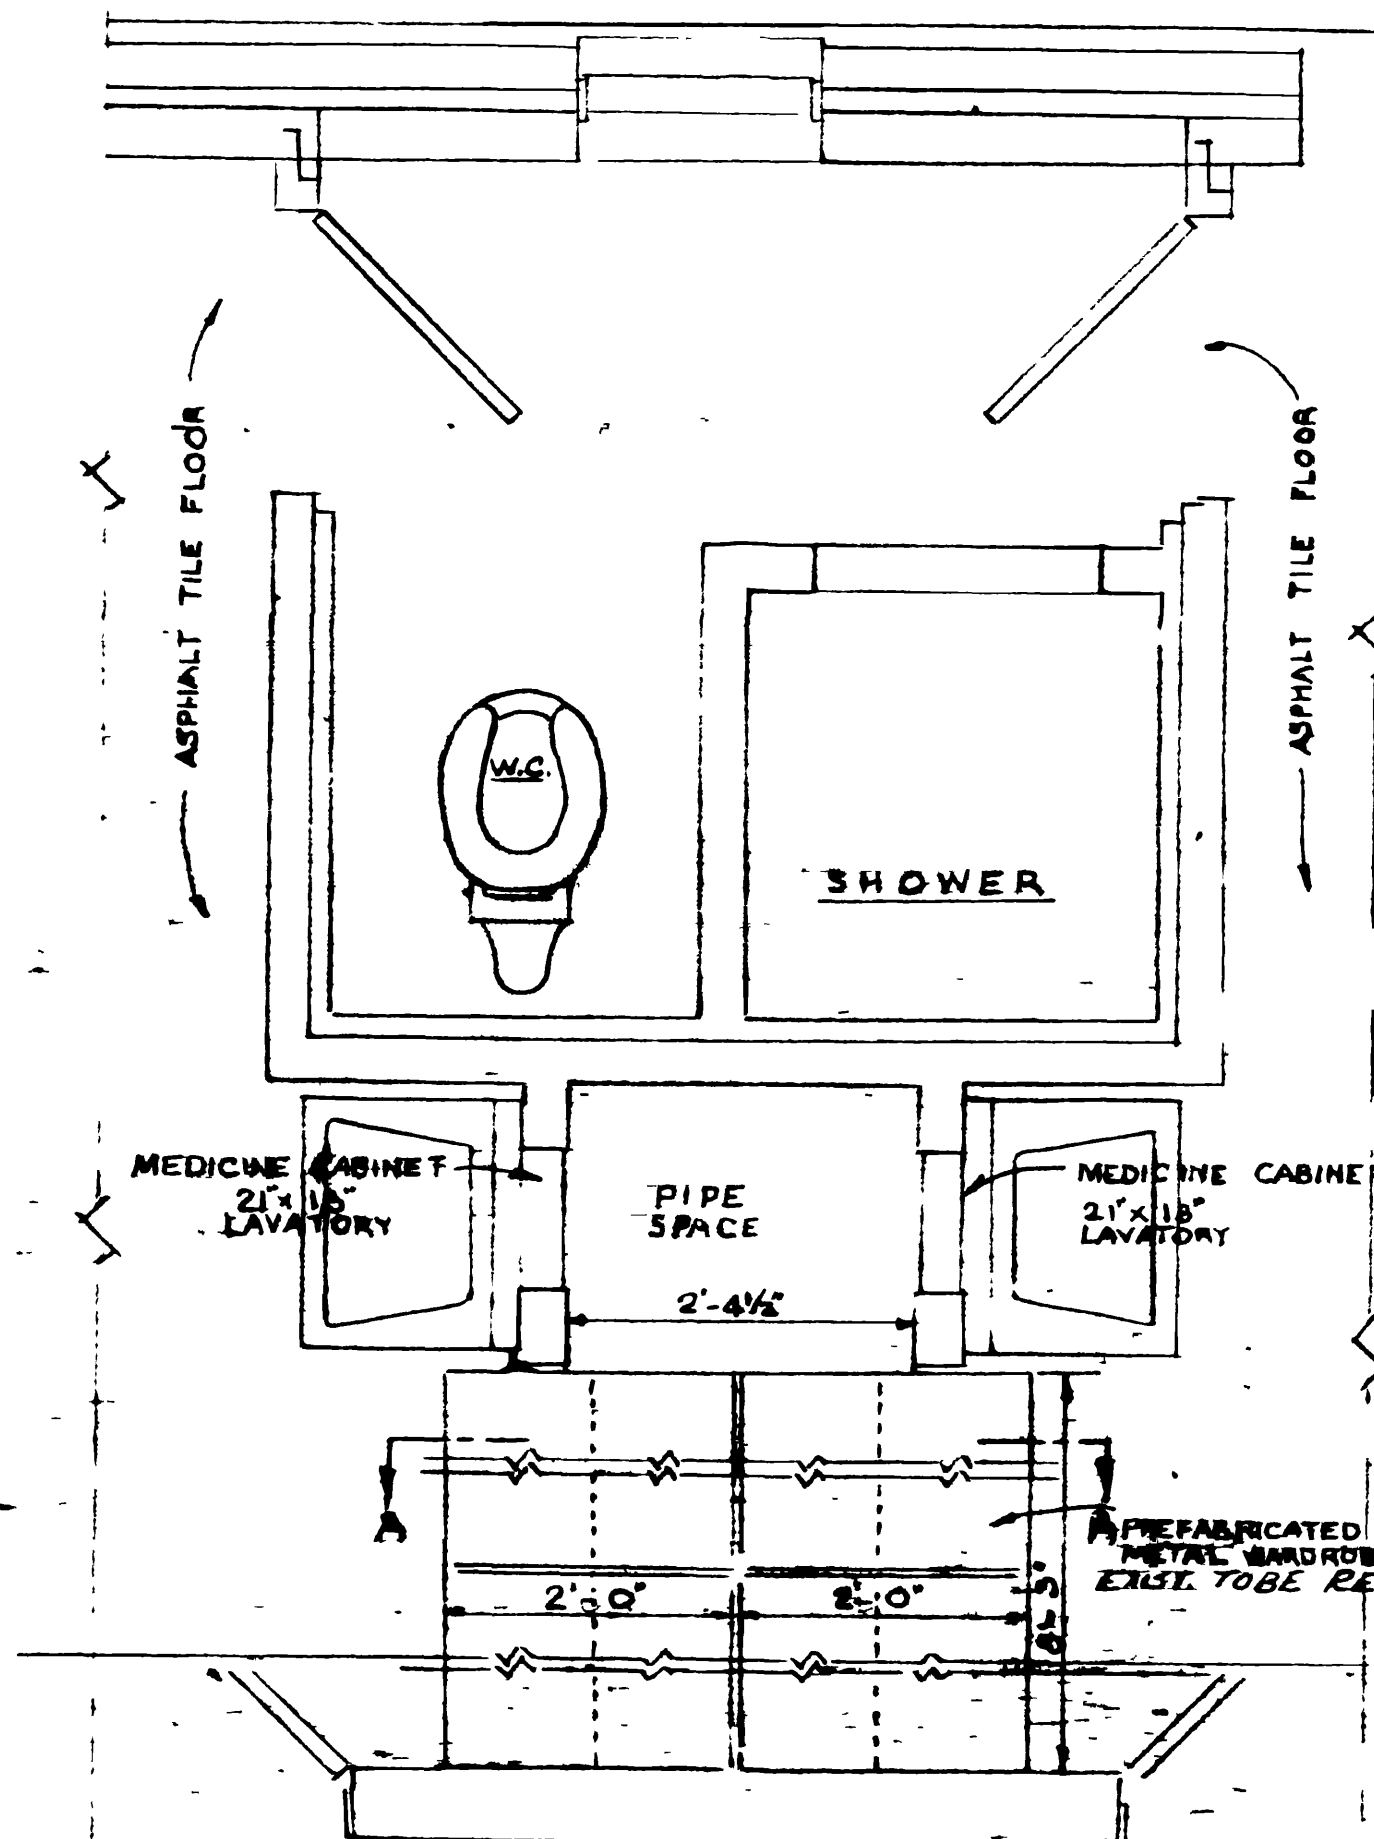

NOTES:  
 1. TOWEL RACKS TO BE REMOVED  
 2. SHEET METAL DIKT IN 2 ROOMS OF BLDG. 842, 1ST FLOOR TO COVER EXISTING PIPES WHICH PASS THROUGH THE WALL.

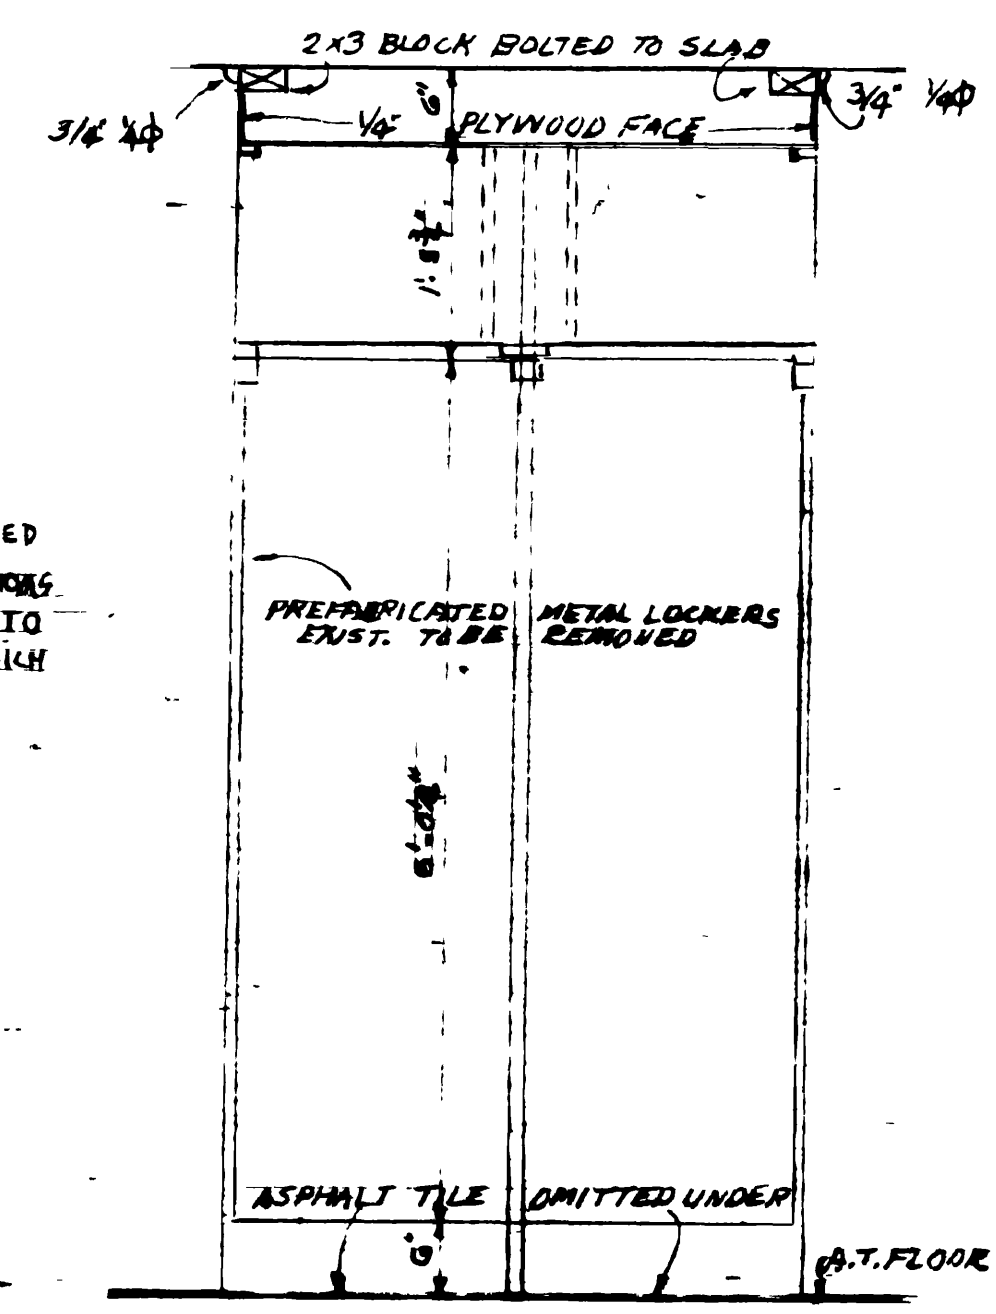


SECTION A-A SCALE 3/4" = 1'-0"

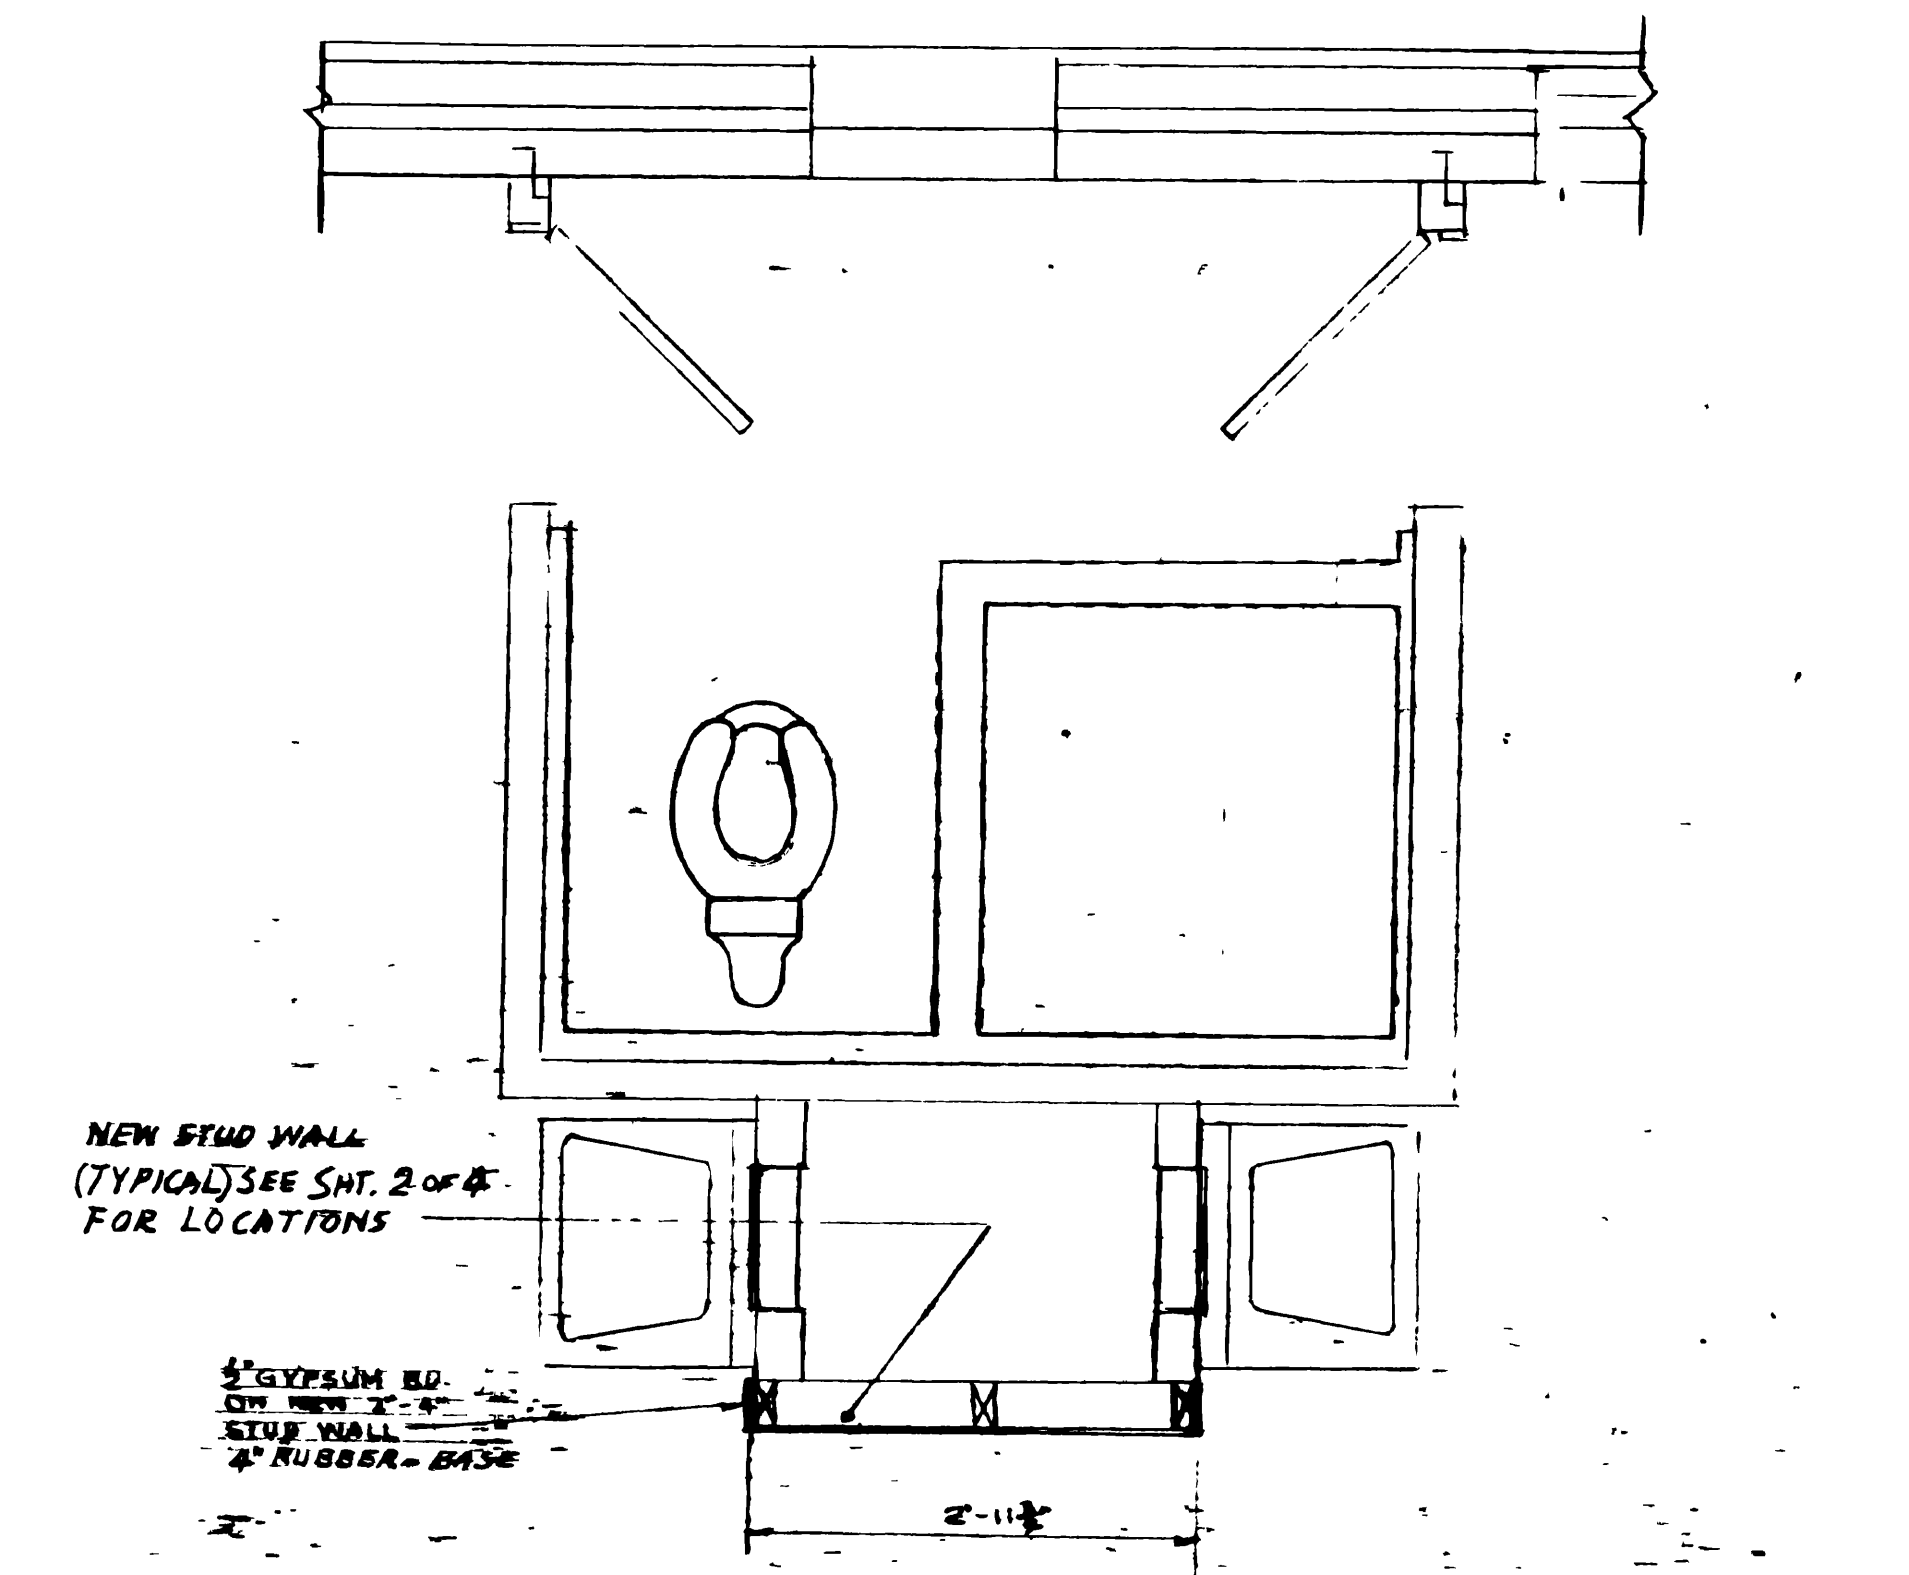


TYPICAL NEW STUD WALL SCALE 3/4" = 1'-0"


FLOOR PLAN SCALE 3/4" = 1'-0"  
 TYPICAL BATHROOM WARDROBE LAY-OUT - EXISTING

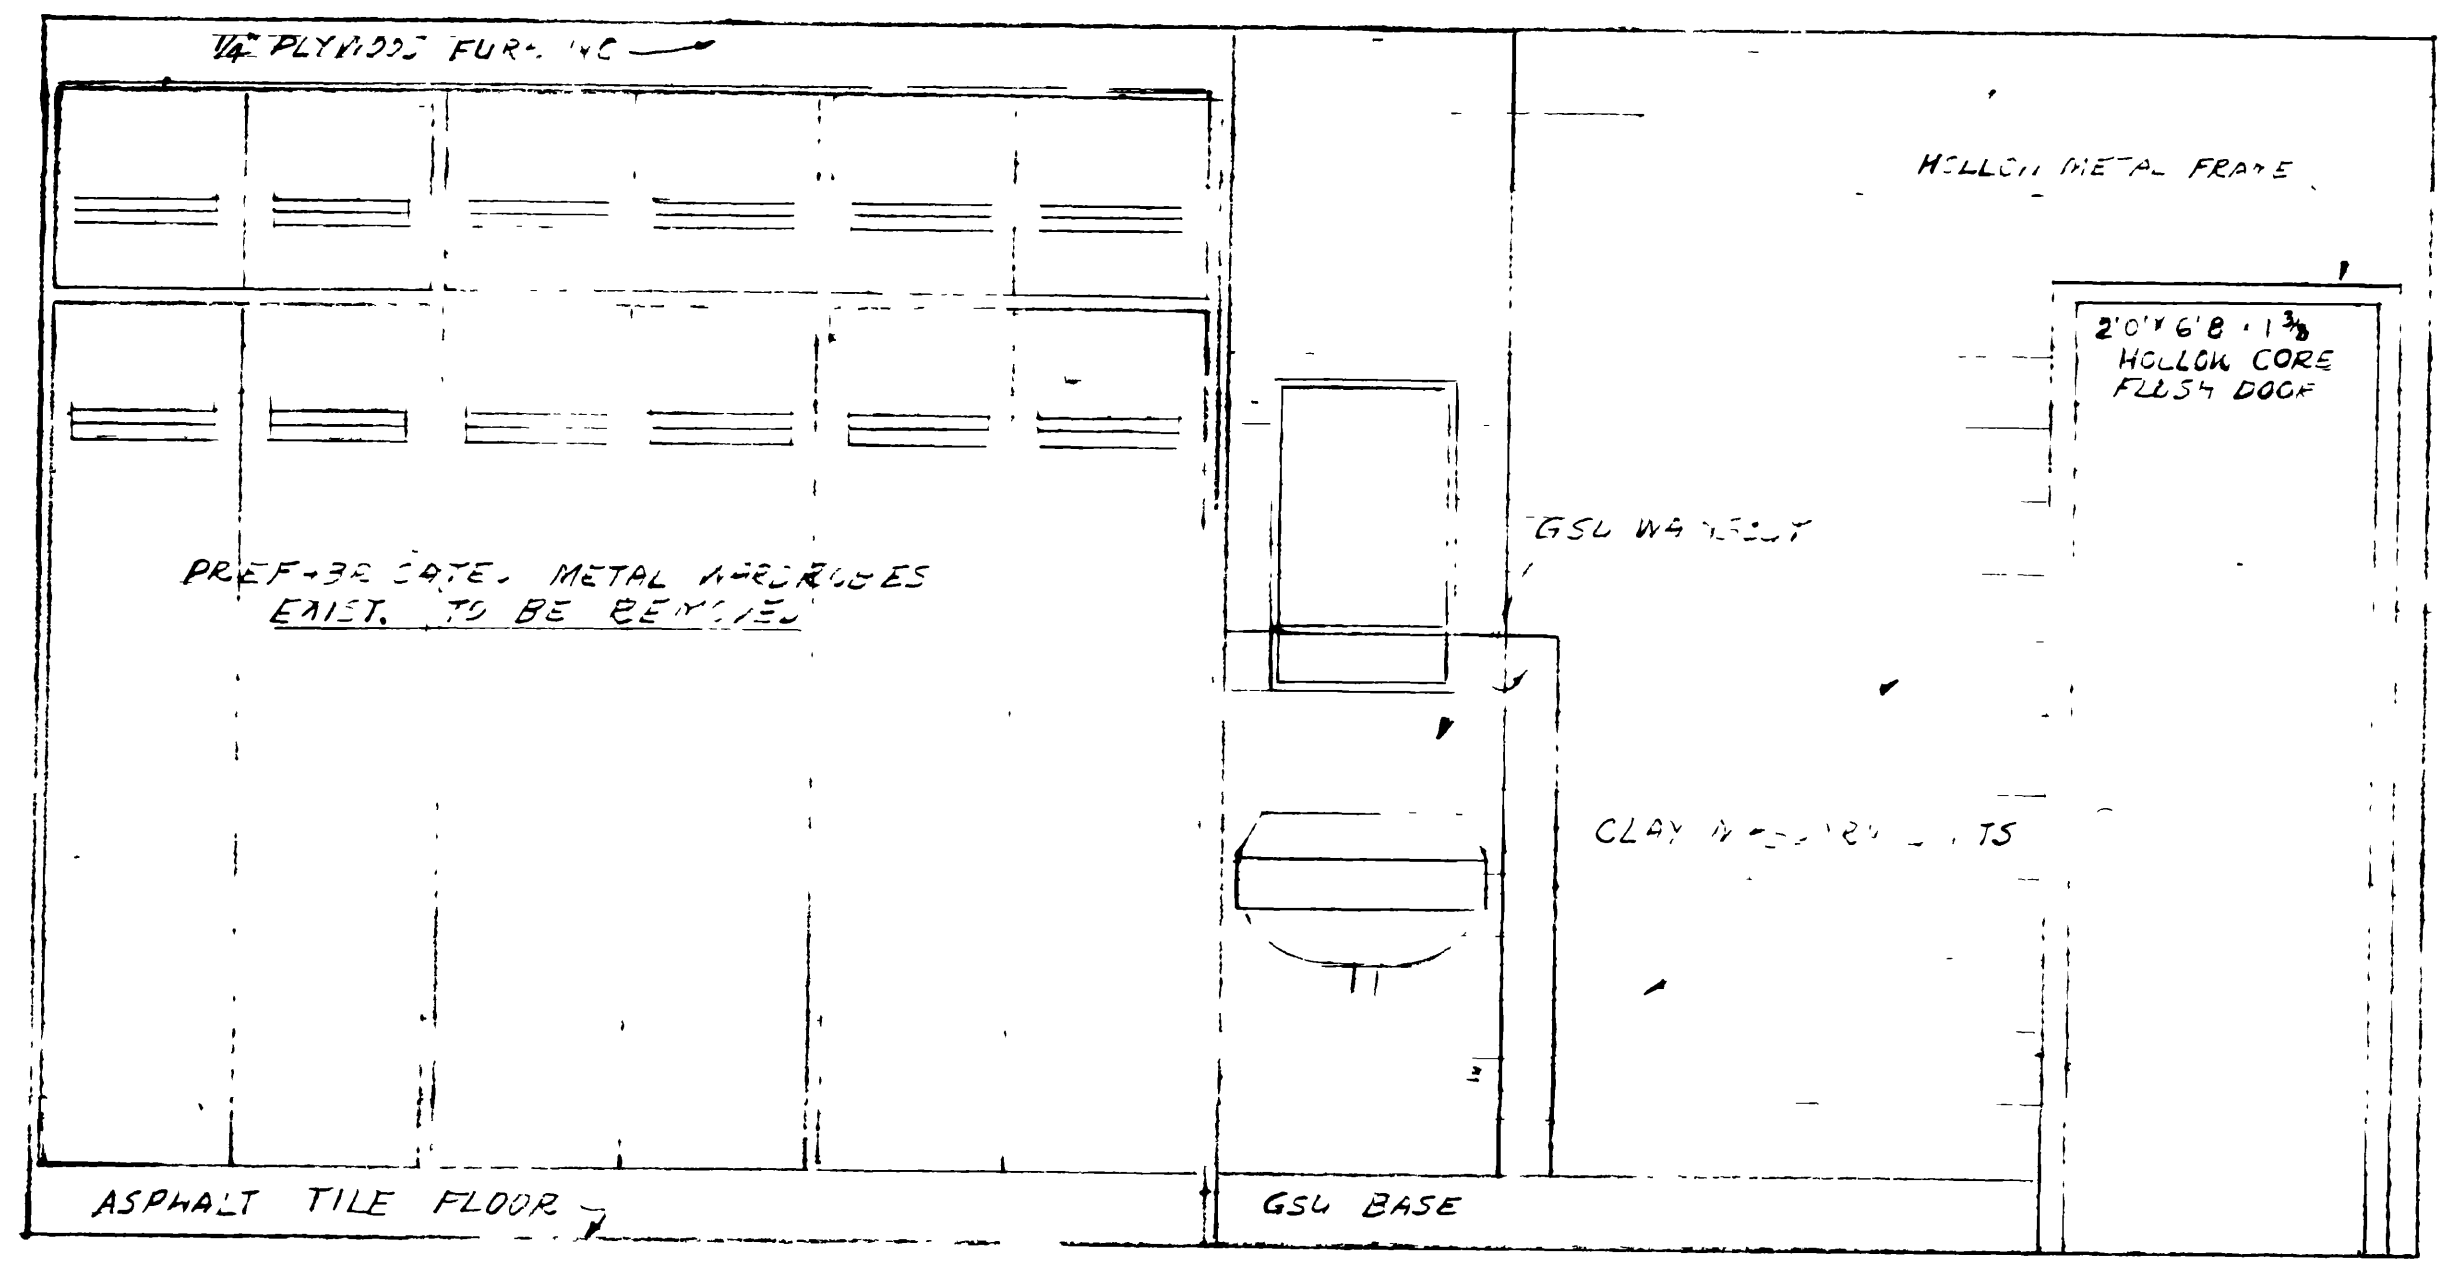


1 ELEVATION SCALE 3/4" = 1'-0"  
 TYPICAL WARDROBE WALL EXIST.

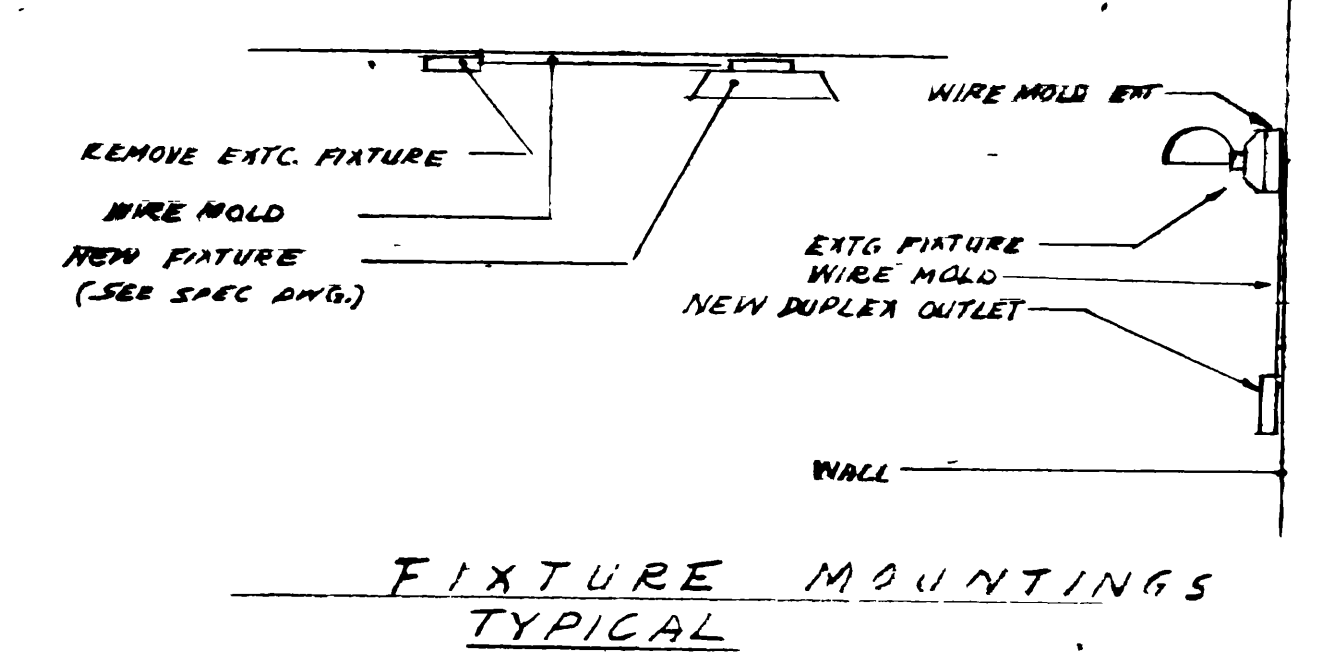

FIXTURE MOUNTINGS TYPICAL

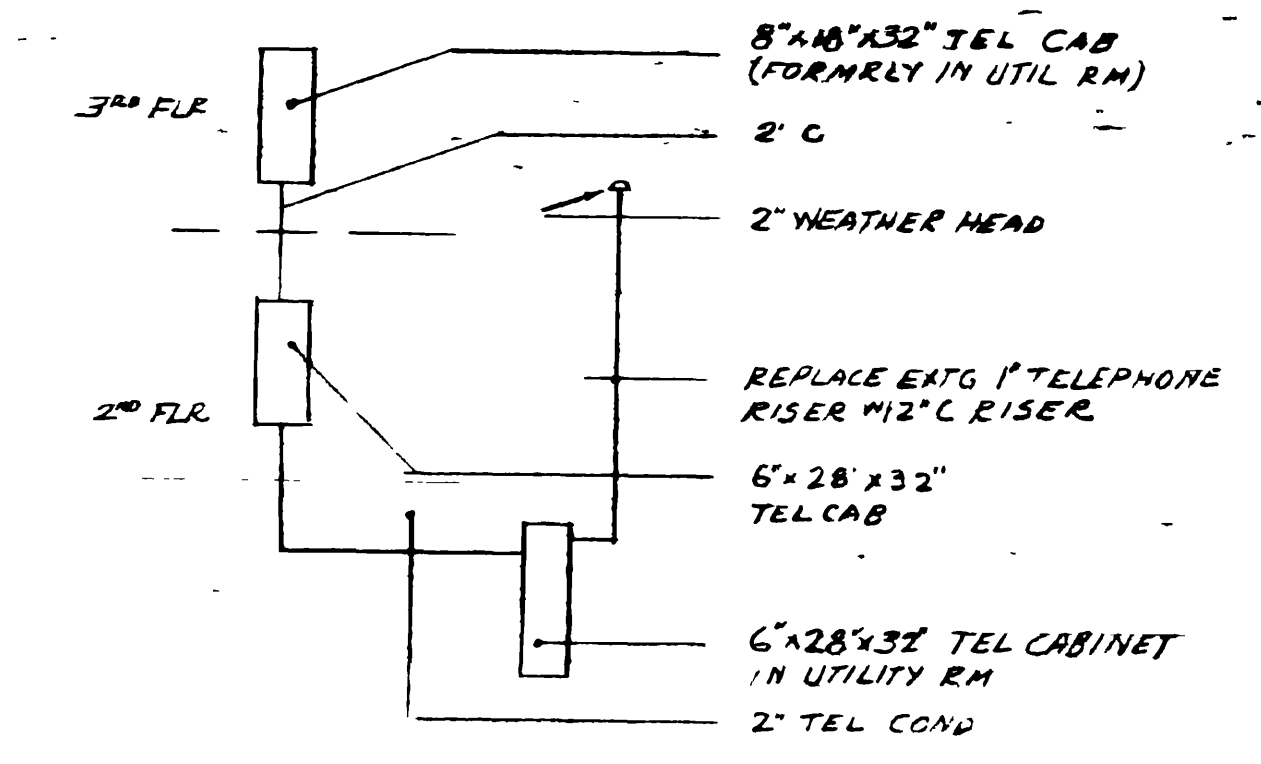

TELEPHONE RISER

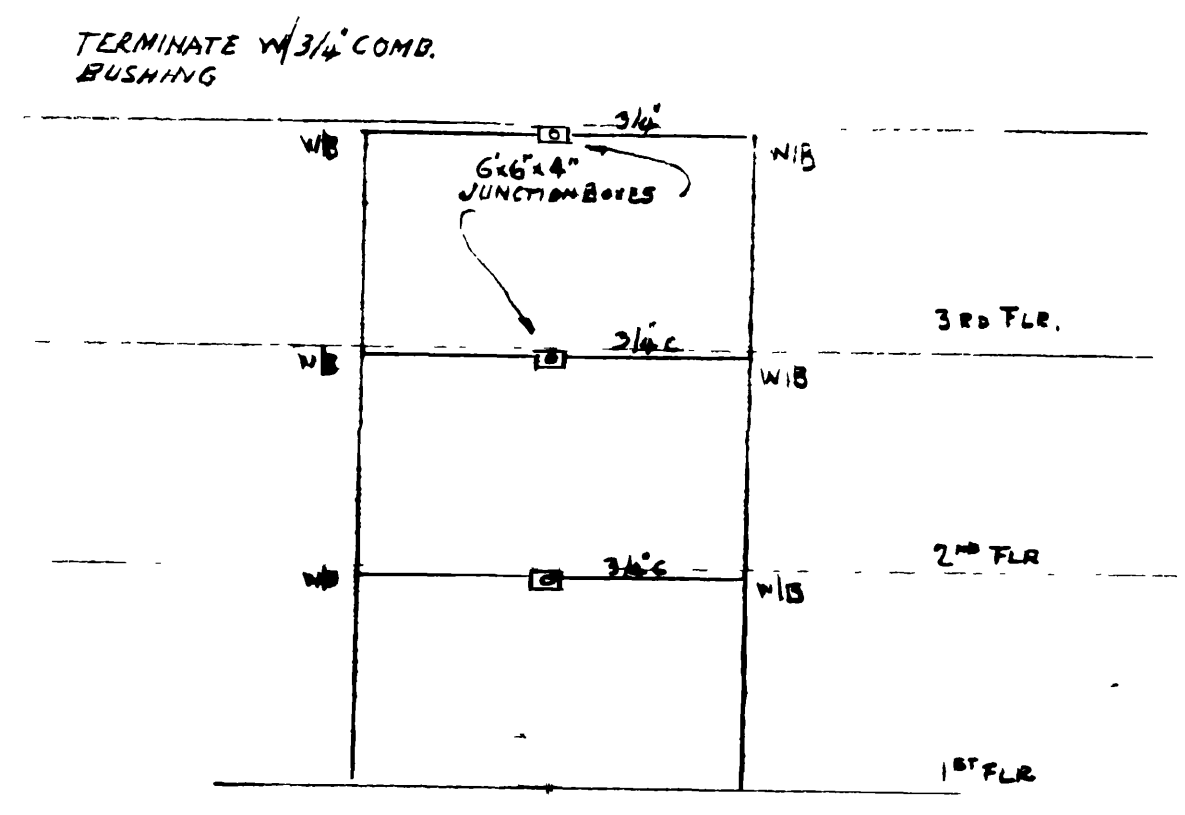

TELEPHONE DETAIL TYPICAL

STRATEGIC AIR COMMAND  
 JACKSONVILLE ARKANSAS  
 LITTLE ROCK AIR FORCE BASE  
 MOD BLDG 842  
 MISSILE ADMIN OFFICE  
 MISC. DETAILS

RECORD DRAWING AS CONSTRUCTED  
 CHIEF ENGINEER  
 PROJECT NO.  
 DATE




APPROVED  
 SAFETY OFF.

APPROVED  
 FIRE CHIEF

APPROVED  
 USING AGENCY


SCALE: AS SHOWN  
 PROJECT NO. LRM 10-1  
 DRAWN  
 SUBMITTED  
 DESIGNED  
 CHECKED  
 APPROVED  
 DATE  
 COMMANDER

RECOMMENDED  
 D/CIVIL ENG  
 DRAWING NO.  
 LRM-AC-832  
 SHT. # OF 4 SHTS

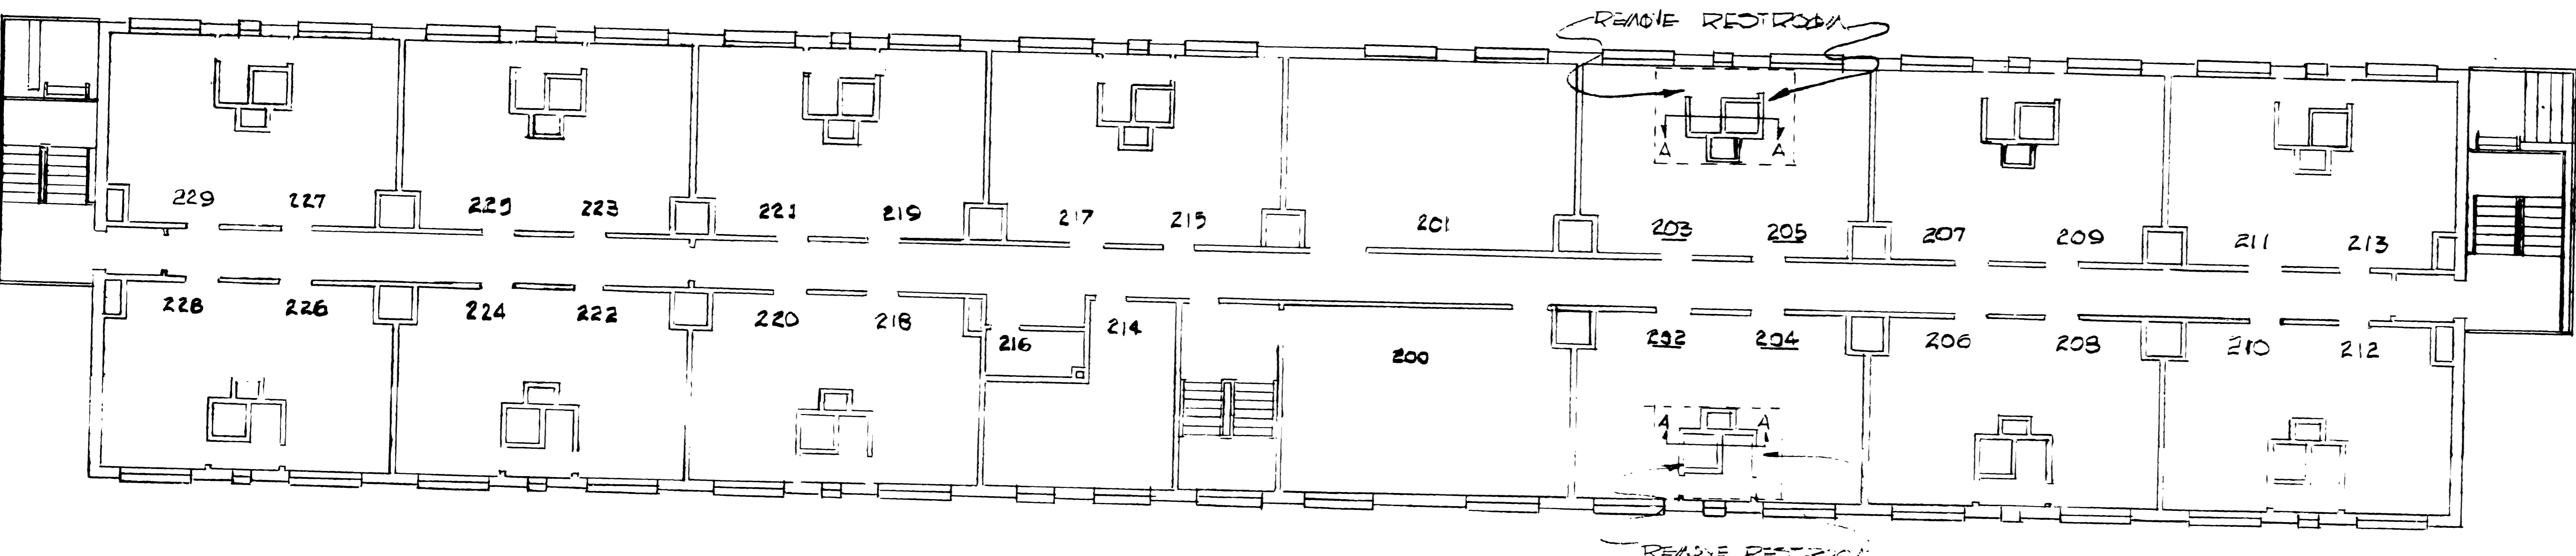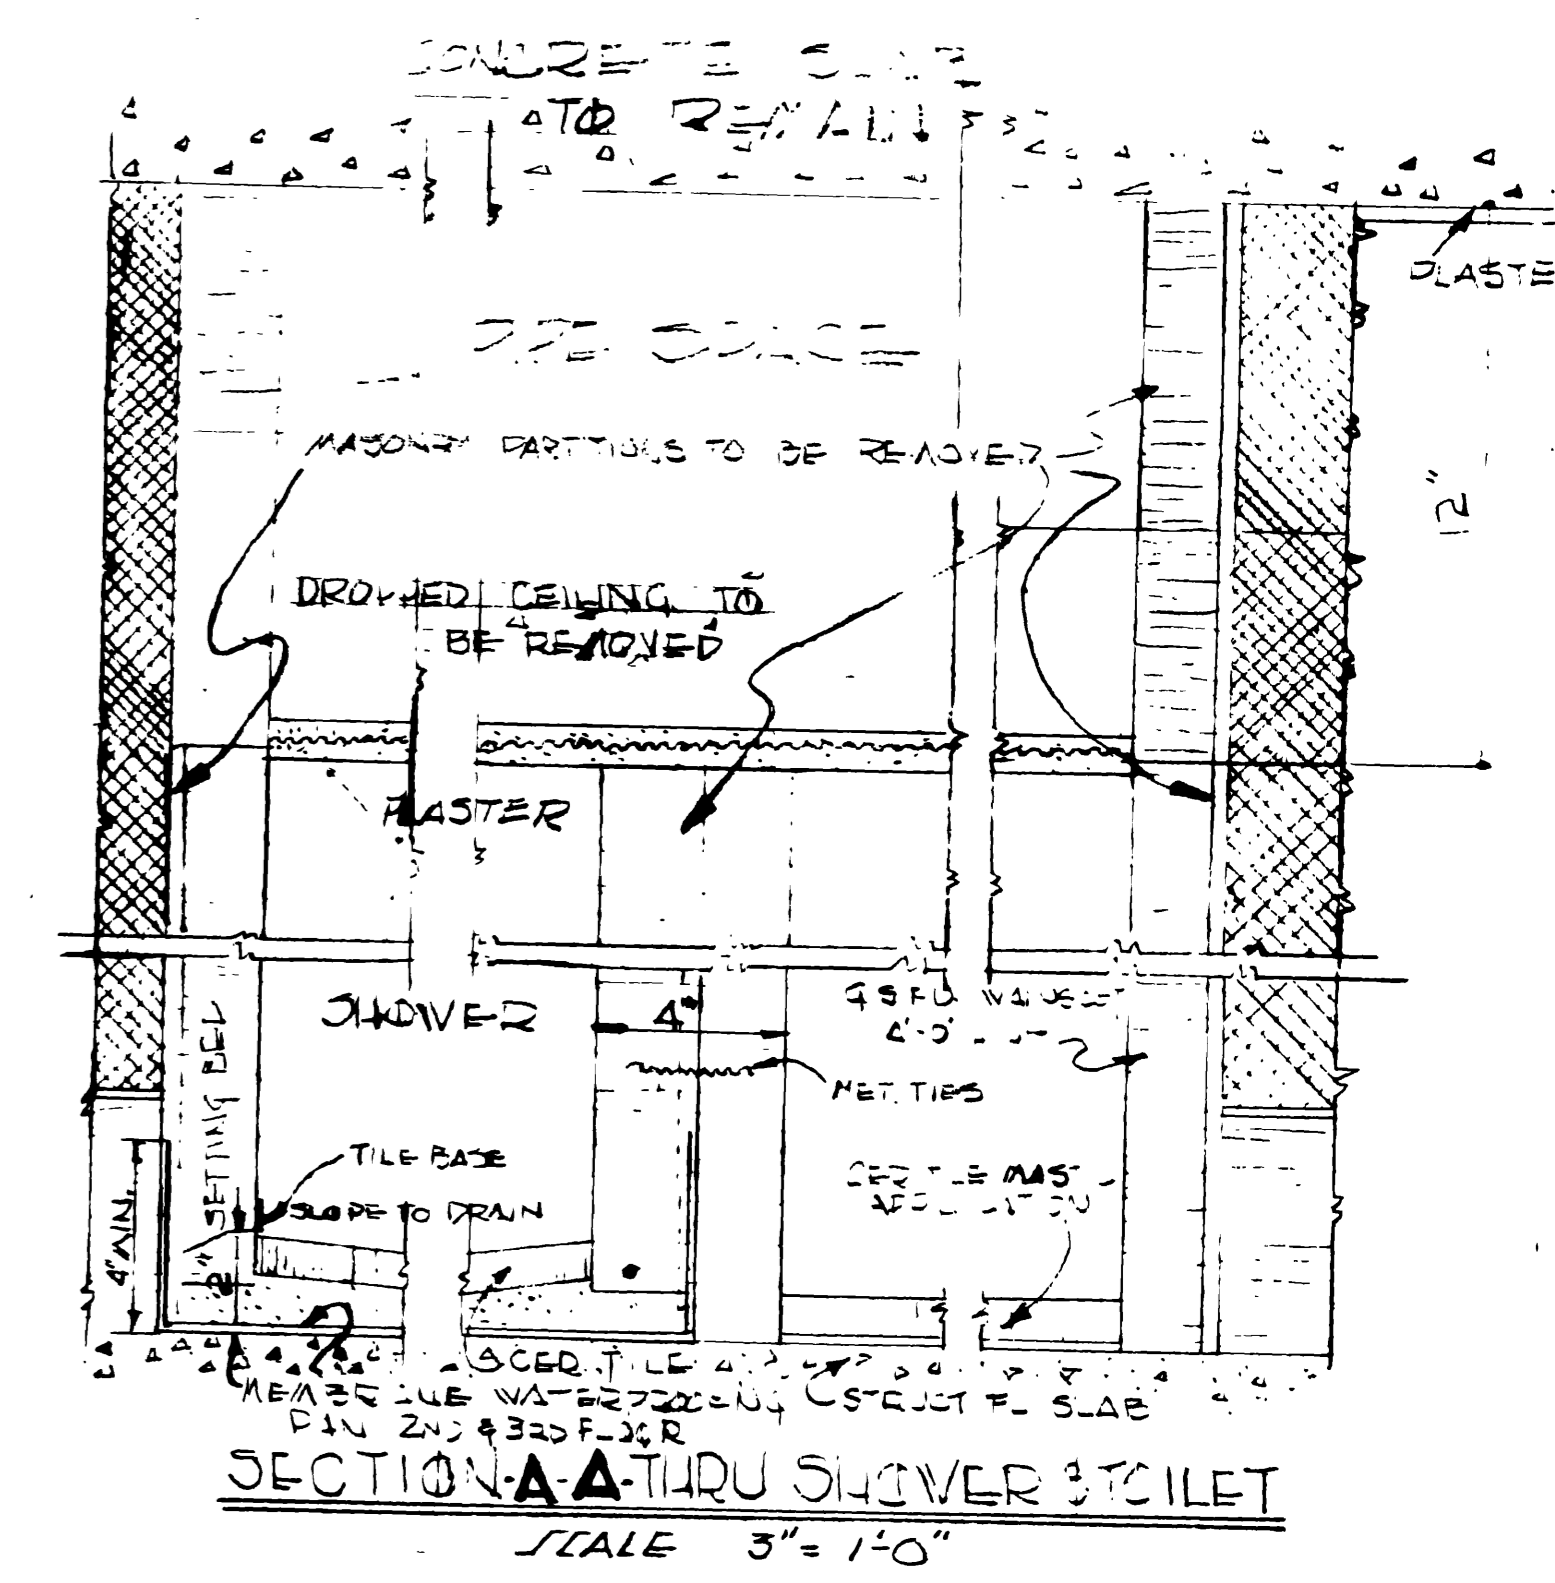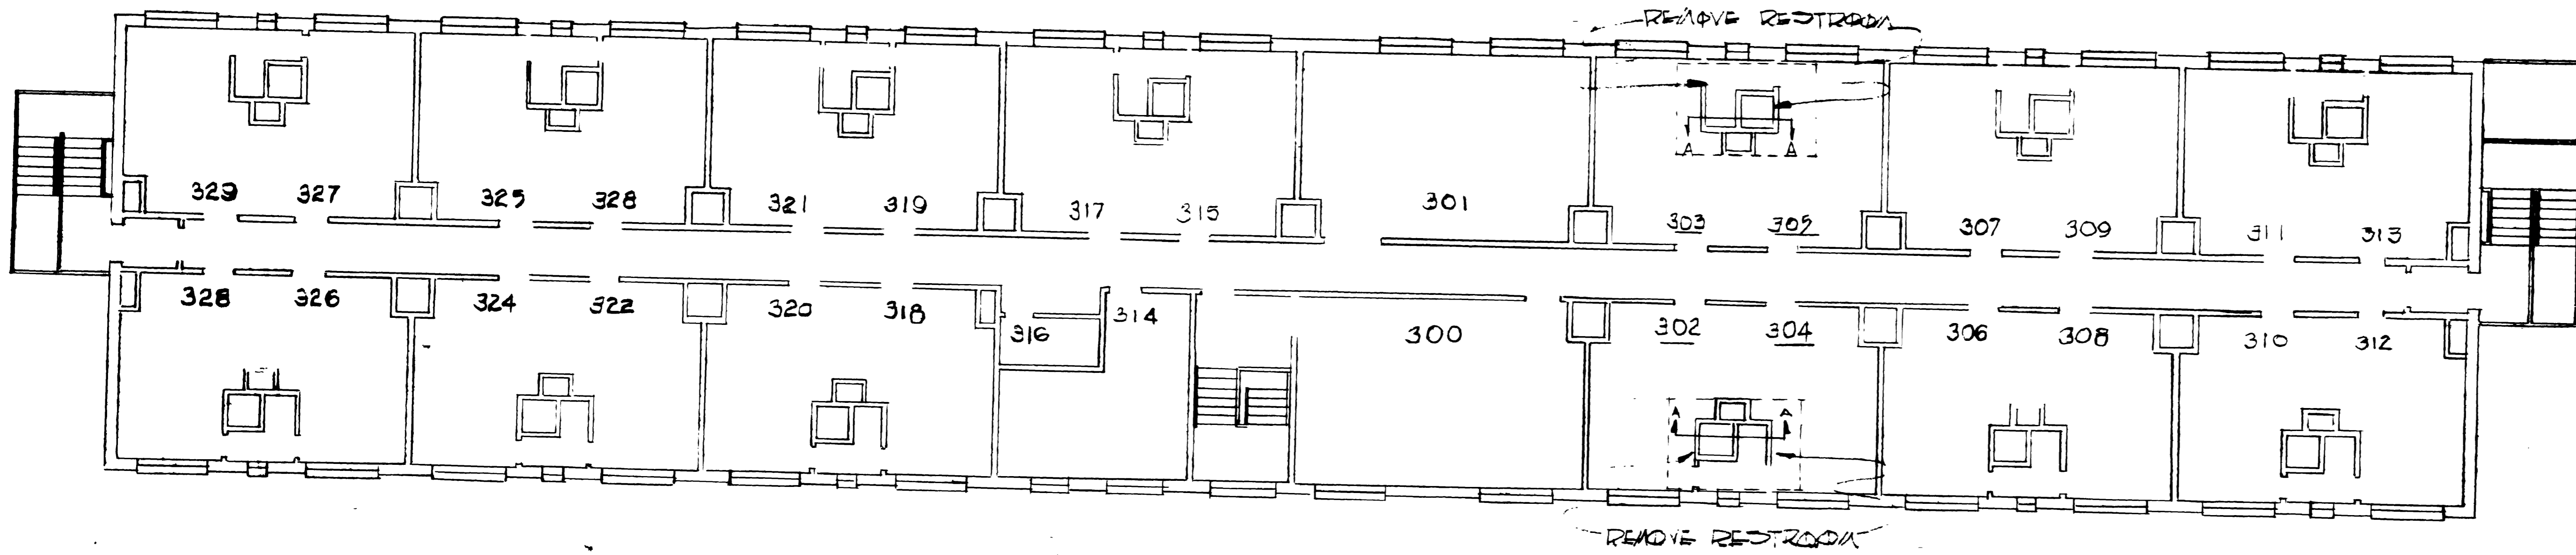

**ROOM SCHEDULE**

ROOM NO.	FLOOR	CEILING	WALLS	REMARKS
103-105	DATCH	NEW ACST	DATCH	RE-OPEN EXIST
104-106				
102				NEW DOOR TO 104
115	NEW AT			
200				
202-204	DATCH		DATCH	REMOVE RESTROOM
205-206				
216	NEW AT			
300				
301				
302-304	DATCH		DATCH	REMOVE RESTROOM
303-305				
306	NEW AT			

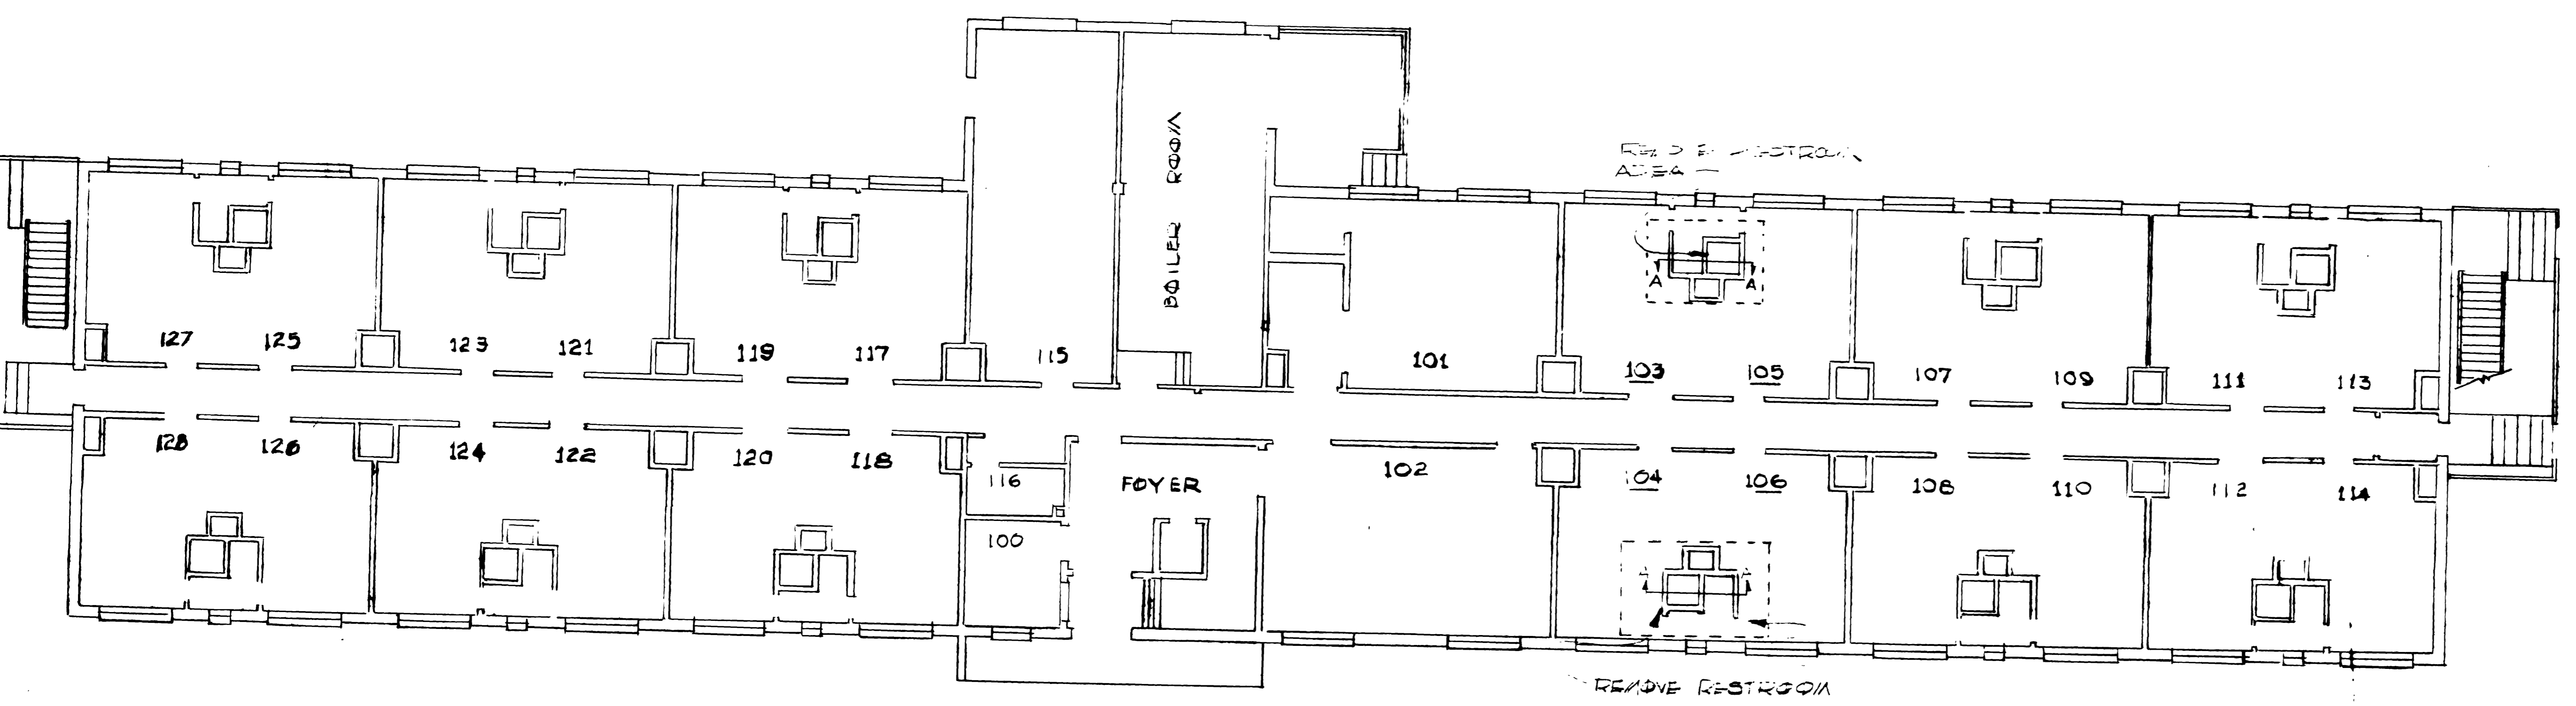

200-204  
FLOOR PLANS

105  
BLDG 202

APPROVED: SAFETY OFFICER  
APPROVED: FIRE CHIEF

042-19