


1 SECURITY AND COMMUNICATIONS PLAN
 E104 E104 SCALE: 1:100

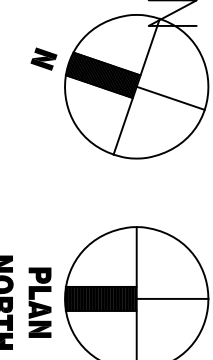

NOTE:
 ALL DIMENSIONS AND/OR DIMENSIONS SHOWN IN CALLOUTS/NOTES
 ARE IN MILLIMETERS (mm) UNLESS OTHERWISE NOTED.

SCALE IN MILLIMETERS
 0 1000 5000 10000
 1:100

- KEYNOTES:**
- 1 REFER TO ENLARGED POWER PLAN ON SHEET E-101 FOR ADDITIONAL TELECOM EQUIPMENT REQUIREMENTS.
 - 2 CABLE TRAY 300mm W X 100mm H. SEE SPECIFICATIONS FOR ADDITIONAL INFORMATION.
 - 3 MOUNT CARD READER AT 1220mm A.F.F. PROVIDE DOOR RELEASE HARDWARE FROM SECURE SIDE OF SPACE. REFER TO ARCHITECTURAL HARDWARE SCHEDULE FOR EQUIPMENT SPECIFICATIONS. ELECTRIC HINGE AND DOOR RELEASE WIRING TO BE PER MANUFACTURER'S INSTRUCTIONS. CONNECTION TO ADVANTOR EQUIPMENT TO BE COORDINATED WITH ADVANTOR.
 - 4 TENTATIVE LOCATION FOR MAIN PANEL.
 - 5 OUTLETS NOTED SHALL BE INSTALLED 50mm ABOVE COUNTER TO MATCH RECEPTACLE MOUNTING HEIGHT.
 - 6 REFER TO SHEET E-106 FOR LOCATION OF TELEPHONE EQUIPMENT ROOM. ALL SERVICE SHALL ORIGINATE FROM THIS LOCATION.
- GENERAL INFORMATION:**
- CONTRACTOR TO COORDINATE SECURITY EQUIPMENT WITH ADVANTOR SYSTEMS CORPORATION (1-800-238-2686). NO EQUALS. EQUIPMENT REQUIRED CONSISTS OF BASE MODULE CONTROL PANEL (AMR PLUS BAS-C); ACCESS MODULE (ACCESS 4-A) AND CARD READER (HID TYPE).

Sheet Reference Number:
 E-104
 Sheet 80 of 91

ADAL C-130J AIRCREW FUSELAGE TRAINER
 LRAFB, LITTLE ROCK AR.
 Project No. NKAK 043005

SECURITY AND COMMUNICATIONS PLAN

DESIGNED BY: RH DRAWN BY: MB CONTRACT DATE: 02/04/03	
REVIEWED BY: PWD DRWG. CODE: 151001E-104 FILE NAME: 151001E-104	
SUBMITTED BY: Atkins Benham, Inc. INVITATION NO.: DAC03-03-R-0021 CONTRACT NO.: DAC03-03-B-	
PLOT DATE: 02/04/03 PLOT SCALE: 1:1	

(918) 492-1600 www.atkinsbenham.com
 a member of the WS Atkins group of companies

Mark	Description	Date	Appr.	Mark	Description	Date	Appr.

