



ELEVATION A  
 MEN'S TOILET WEST ELEV.  
 WOMEN'S TOILET EAST ELEV. (OPPOSITE)

**TILE LEGEND:**


- AMERICAN OLEAN Y64 GLOSS BLACK
- AMERICAN OLEAN 0059 TAUPE MIST (FIELD)

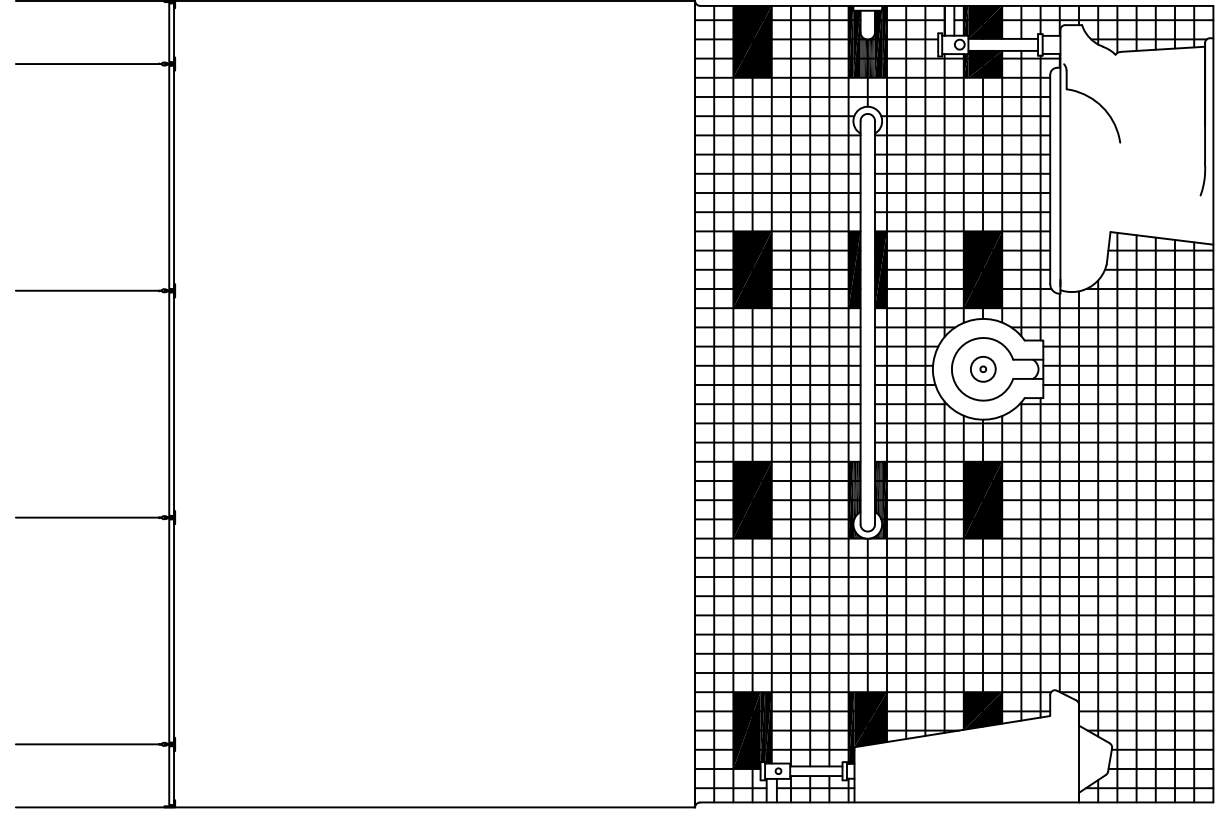

ELEVATION B  
 MEN'S TOILET SOUTH ELEV.

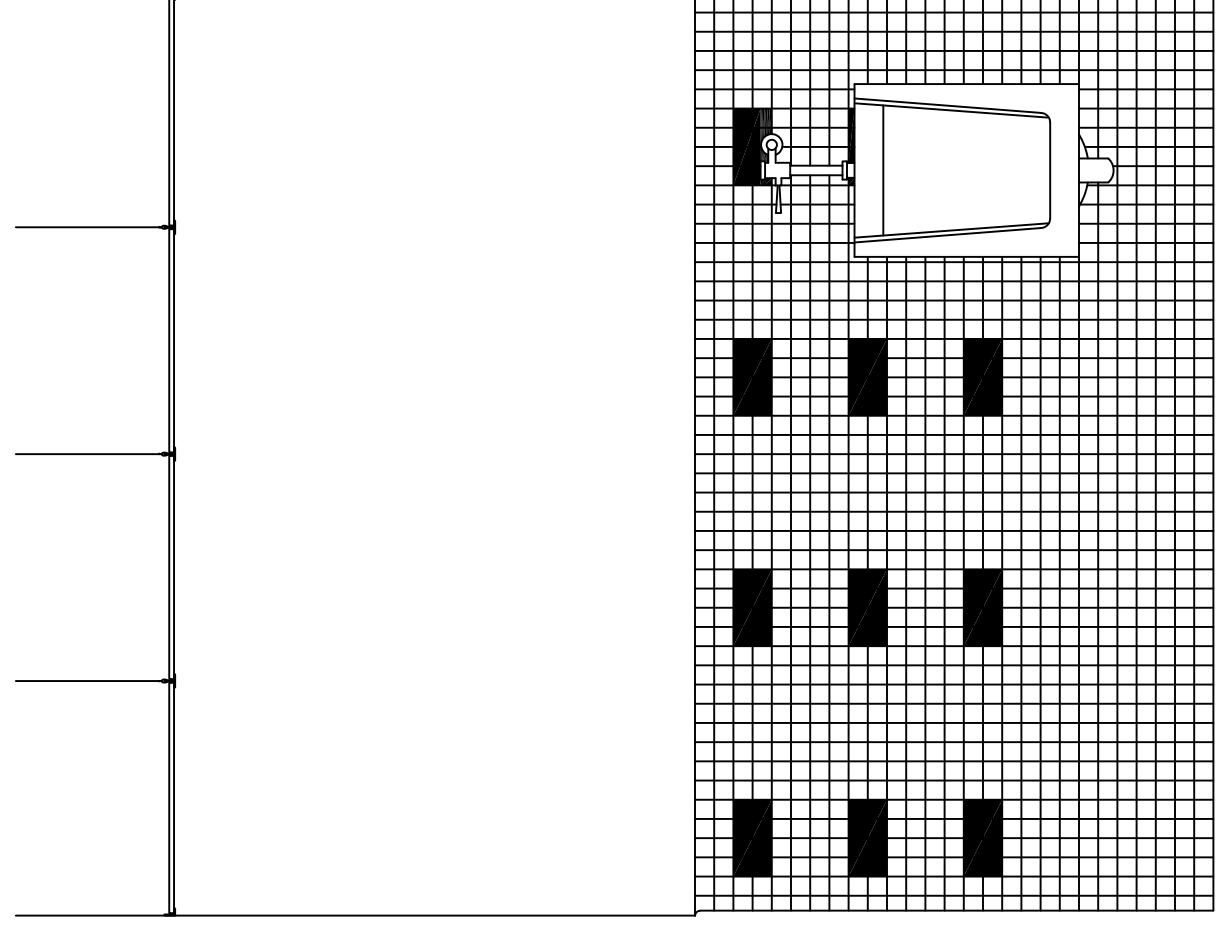

ELEVATION C  
 MEN'S TOILET EAST ELEV.

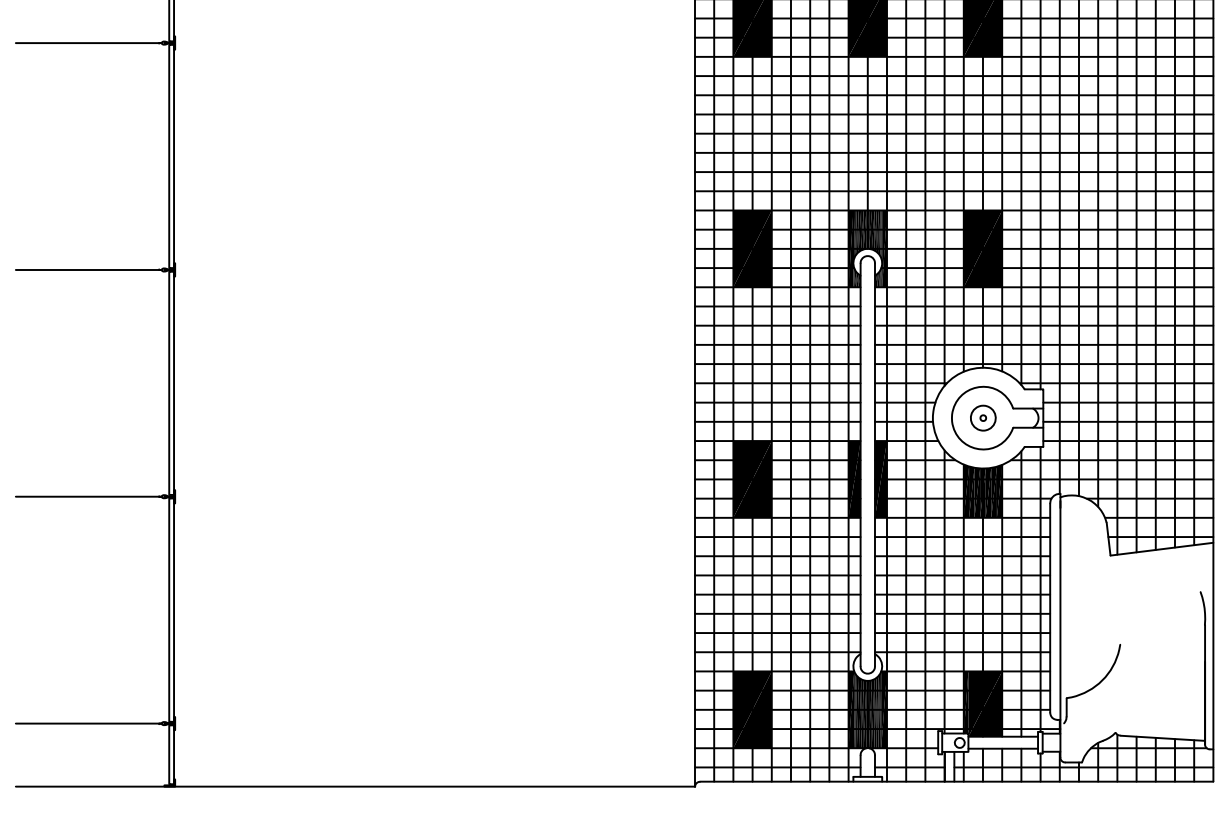

ELEVATION D  
 WOMEN'S TOILET SOUTH ELEV.

**1 MEN'S AND WOMEN'S TOILET**  
 A-401 | I-401 SCALE: 1:20

NOTE:  
 ALL DIMENSIONS AND/OR DIMENSIONS SHOWN  
 IN CALLOUTS/NOTES ARE IN MILLIMETERS  
 (mm) UNLESS OTHERWISE NOTED.

GRAPHIC SCALE:  
  
 SCALE: 1:20

Sheet Reference Number:  
**I-401**  
 Sheet 40 of 91

ADAL C-130U AIRCREW FUSELAGE TRAINER  
 LRAFB, LITTLE ROCK AR.  
 Project No. NNAK 043005  
 INTERIOR ELEVATIONS

DEPARTMENT OF THE ARMY U.S. ARMY CORPS OF ENGINEERS LITTLE ROCK DISTRICT Little Rock, ARKANSAS		(918) 482-1600 www.delt.demil.com a member of the Atkins group of companies	
Designed by:	SLB	Submitted by:	Atkins Benham, Inc.
Drawn by:	ART	Reviewed by:	DM
Dwg. Code:		File Name:	151001-401
Contract Date:		Contract No.:	DMA01-03-9-
		Part No.:	1-1
		Part Date:	02/04/03

Rev	Description	Date	Appr.	Mark



1 2 3 4 5