


LITTLE ROCK A.F.B.
ARKANSAS

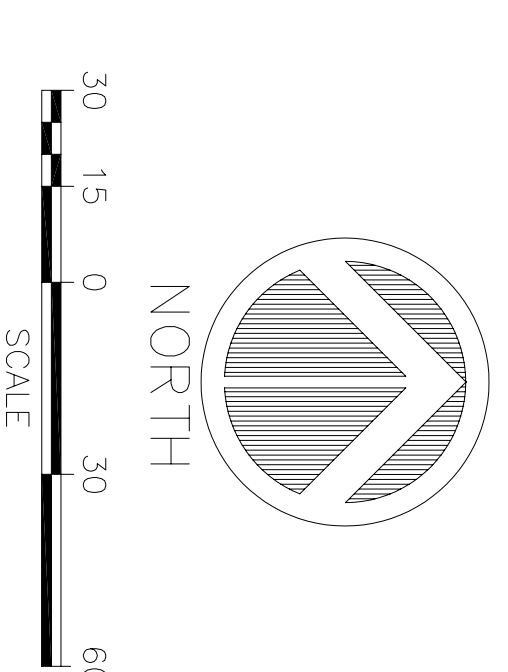

No.	Revision/Issue	Date	BY	APP'D
1	Note to find Gazebo Slab Detail	2-05		

PROJECT TITLE
TEMPORARY LODGING FACILITY (TLF)
LITTLE ROCK AIR FORCE BASE

SHEET TITLE	
DIMENSIONING PLAN AS-BUILT	

DESIGNED BY	FILE LOCATION	LEAD DESIGNER
CHKD	G:\DD-EXHIBITION\01\335\ELING	HRV
DATE	PROJECT NUMBER	TECH REVIEWER
28 MAY 2002	MAK02-0001	HRV
SCALE	SHEET	
1"=30'	2 OF 108	

- GENERAL NOTES**
- THE LOCATION OF THE EXISTING WATER AND GAS UTILITIES ARE BASED ON LOCATED DATA. THE CONTRACTORS SHALL BE RESPONSIBLE FOR DETERMINING THE EXACT LOCATION OF THESE UTILITIES BEFORE CONSTRUCTION.
 - CONTRACTOR TO MONITOR AND MARK UTILITIES BEFORE CONSTRUCTION.
 - CONTRACTOR SHALL PROTECT UTILITIES IN AREA OF RESPONSIBILITY AND COST OF REPAIR OR REPLACEMENT OF EXISTING & RELOCATED UTILITIES DAMAGED OR INTERFERED AS A RESULT OF THIS CONSTRUCTION PROJECT. DAMAGED OR INTERFERED UTILITIES SHALL BE RELOCATED AT THE CONTRACTOR'S EXPENSE AND AT THE CONTRACTOR'S RISK.
 - ALL SEWER LINES AND APPURTENANCES SHALL BE INSTALLED IN ACCORDANCE TO THE LITTLE ROCK AND FORCE BASE STANDARDS.
 - TO THE UTILITY CONTRACTOR'S STANDARDS.
 - CONTRACTOR SHALL NOTIFY PROJECT ENGINEER PRIOR TO BEGINNING WORK.
 - ALL AREAS WITHIN THE PAVING LOT ARE TO RECEIVE A GRAVEL BASE TO MAINTAIN A BUILT UP ON THE AREAS BEING PAVED. THE GRAVEL SHALL BE MAINTAINED AT ALL TIMES THROUGHOUT THE CONSTRUCTION PERIOD.
 - CONTRACTOR SHALL MAINTAIN THE PAVING LOT ARE TO RECEIVE LOOSE STRAW TO PROTECT EXISTING CURBS, DRIVEWAYS AND GRAVEL AT ALL TIMES THROUGHOUT THE CONSTRUCTION PERIOD.
 - CONTRACTOR IS TO PROTECT EXISTING STORM DRAINAGE SYSTEM.
 - CONTRACTOR SHALL MAINTAIN THE PAVING LOT ARE TO RECEIVE LOOSE STRAW TO PROTECT EXISTING CURBS, DRIVEWAYS AND GRAVEL AT ALL TIMES THROUGHOUT THE CONSTRUCTION PERIOD.
 - CONTRACTOR SHALL MAINTAIN THE PAVING LOT ARE TO RECEIVE LOOSE STRAW TO PROTECT EXISTING CURBS, DRIVEWAYS AND GRAVEL AT ALL TIMES THROUGHOUT THE CONSTRUCTION PERIOD.
