



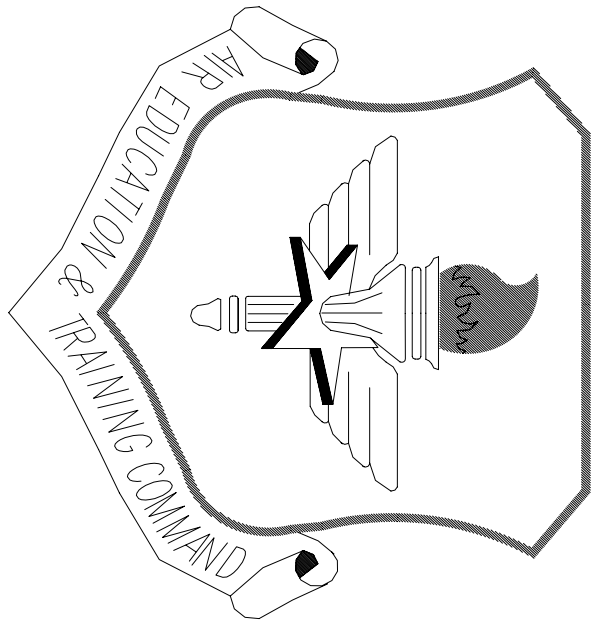

LITTLE ROCK A.F.B.
ARKANSAS

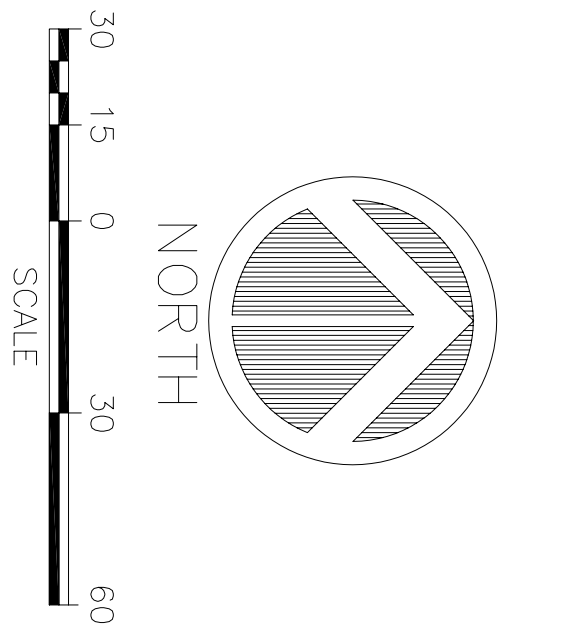

No.	Revision/Issue	Date	BY	APP'D
1	No Changes from Design to As-Built			

TEMPORARY LODGING FACILITY (TLF)
LITTLE ROCK AIR FORCE BASE

EROSION CONTROL PLAN
AS-BUILT

DRAWN BY	KRY	LEAD DESIGNER	KRY
TECH. REVIEWER	KRY	FILE LOCATION	6 VO-133 USCON(V)13317.DWG
DESIGNED BY	KRY	PROJECT NUMBER	WMAK02-5001
DATE	28 MAY 2002	SHEET	C3
SCALE	1"=30'		4 OF 108

