


LITTLE ROCK A.F.B.
ARKANSAS

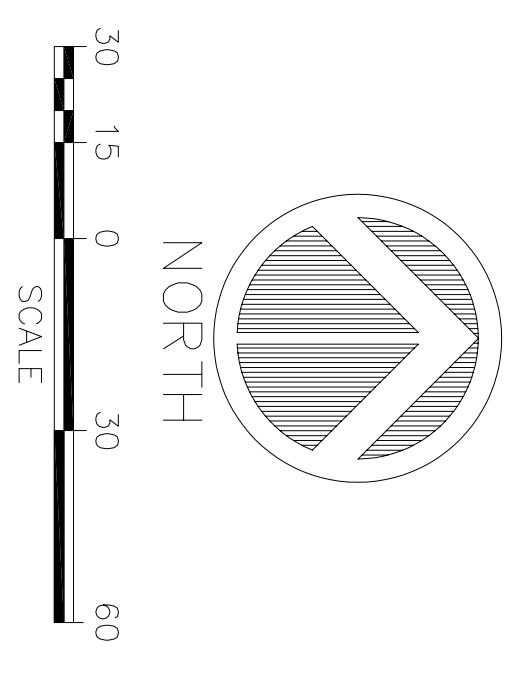


No.	Revision/Issue	Date	BY	APP'D
1	No Changes from Design to As-Built			

PROJECT TITLE
TEMPORARY LODGING FACILITY (TLF)
LITTLE ROCK AIR FORCE BASE

SHEET TITLE
UTILITY COORDINATION PLAN
AS-BUILT

DRAWN BY KEY	LEAD DESIGNER KEY
TECH. ENGINEER KEY	FILE LOCATION 6:\06-12\VERSION\001\387E\DWG
DESIGNED BY KEY	PROJECT NUMBER MKA02-5001
DATE 28 MAY 2002	SHEET C4
SCALE 1"=30'	5 of 108

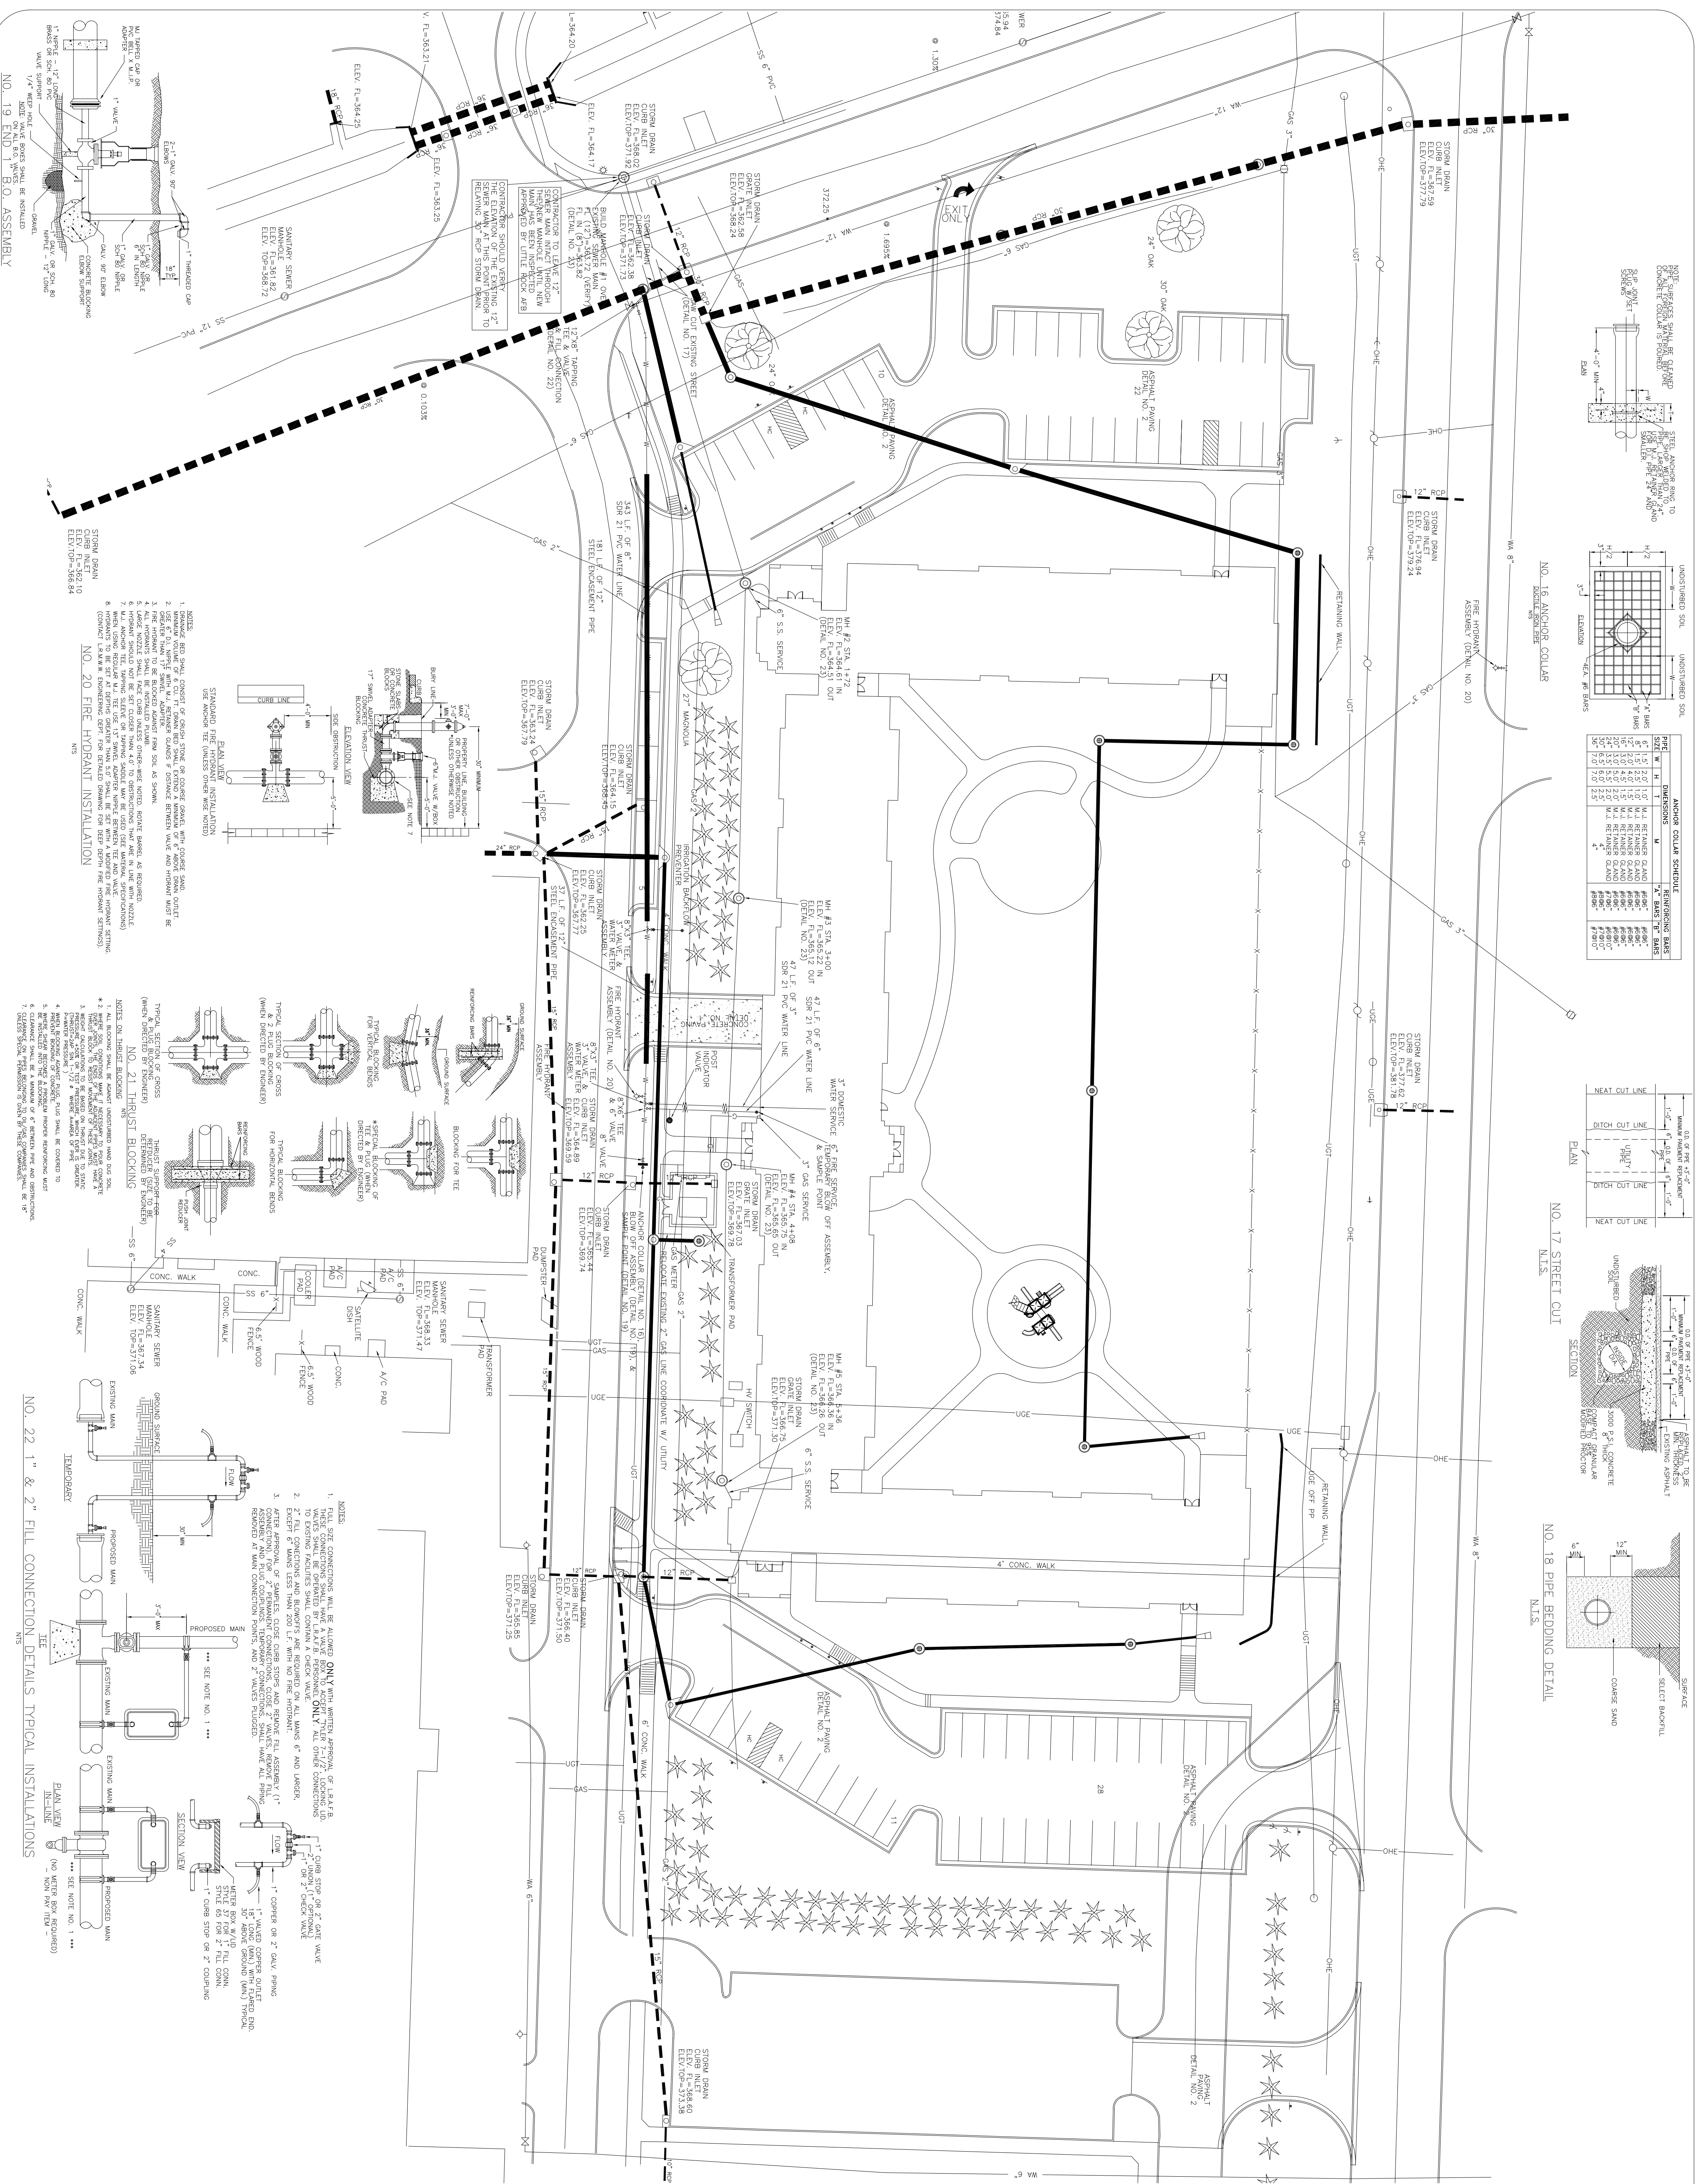

ANCHOR COLLAR SCHEDULE

PIPE	W	H	T	M	REINFORCING BARS	EXPOSURE BARS
6"	12.0	11.0	1.0	M 3	REINFORCING BARS	REINFORCING BARS
8"	15.0	14.0	1.0	M 4	REINFORCING BARS	REINFORCING BARS
10"	18.0	17.0	1.0	M 5	REINFORCING BARS	REINFORCING BARS
12"	21.0	20.0	1.0	M 6	REINFORCING BARS	REINFORCING BARS
15"	24.0	23.0	1.0	M 7	REINFORCING BARS	REINFORCING BARS
18"	27.0	26.0	1.0	M 8	REINFORCING BARS	REINFORCING BARS
21"	30.0	29.0	1.0	M 9	REINFORCING BARS	REINFORCING BARS
24"	33.0	32.0	1.0	M 10	REINFORCING BARS	REINFORCING BARS
30"	39.0	38.0	1.0	M 12	REINFORCING BARS	REINFORCING BARS
36"	45.0	44.0	1.0	M 14	REINFORCING BARS	REINFORCING BARS
42"	51.0	50.0	1.0	M 16	REINFORCING BARS	REINFORCING BARS
48"	57.0	56.0	1.0	M 18	REINFORCING BARS	REINFORCING BARS
54"	63.0	62.0	1.0	M 20	REINFORCING BARS	REINFORCING BARS
60"	69.0	68.0	1.0	M 22	REINFORCING BARS	REINFORCING BARS

