


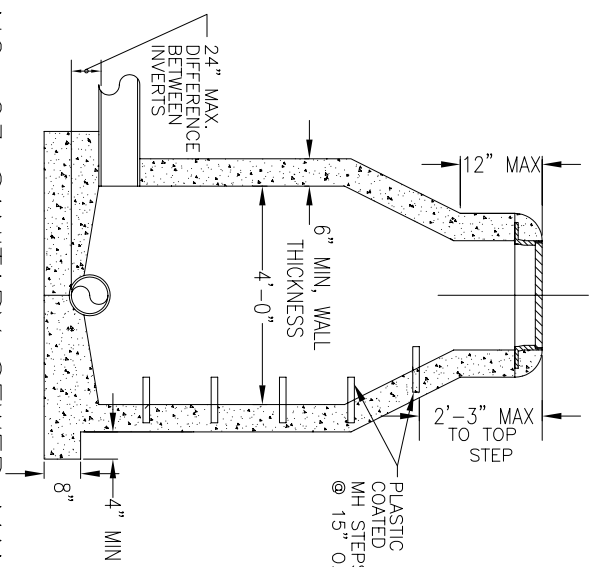
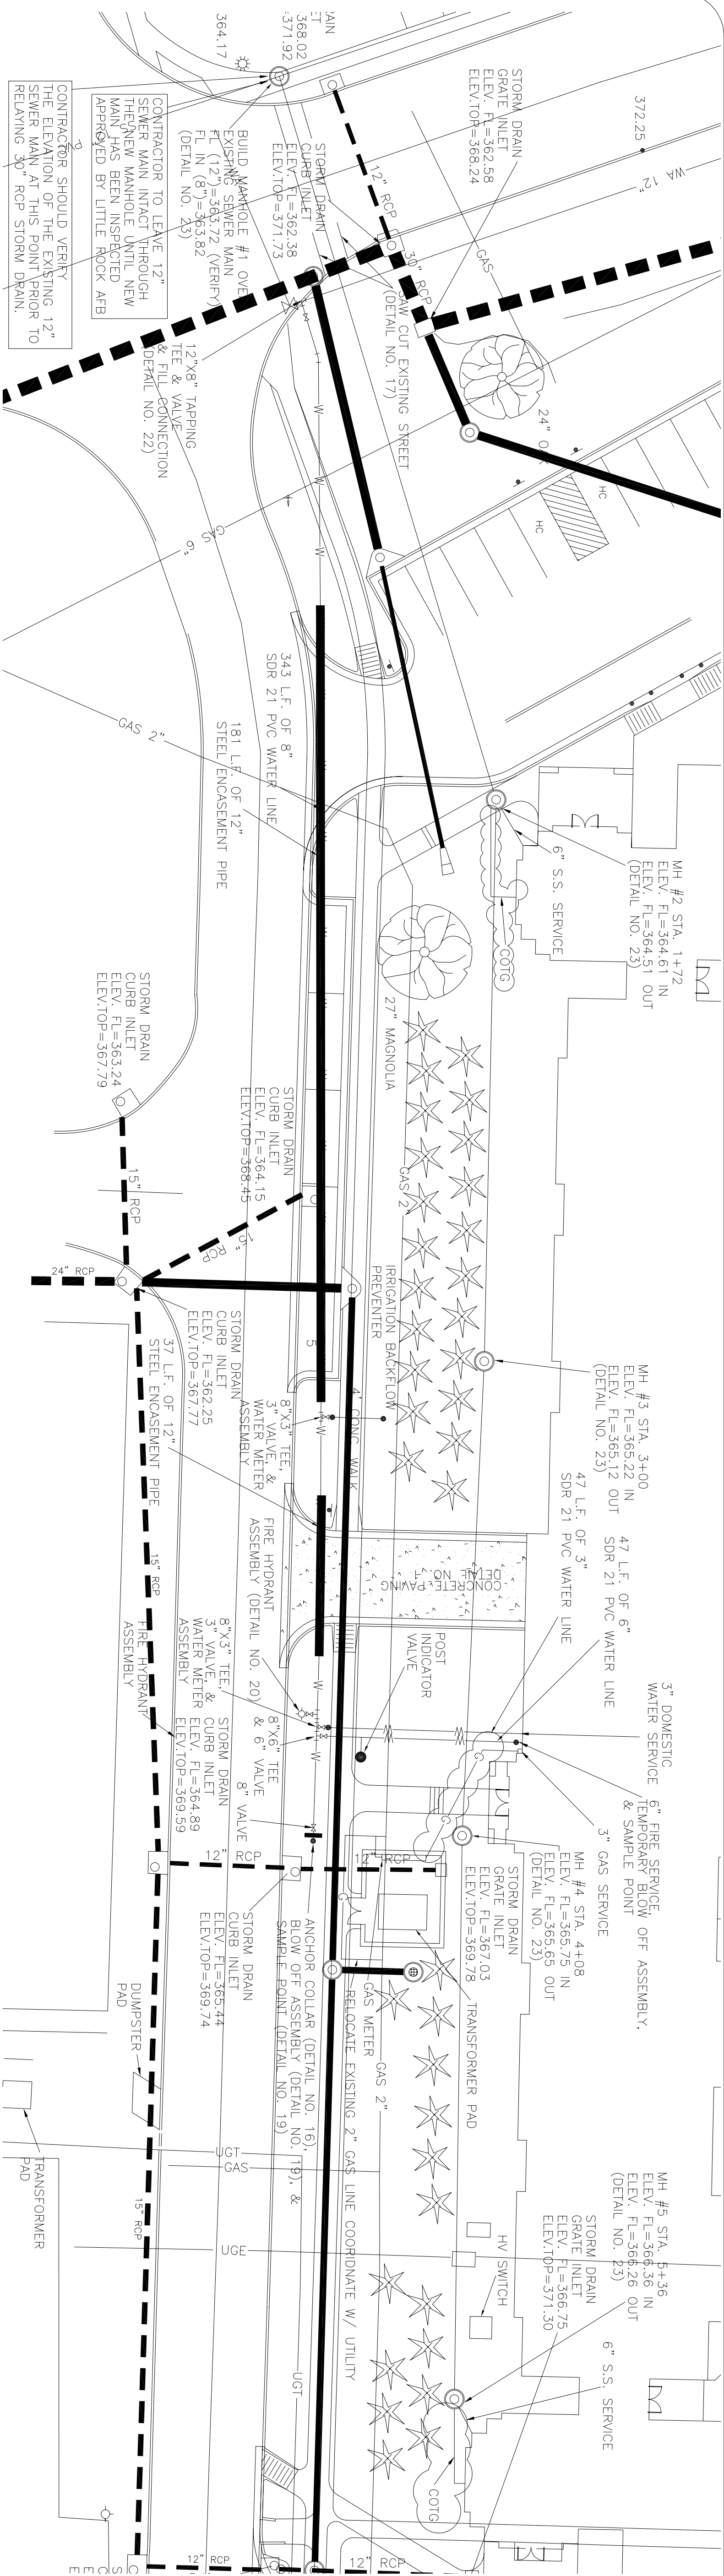


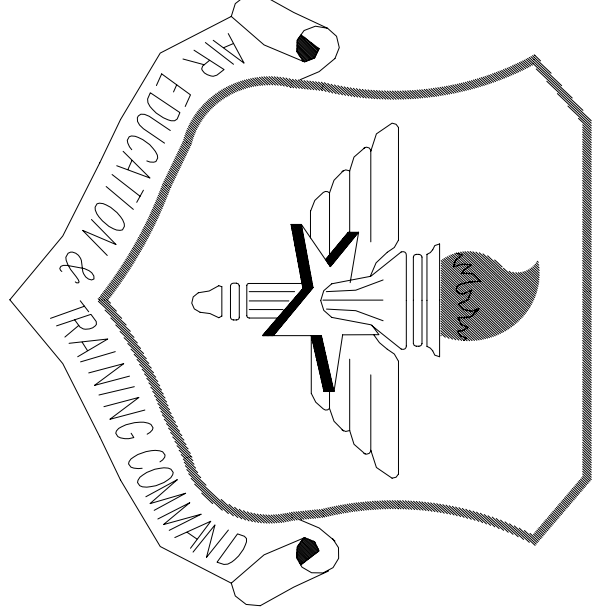

NO. 23 SANITARY SEWER MANHOLE

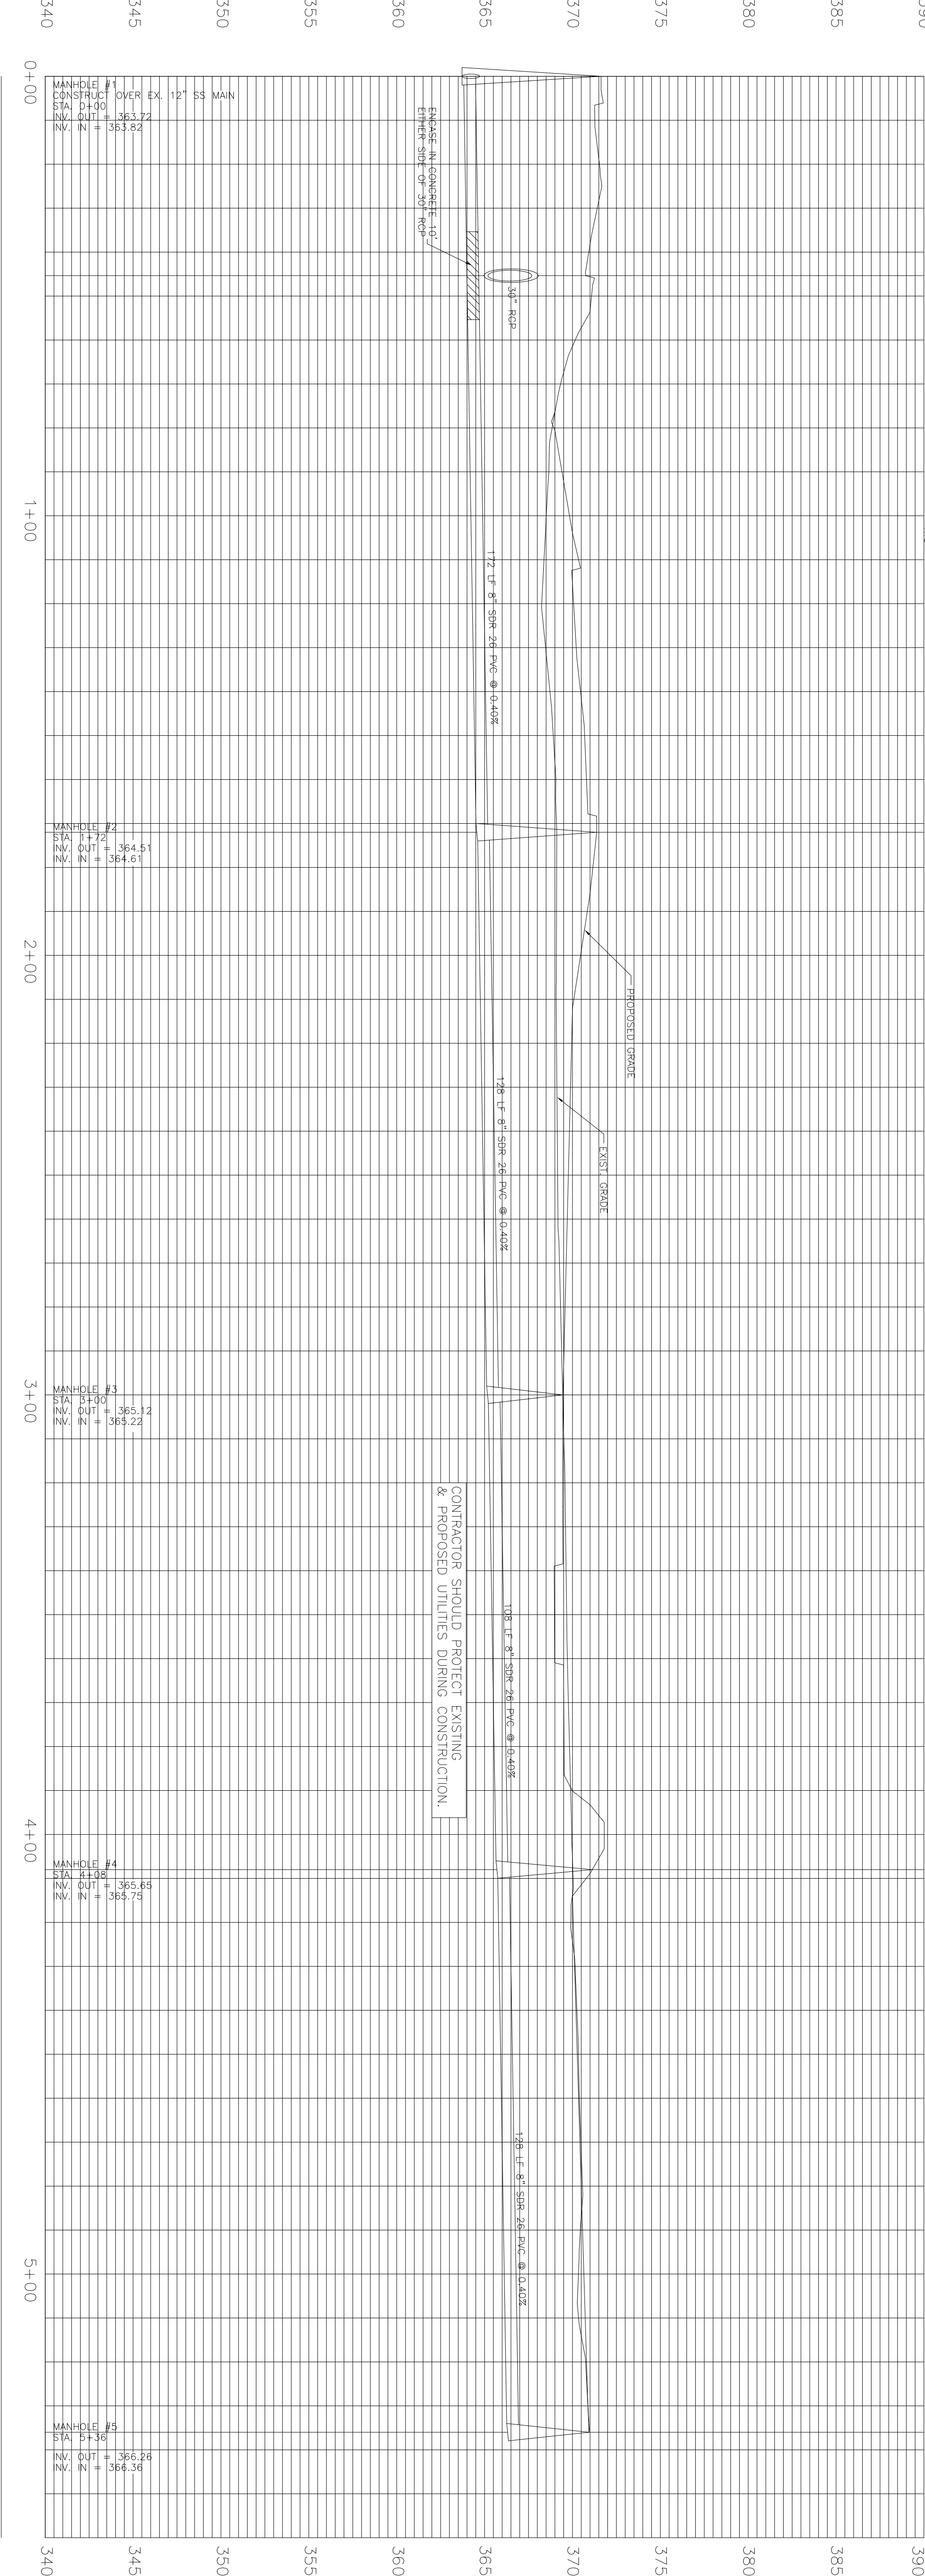

LITTLE ROCK A.F.B.
ARKANSAS

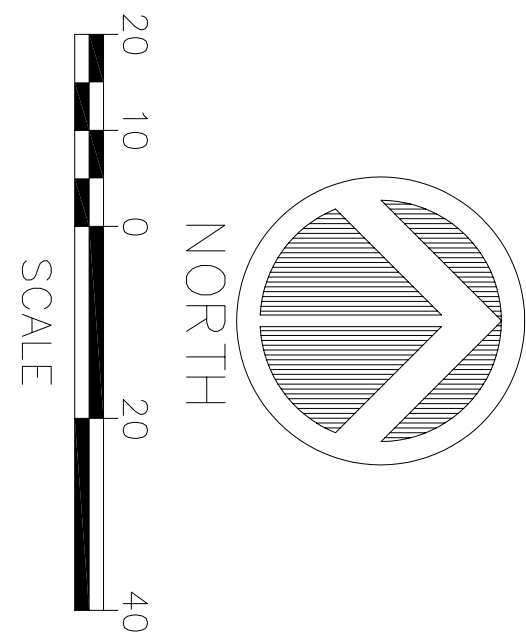

No.	Revision/Issue	Date	BY	APP'D
1	As-Built Revisions COTG and Gas Line location amended			

PROJECT TITLE
TEMPORARY LODGING FACILITY (TLF)
LITTLE ROCK AIR FORCE BASE

SHEET TITLE
SEWER PLAN & PROFILE
AS-BUILT

DESIGNED BY KRY	FILE LOCATION 6-100-13XJNSON\03\SYSTEMS	LEAD DESIGNER KRY
DATE 28 MAY 2002	PROJECT NUMBER WMA02-001	
SCALE 1"=20'	SHEET C5	
		6 OF 108