




LITTLE ROCK A.F.B.
ARKANSAS

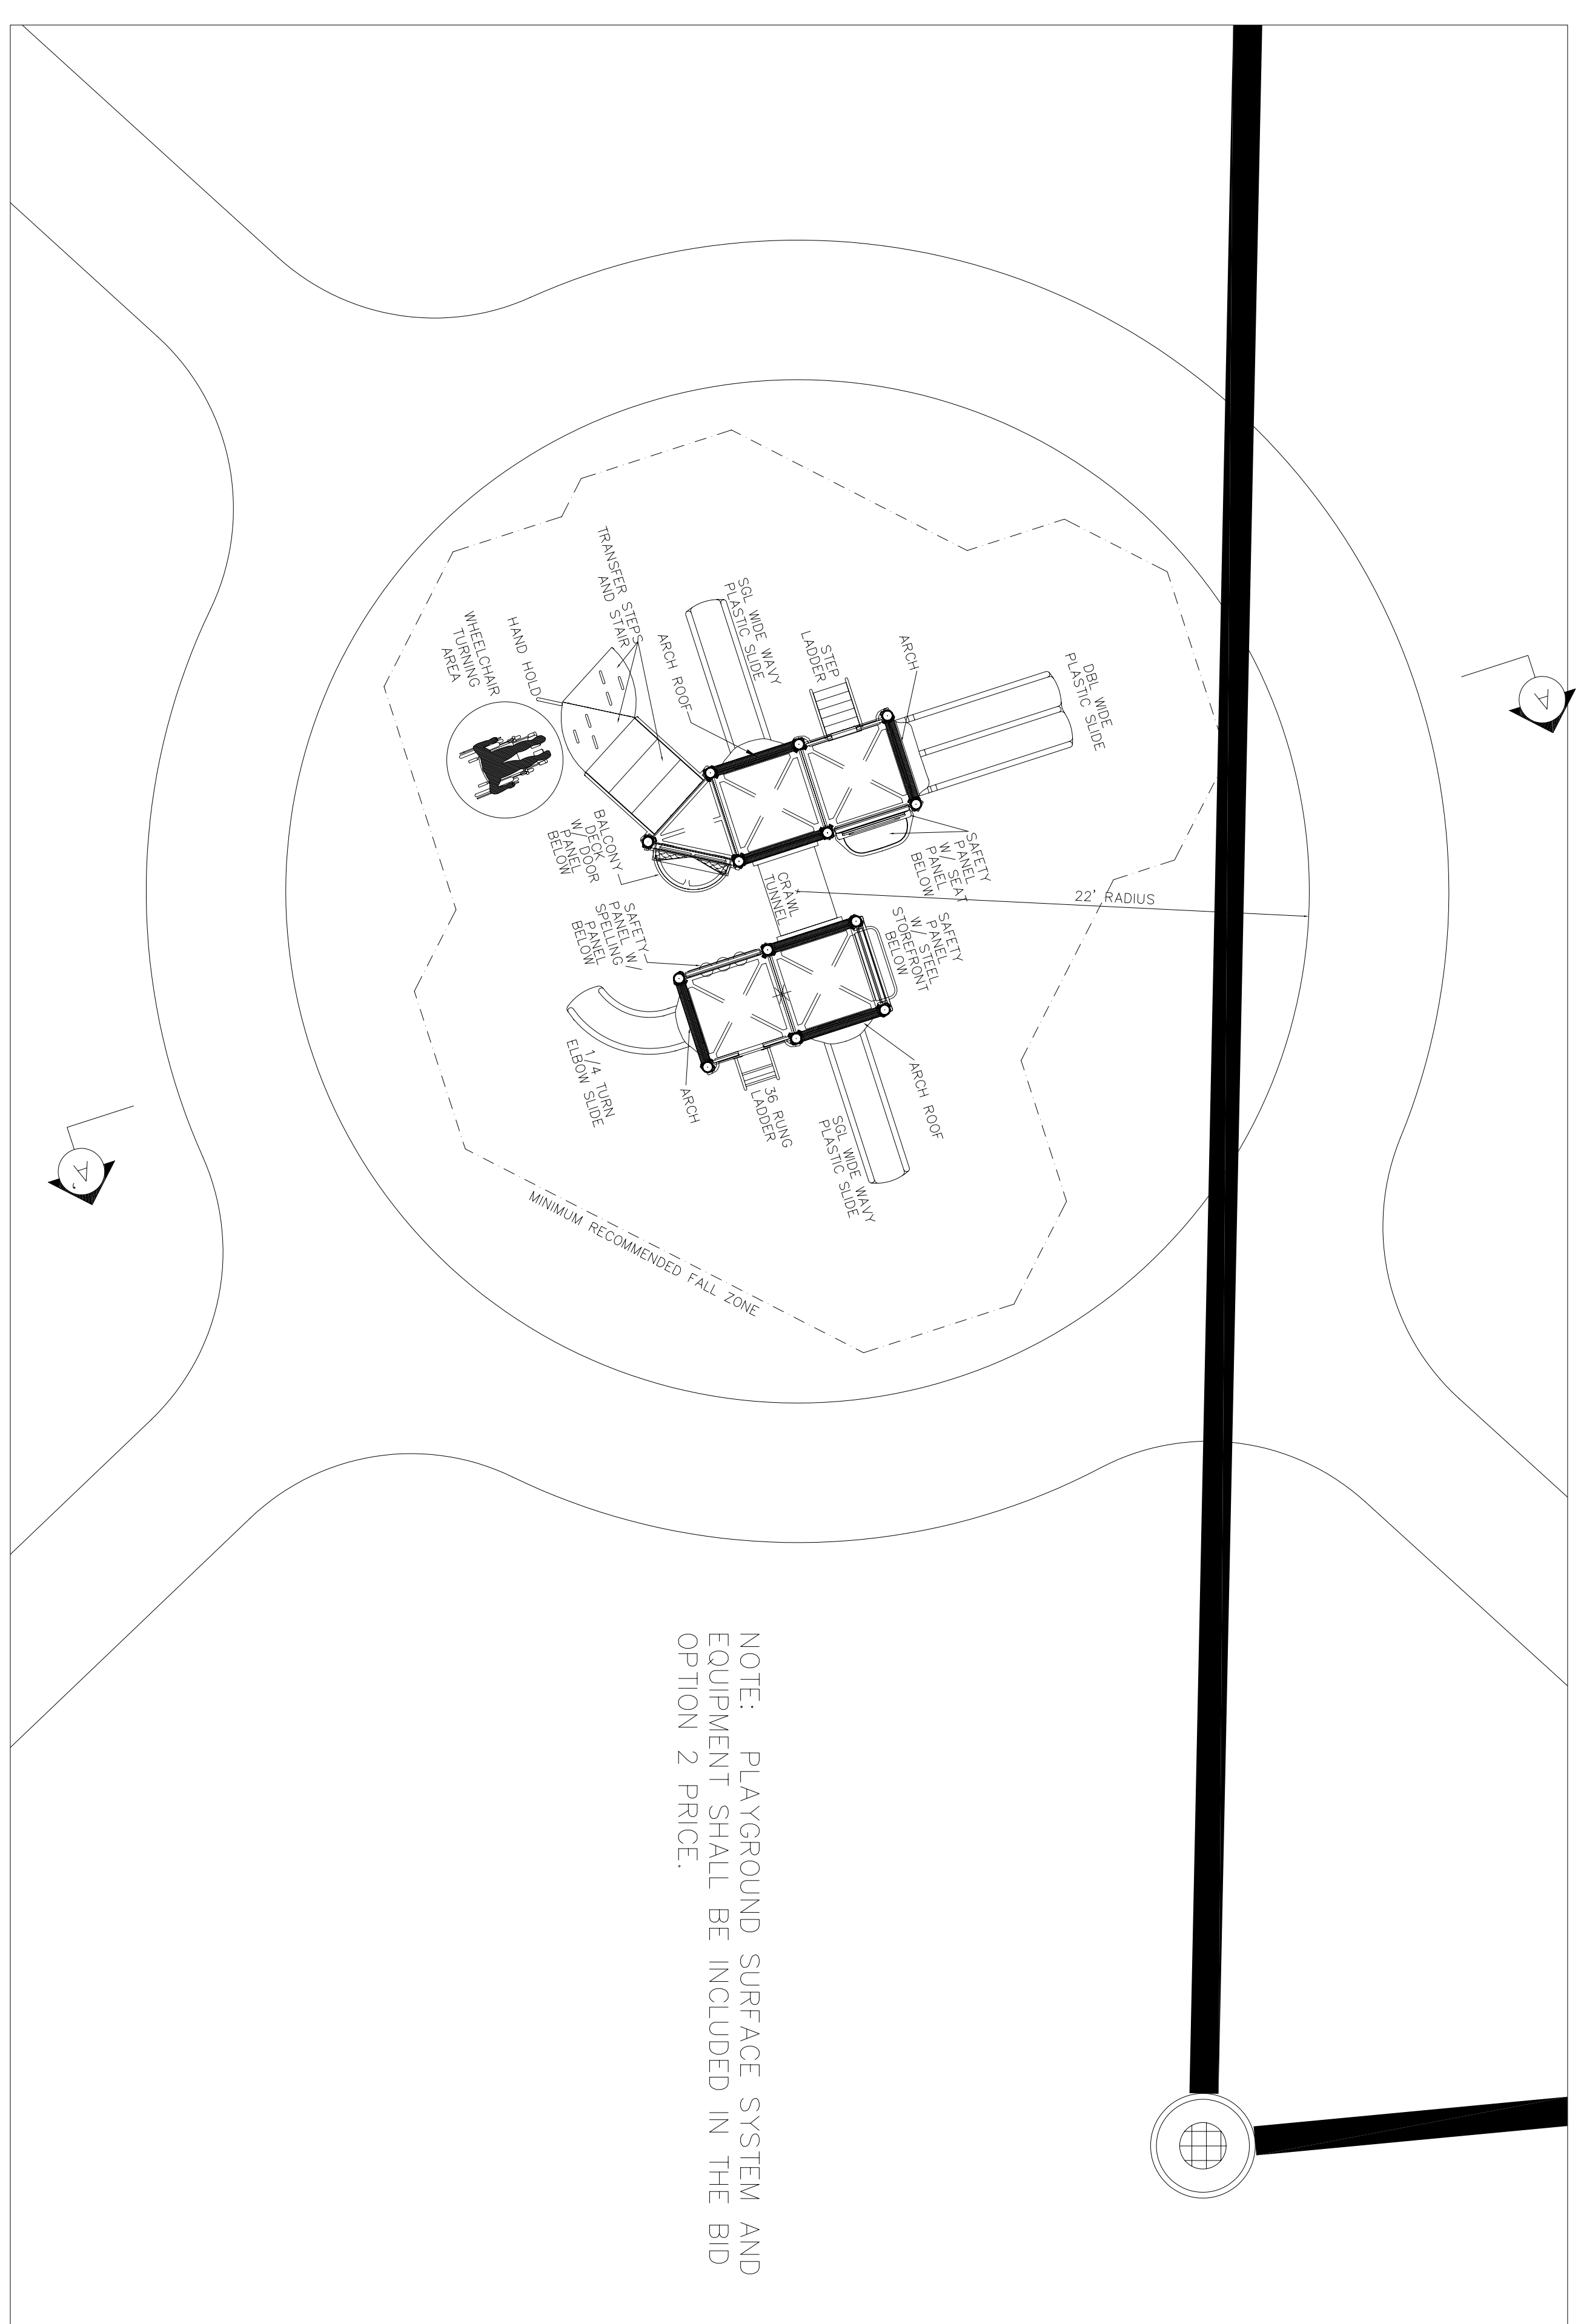

NOTE: PLAYGROUND SURFACE SYSTEM AND EQUIPMENT SHALL BE INCLUDED IN THE BID OPTION 2 PRICE.

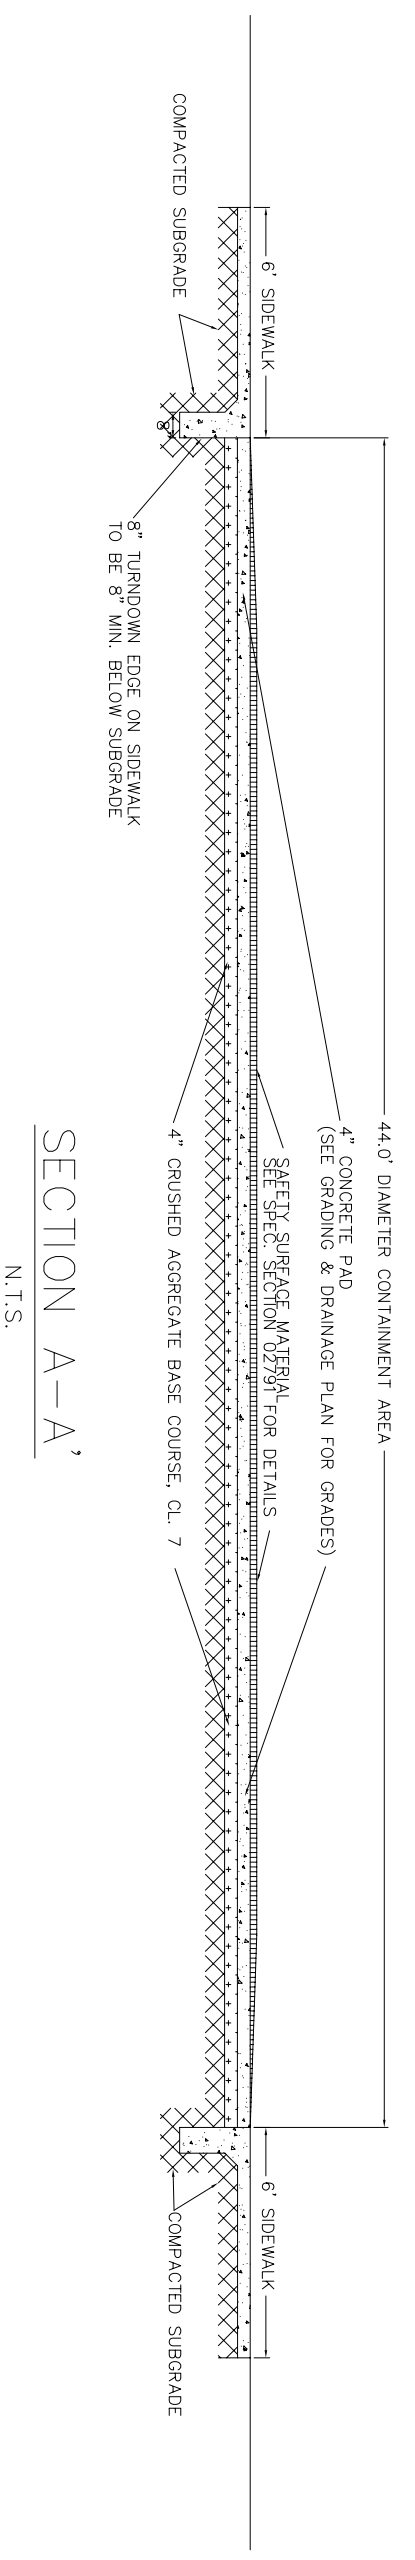

PLAYGROUND PLAN
AS-BUILT

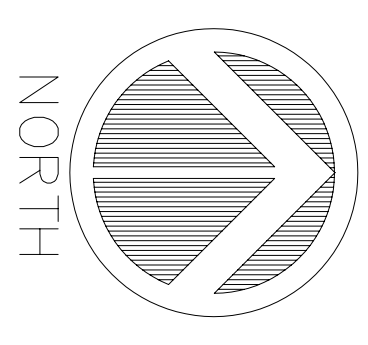

No.	Revision/Issue	Date	BY	APP'D
1	No Changes from Design to As-Built			

PROJECT TITLE
TEMPORARY LODGING FACILITY (TLF)
LITTLE ROCK AIR FORCE BASE

SHEET TITLE
PLAYGROUND PLAN
AS-BUILT

DRAWN BY RMG	LEAD DESIGNER RMG
TECH REVIEWER RMG	FILE LOCATION G:\00-133\00SRV\003SRV\AV\DMG
DESIGNED BY RMG	PROJECT NUMBER NMAK02-5001
DATE 28 MAY 2002	SHEET L2
SCALE 1"=5'	9 of 108