


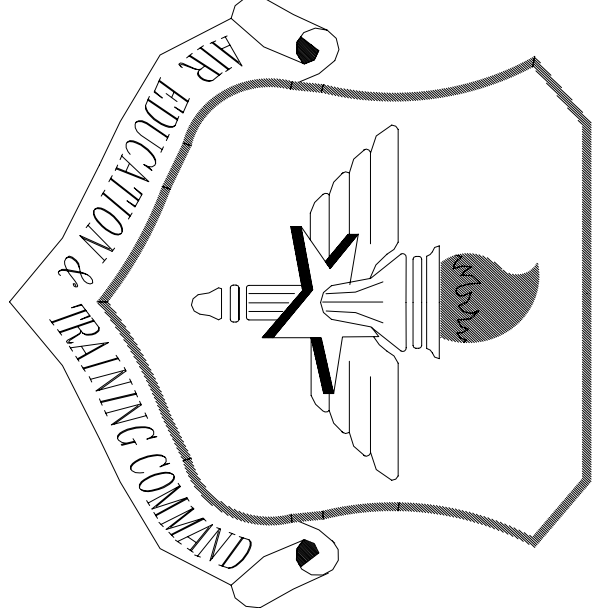

LITTLE ROCK A.F.B.
ARKANSAS

No.	Revision/Issue	Date	BY	APP'D
1	As-built Revisions Wall & door locations changed			

PROJECT TITLE

TEMPORARY LODGING FACILITY

SHEET TITLE

PARTIAL FIRST FLOOR REFERENCE PLAN

AS-BUILT

DRAWN BY	LEAD DESIGNER
JB/ RL	BG
TECH REVIEWER	FILE LOCATION
BG	PROJECT NUMBER
DATE	PROJECT NUMBER
28 MAY 2002	NKAK02-5001
SCALE	SHEET
3/32"=1'-0"	11 of 108
	A2

LEGEND

BUILDING ELEVATION SYMBOL

1/A17 ← DETAIL #/ SHEET #

SECTION SYMBOL

1/A11 ← DETAIL #/ SHEET #

ENLARGED PLANS

1/A2 ← DETAIL #/ SHEET #

WINDOW SYMBOL

⊗ WINDOW TYPE

ROOM NAME & NUMBER

OFFICE ← ROOM NAME

100 ← ROOM NUMBER

CORNER GUARD

└┐

- NOTE:
1. EXTERIOR WALLS AND CORRIDOR WALLS ARE 6" METAL STUDS. ALL OTHER WALLS ARE 3-5/8" METAL STUD WALLS UNLESS OTHERWISE NOTED.
 2. REFER TO SHEET A8 & A9 FOR FIRE RATED WALL CONSTRUCTION.
 3. PROVIDE ACOUSTICAL BATT INSULATION (FULL HEIGHT AND FULL WIDTH) IN ALL WALLS SEPARATING INDIVIDUAL LIVING UNITS AND IN ALL WALLS SEPARATING INDIVIDUAL LIVING UNITS FROM ALL ADJACENT INTERIOR AREAS, CORRIDORS, ROOMS, SPACES, AND ETC...
 4. PROVIDE CORNER GUARDS AT ALL OUTSIDE CORNERS IN ALL CORRIDORS.
 5. PROVIDE 5/8" ABUSE RESISTANT Gypsum BOARD IN ALL CORRIDORS AND STAIRWELLS UP TO 48" A.F.F..
 6. REFER TO SHEET A8 & A9 FOR DOOR SCHEDULE AND SYMBOLS. REFER TO A30 FOR DOOR AND FRAME ELEVATIONS.
 7. ALL LOAD BEARING WALLS, SHEAR WALLS (SW), AND WALLS SEPARATING INDIVIDUAL UNITS SHALL BE CONSTRUCTED WITH 6" WIDE METAL STUDS. RE: STRUCTURAL S2, S3, S4, S5, S6, AND S7.

