


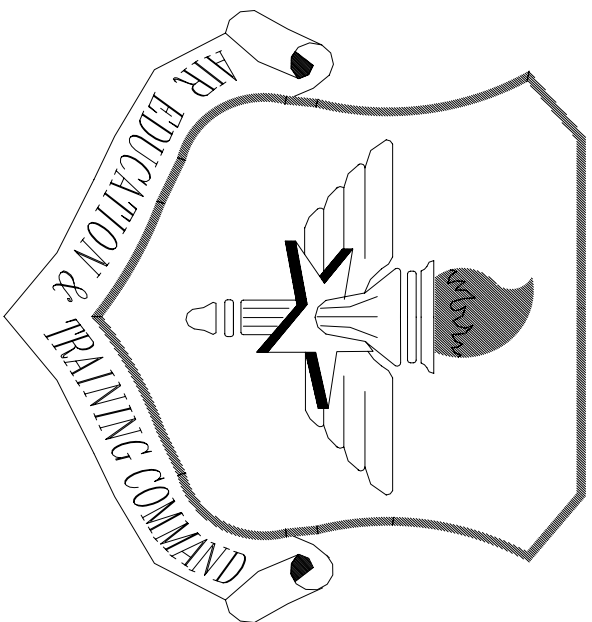



LITTLE ROCK A.F.B.
ARKANSAS

APP'D	BY	Date	Revision/Issue	No.
			1 No Changes from Deign to As-Built	1


PROJECT TITLE
TEMPORARY LODGING FACILITY

SHEET TITLE
PARTIAL SECOND FLOOR REFERENCE PLAN
AS-BUILT

DRAWN BY JB/ RL	LEAD DESIGNER BG
TCO/ REVIEWER	TITLE LOCATION
DESIGNED BY BG	PROJECT NUMBER NKA002-0001
DATE 28 MAY 2002	SHEET
SCALE 3/32"=1'-0"	12 of 108

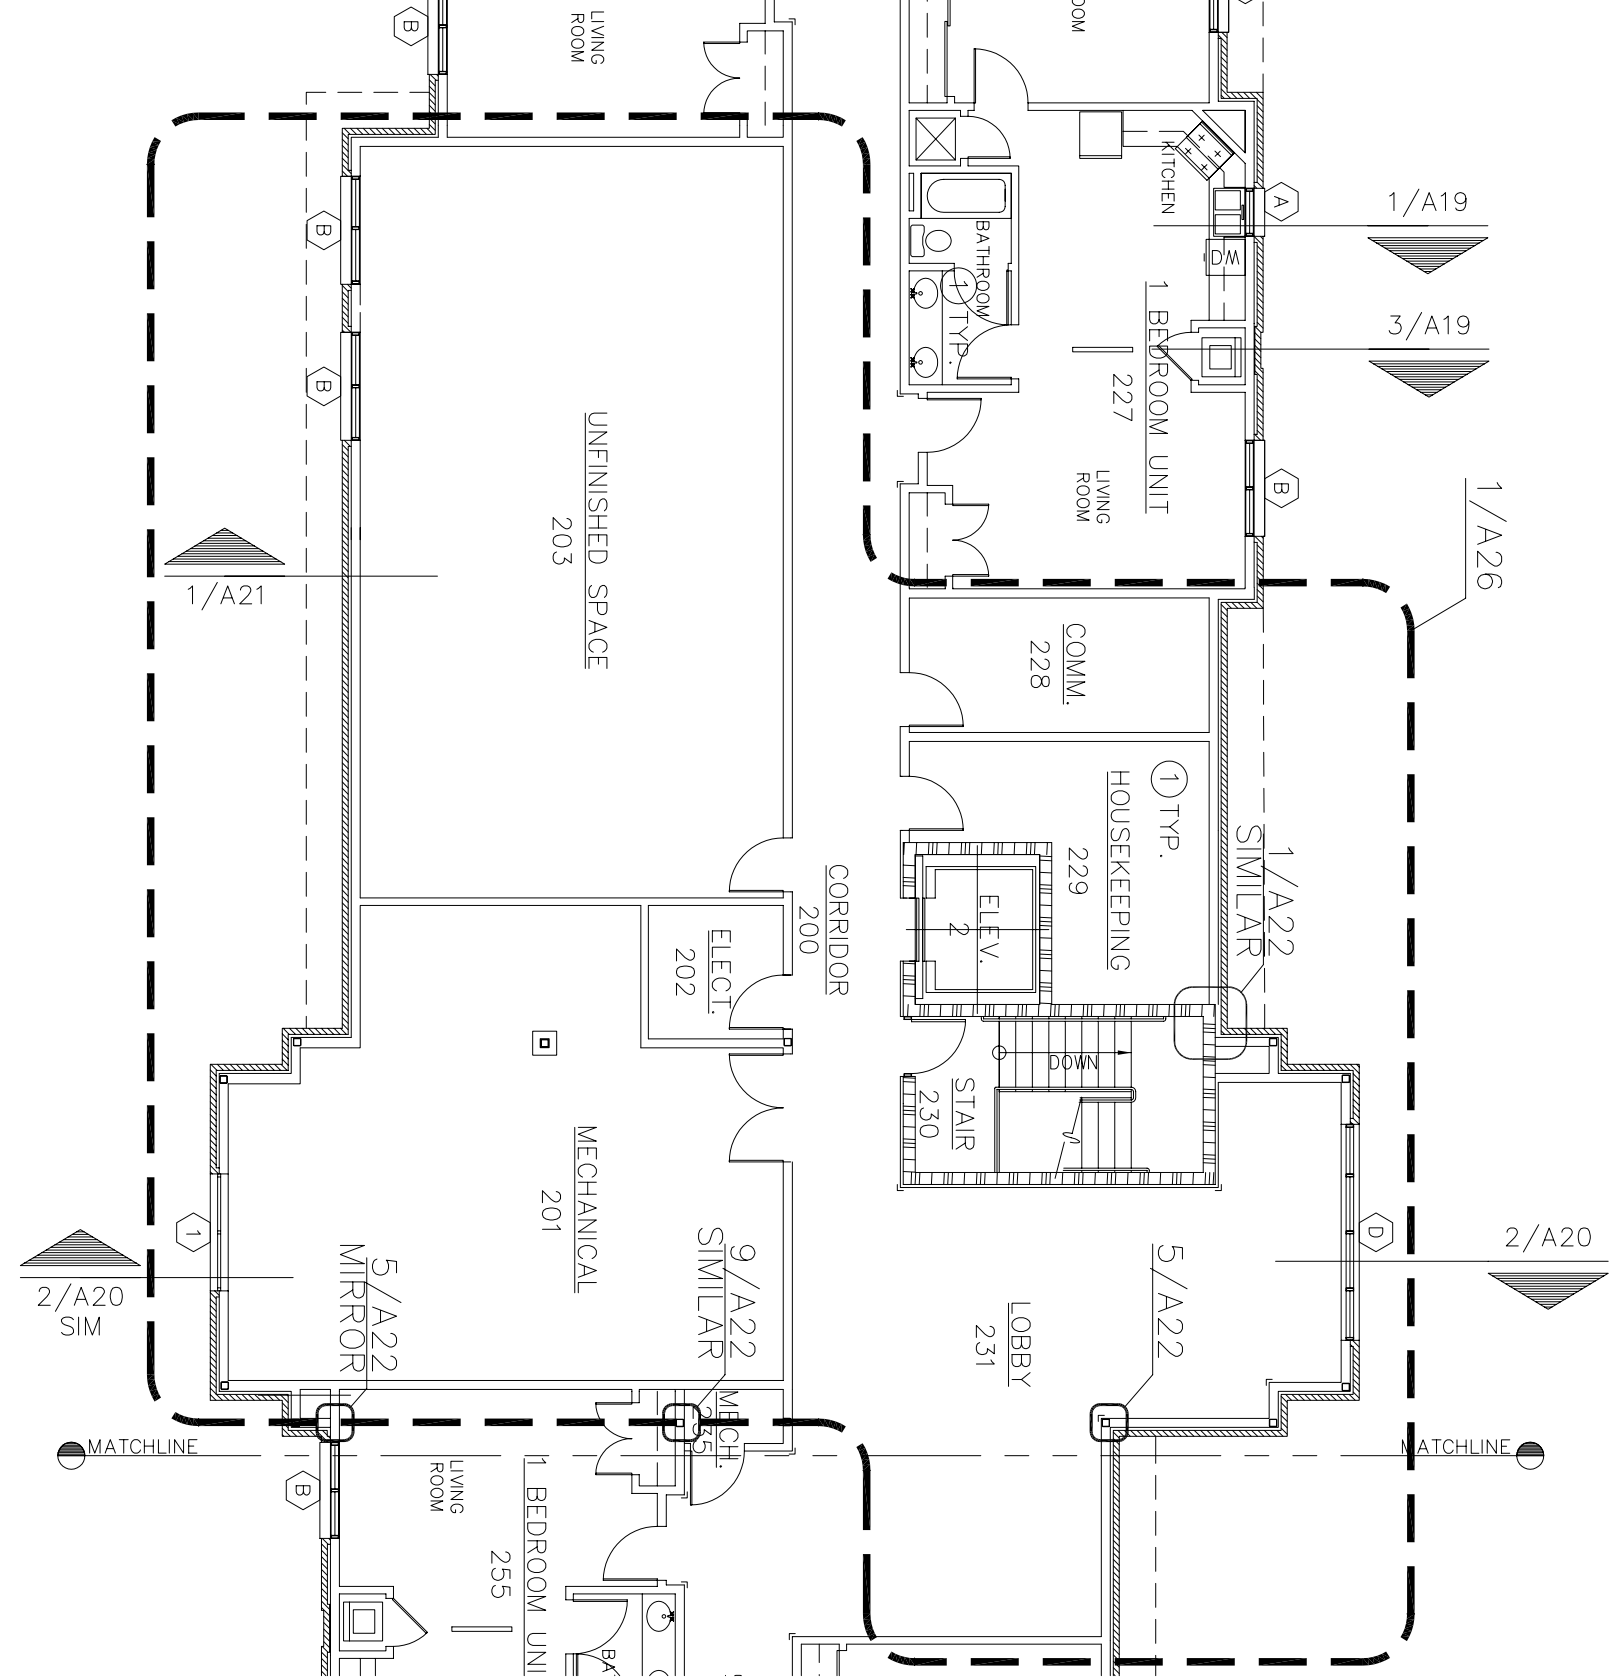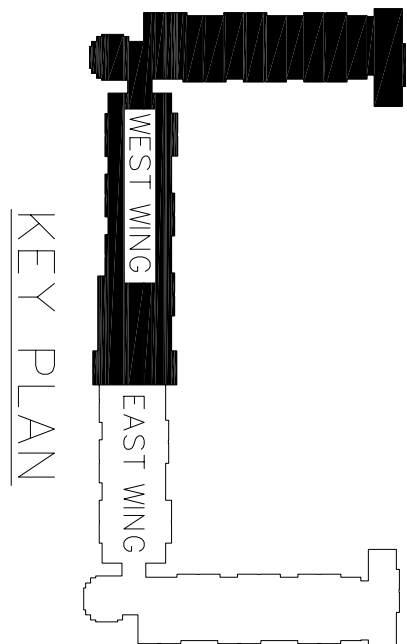

PARTIAL SECOND FLOOR REFERENCE PLAN – WEST WING
SCALE 3/32"=1'-0"
0' 5' 10' 20' 40'
SECOND FLOOR 32,212 SQ.FT.
NORTH

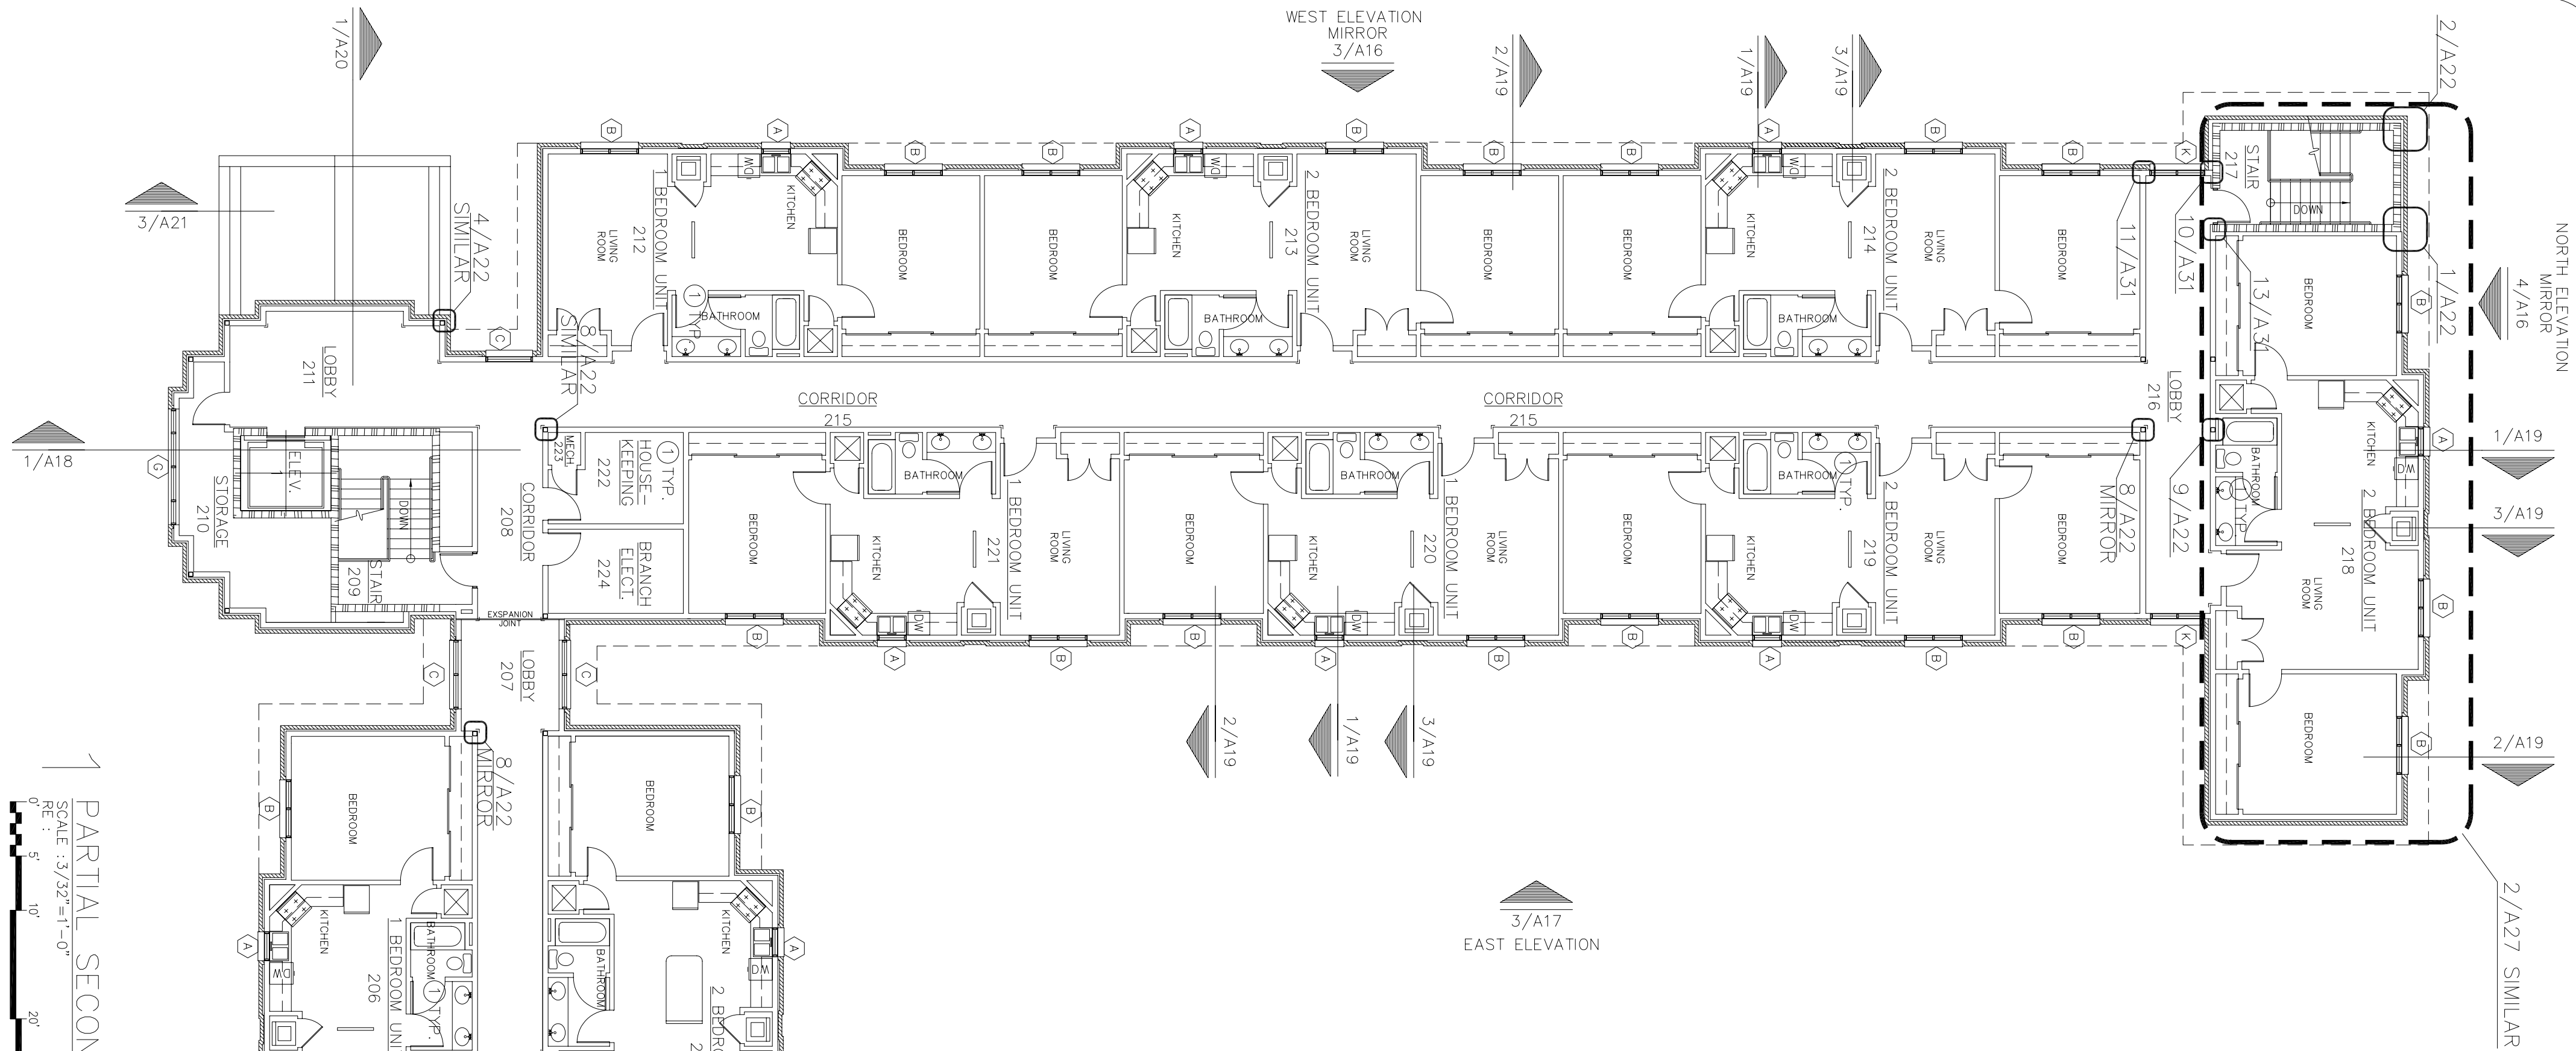

GENERAL NOTE: SECOND FLOOR ONLY
1 AT ALL UNIT BATHROOMS AND AT ALL HOUSEKEEPING ROOMS EXTEND ALL WALL CONSTRUCTION AND WALL FINISH TO BOTTOM OF ROOF TRUSSES, AND PROVIDE ONE (1) LAYER 1/2" GYPSUM BOARD TO BOTTOM CHORD OF ROOF TRUSSES. RE: 1/A23.

LEGEND

BUILDING ELEVATION SYMBOL
1/A17 ← DETAIL #/ SHEET #
SECTION SYMBOL
1/A17 ← DETAIL #/ SHEET #
ENLARGED PLANS
1/2 ← DETAIL #/ SHEET #

WINDOW SYMBOL
X → WINDOW TYPE
ROOM NAME & NUMBER
OFFICE → ROOM NAME
100 → ROOM NUMBER
CORNER GUARD

NOTE:
1 EXTERIOR WALLS AND CORRIDOR WALLS ARE 6" METAL STUDS. ALL OTHER WALLS ARE 3-5/8" METAL STUD WALLS UNLESS OTHERWISE NOTED.
2 REFER TO SHEET A8 & A9 FOR FIRE RATED WALL CONSTRUCTION.
3 PROVIDE ACOUSTICAL BATT INSULATION (FULL HEIGHT AND FULL WIDTH) IN ALL WALLS SEPARATING INDIVIDUAL LIVING UNITS AND IN ALL WALLS SEPARATING INDIVIDUAL LIVING UNITS FROM ALL ADJACENT INTERIOR SPACES, CORRIDORS, ROOMS, SPACES, AND ETC...
4 PROVIDE CORNER GUARDS AT ALL OUTSIDE CORNERS IN ALL CORRIDORS.
5 PROVIDE 5/8" ABUSE RESISTANT GYPSUM BOARD IN ALL CORRIDORS AND STAIRWELLS UP TO 48" A.F.F..
6 REFER TO SHEET A8 & A9 FOR DOOR SCHEDULE AND SYMBOLS. REFER TO A30 FOR DOOR AND FRAME ELEVATIONS.
7 ALL LOAD BEARING WALLS, SHEAR WALLS (SW), AND WALLS SEPARATING INDIVIDUAL UNITS SHALL BE CONSTRUCTED WITH 6" WIDE METAL STUDS RE: STRUCTURAL S2, S3, S4, S5, S6, AND S7.