


LITTLE ROCK A.F.B.
ARKANSAS

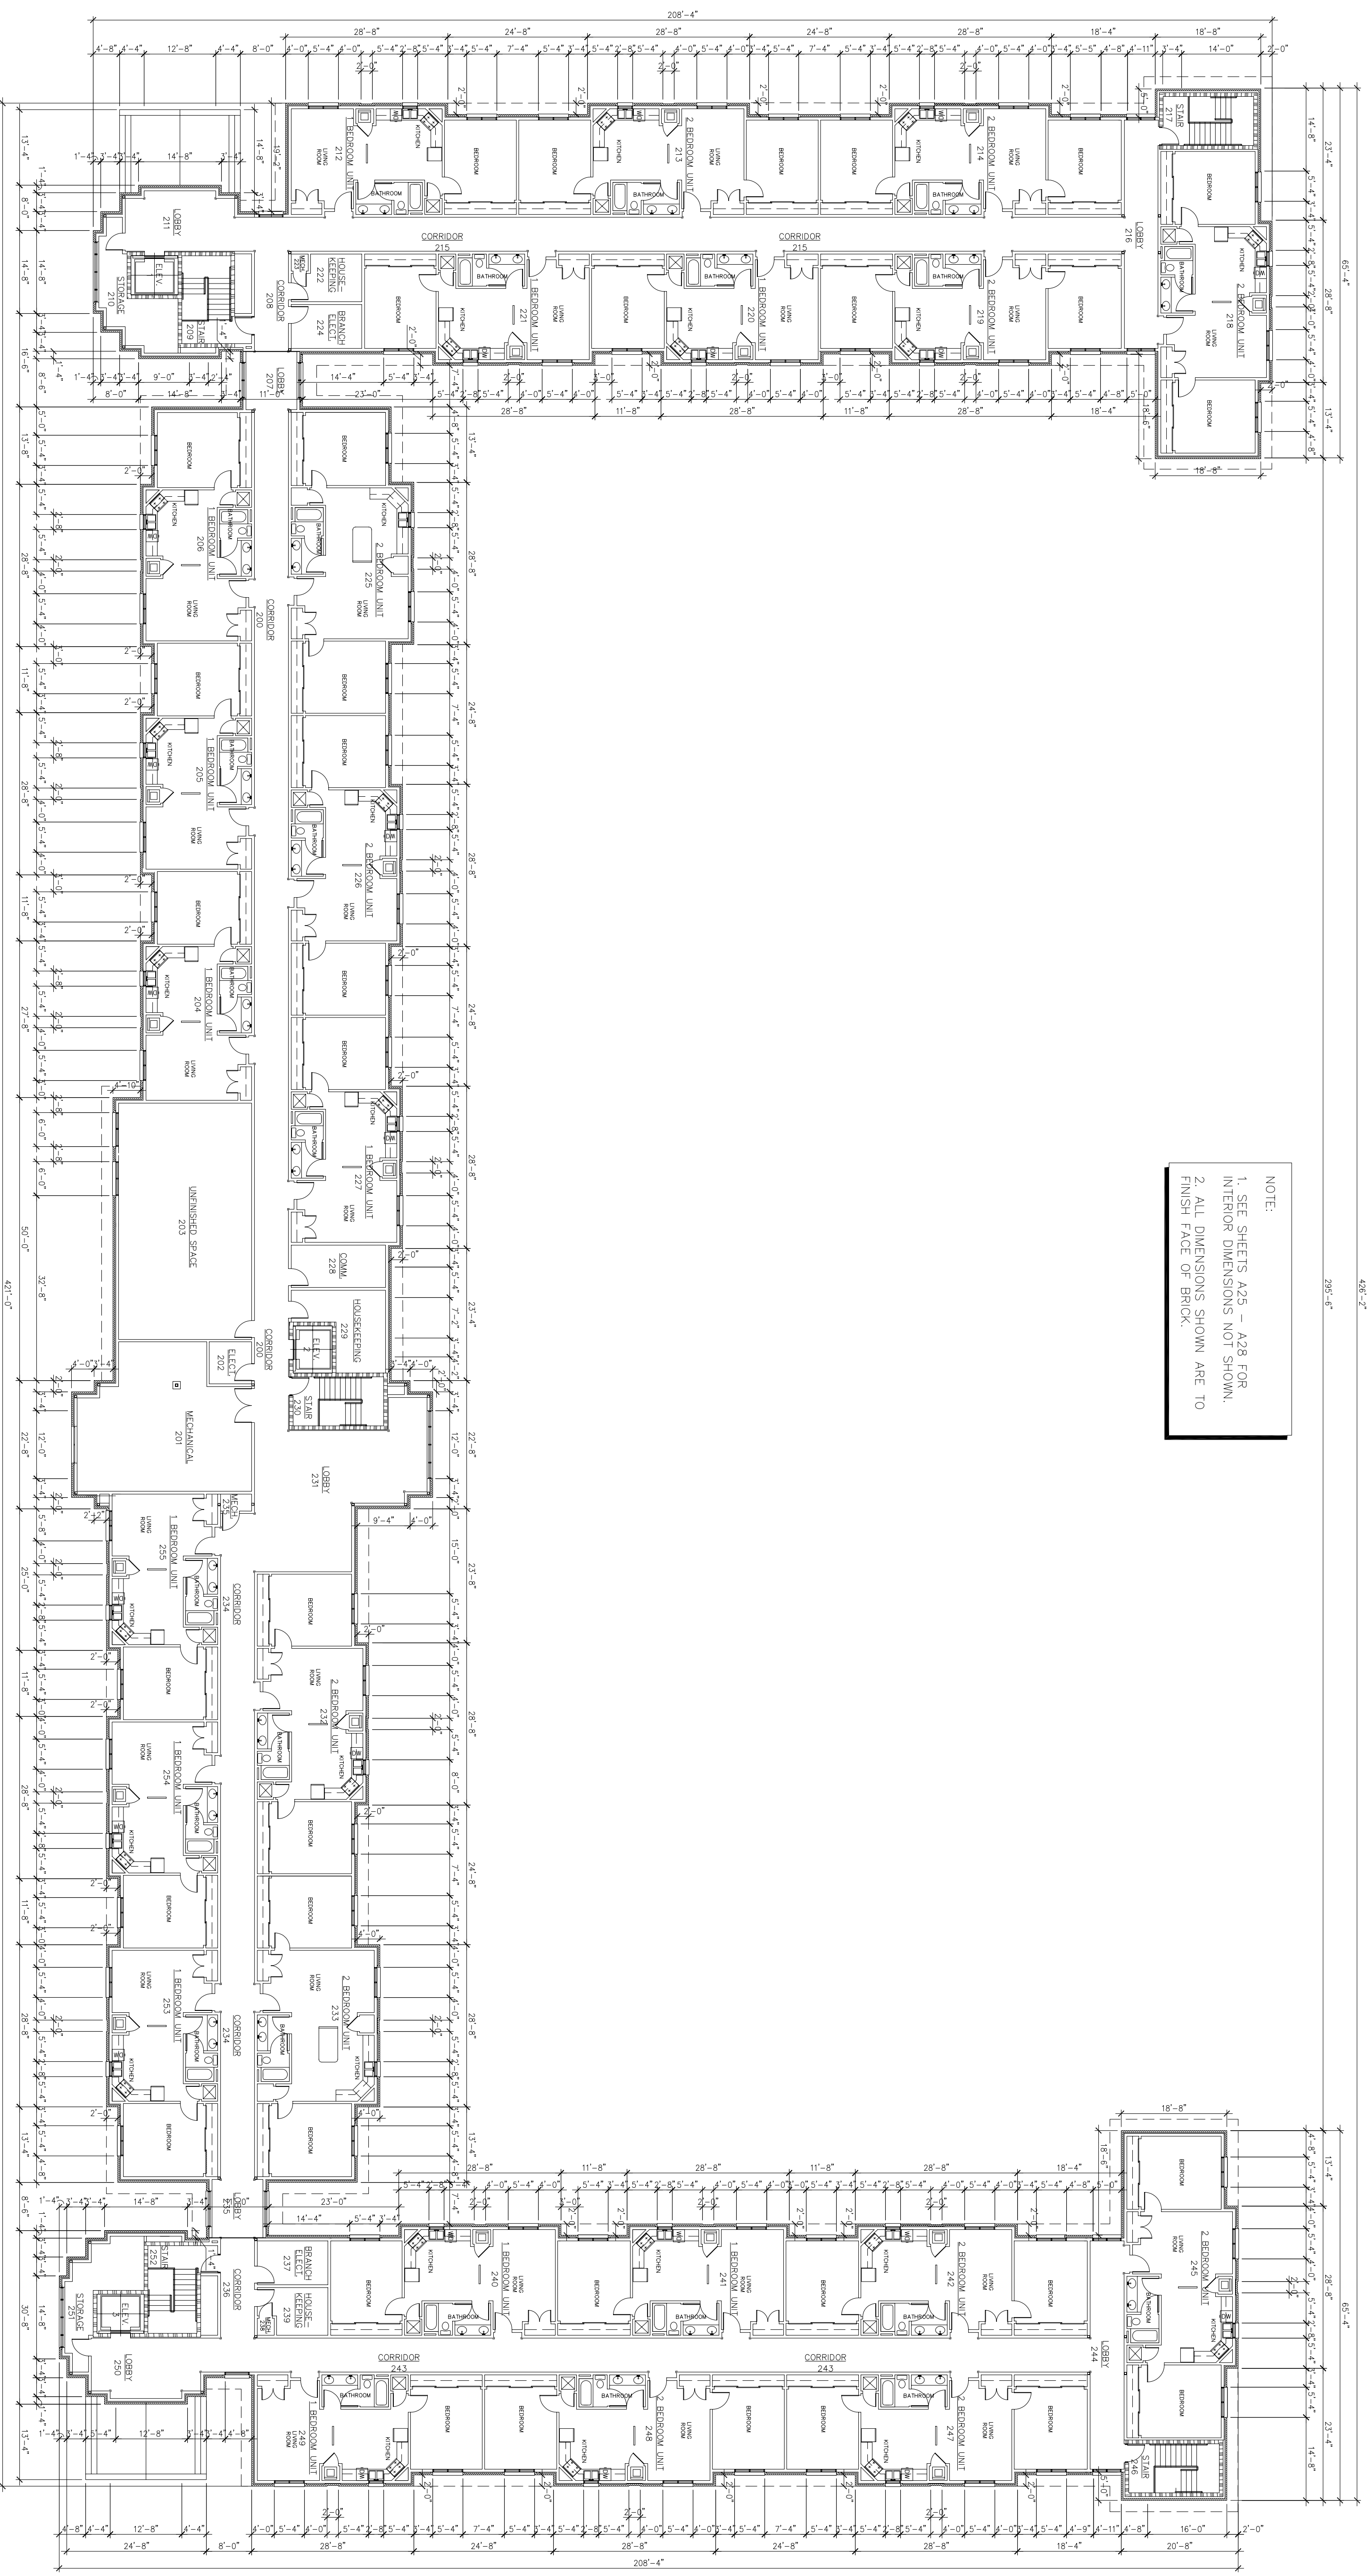

NOTE:
1. SEE SHEETS A25 - A28 FOR INTERIOR DIMENSIONS NOT SHOWN.
2. ALL DIMENSIONS SHOWN ARE TO FINISH FACE OF BRICK.

1 SECOND FLOOR DIMENSION PLAN
SCALE: 1/16" = 1'-0"
1" = 5' 10" 20' 40'



No.	Revision/Issue	Date	BY	APP'D
1	No Changes from Deign to As-Built			

PROJECT TITLE
TEMPORARY LODGING FACILITY

SHEET TITLE
SECOND FLOOR DIMENSION PLAN
AS-BUILT

DRAWN BY JB/RL	LEAD DESIGNER BC
TECH REVIEWER	FILE LOCATION
DESIGNED BY BC	PROJECT NUMBER NKA02-5001
DATE 28 MAY 2002	SHEET 15 of 108
SCALE 1/16" = 1'-0"	