




LITTLE ROCK A.F.B.  
ARKANSAS

No.	Revision/Issue	Date	BY	APP'D
1	No changes from Design to As-Built			

TEMPORARY LODGING  
FACILITY

ROOF PLAN  
AS-BUILT

ISSUED BY RL	LEAD DESIGNER BG
TECH REVIEWER	FILE LOCATION
DESIGNED BY BG	PROJECT NUMBER NKA02-5001
DATE 28 MAY 2002	SHEET A14
SCALE 1/16"=1'-0"	23 OF 108

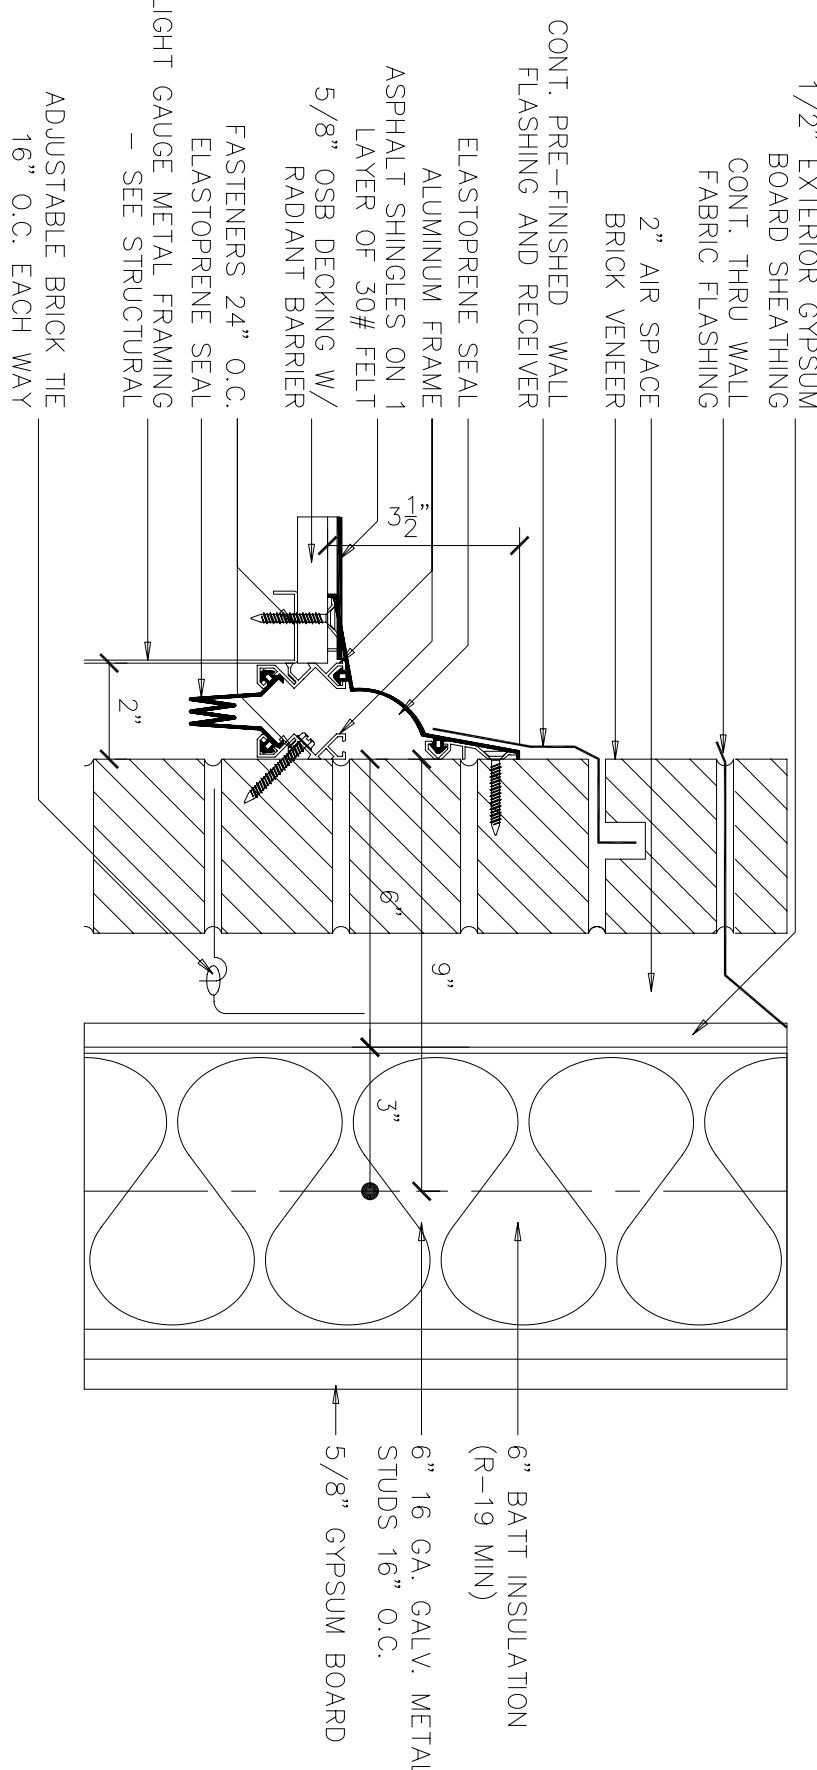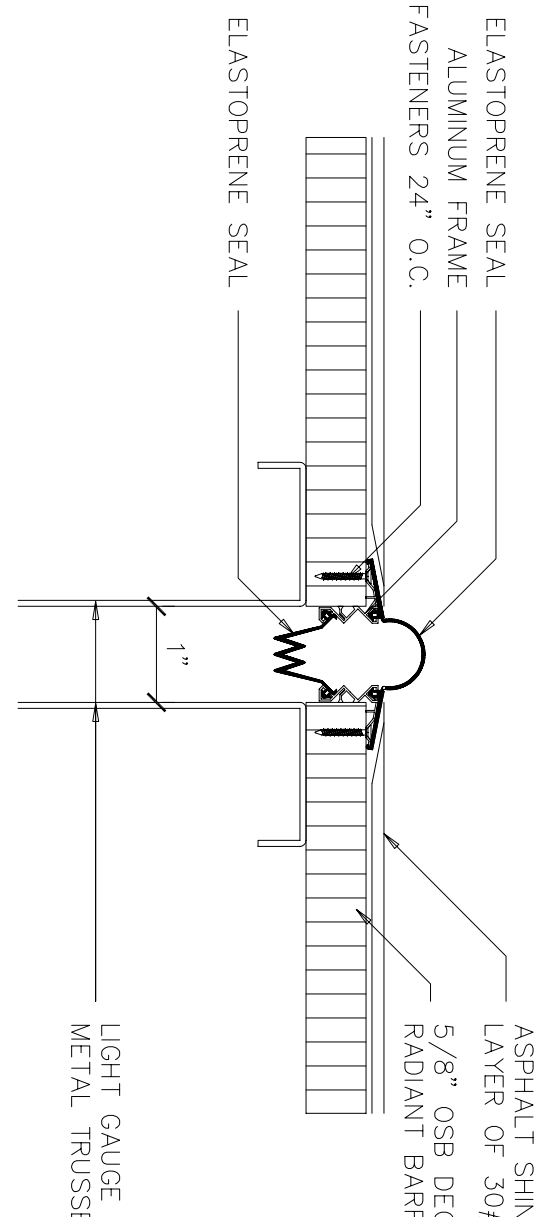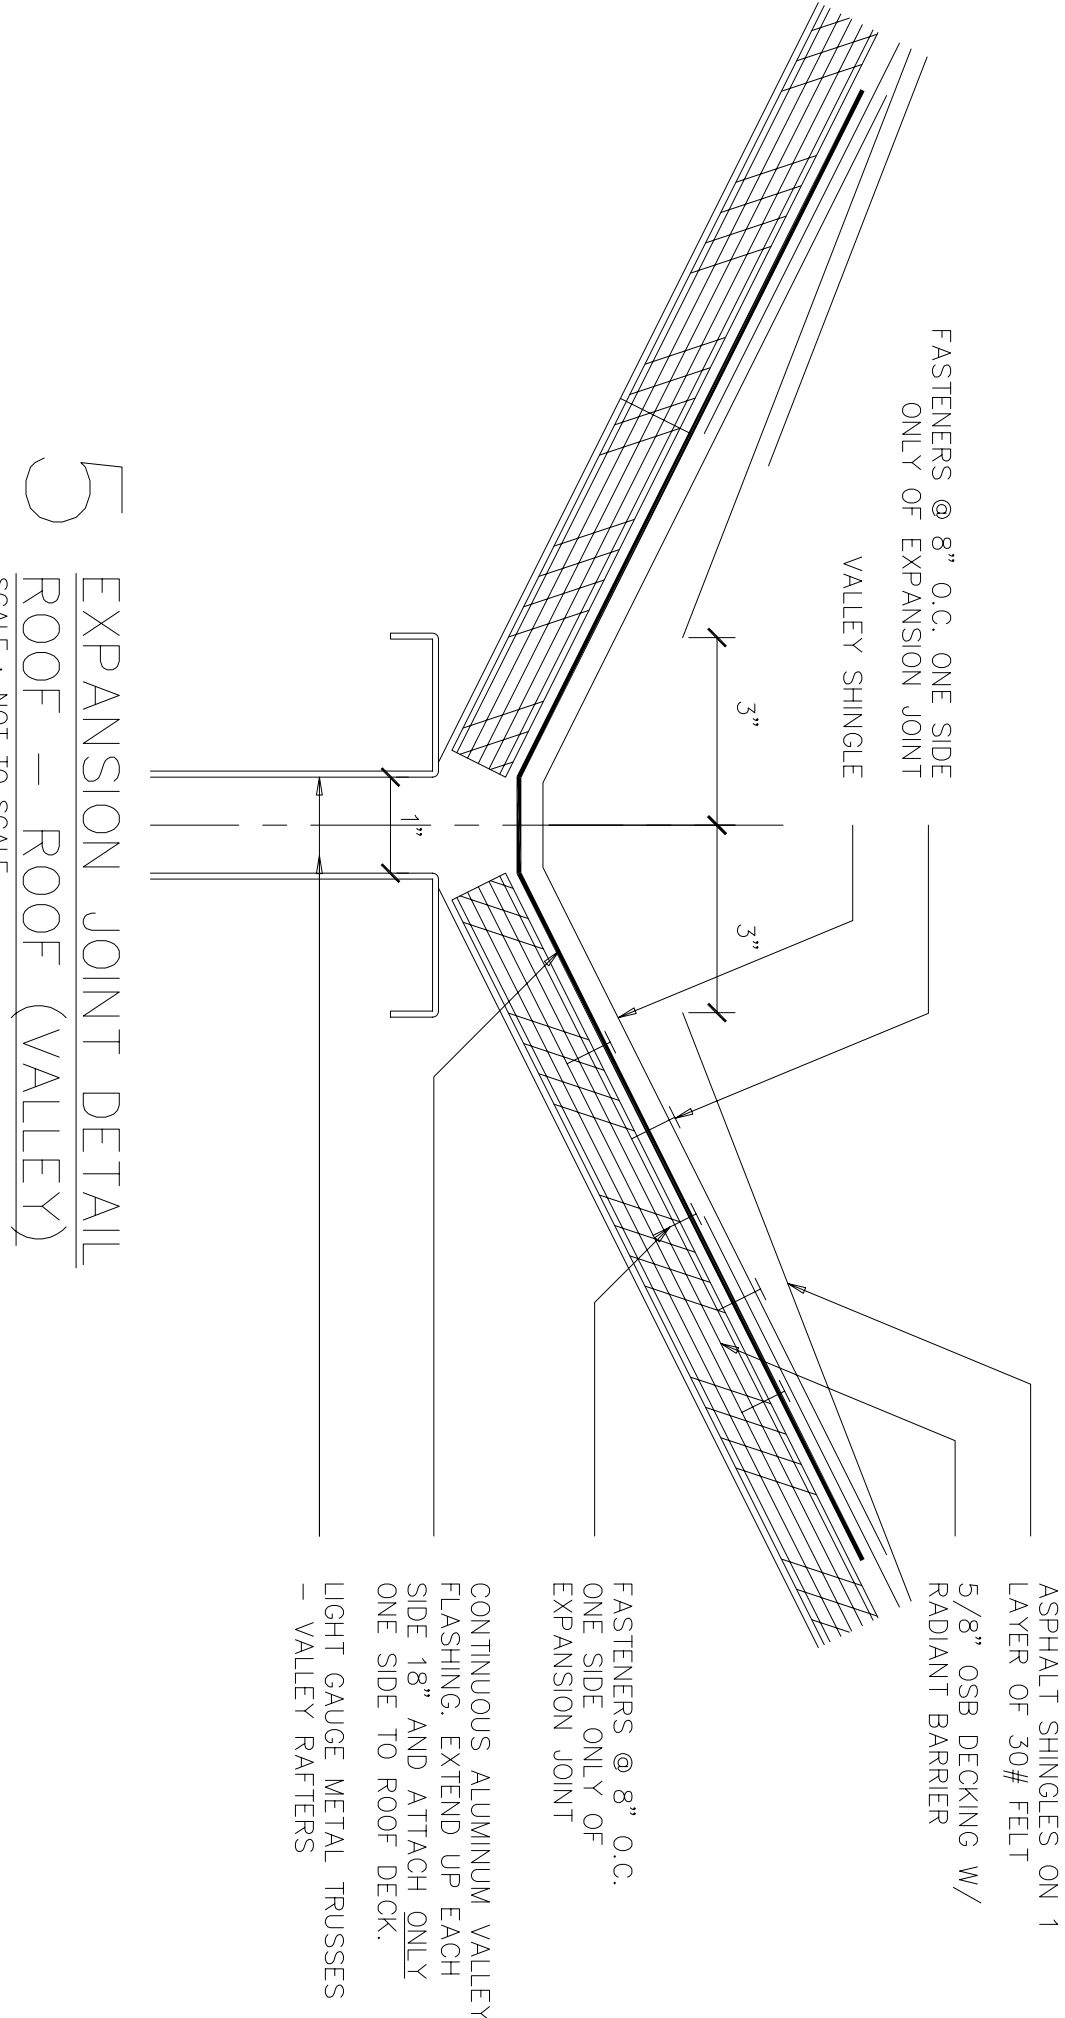

2 PARTIAL ROOF PLAN  
SCALE 1/8"=1'-0"  
RE : 1

