


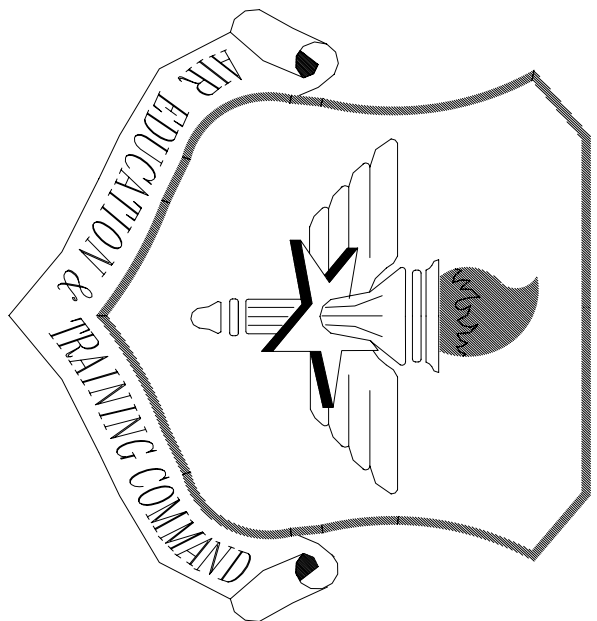




LITTLE ROCK A.F.B.
ARKANSAS

No.	Revision/Issue	Date	BY	APP'D
1	Details 5 & 6 deleted and note added RE: Lead Boot			

TEMPORARY LODGING
FACILITY

ROOF PLAN DETAILS
AS-BUILT








DRAWN BY RL	LEAD DESIGNER BG
TECH REVIEWER BG	FILE LOCATION
DESIGNED BY BG	PROJECT NUMBER M4K02-5001
DATE 28 MAY 2002	SHEET A15
SCALE 1/16"=1'-0"	24 of 108

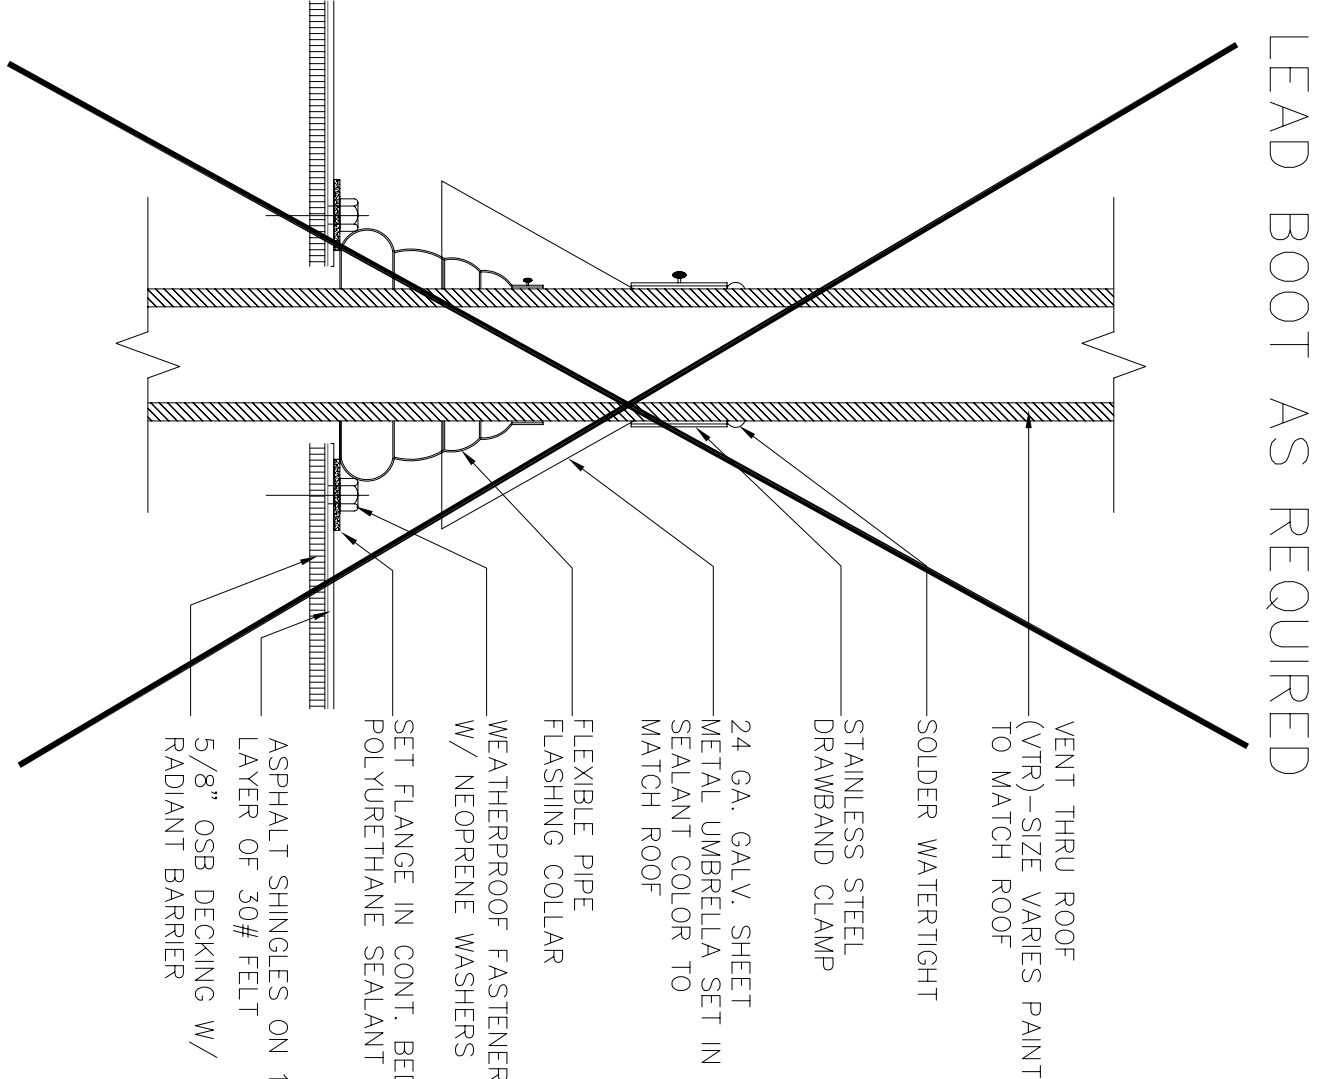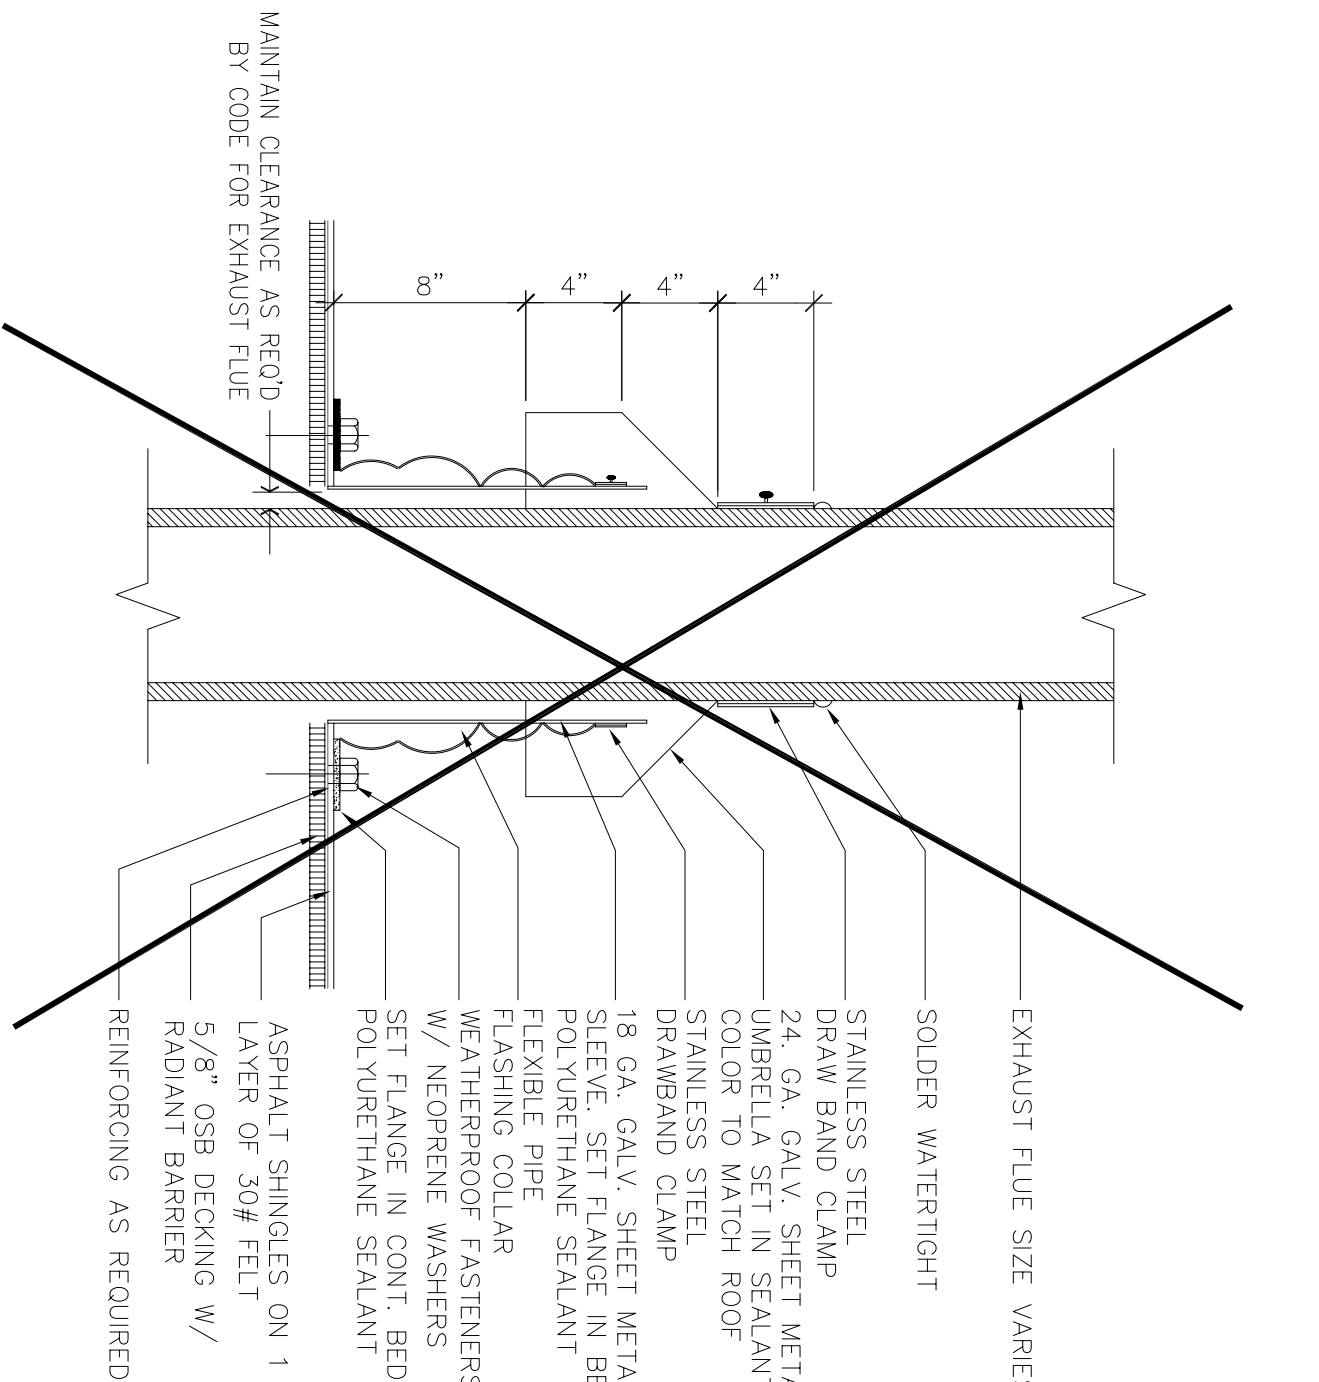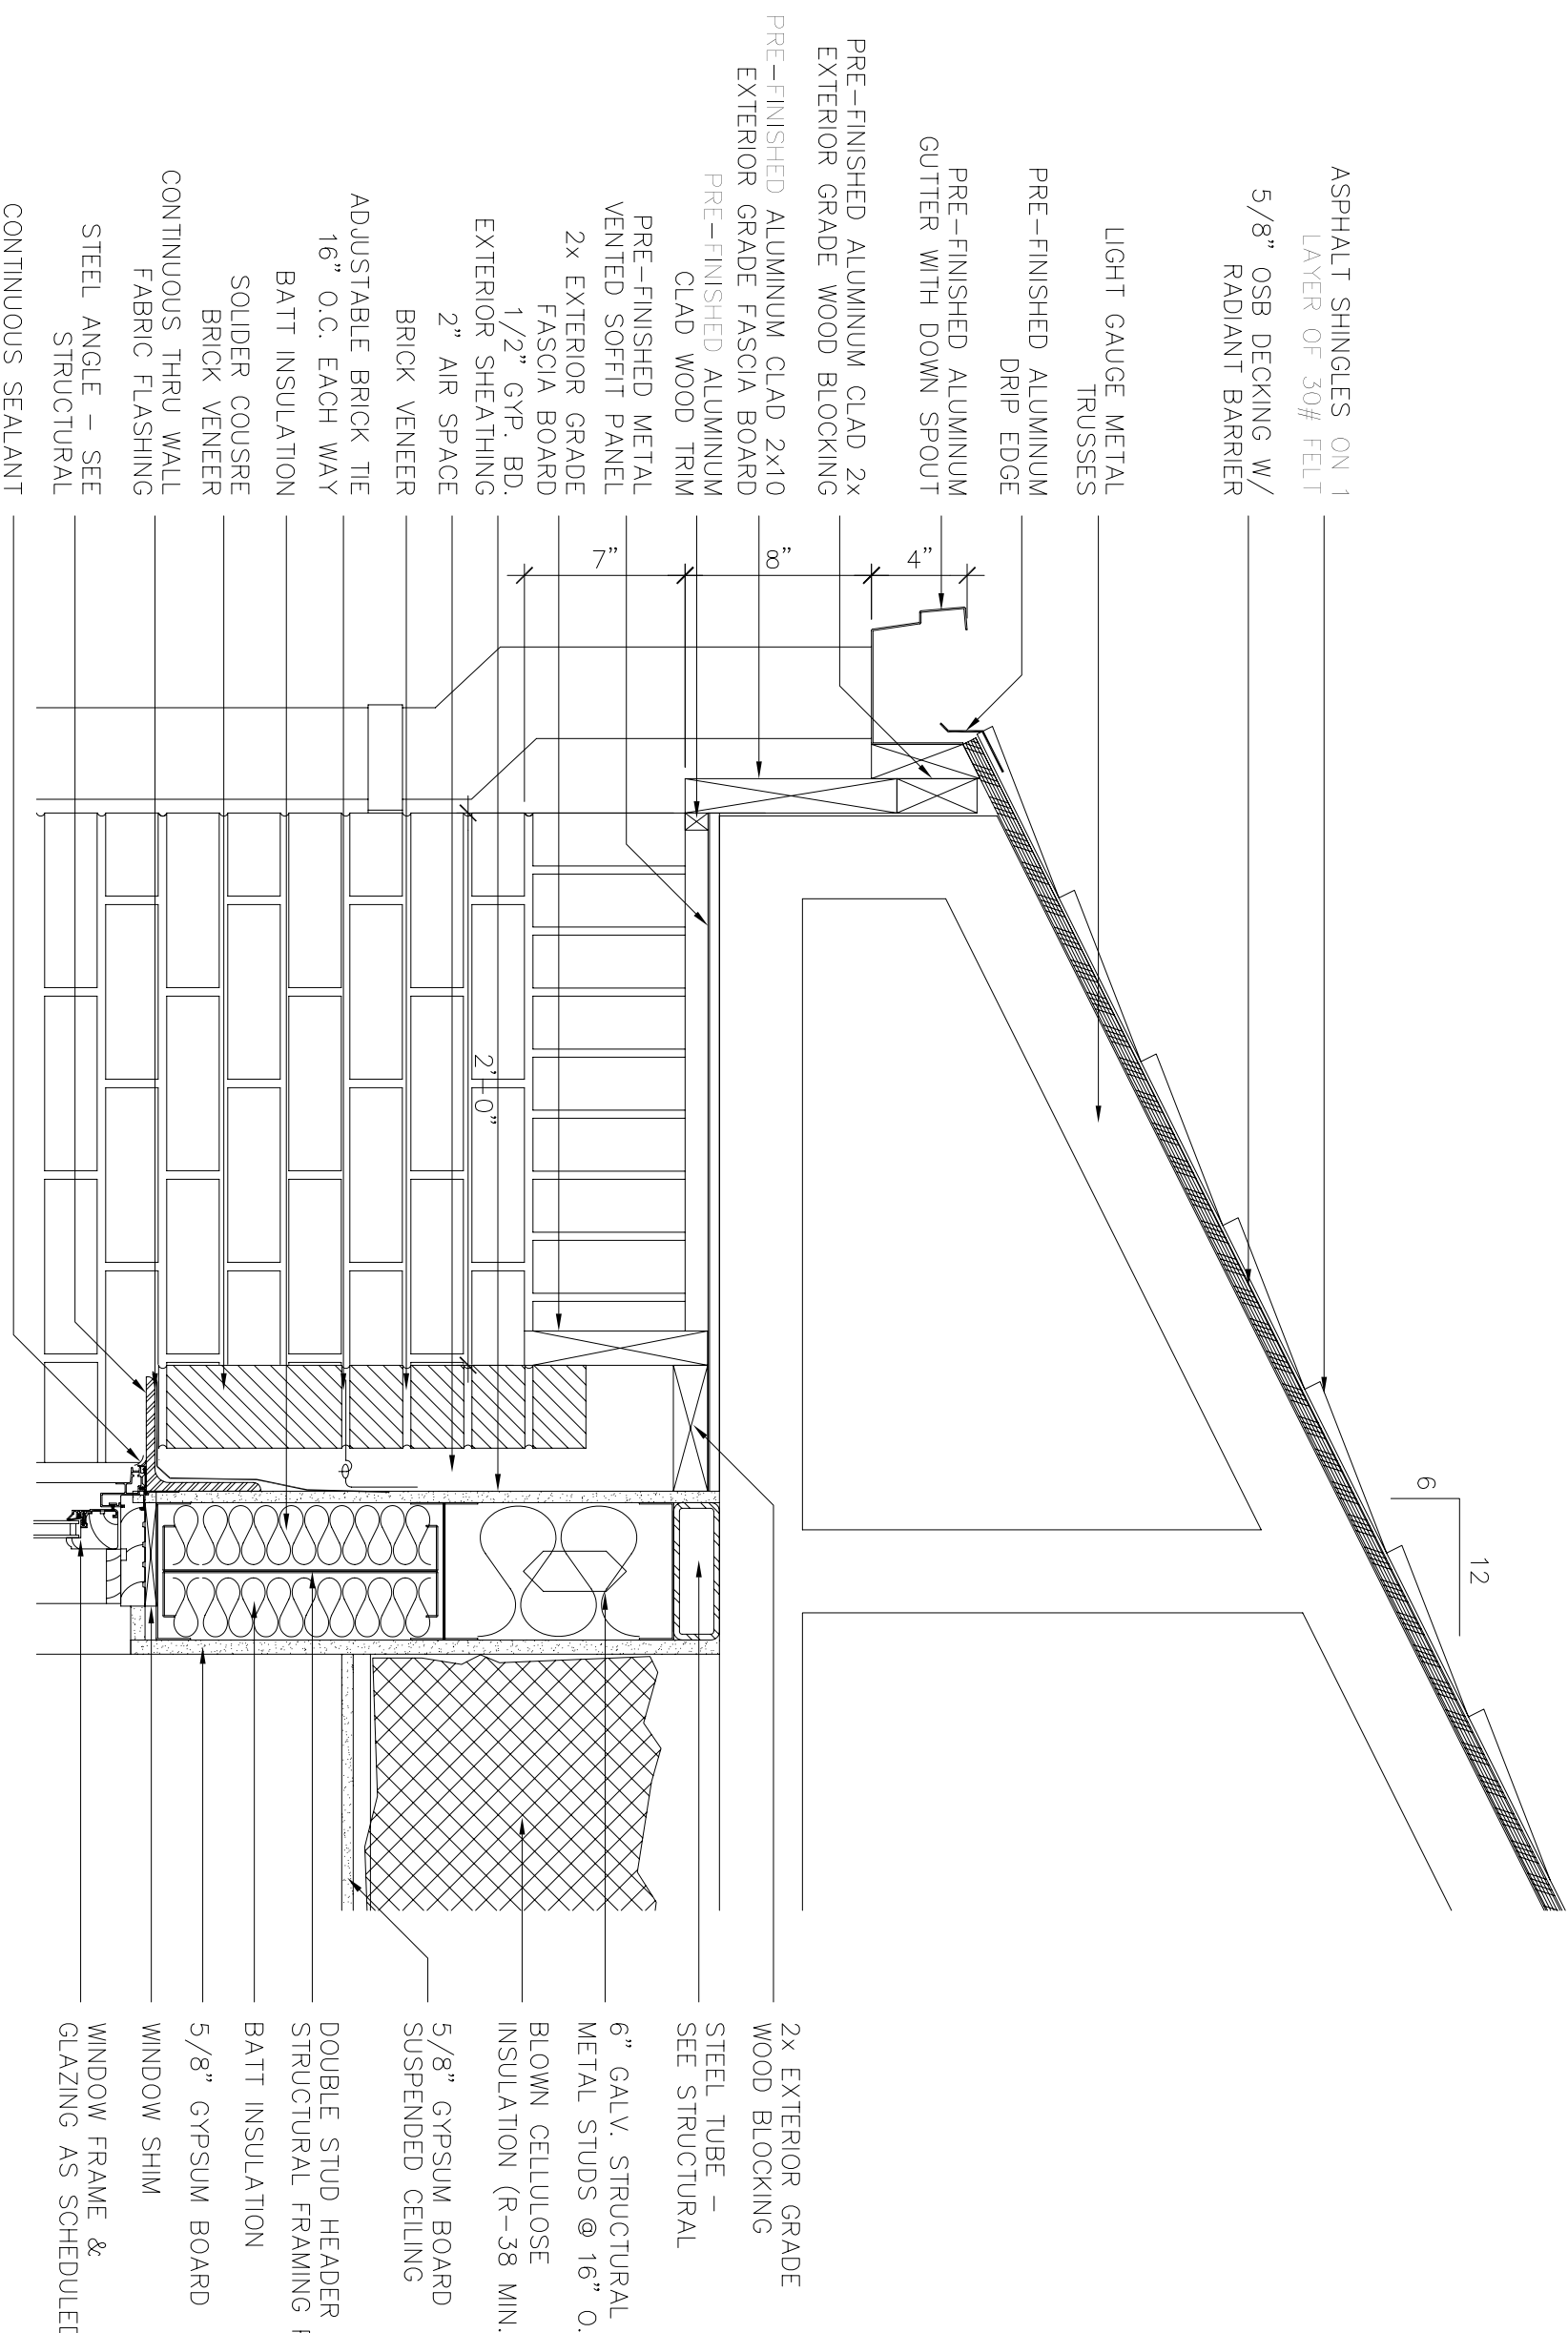

5 DETAIL AT VENT THRU ROOF
SCALE : 1-1/2"=1'-0"
RE : 1/A71


6 DETAIL AT EXHAUST FLUE
SCALE : 1-1/2"=1'-0"
RE : 1/A71

4 ROOF DETAIL
SCALE : 1-1/2"=1'-0"
RE : 2/A19 & 1/A24

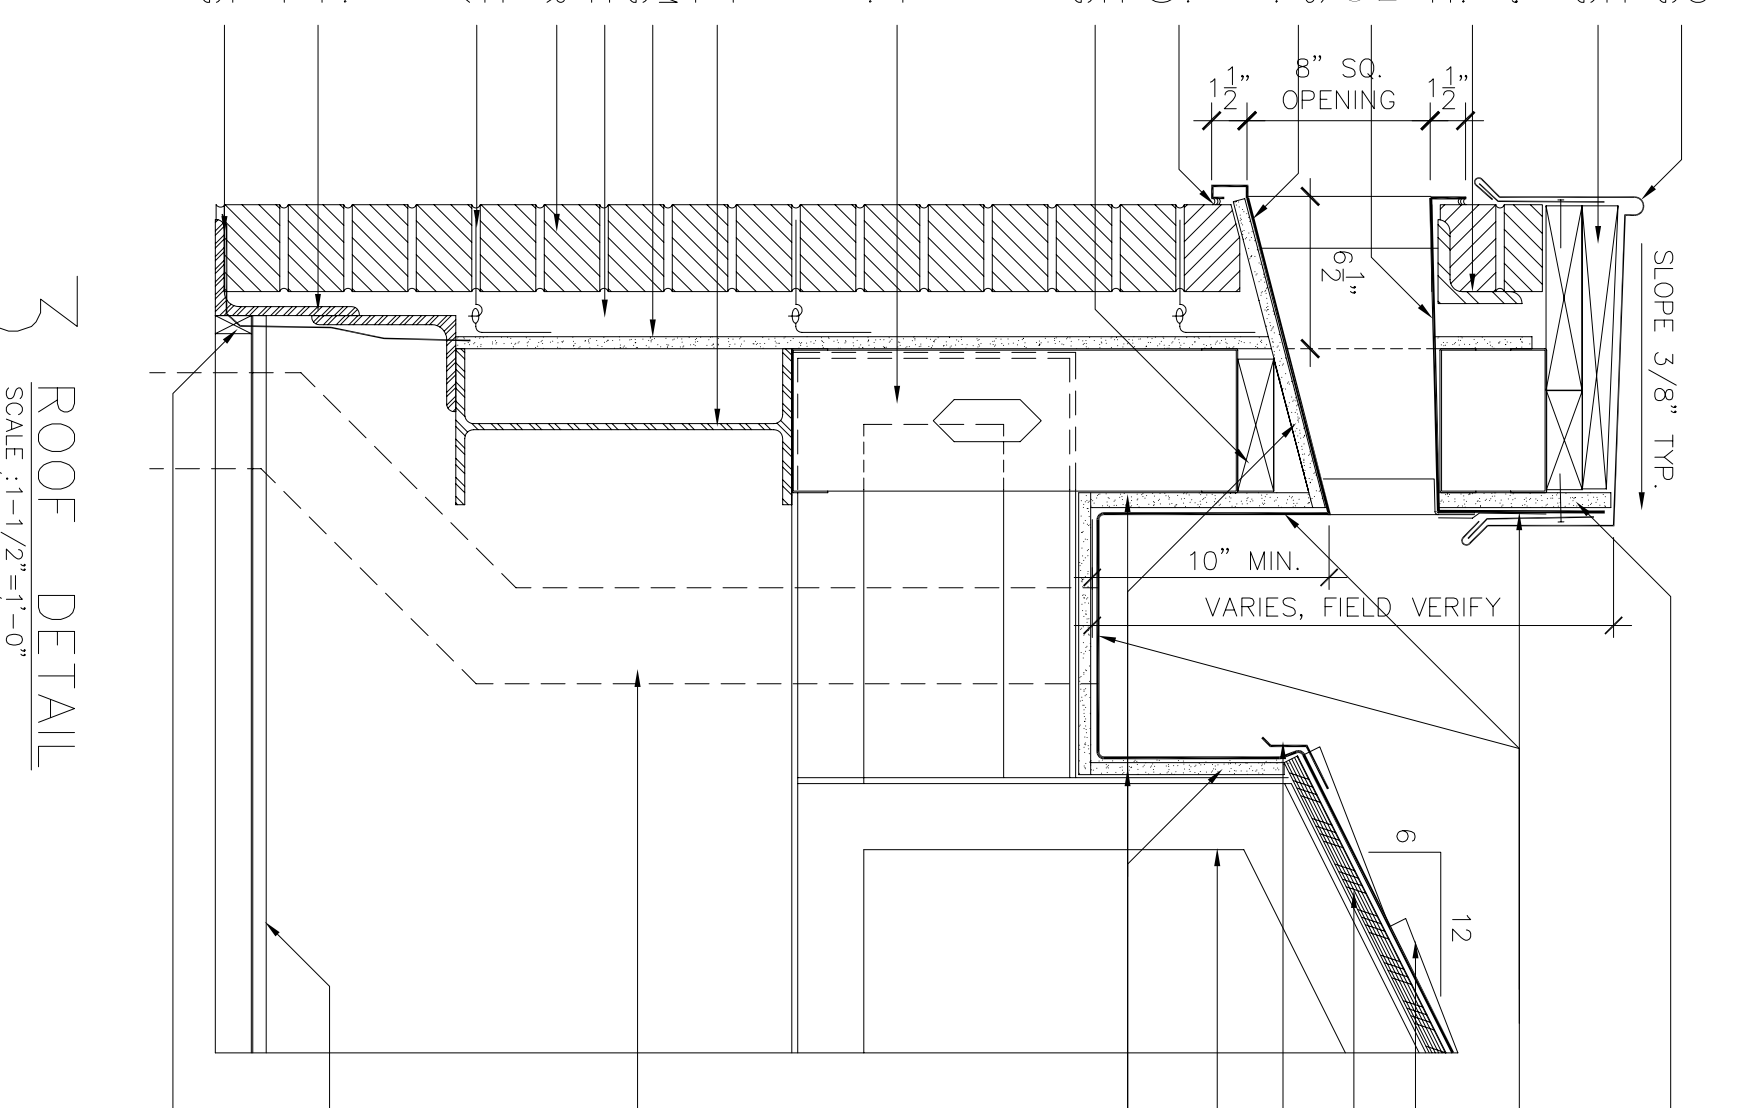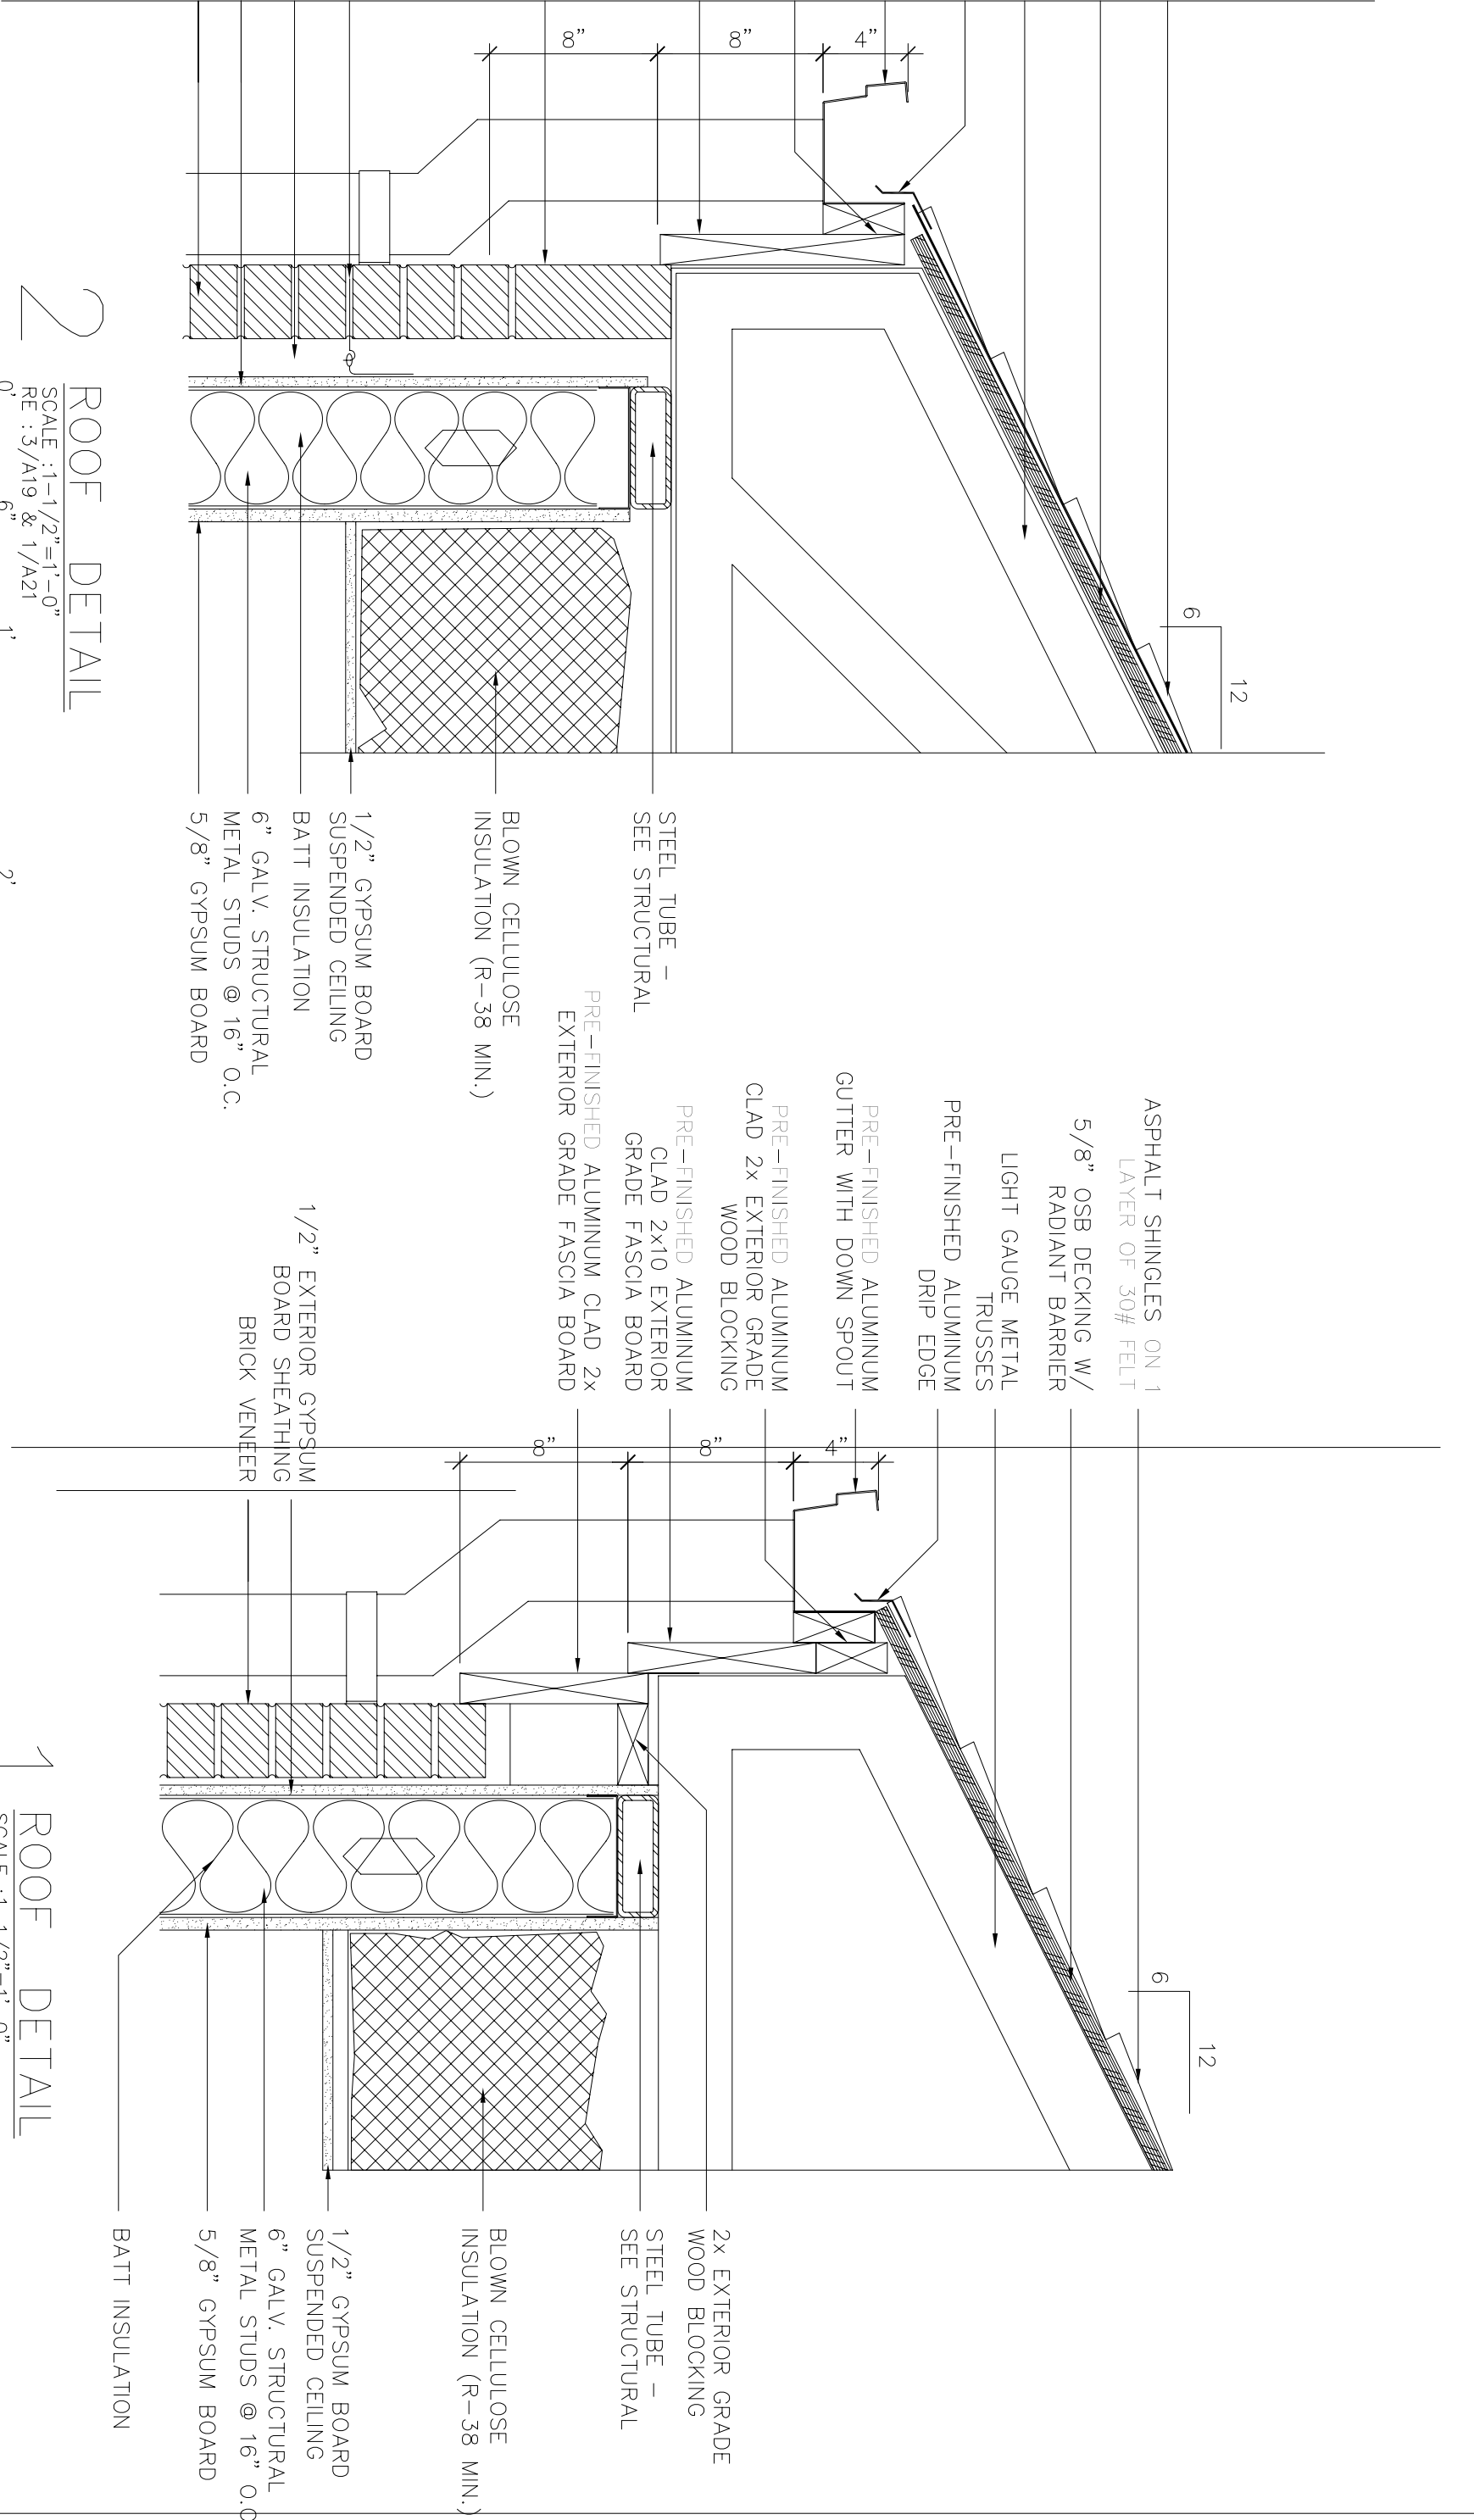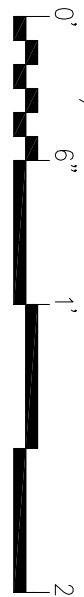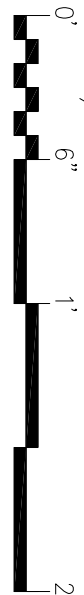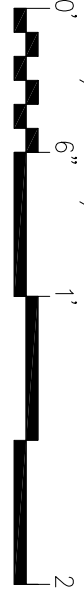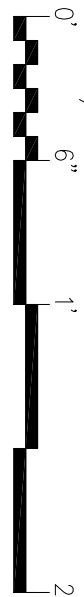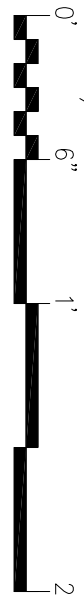

2 ROOF DETAIL
SCALE : 1-1/2"=1'-0"
RE : 3/A19 & 1/A21

3 ROOF DETAIL
SCALE : 1-1/2"=1'-0"
RE : 2/A21 & 3/A21

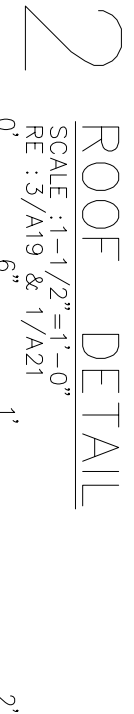

1 ROOF DETAIL
SCALE : 1-1/2"=1'-0"
RE : 3/A19

