



NOTE:


1. ALL FIELD BRICK SHALL BE ACME GARNET MODULAR SMOOTH.
2. ALL ACCENT BRICK (i.e. SOLDIER COURSES, BRICK WINDOW SILLS AND ROWLOCKS & HEADERS AROUND GABLE VENT SHALL BE ACME STEEL GRAY MODULAR VELOUR.
3. ALL 8X8X4 BRICK SHALL BE ACME STEEL GRAY TRIPLE BRICK VELOUR.

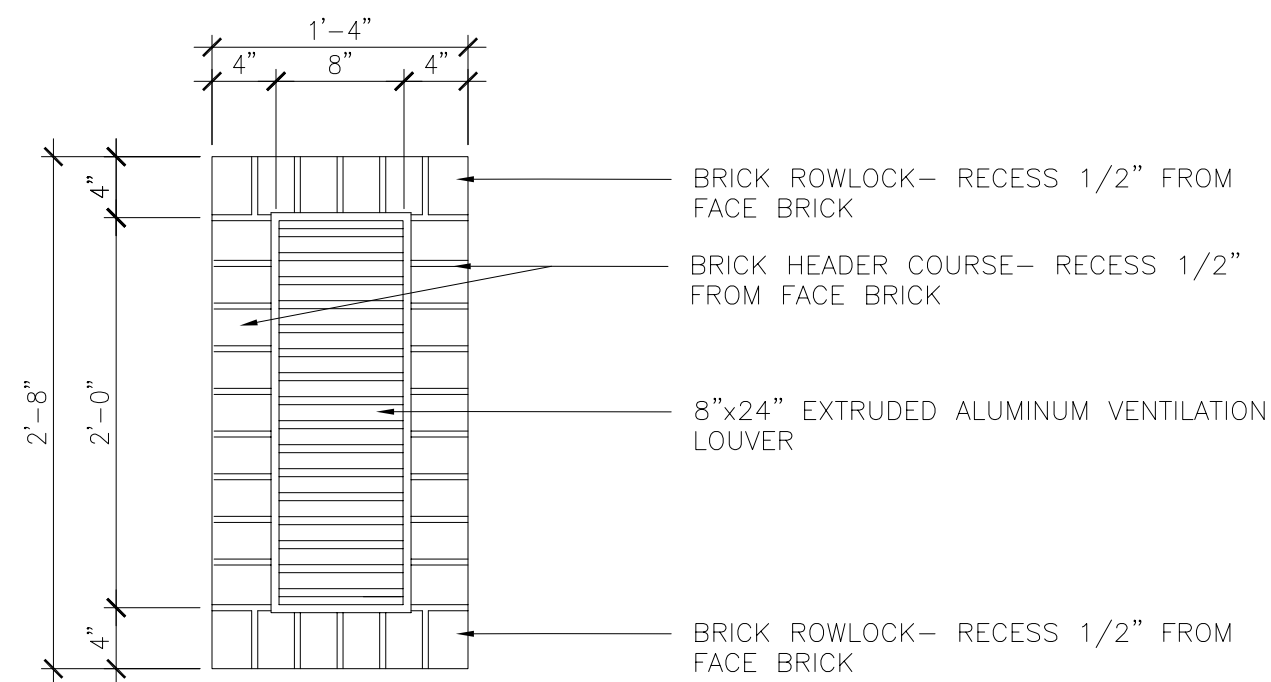


5 BRICK KEYSTONE DETAIL
SCALE : 1"=1'-0"

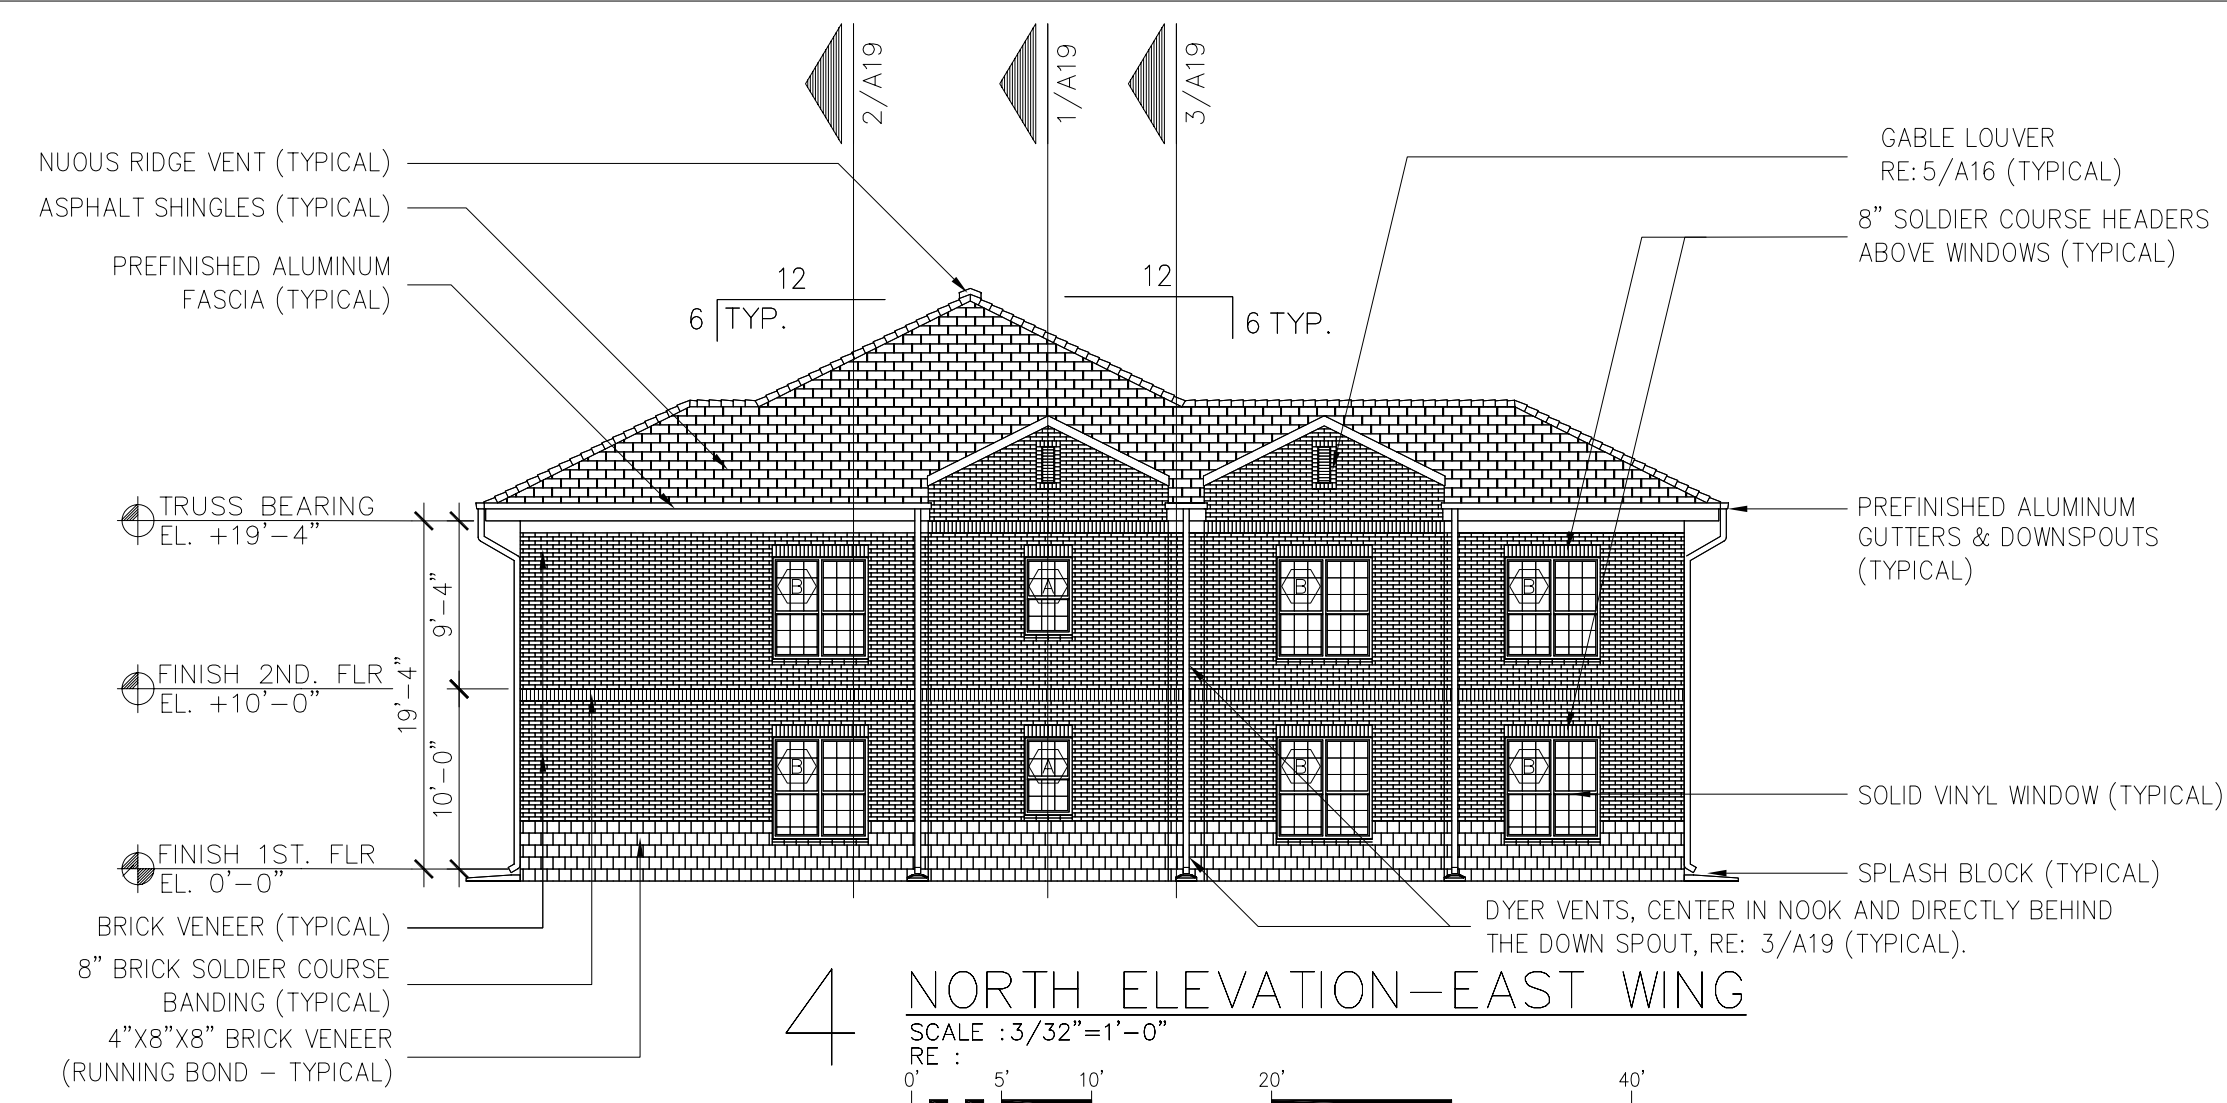


4 NORTH ELEVATION-EAST WING
SCALE : 3/32"=1'-0"

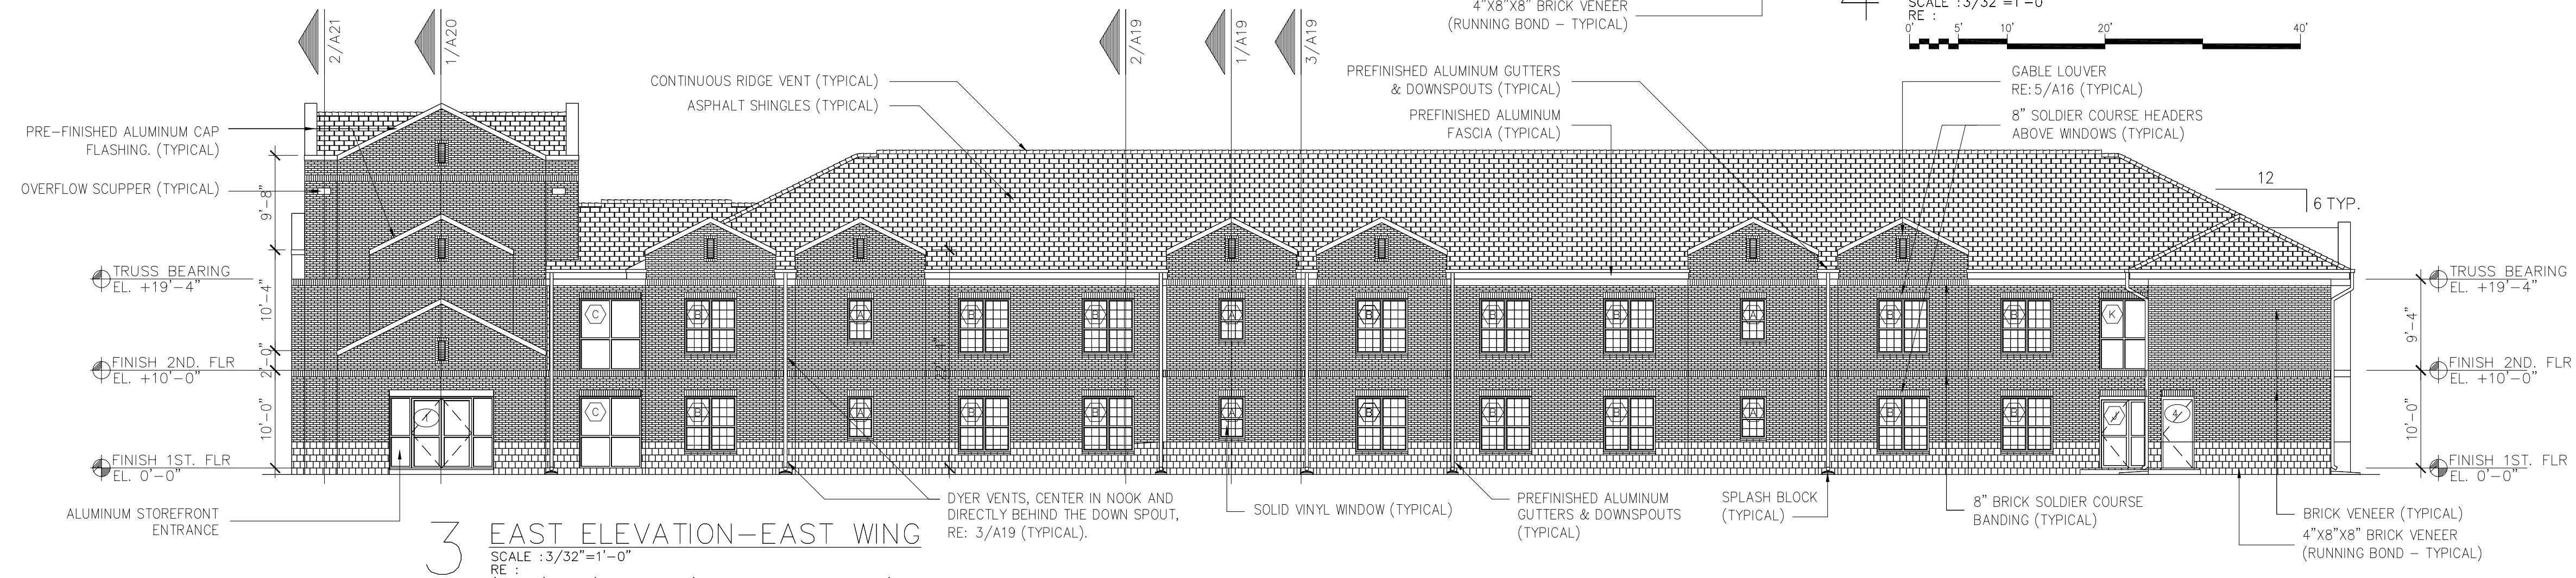

3 EAST ELEVATION-EAST WING
SCALE : 3/32"=1'-0"

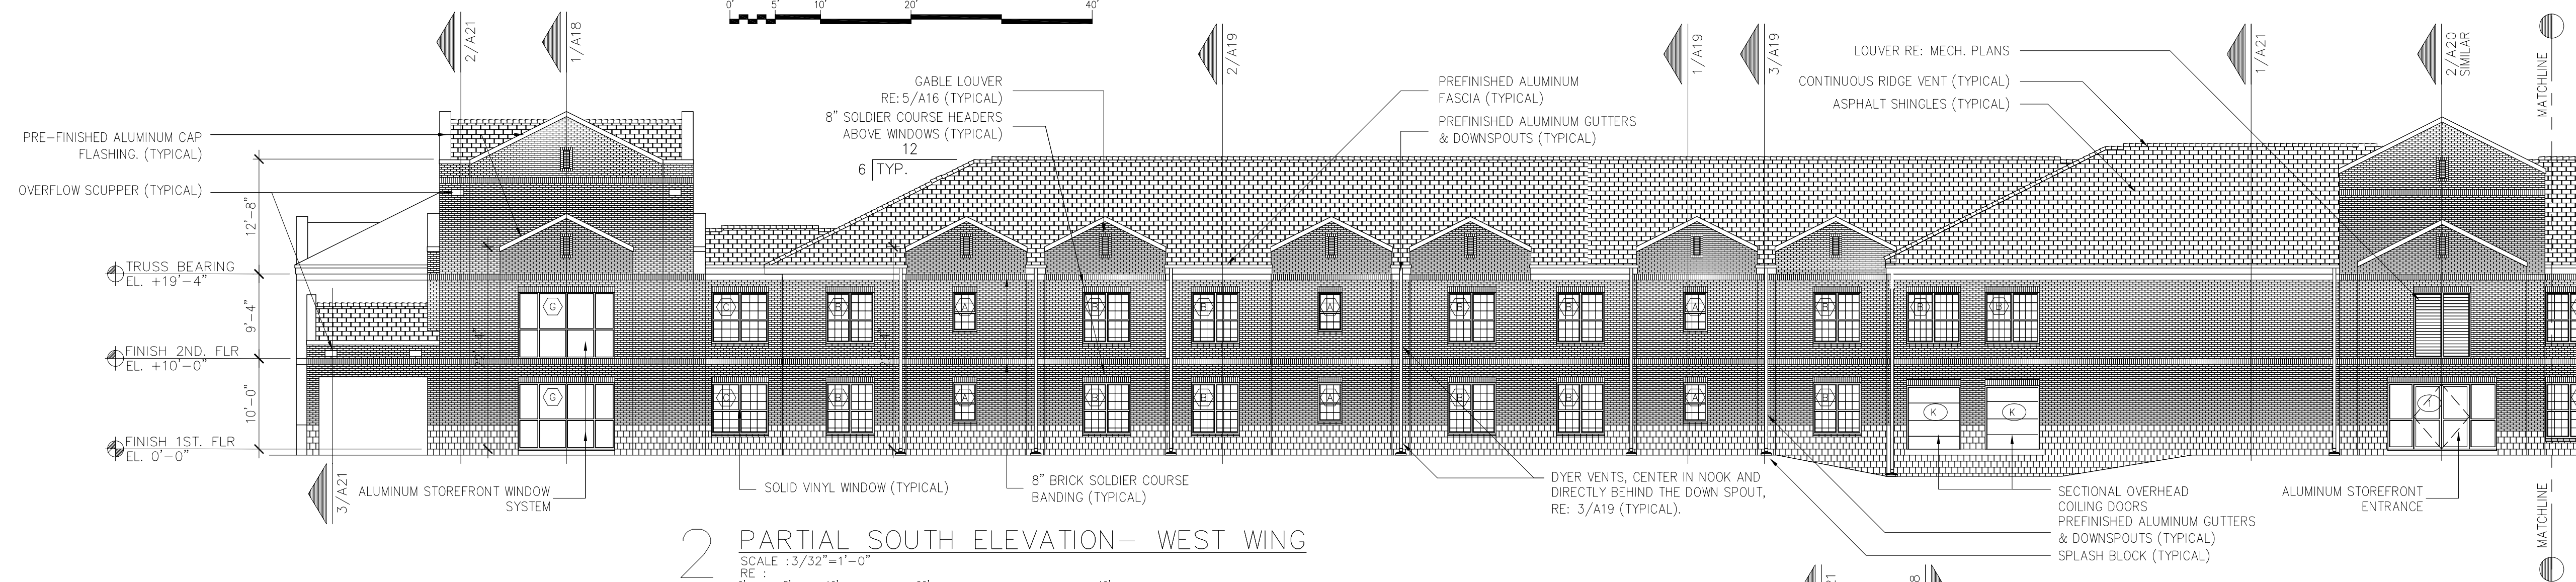

2 PARTIAL SOUTH ELEVATION- WEST WING
SCALE : 3/32"=1'-0"

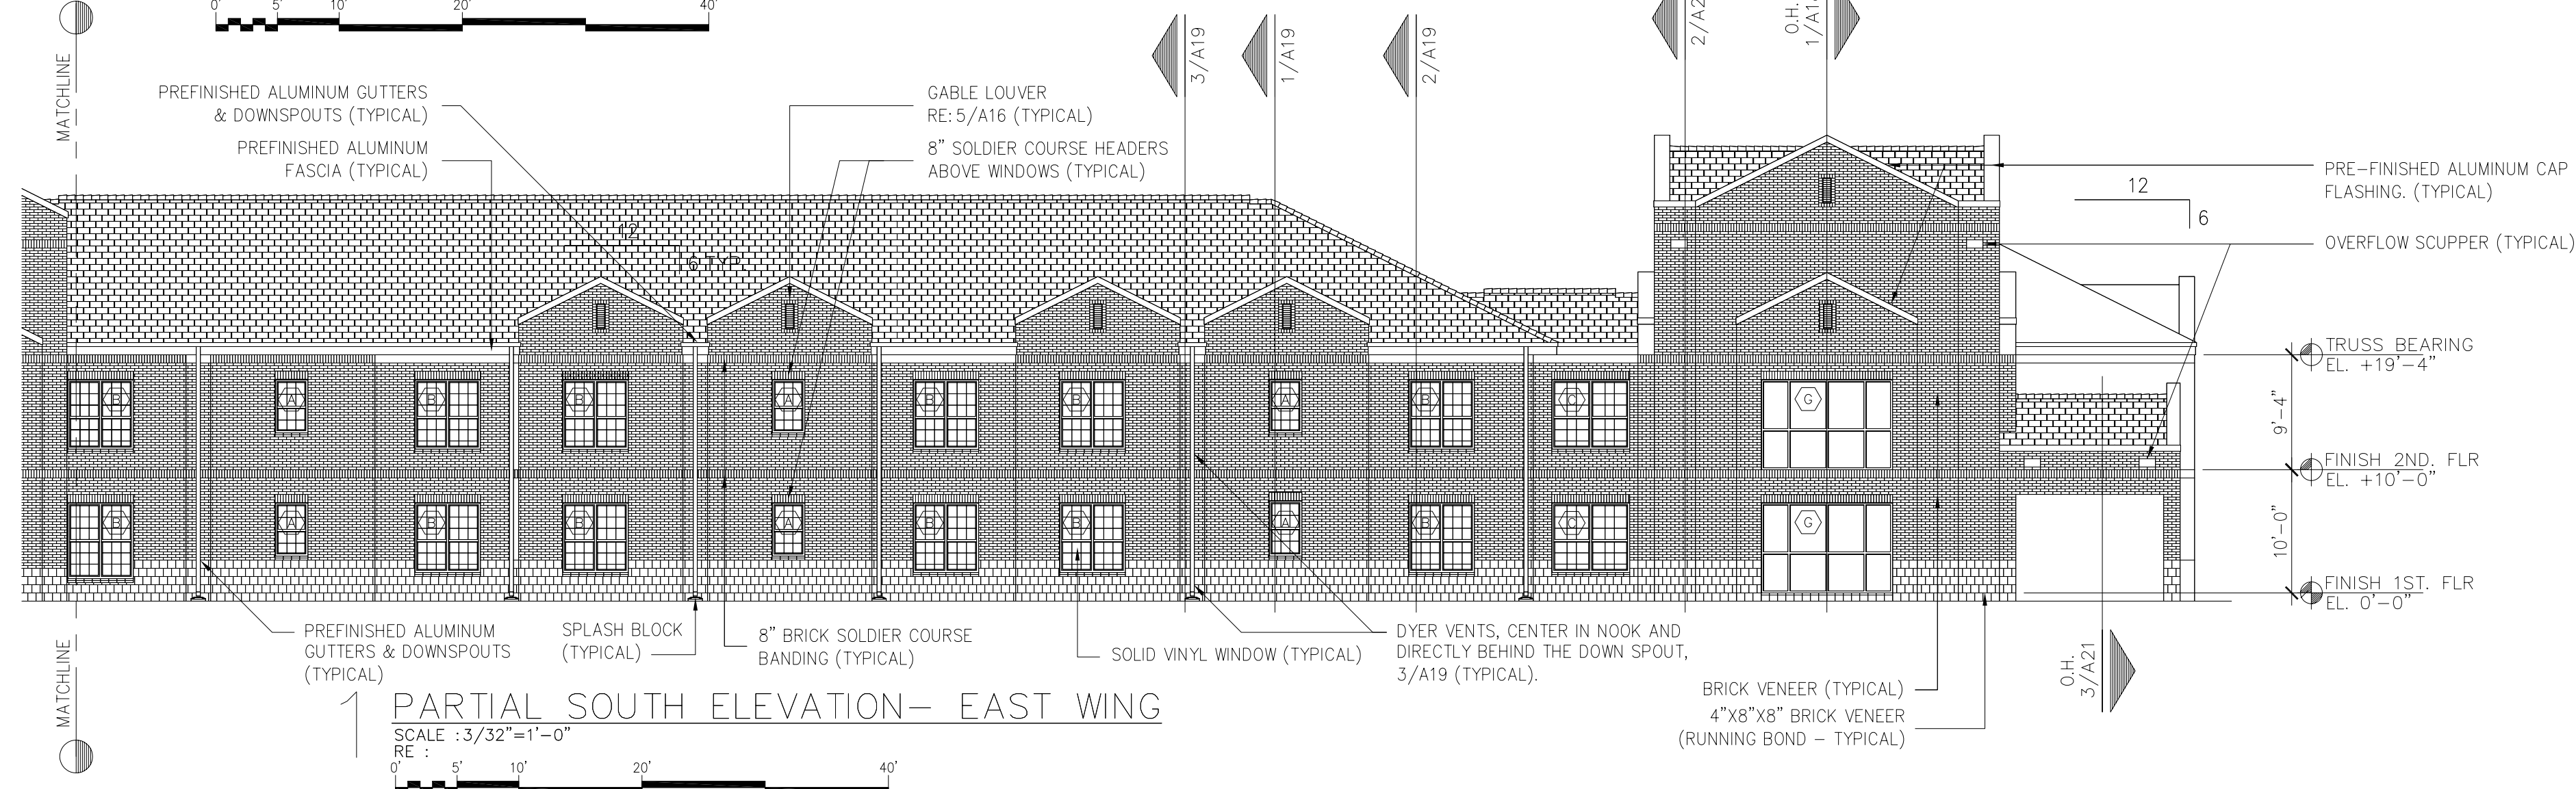

1 PARTIAL SOUTH ELEVATION- EAST WING
SCALE : 3/32"=1'-0"



LITTLE ROCK A.F.B.
ARKANSAS

No.	Revision/Issue	Date	BY	APP'D
1	No changes from Design to As-Built			

PROJECT TITLE
TEMPORARY LODGING
FACILITY

SHEET TITLE
BUILDING
ELEVATIONS
AS-BUILT

DRAWN BY RL	LEAD DESIGNER BG
TECH REVIEWER	FILE LOCATION
DESIGNED BY BG	PROJECT NUMBER NKAK02-5001
DATE 28 MAY 2002	SHEET A16
SCALE 3/32"=1'-0"	25 of 108