


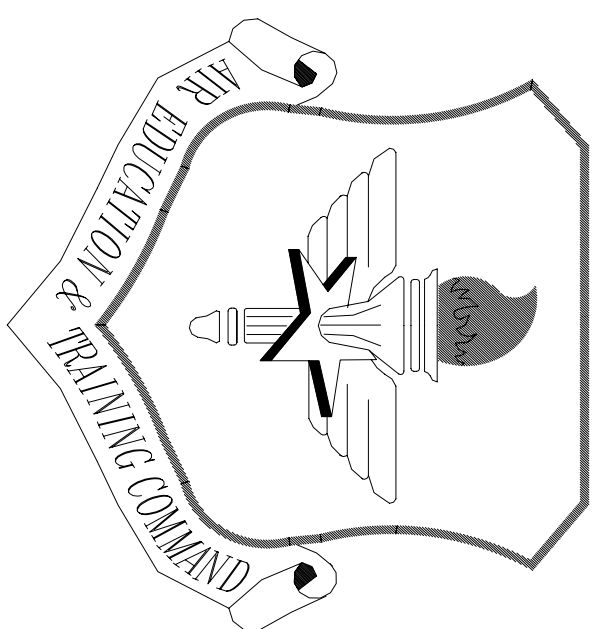

LITTLE ROCK A.F.B.
ARKANSAS

No.	Revision/Issue	Date	BY	APP'D
1	No changes from Design to As-Built			

PROJECT TITLE
TEMPORARY LODGING
FACILITY

SHEET TITLE
BUILDING SECTION
AT END TOWERS
AS-BUILT

DESIGNED BY BG	FILE LOCATION	LEAD DESIGNER BG
DATE 28 MAY 2002	PROJECT NUMBER NKA02-5001	
SCALE 1/2"=1'-0"	SHEET 27 of 108	A18

