


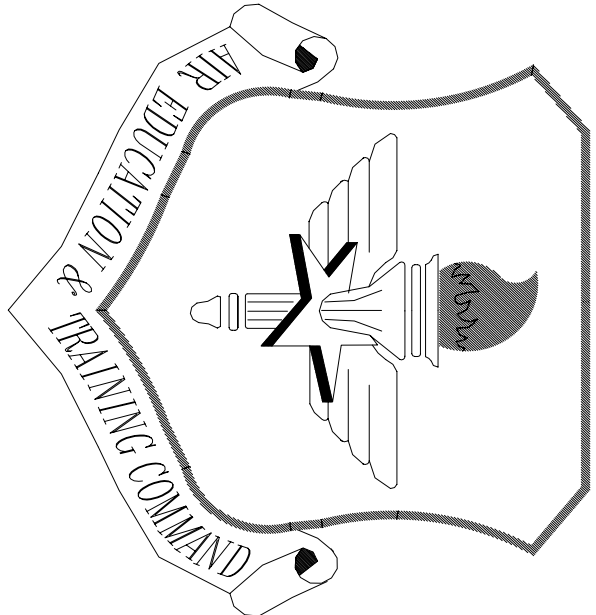


LITTLE ROCK A.F.B.
ARKANSAS

APP'D	BY	Date	Revision/Issue
			1 No changes from Design to As-Built
No.			

TEMPORARY LODGING
FACILITY

SHEET TITLE
WALL SECTIONS
AS-BUILT

DESIGNED BY BG	FILE LOCATION	LEAD DESIGNER BG
PROJECT NUMBER NKAHQ2-5001		
DATE 28 MAY 2002	SHEET 28 OF 108	A19
SCALE 3/4"=1'-0"		

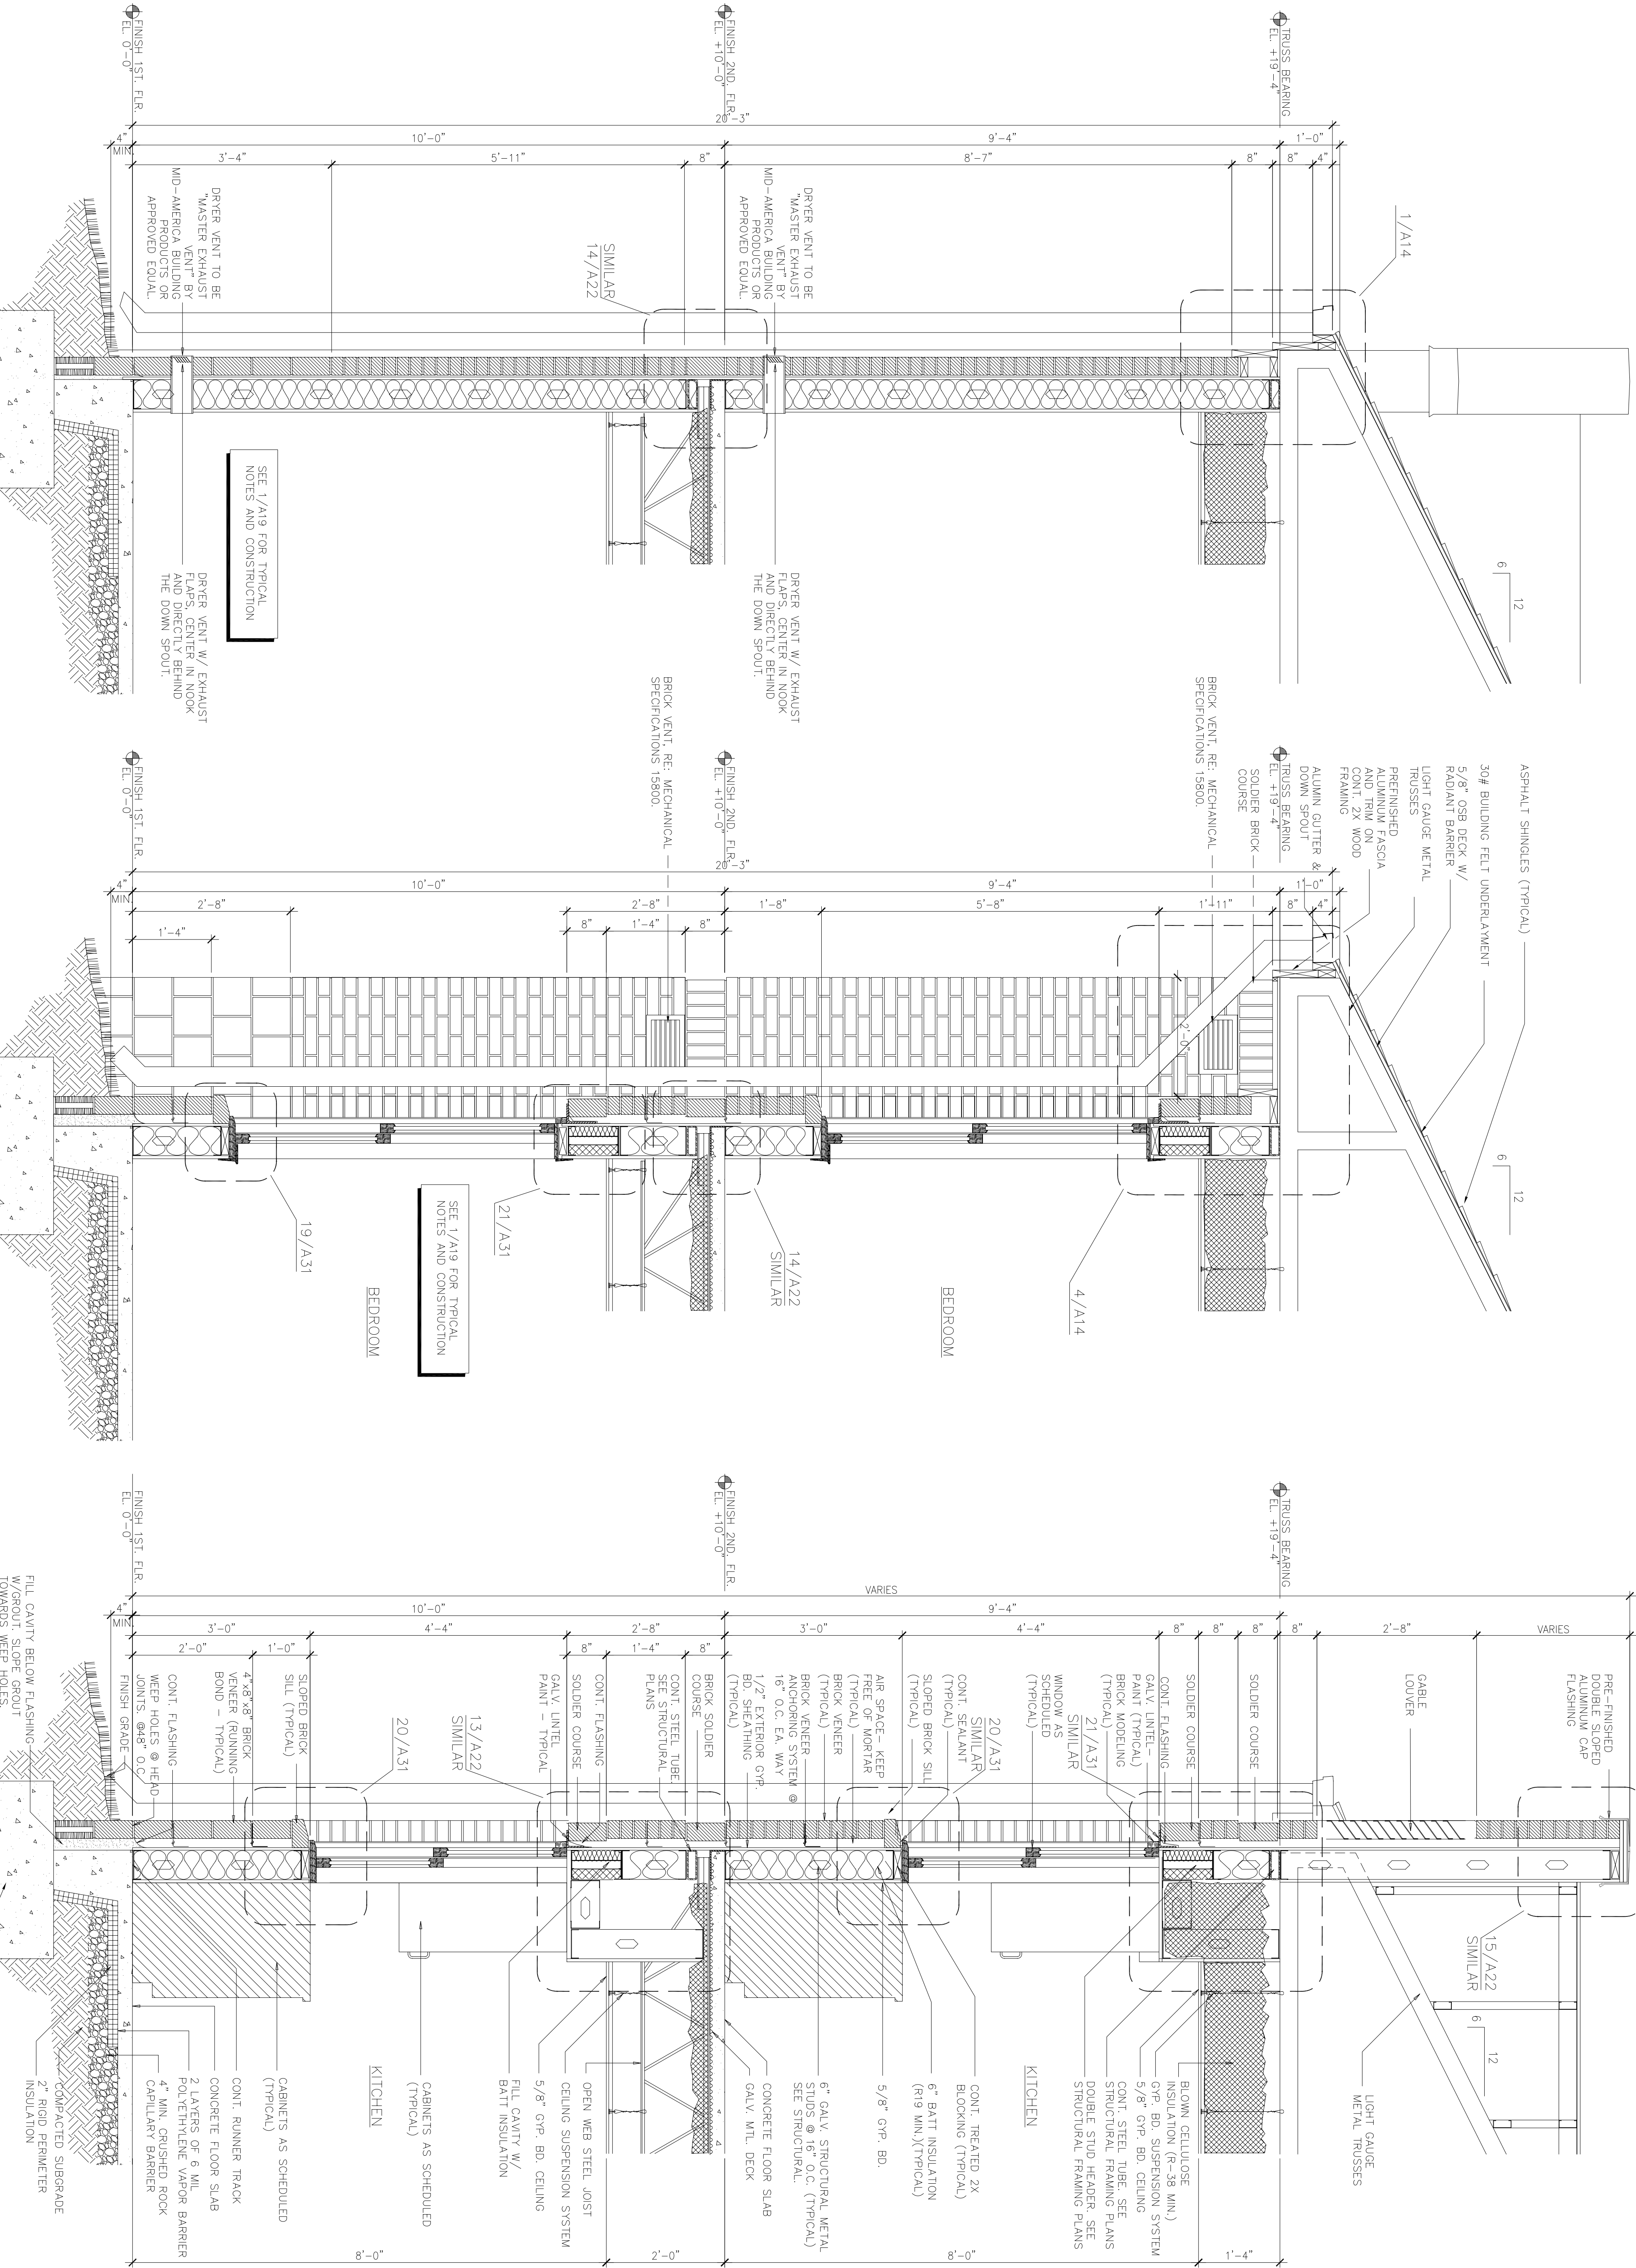

3 WALL SECTION
SCALE: 3/4"=1'-0"
0' 1' 2' 4'

2 WALL SECTION
SCALE: 3/4"=1'-0"
0' 1' 2' 4'

1 WALL SECTION
SCALE: 3/4"=1'-0"
0' 1' 2' 4'