


LITTLE ROCK A.F.B.
ARKANSAS

| No. | Revision/Issue | Date | BY | APP'D |
|-----|------------------------------------|------|----|-------|
| 1 | No changes from Design to As-Built | | | |


PROJECT TITLE
TEMPORARY LODGING
FACILITY

SHEET TITLE
WALL SECTIONS
AS-BUILT


| | |
|---------------------|-------------------------------|
| DRAWN BY RL | LEAD DESIGNER BG |
| TECH REVIEWER | FILE LOCATION |
| DESIGNED BY BG | PROJECT NUMBER NKAHQ2-5001 |
| DATE 28 MAY 2002 | SHEET A20 |
| SCALE 1/2"=1'-0" | 29 of 108 |

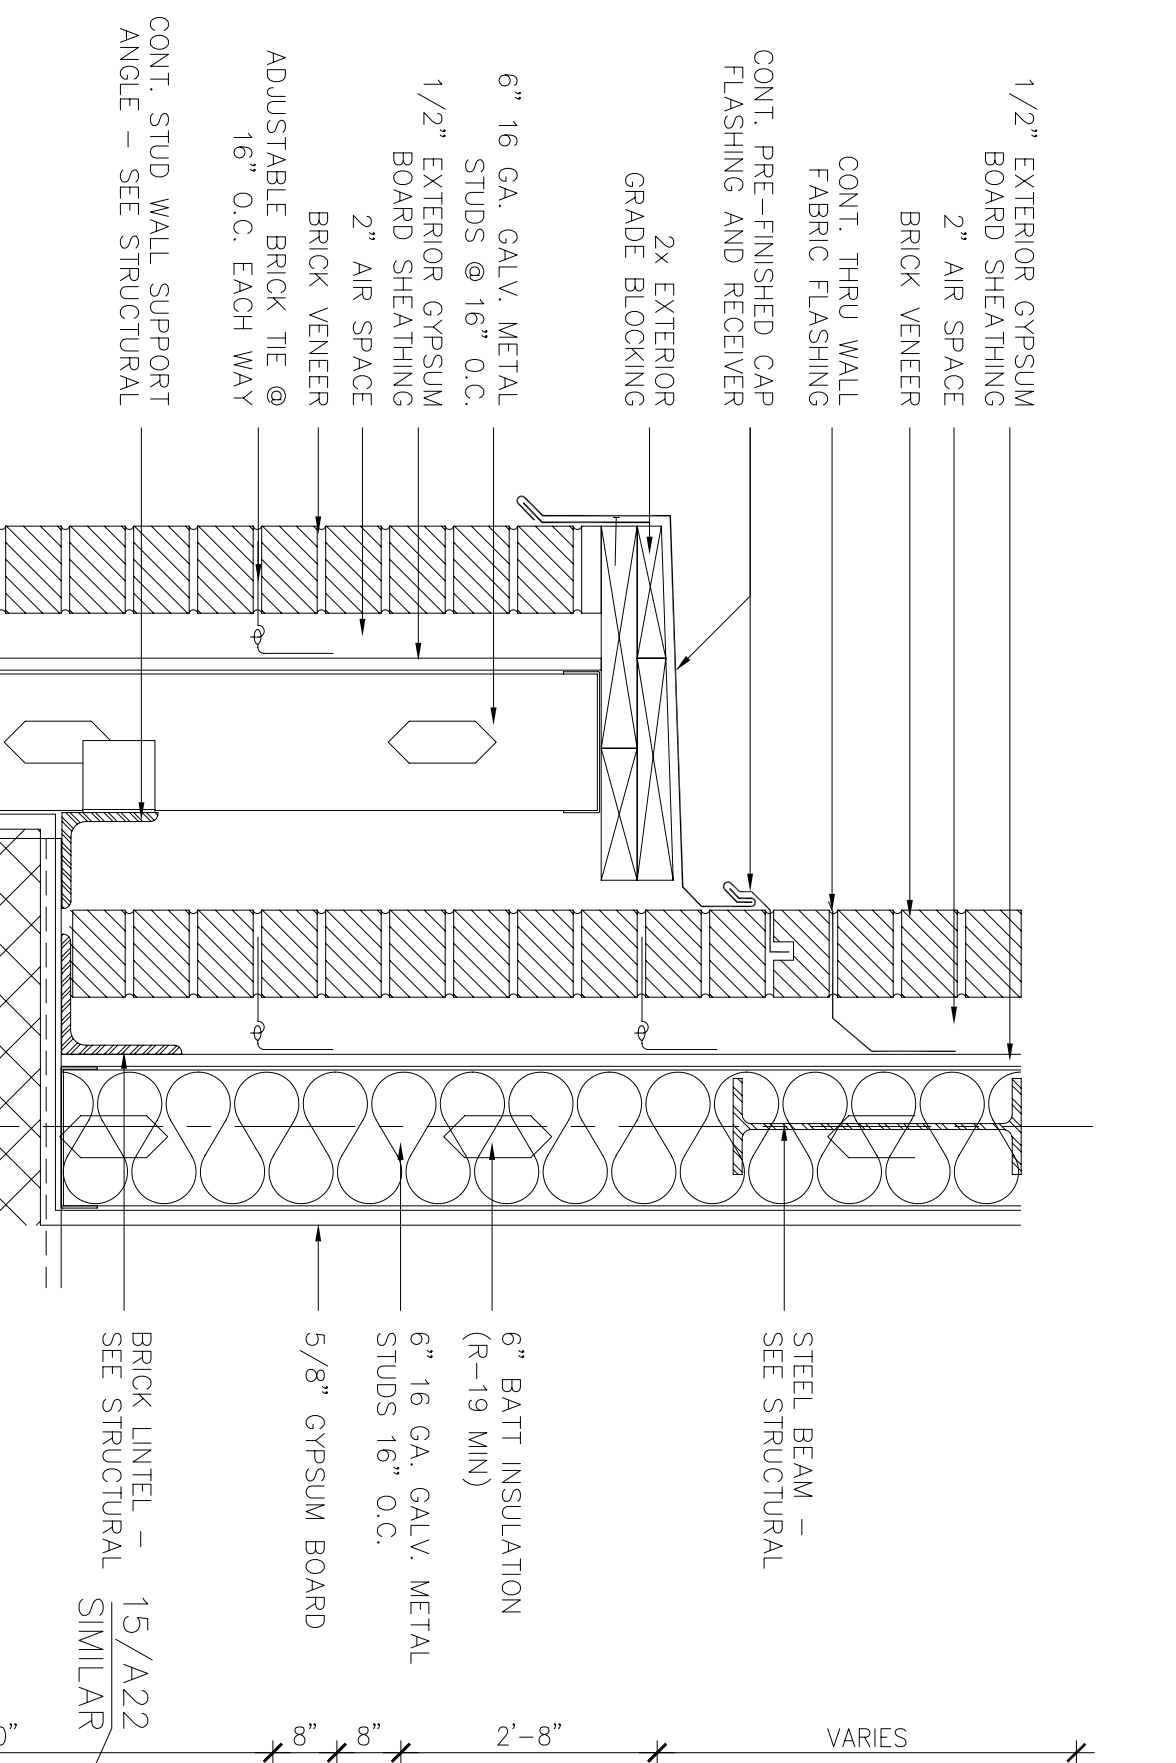


3 ENLARGED DETAIL
SCALE: 1/2"=1'-0"
RE: 1/A18 & 1/A20

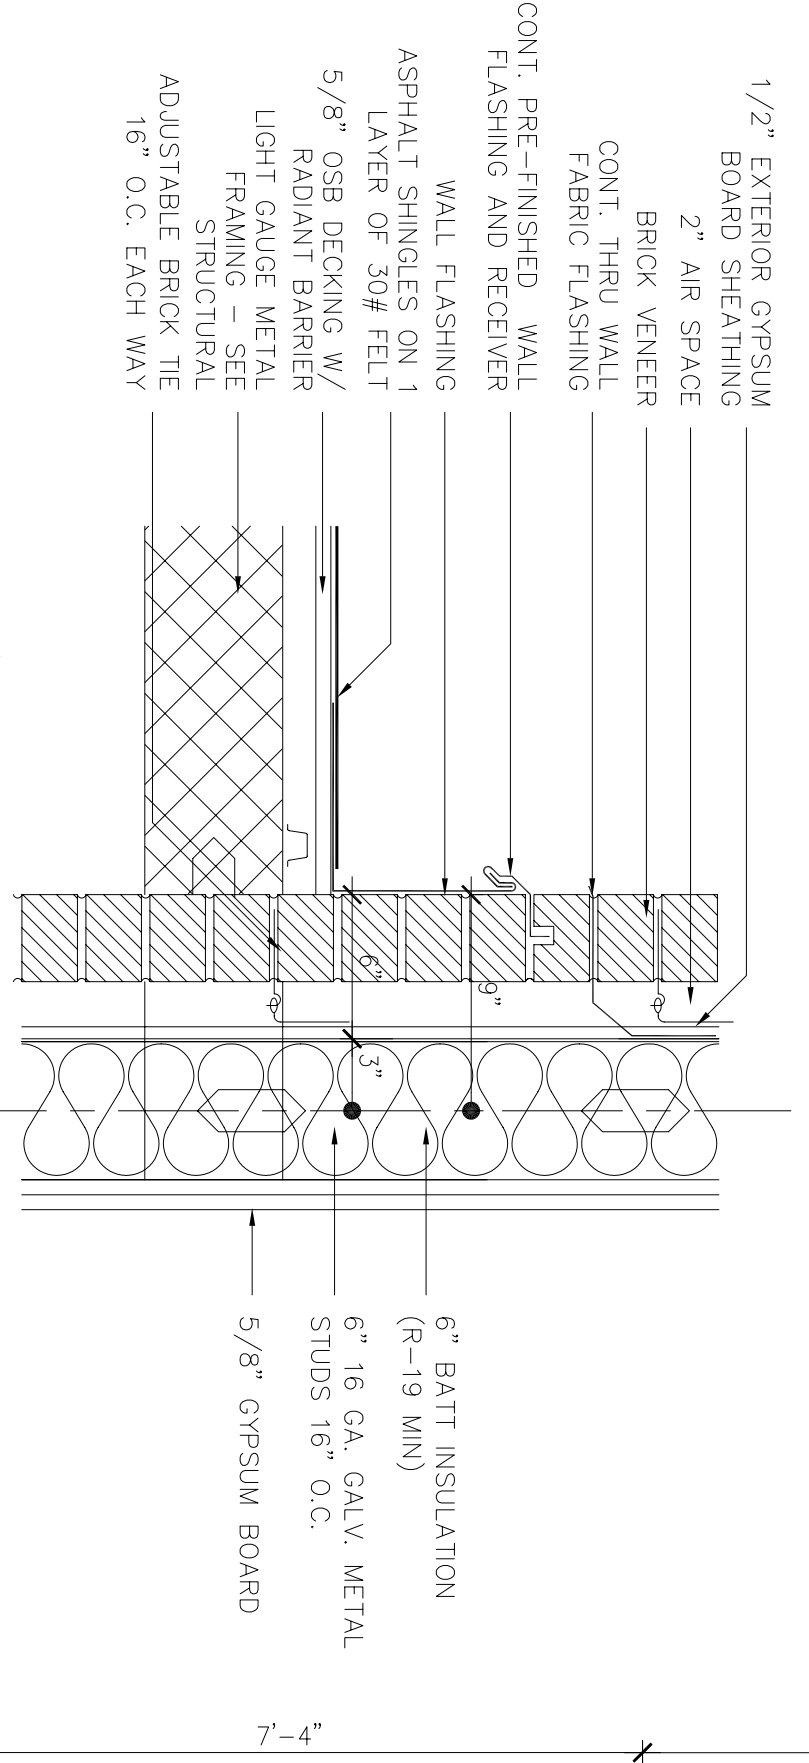


4 ENLARGED DETAIL
SCALE: 1/2"=1'-0"
RE: 1/A18 & 1/A20

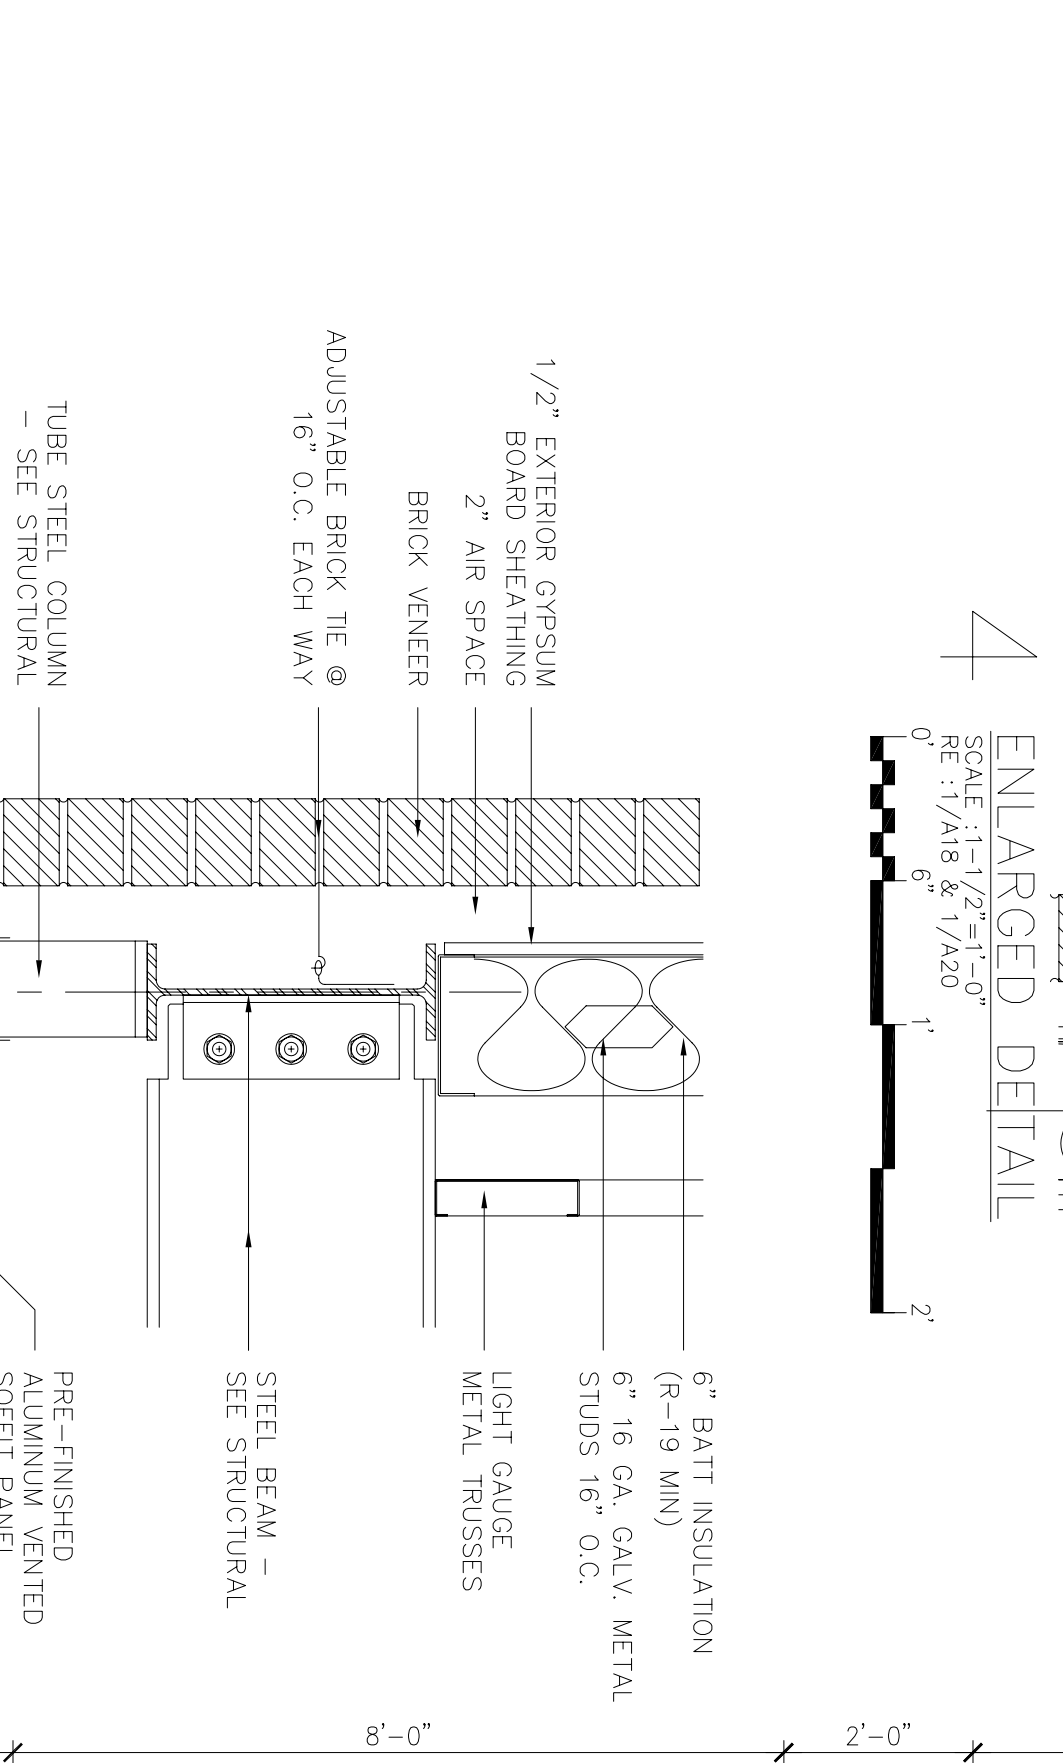


5 DETAIL
SCALE: 1/2"=1'-0"
RE: 1/A20

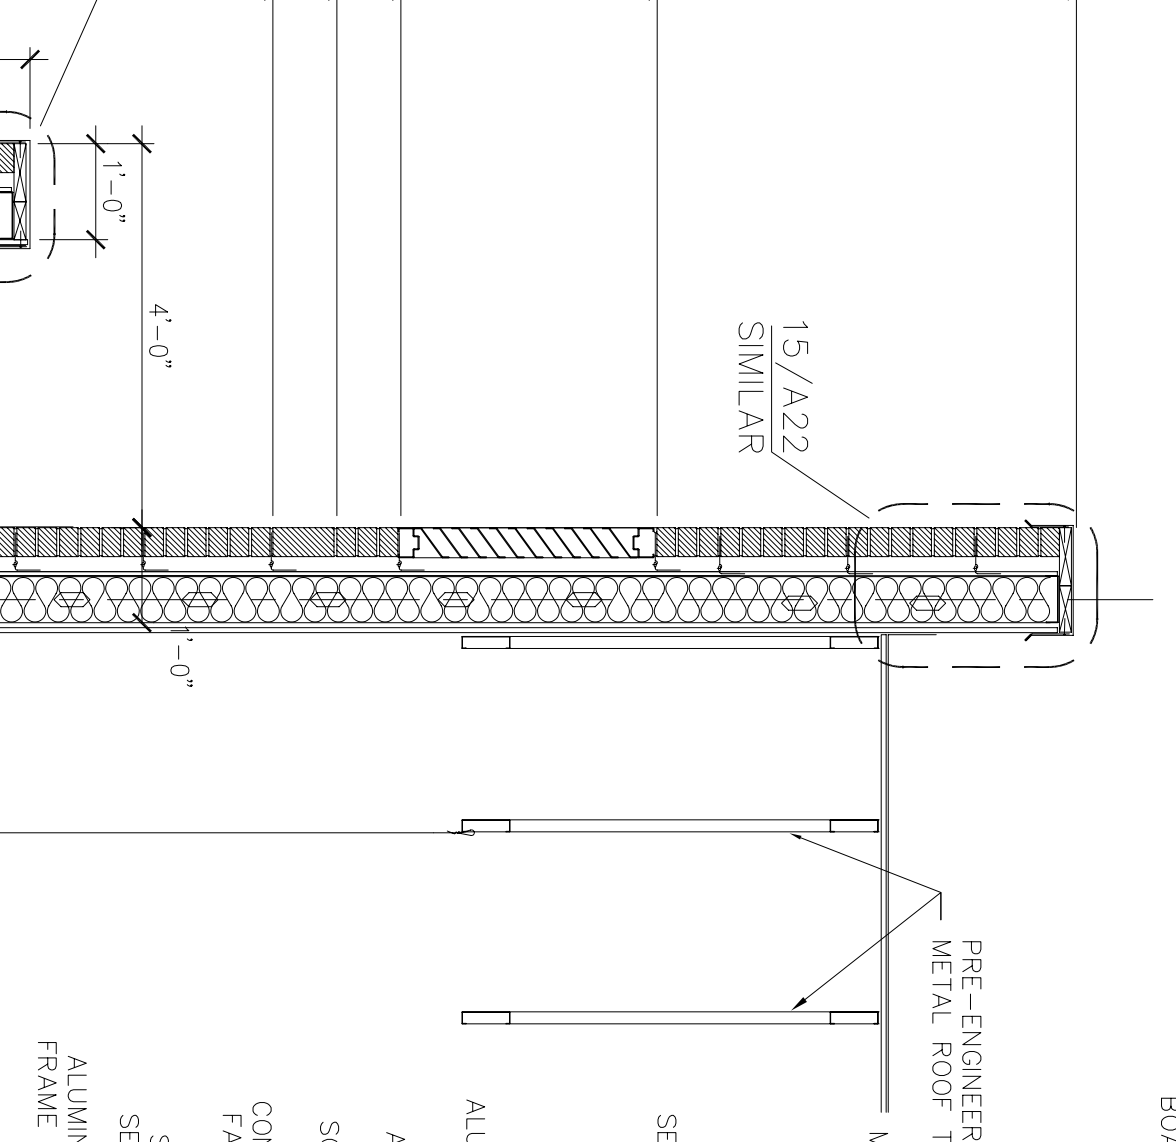

2 WALL SECTION
SCALE: 1/2"=1'-0"

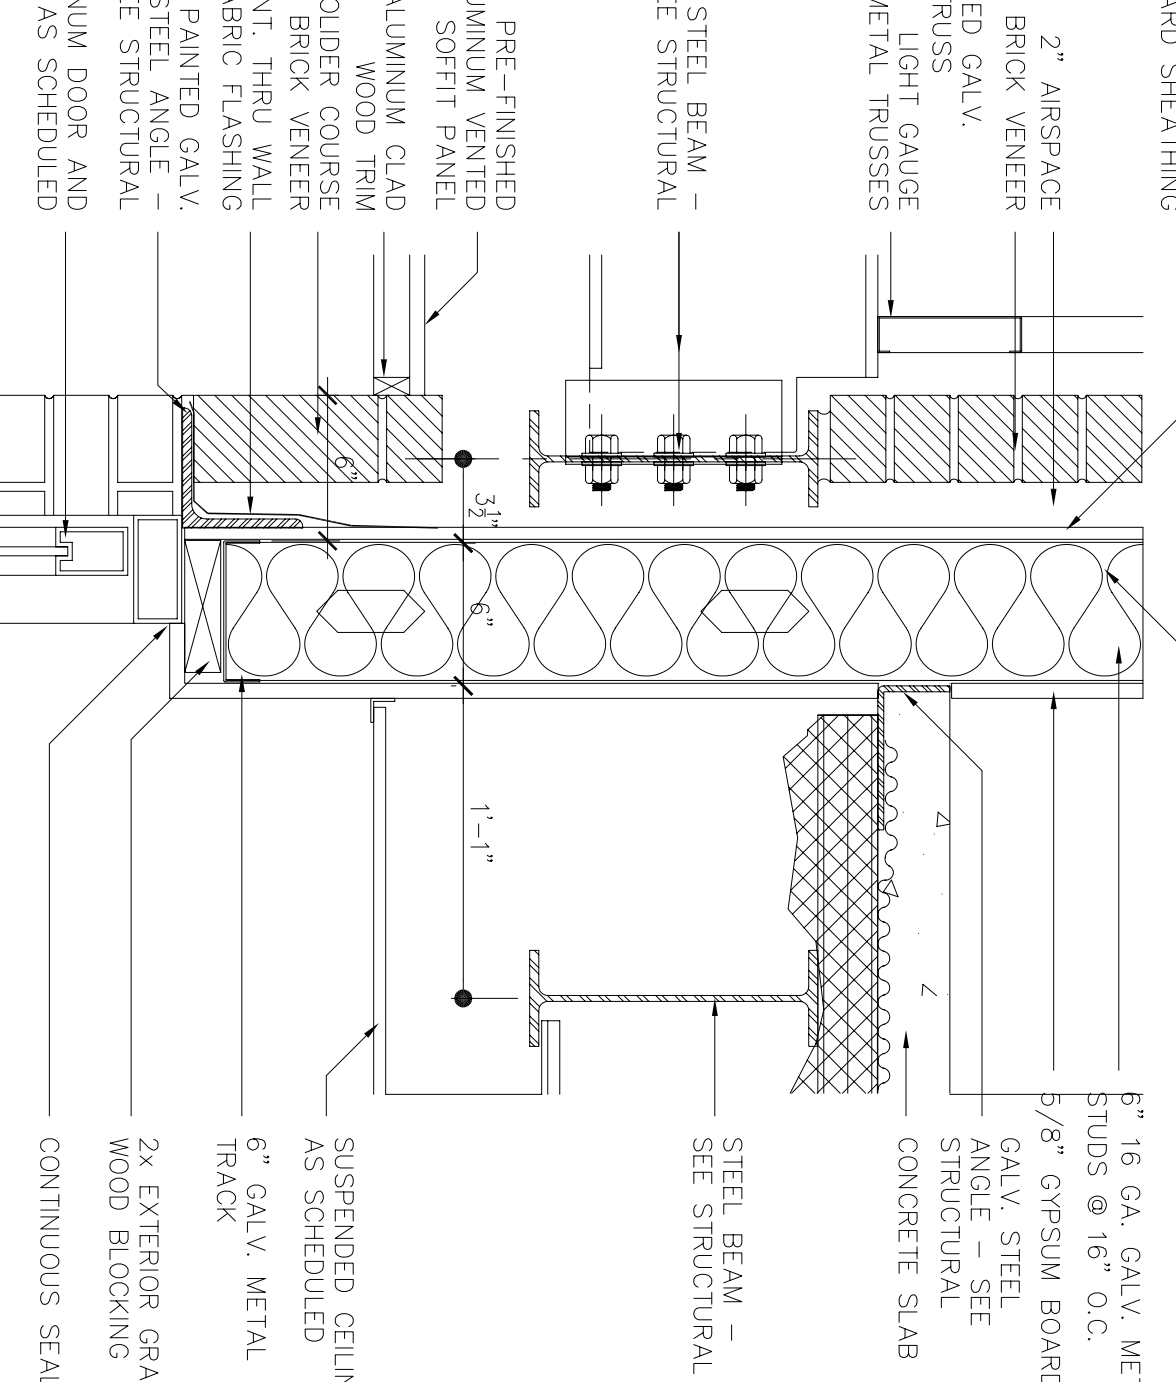

6 ENLARGED DETAIL
SCALE: 1/2"=1'-0"
RE: 1/A20

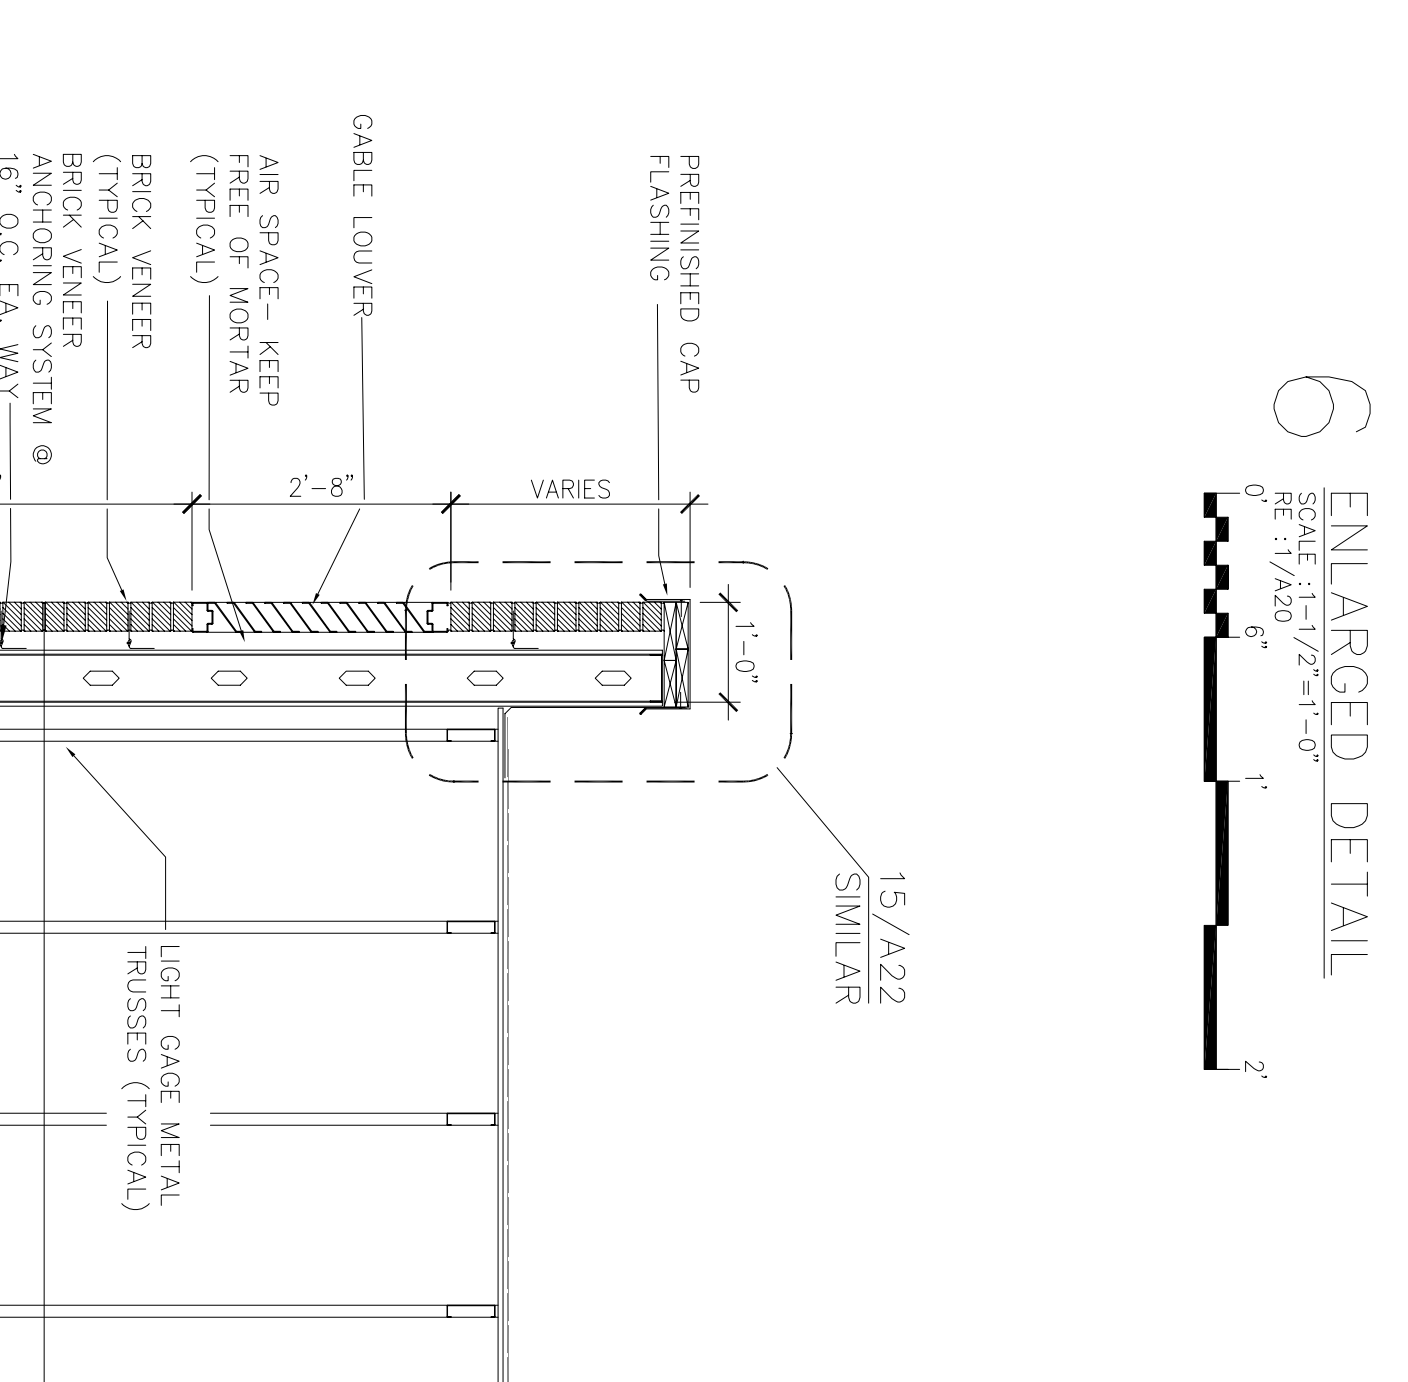

1 WALL SECTION
SCALE: 1/2"=1'-0"