





LITTLE ROCK A.F.B.
ARKANSAS

No.	Revision/Issue	Date	BY	APP'D
1	No changes from Design to As-Built			

PROJECT TITLE
TEMPORARY LODGING FACILITY

SHEET TITLE
WALL SECTIONS AS-BUILT

DESIGNED BY BG	PROJECT NUMBER NKA02-5001
DATE 28 MAY 2002	SHEET A21
SCALE 1/2"=1'-0"	30 OF 108

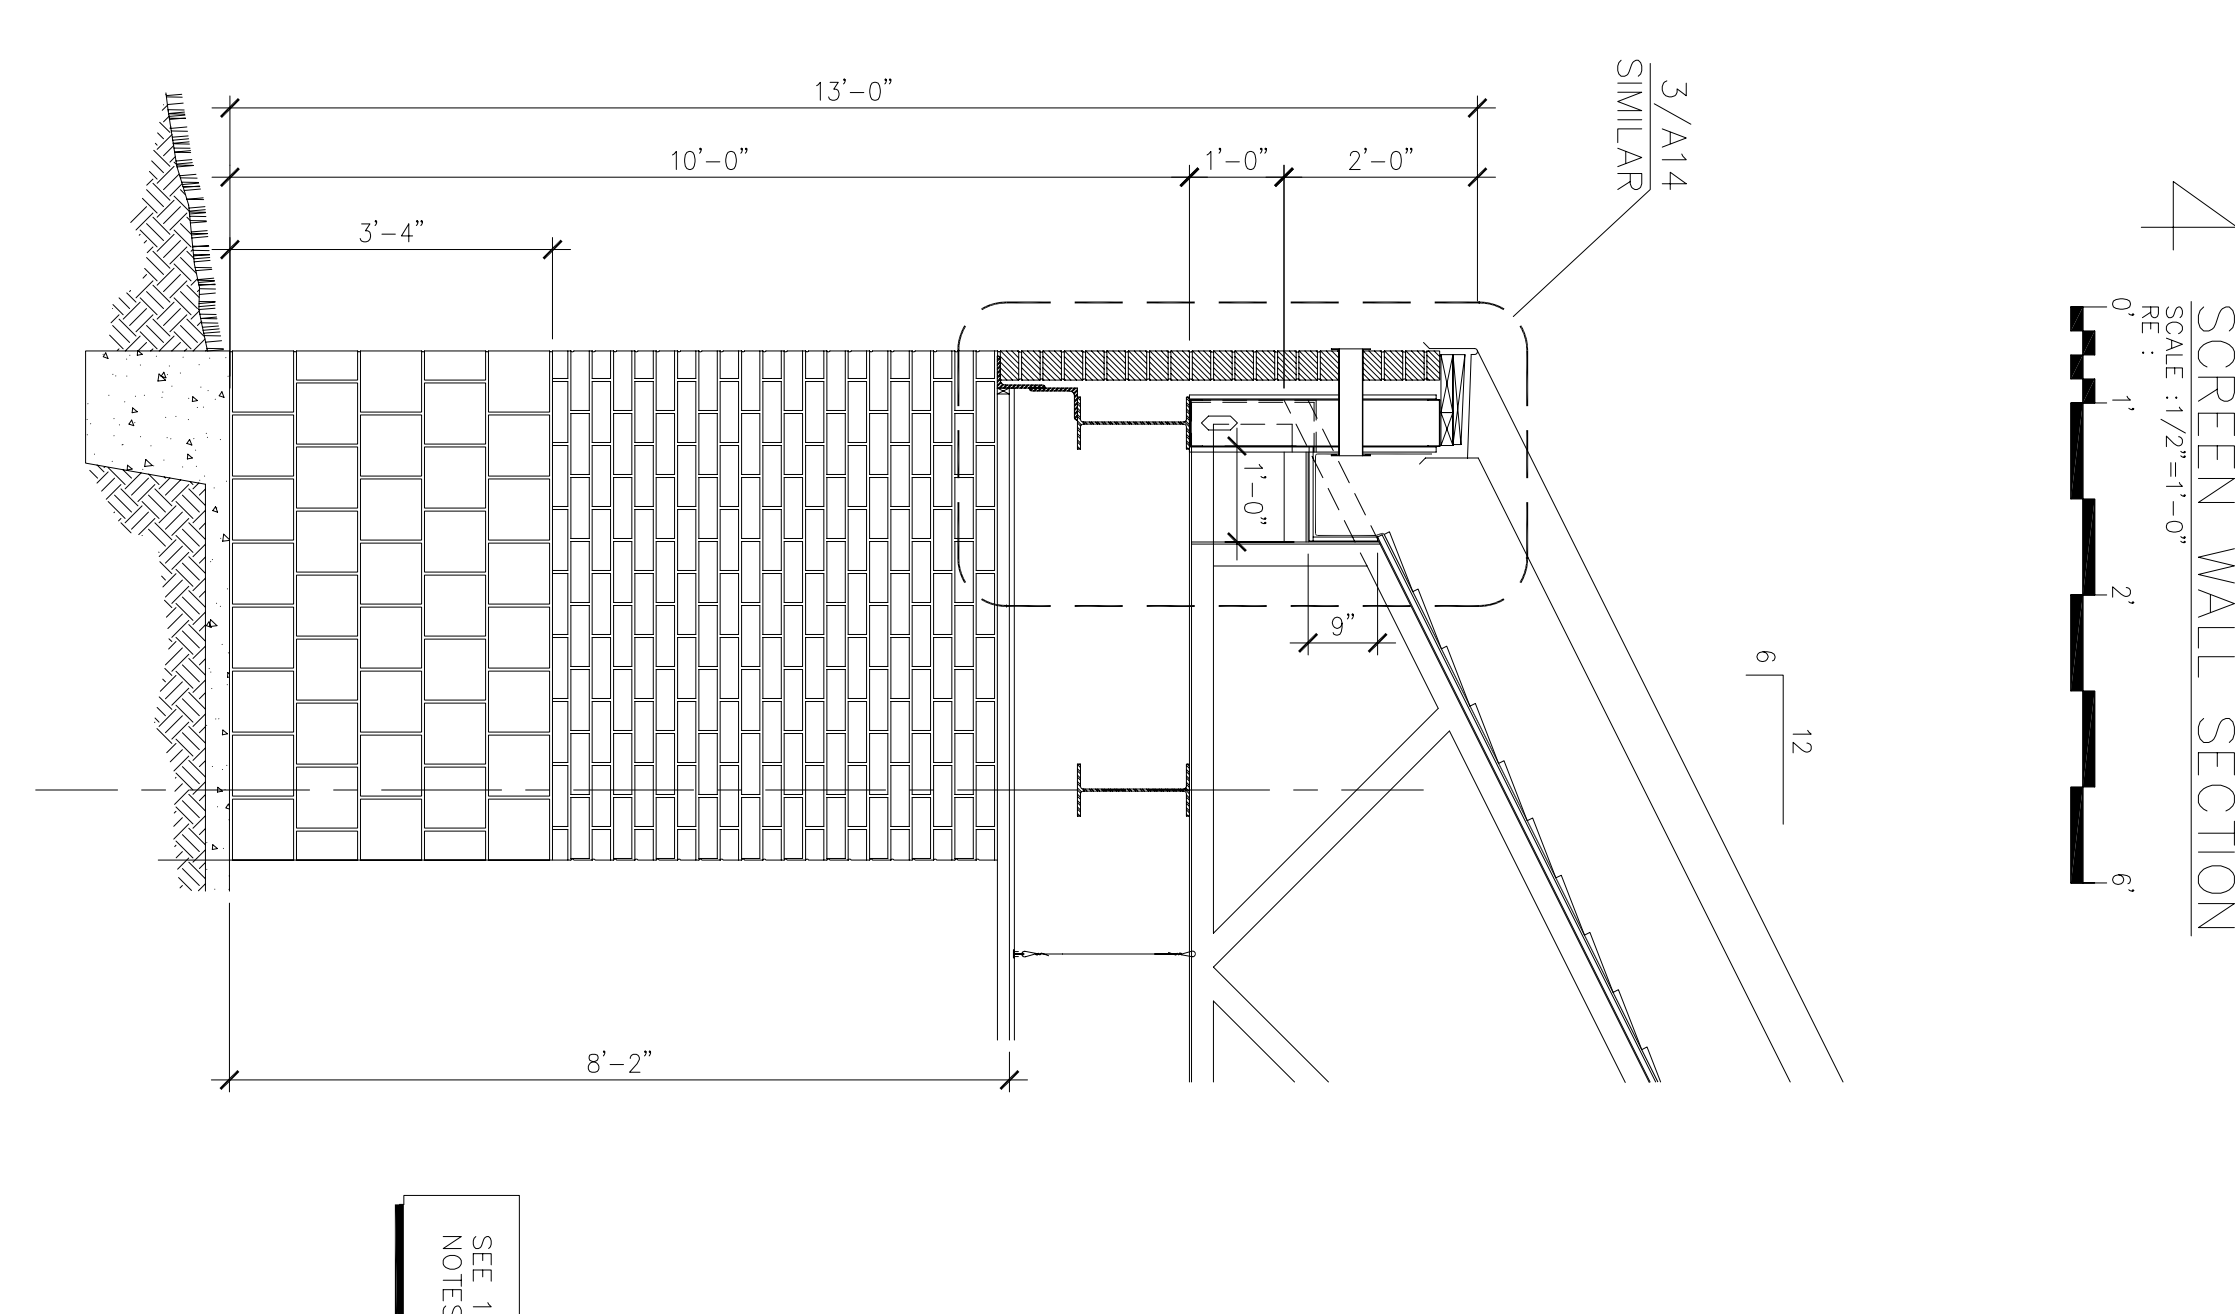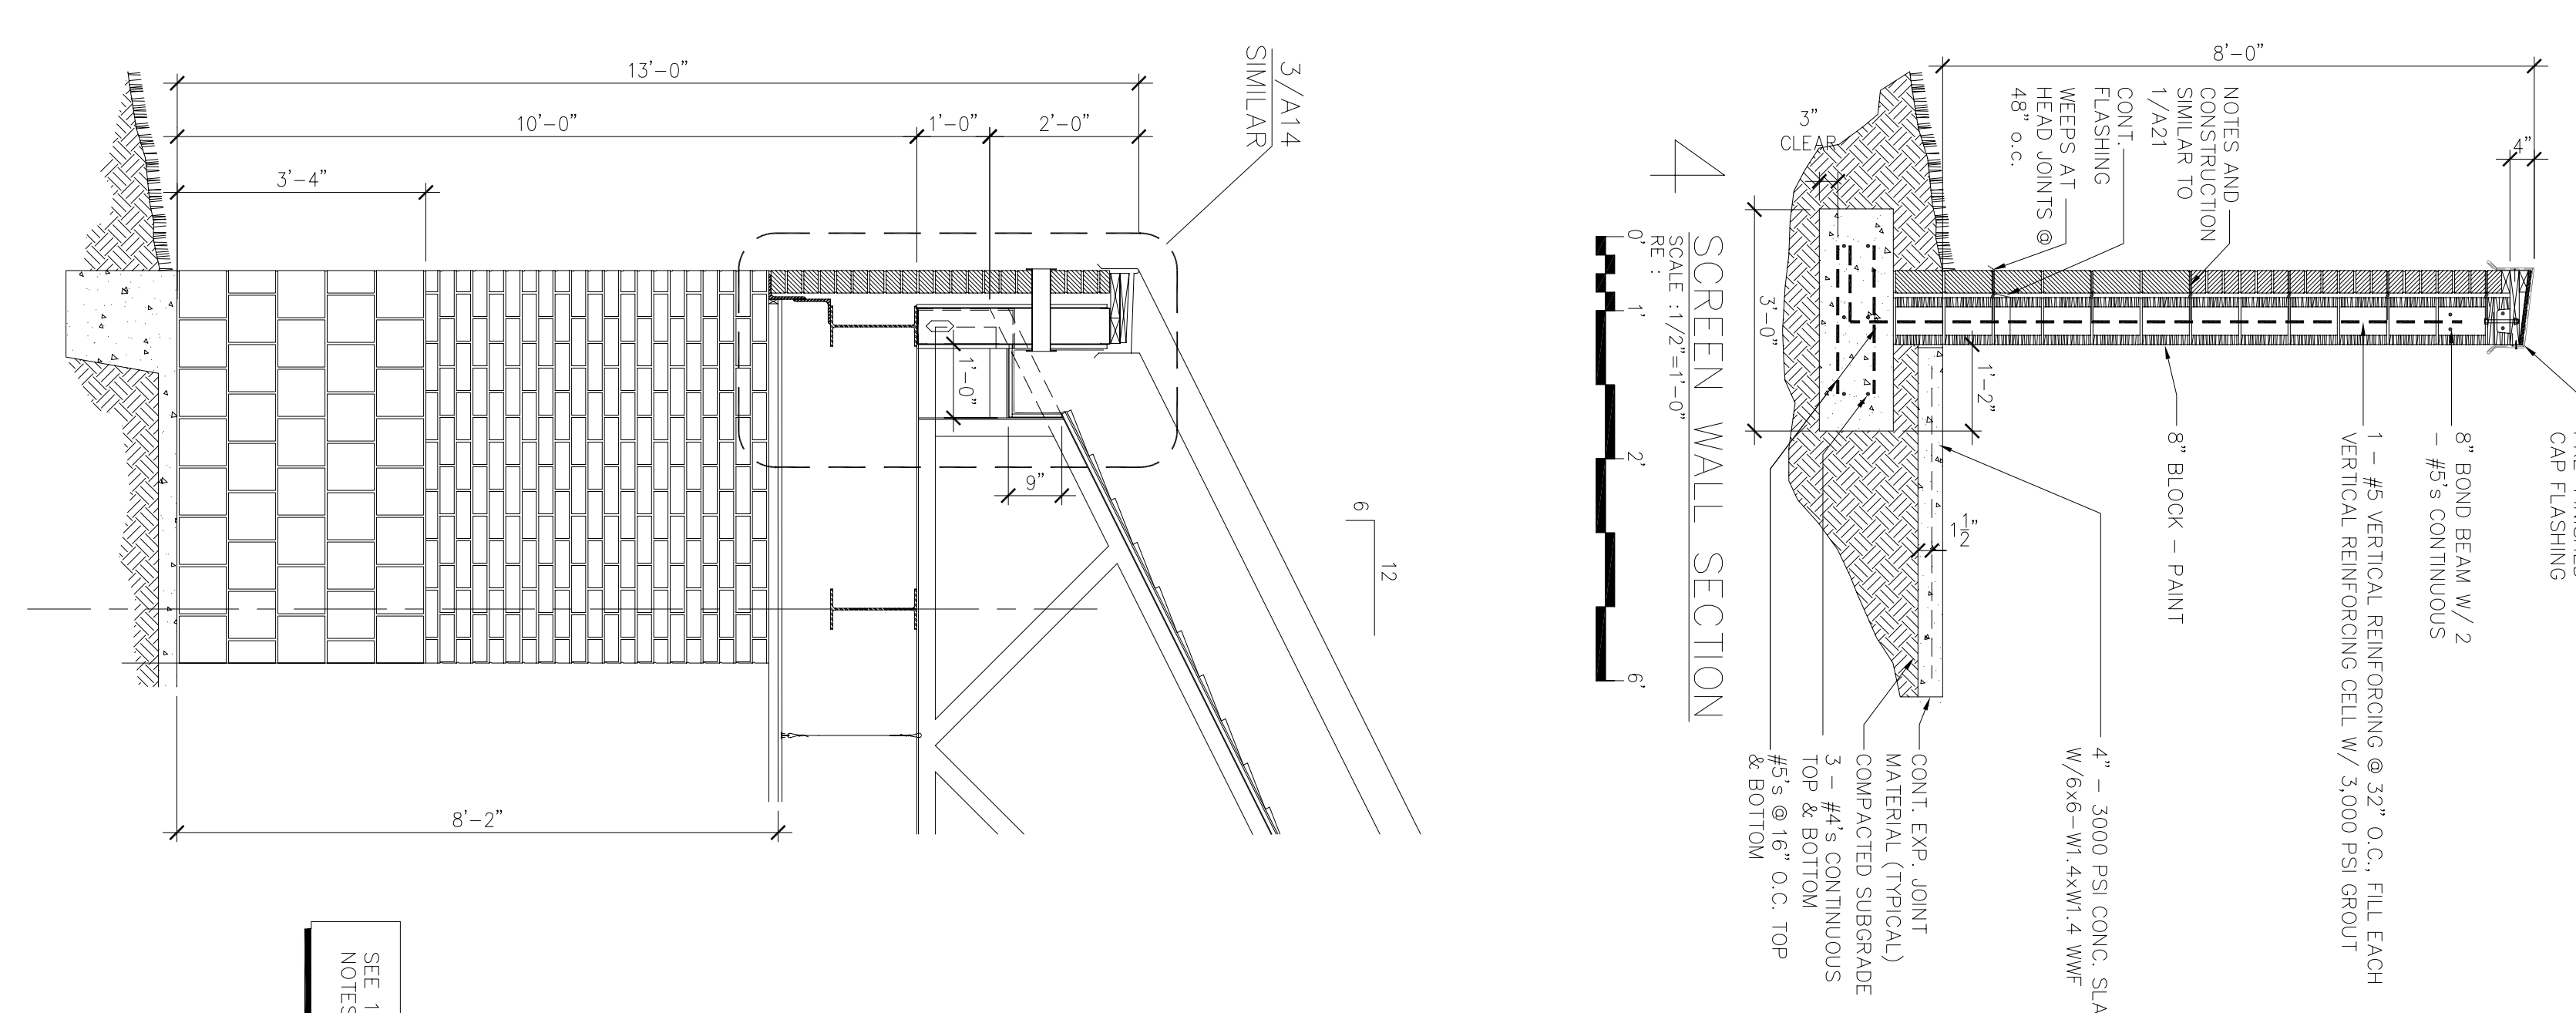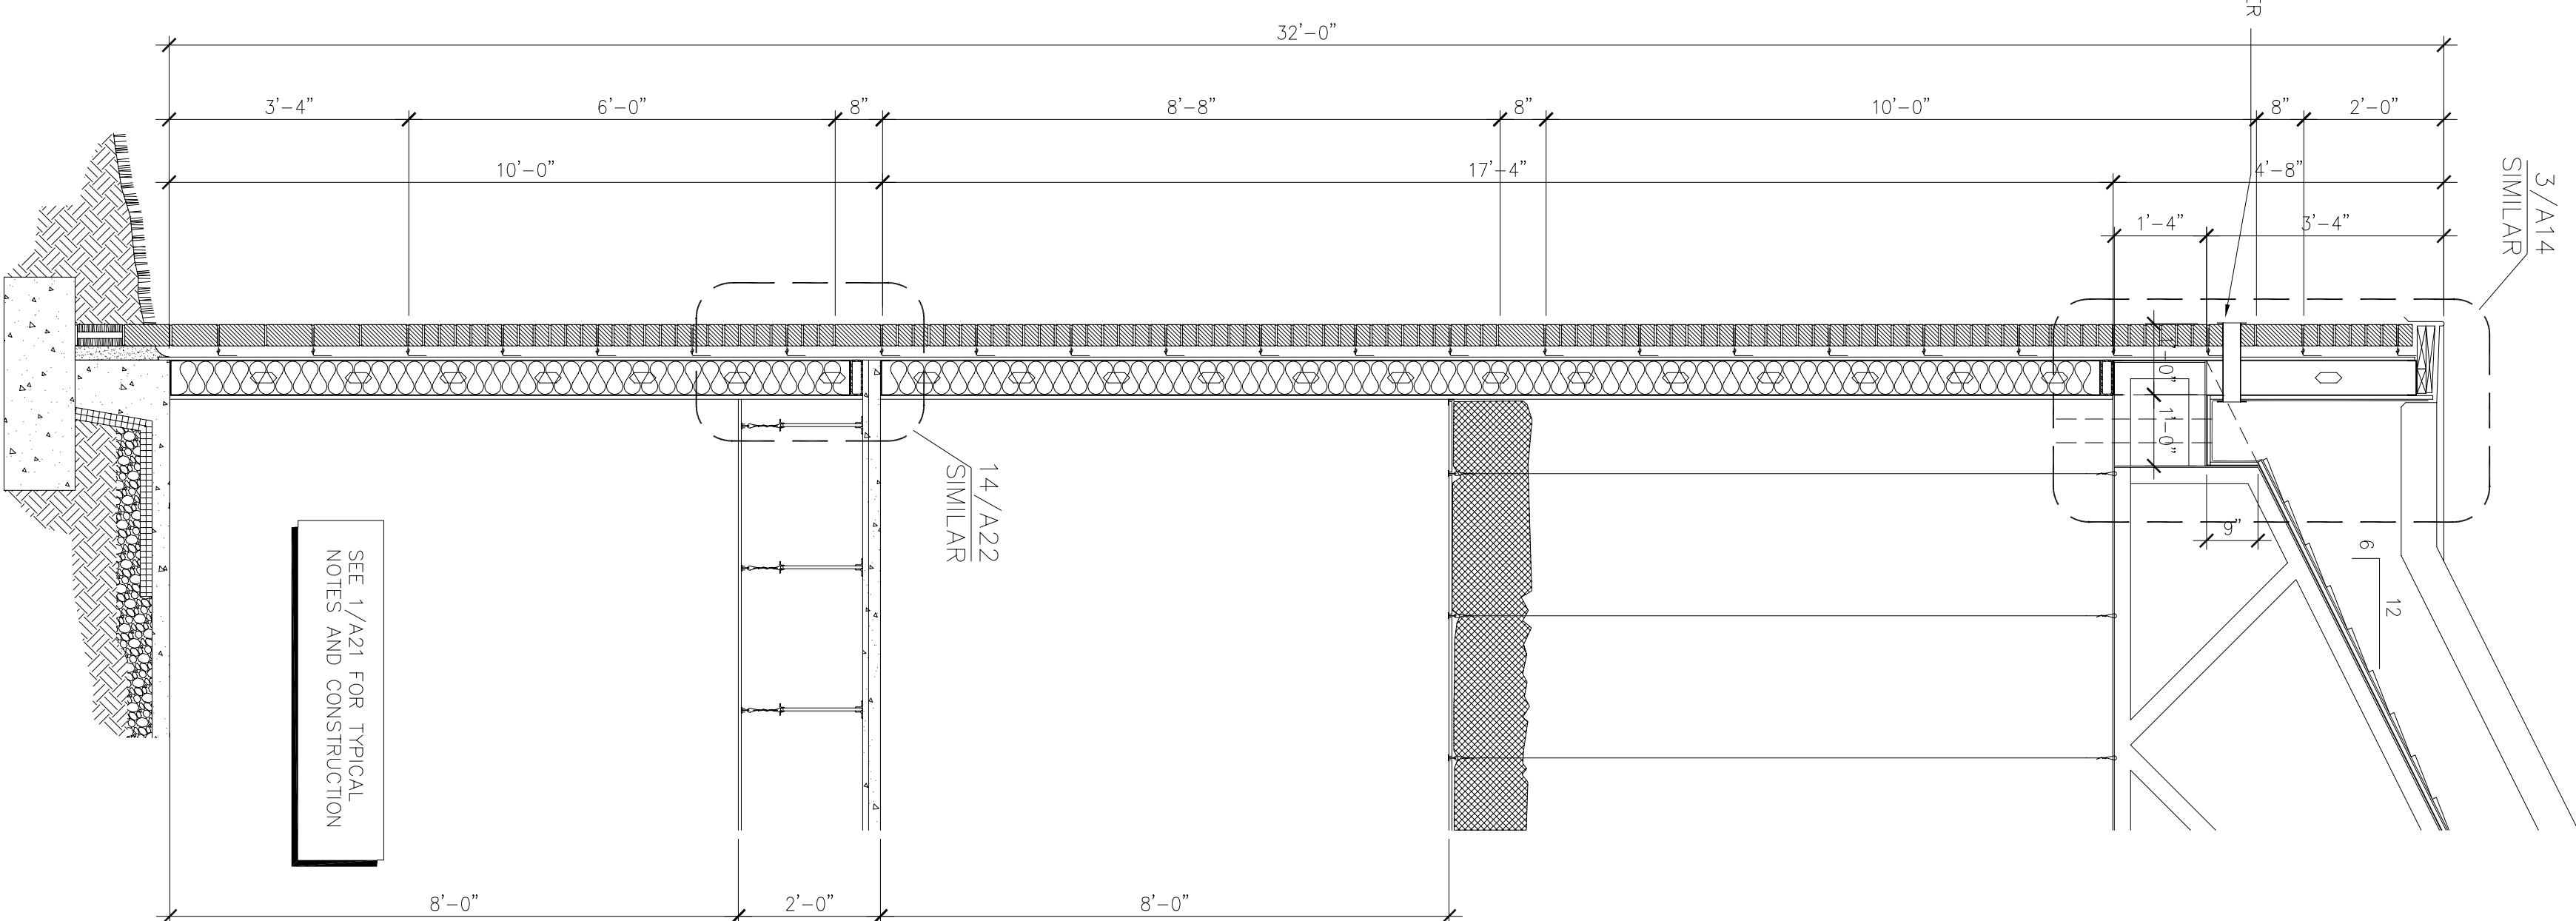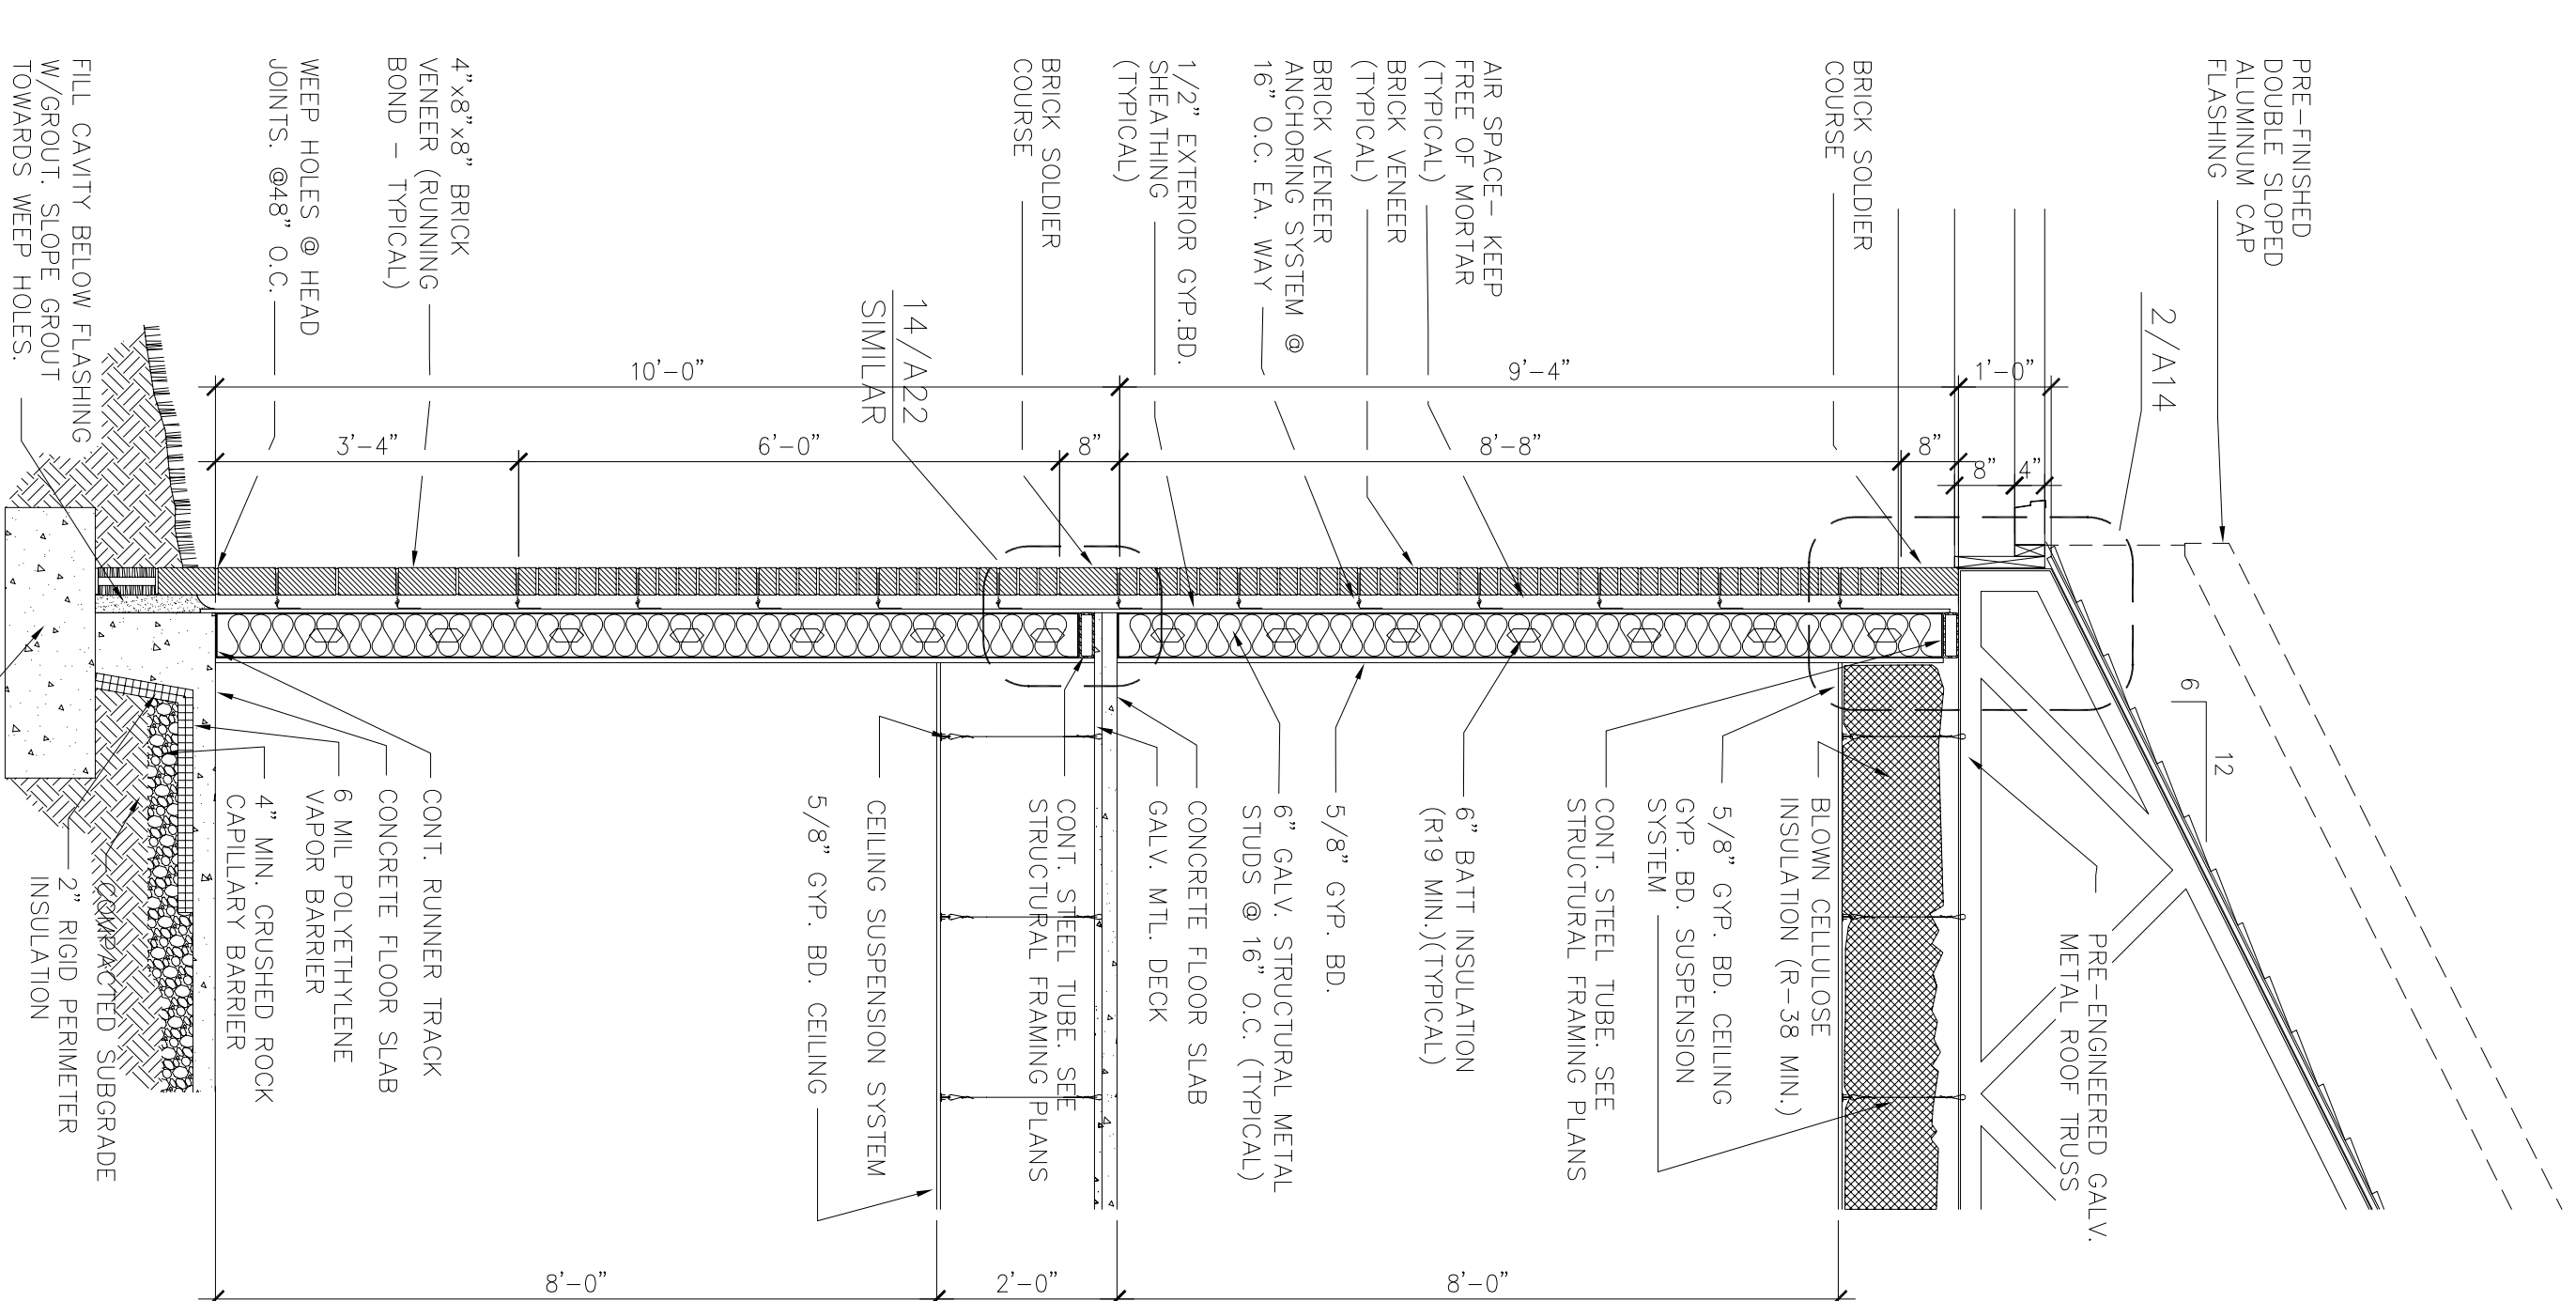

SEE 1/A21 FOR TYPICAL NOTES AND CONSTRUCTION

SEE 1/A21 FOR TYPICAL NOTES AND CONSTRUCTION

3 WALL SECTION
SCALE: 1/2"=1'-0"
0' 1' 2' 6'

2 WALL SECTION
SCALE: 1/2"=1'-0"
0' 1' 2' 6'

1 WALL SECTION
SCALE: 1/2"=1'-0"
0' 1' 2' 6'

1/2"=1'-0"