


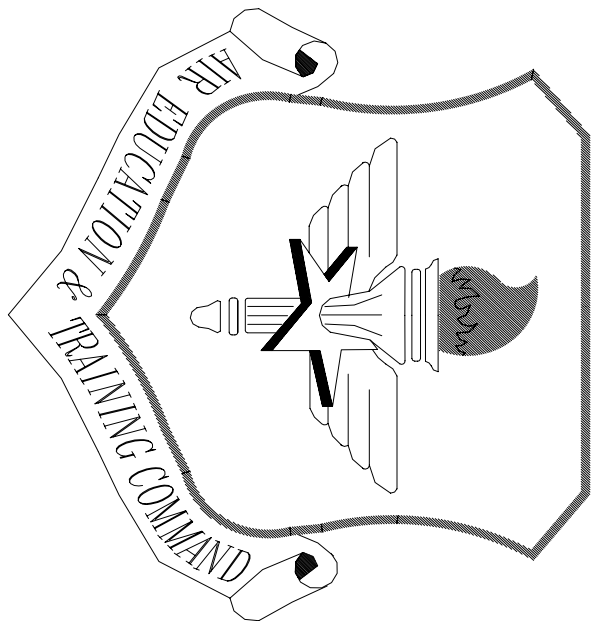

LITTLE ROCK A.F.B.
ARKANSAS

No.	Revision/Issue	Date	BY	APP'D
1	No changes from Design to As-Built			

TEMPORARY LODGING
FACILITY

ENLARGED PLANS
AS-BUILT

DRAWN BY JB	LEAD DESIGNER BG
TECH REVIEWER BG	FILE LOCATION
DESIGNED BY BG	PROJECT NUMBER NKA02-5001
DATE 28 MAY 2002	SHEET A25
SCALE 1/4" = 1'-0"	34 OF 108

