



LITTLE ROCK A.F.B.
ARKANSAS

NOTE:
1. ALL DIMENSIONS SHOWN ARE FINISH DIMENSIONS.
2. SEE SHEET A27 FOR INTERIOR FINISH SCHEDULE AND TOILET ACCESSORY SCHEDULE.
3. EXTERIOR DIMENSIONS MAY VARY @ LIVING UNITS REFER TO A7 & A8.

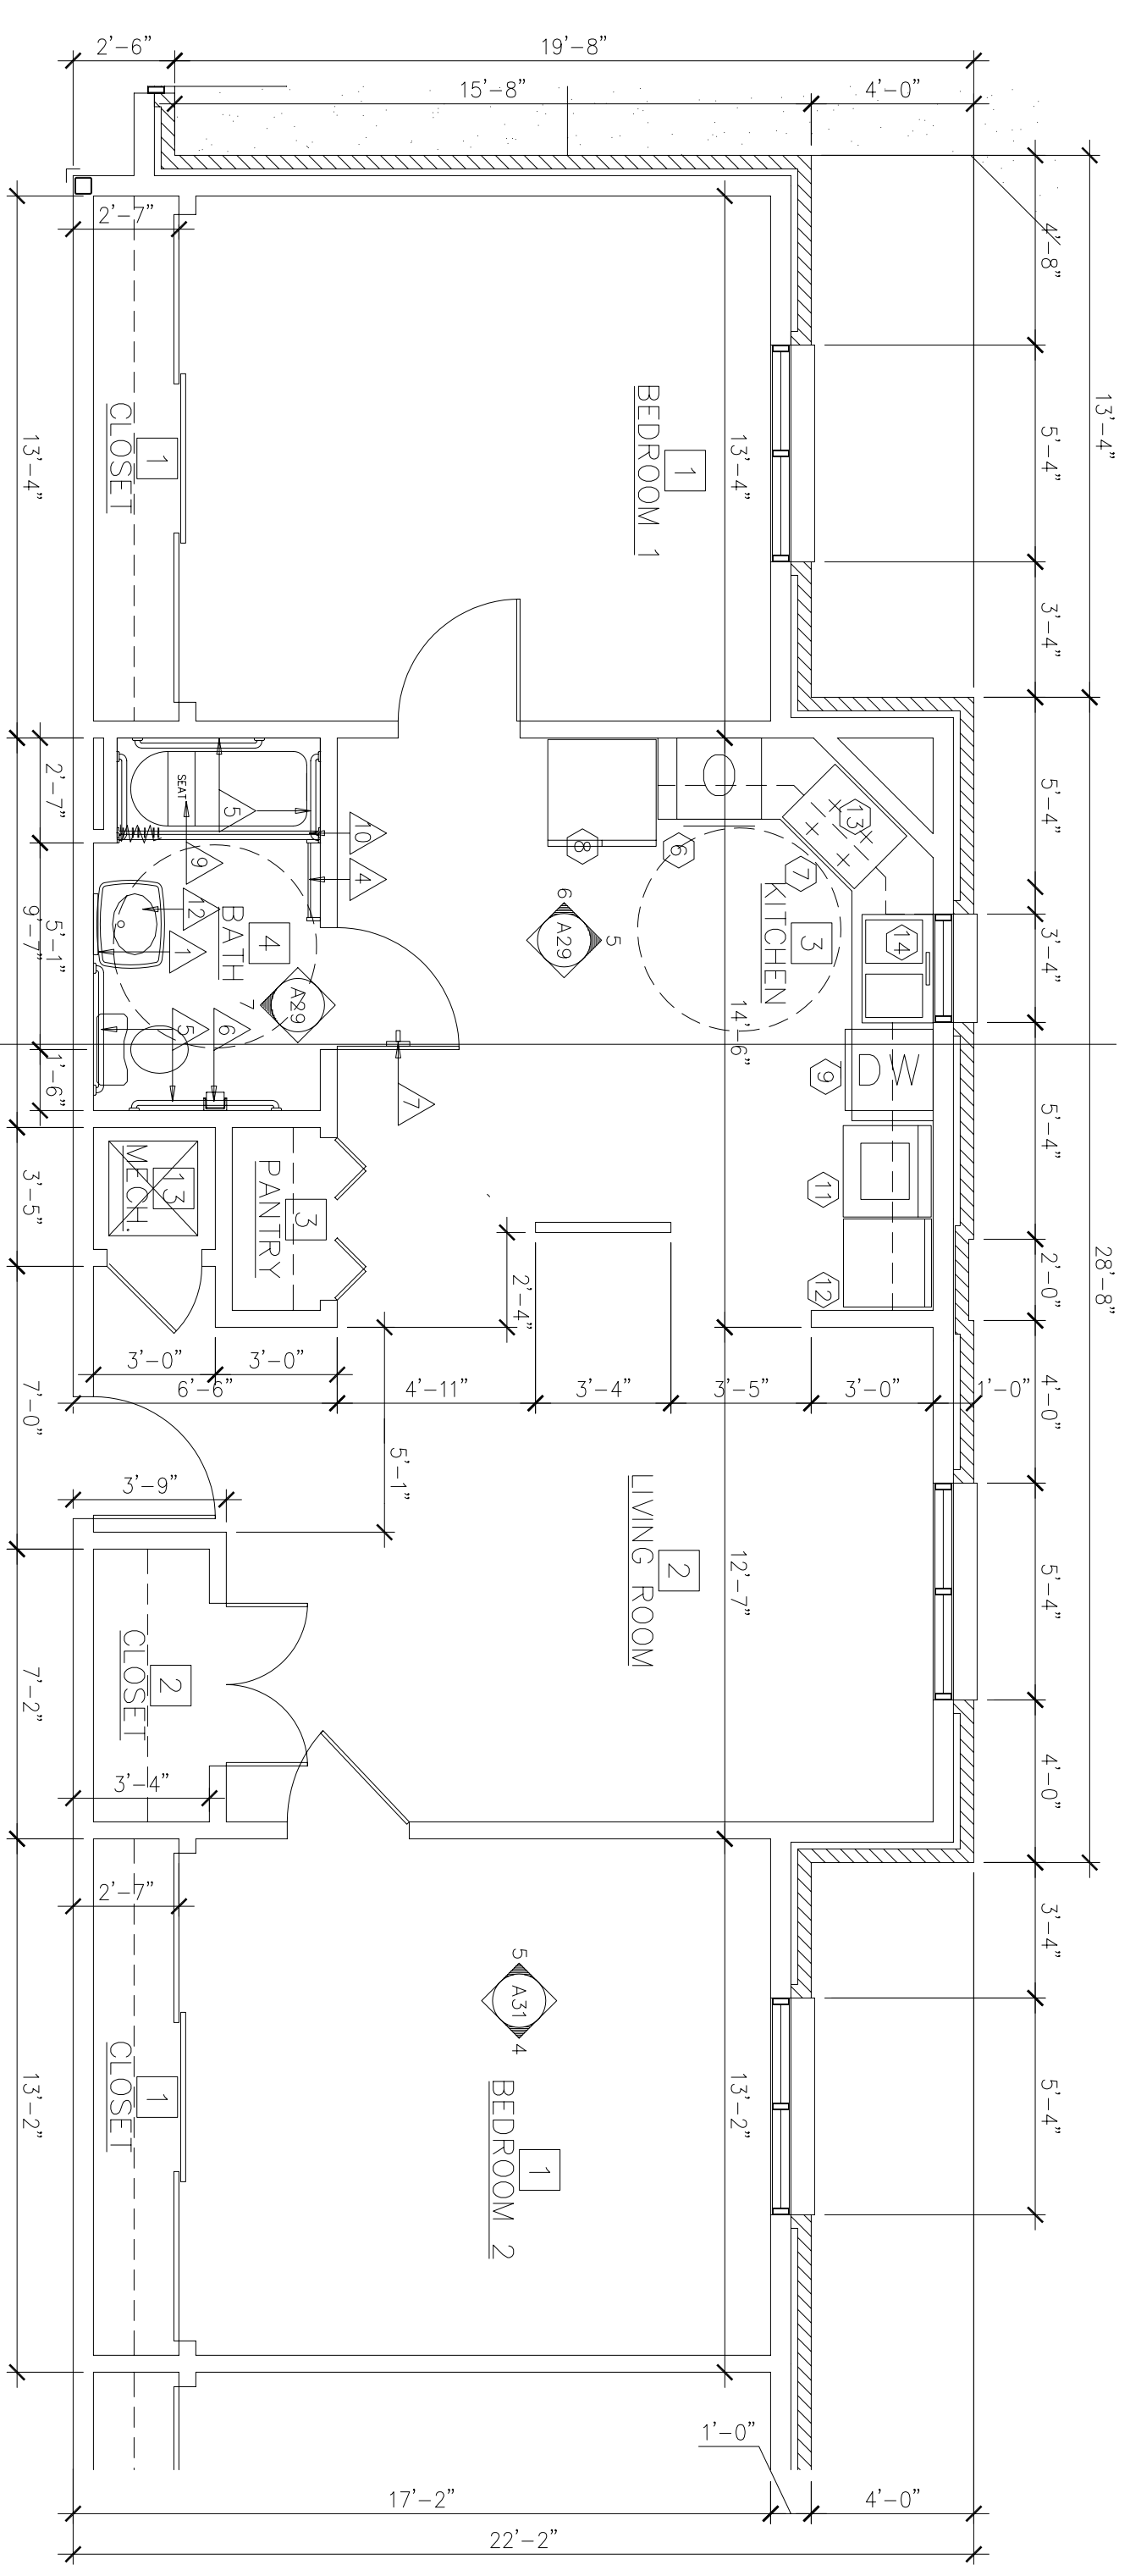

2 ENLARGED PLAN AT ADA UNIT
SCALE: 1/4" = 1'-0"
0' 1' 2' 3' 4' 5' 6' 7' 8' 9' 10' 11' 12'

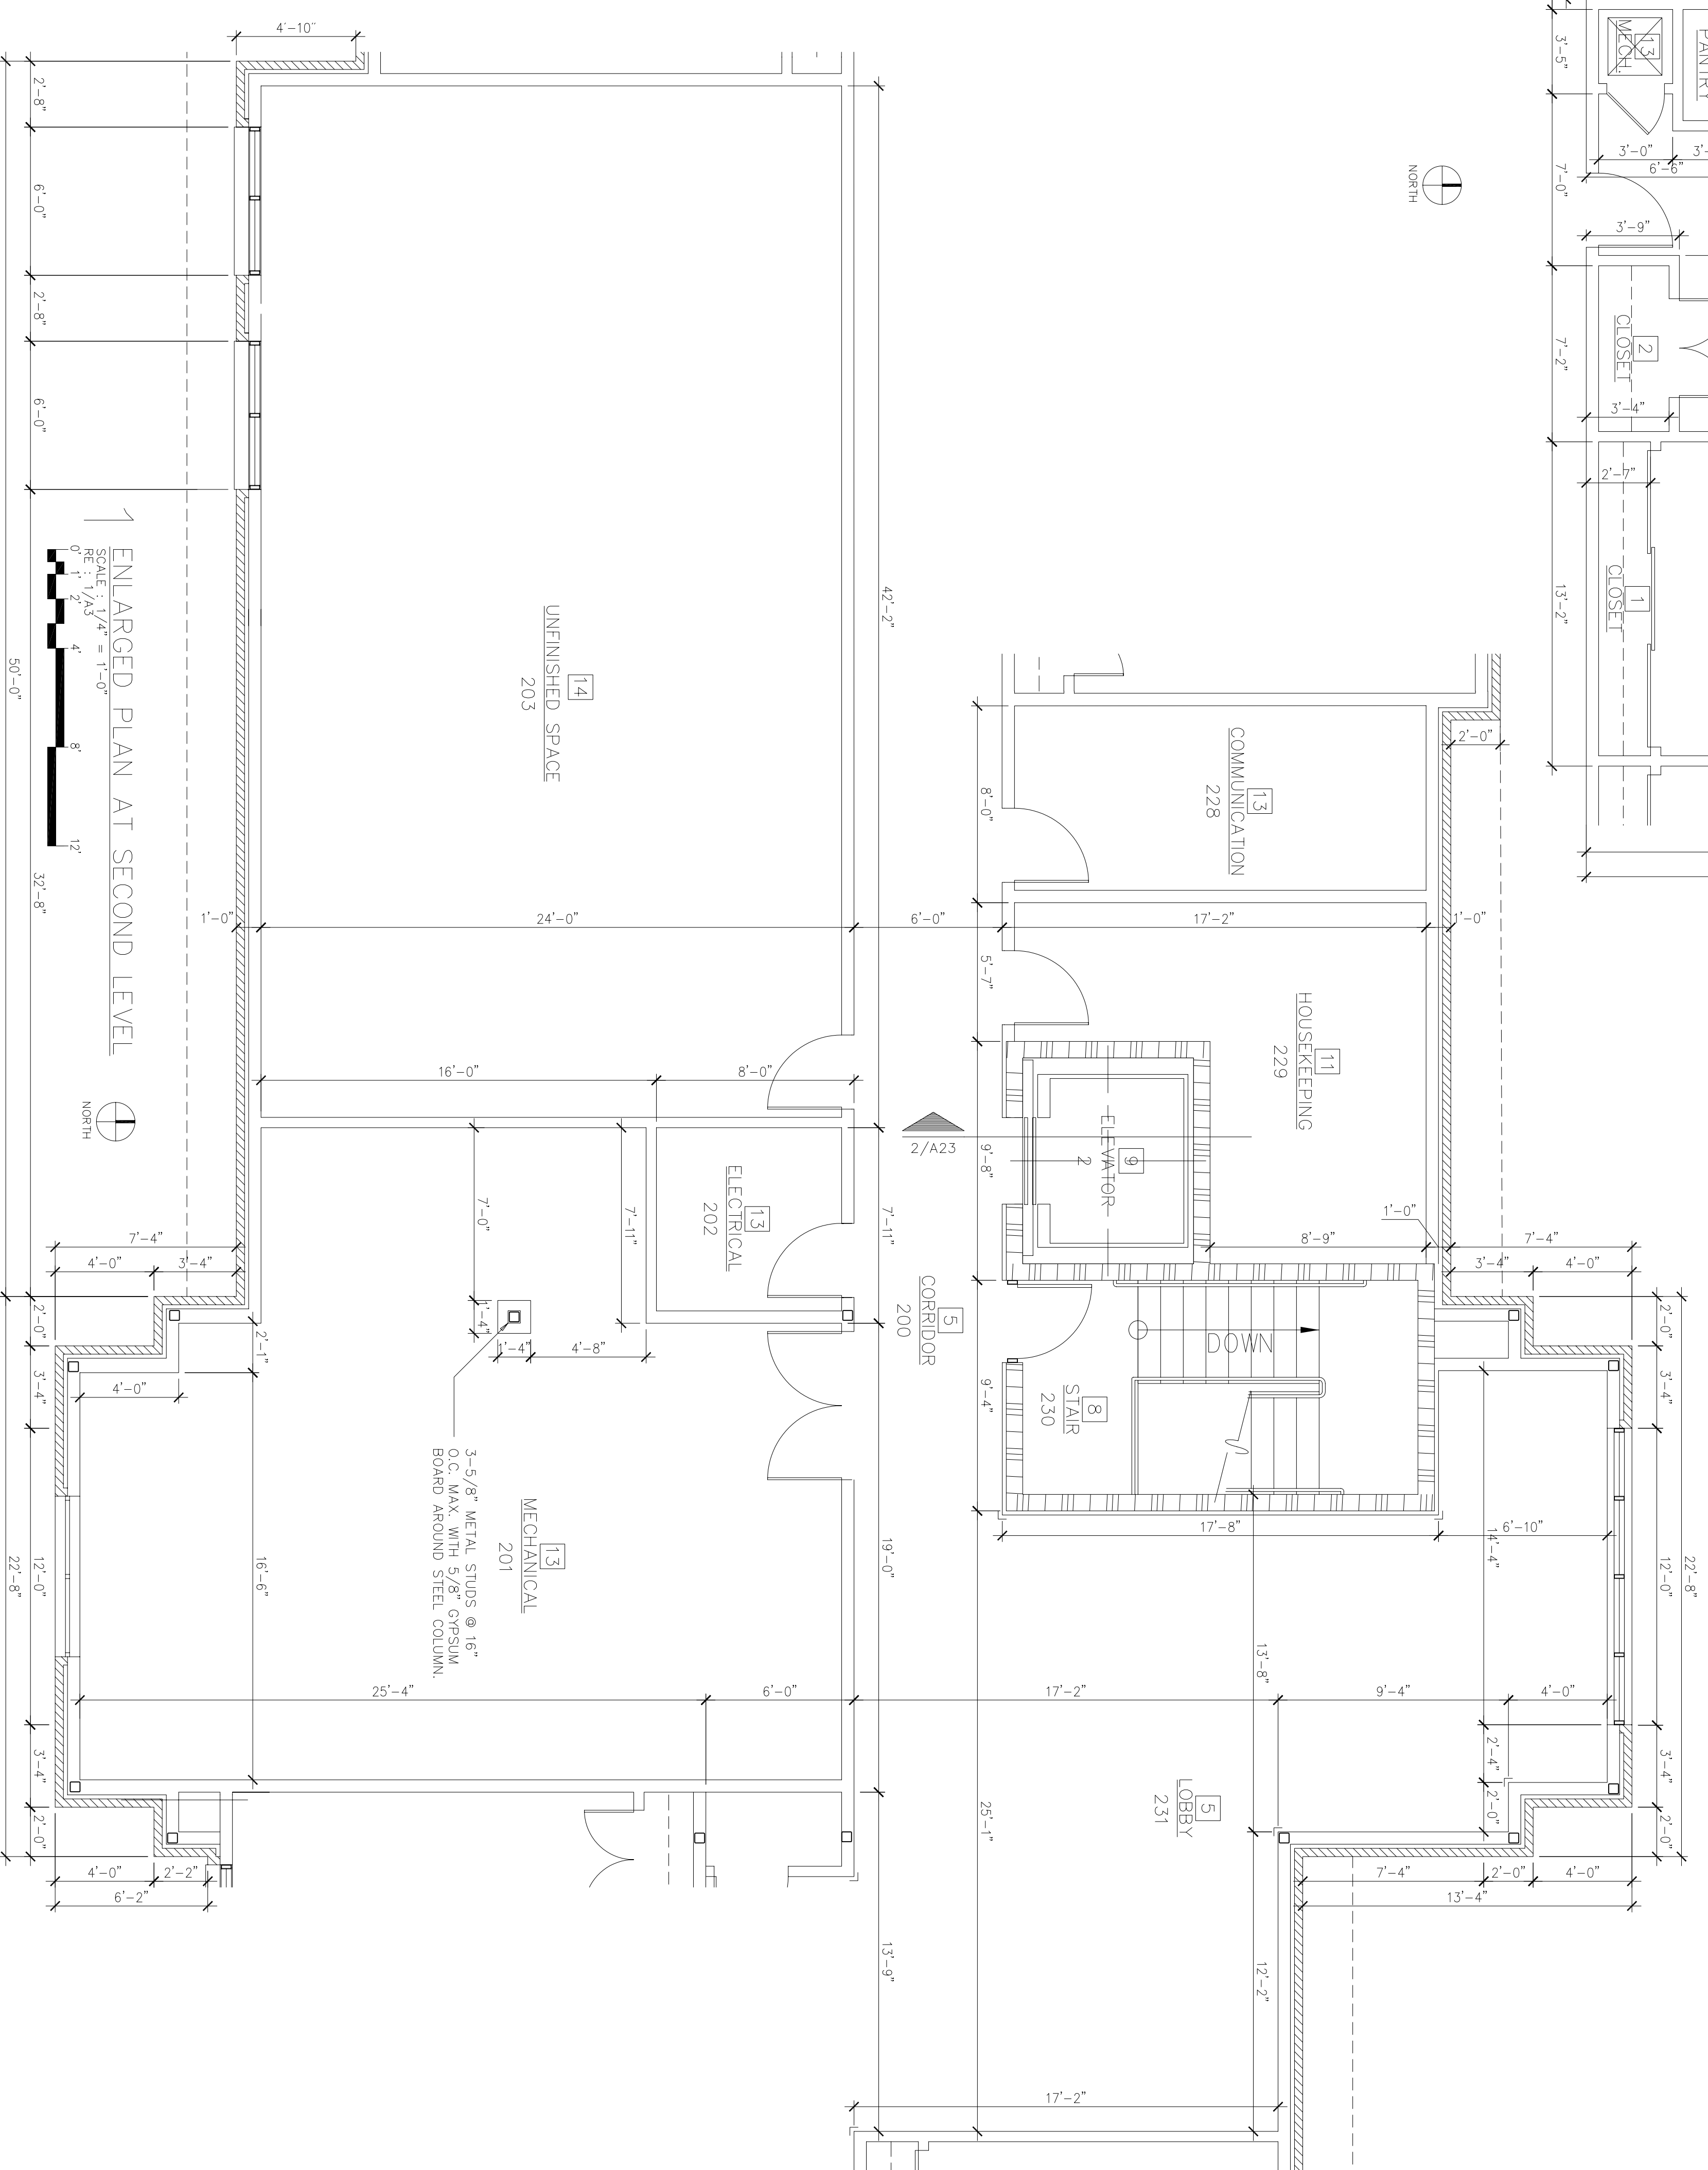

1 ENLARGED PLAN AT SECOND LEVEL
SCALE: 1/4" = 1'-0"
0' 1' 2' 3' 4' 5' 6' 7' 8' 9' 10' 11' 12'



No.	Revision/Issue	Date	BY	APP'D
1	No changes from Design to As-Built			

PROJECT TITLE
TEMPORARY LODGING FACILITY

SHEET TITLE
ENLARGED PLANS AS-BUILT

Drawn by JB	Lead Designer BG
Tech Reviewer	File Location
Designed by BG	Project Number NKAK02-5001
Date 28 MAY 2002	Sheet A26
Scale 1/4" = 1'-0"	35 of 108