




GL-1 = INSULATED CLEAR GLASS
GL-2 = INSULATED TEMPERED CLEAR GLASS
GL-3 = 1/4" WIRE GLASS

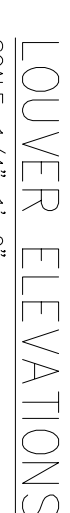


SCALE: 1/4" = 1'-0"


0' 1' 2' 4' 8' 12'



SCALE: 1/4" = 1'-0"

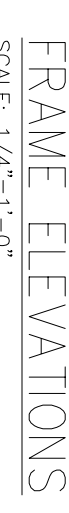

FRAME NOTE:
PROVIDE HOLLOW METAL KNOCK DOWN FRAMES IN LIEU
OF FULLY WELDED HOLLOW METAL FRAMES AT ALL DOOR
EXCEPT CORRIDOR AND/ OR FIRE RATED DOORS.

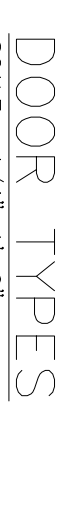

PROJECT TITLE

TEMPORARY LODGING
FACILITY

SHEET TITLE

DOOR & WINDOW
ELEVATIONS

AS-BUILT