









LITTLE ROCK A.F.B.
ARKANSAS

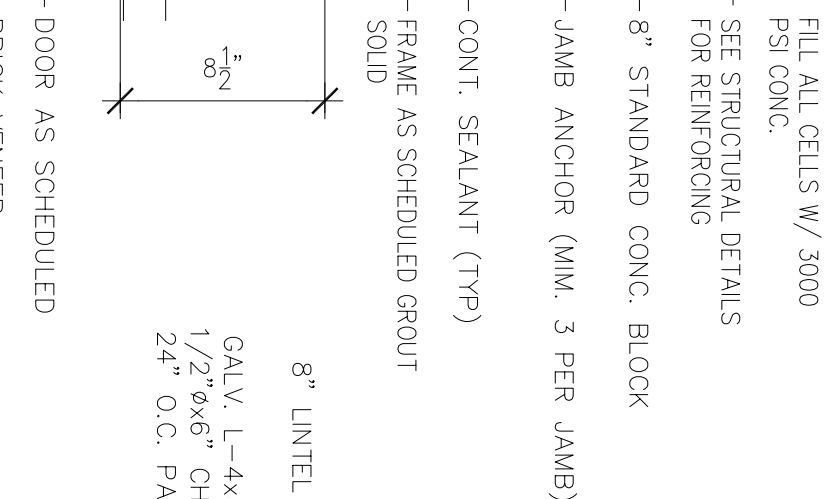

SCALE: 1-1/2"=1'-0"
RE: 1/A18, 2/A19, & 2/A20

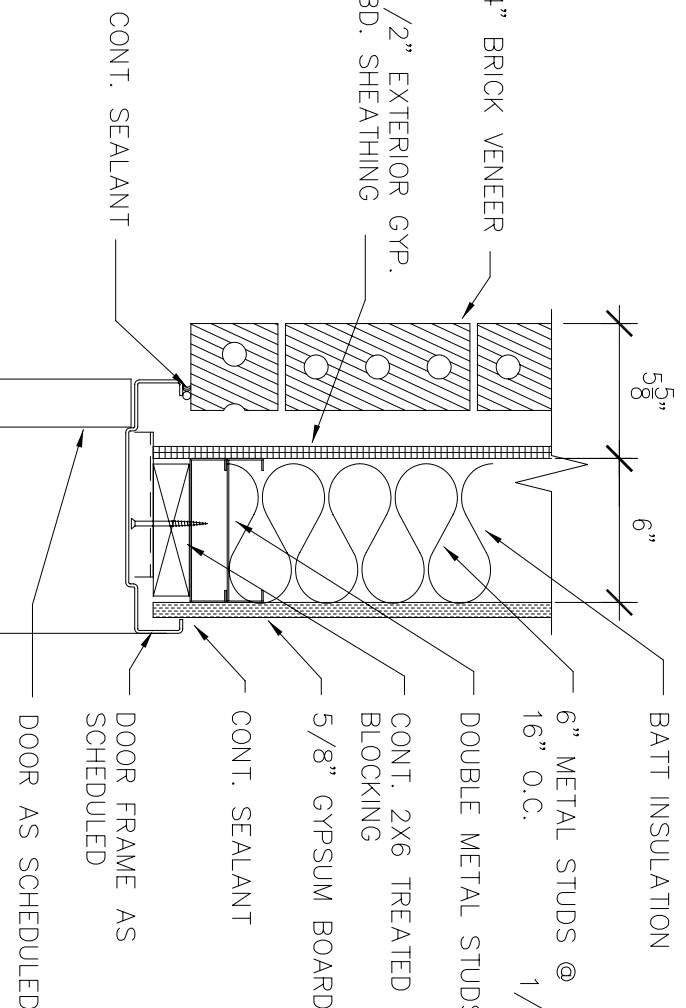

SCALE: 1-1/2"=1'-0"
RE: 1/A19

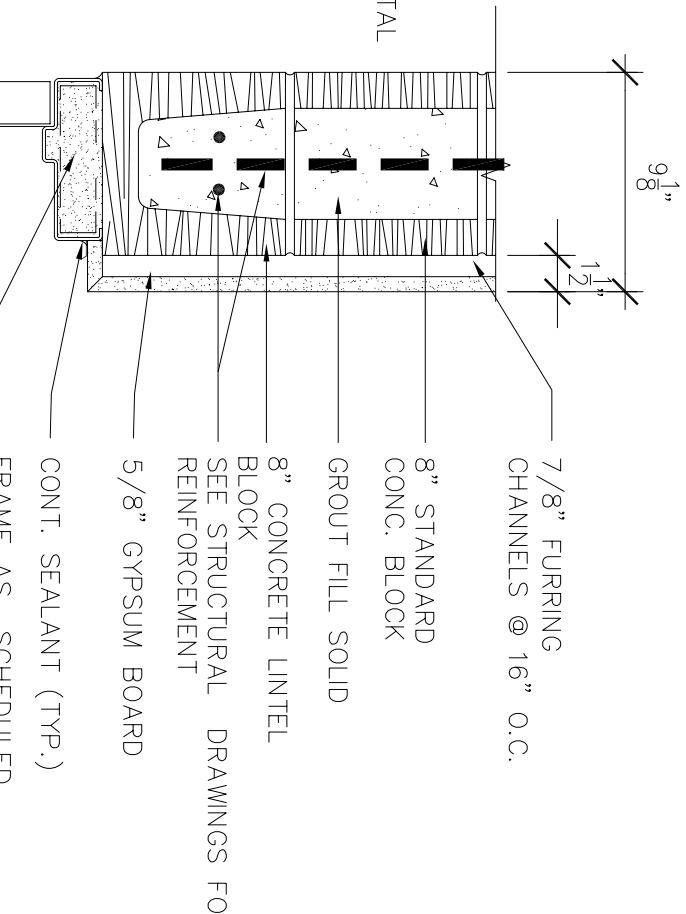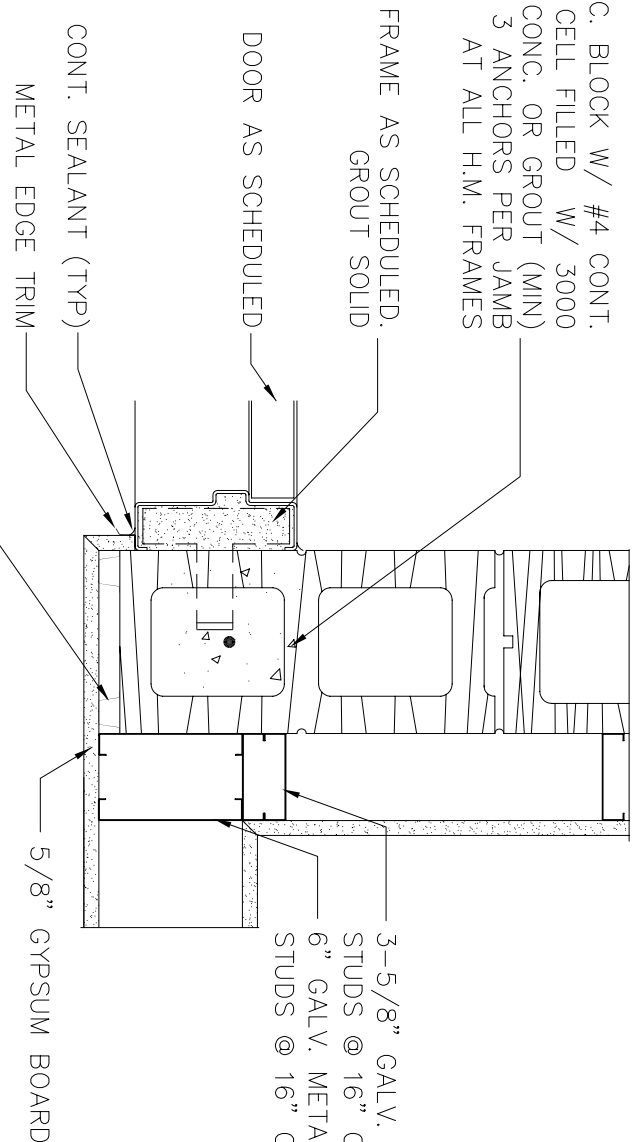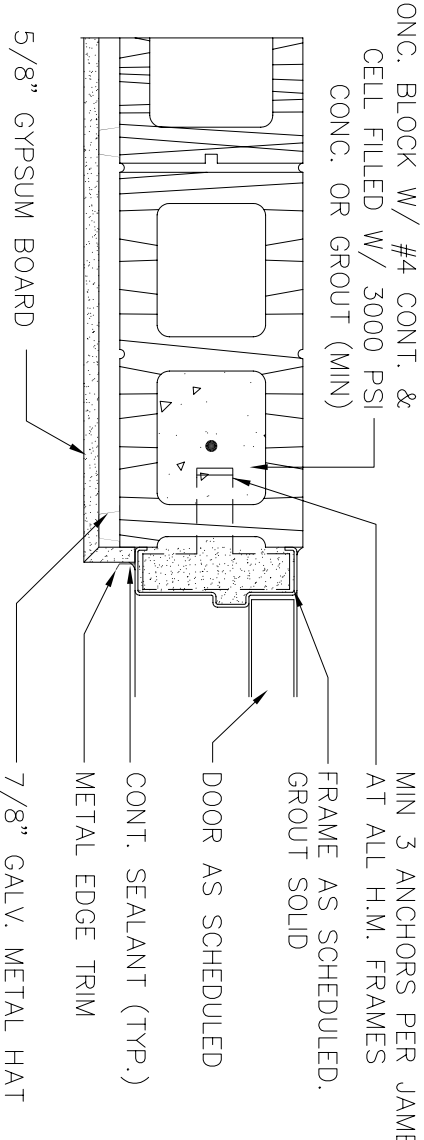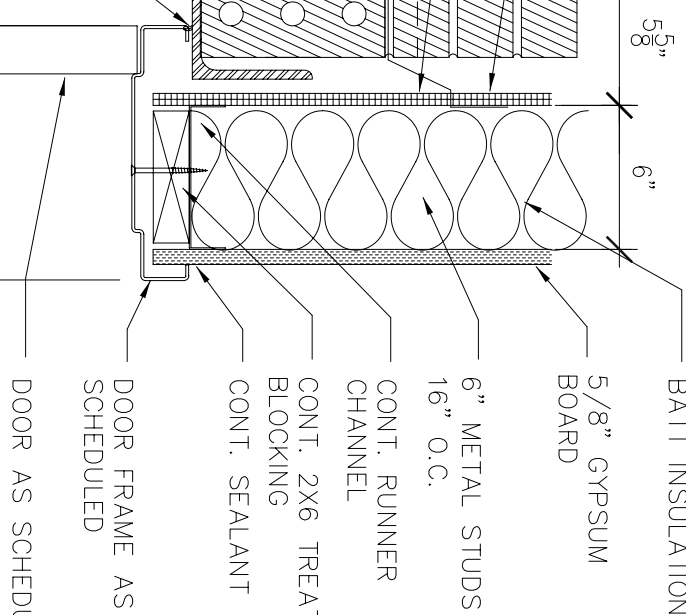





SCALE: 1'-1/2"=1'-0"
RE: 0' 6" 1'

SCALE: 1-1/2"=1'-0"
RE: 0' 6" 1'


SCALE: 1-1/2"=1'-0"
RE: 1/A1, 1/A2, 1/A3

SCALE: 1-1/2"=1'-0"
RE: 1/A1, 1/A2, 1/A3
6" 1


SCALE: 1"=1'-0"
RE: 1/A24

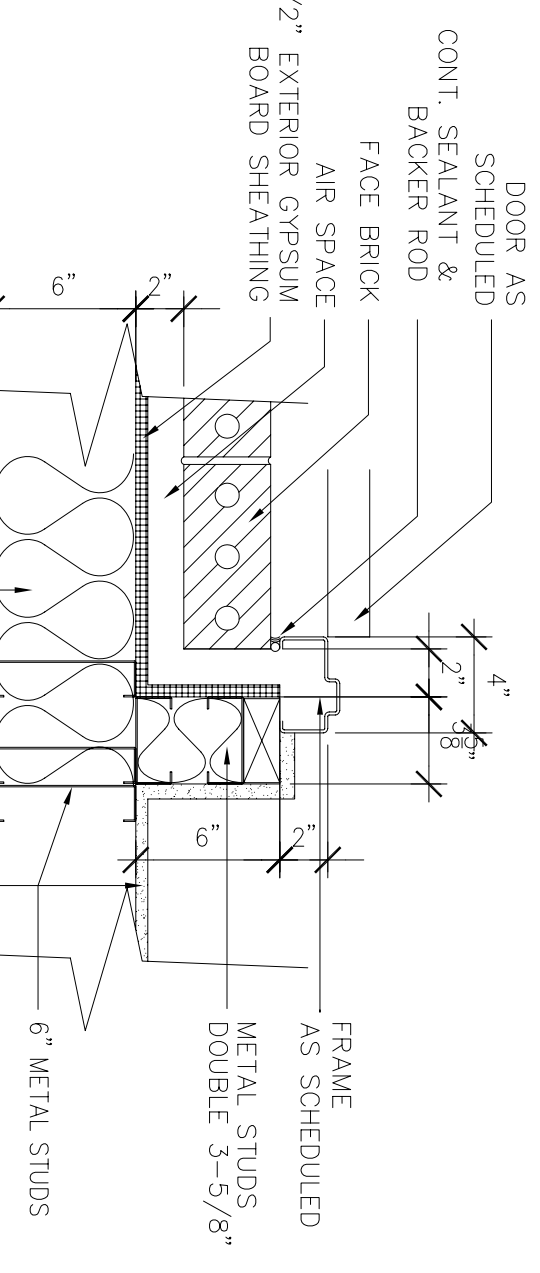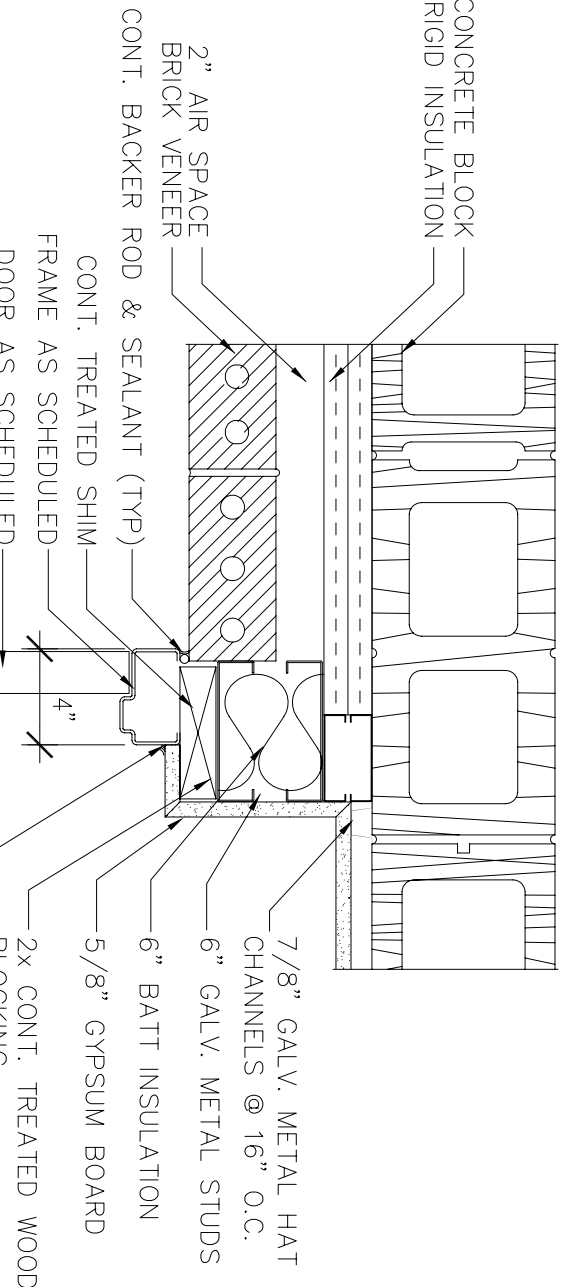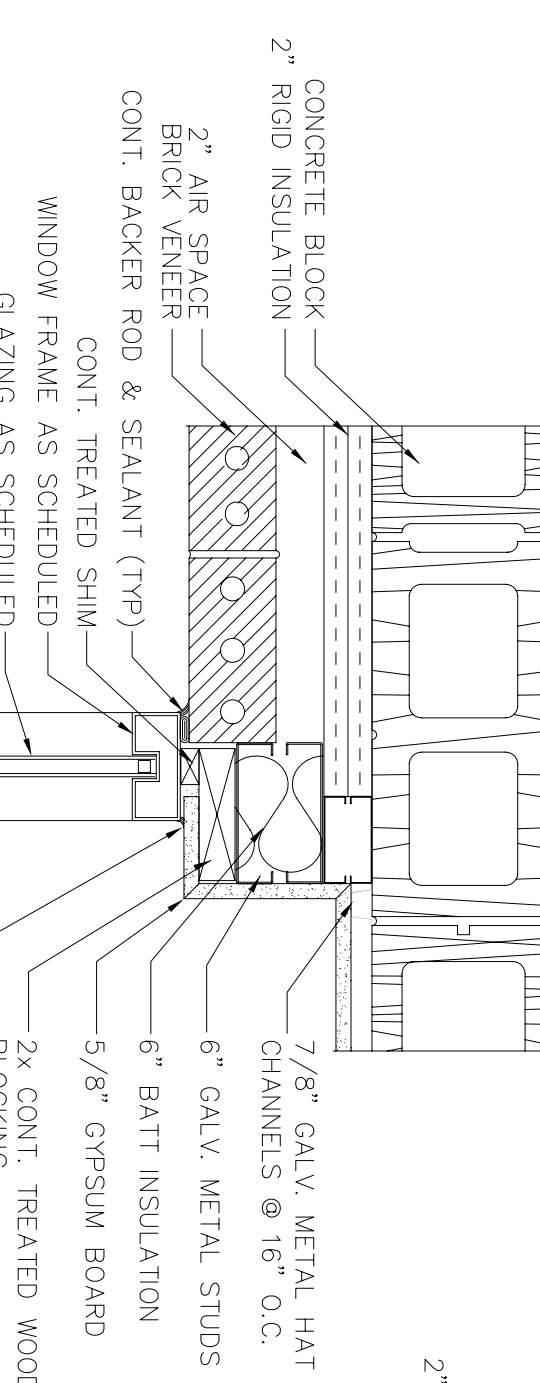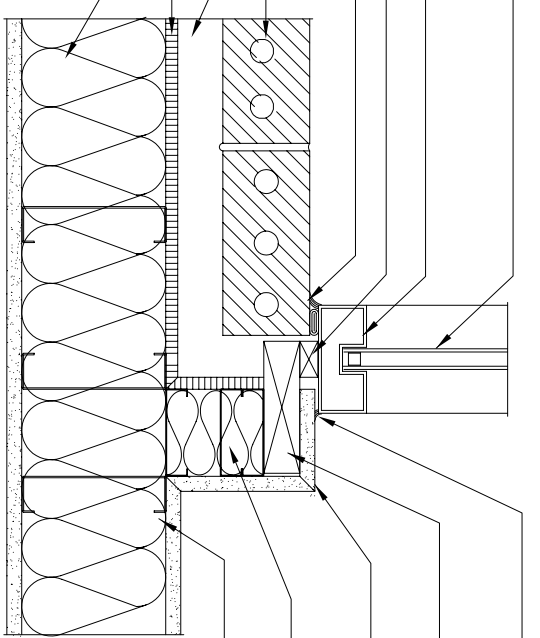


SCALE: 1-1/2"=1'-0"
RE: 1/A3 & 1/A4

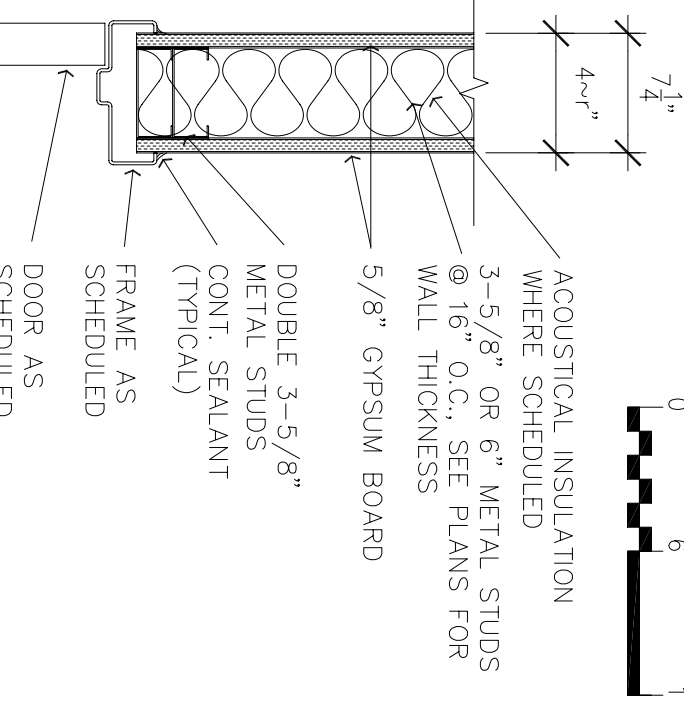


SCALE: 1-1/2"=1'-0"
RE: 1/A3 & 1/A4

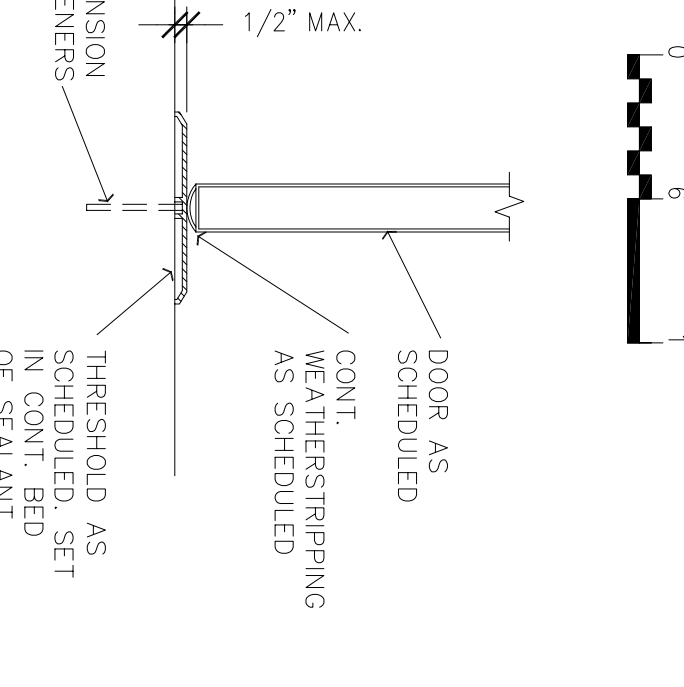

SCALE: 1'-1 1/2"=1'-0"
RE: 1/A1 & 1/A2

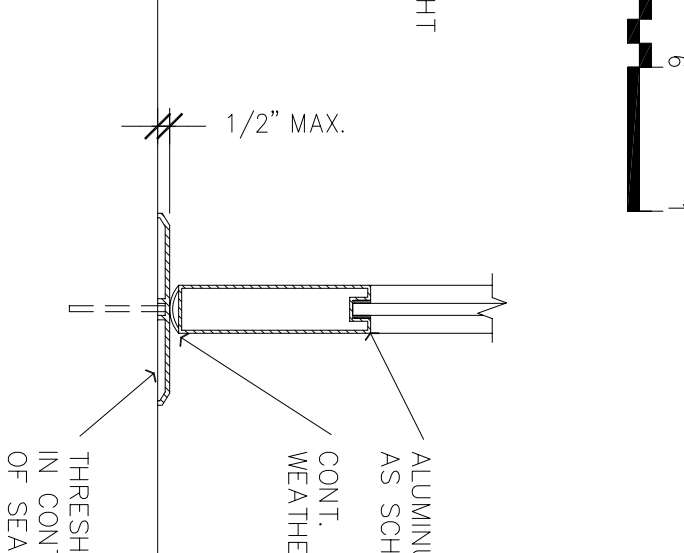

SCALE: 1"=1'-0"
RE: 1/A1 & 1/A2

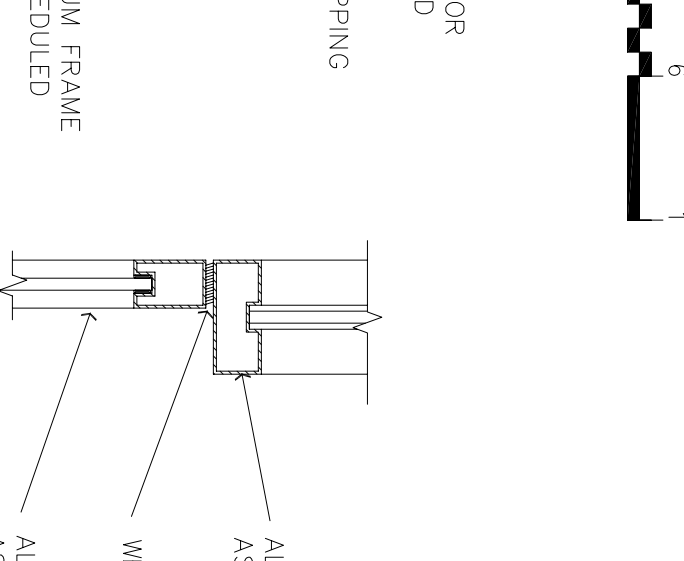

RE: 0 0

RE: 0 6 1

1	No changes from Design to As-Built			
No.	Revision/Issue	Date	BY	APP'D

LEAD DESIGNER	BG
FILE LOCATION	
PROJECT NUMBER	NKAK02-5001
SHEET	A31
	40 OF 108