

LITTLE ROCK A.F.B.
ARKANSAS


No.	Revision/Issue	Date	By	App'D
1	No Changes from Design to As-Built			

PROJECT TITLE
TEMPORARY LODGING FACILITY

SHEET TITLE
PARTIAL FOUNDATION PLAN AS-BUILT

LEAD DESIGNER	TVR
FILE LOCATION	
PROJECT NUMBER	NKAK02-5001
DESIGNED BY	TVR
DATE	28 MAY 2002
SHEET	S2
SCALE	3/32" = 1'-0"

42 of 108

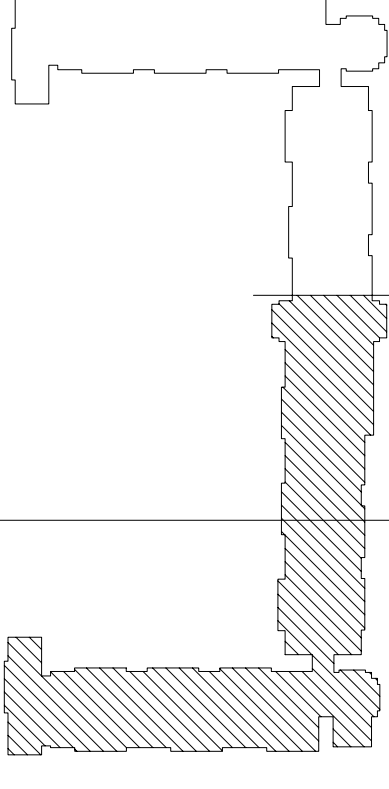

KEY PLAN

- NOTES:
1. FINISH FLOOR EL 372.00' (REF 0'-0")
 2. FLOOR CONSTRUCTION: 4" NORMAL WT CONCRETE w/ 2 LAYERS OF 6 MIL VAPOR RETARDER ON COMPACTED STRUCTURAL FILL OR UNDISTURBED SOIL
 3. REINFORCEMENT: 16x6-W2.9W2.9 W/F ON CHAIRS. SEE DETAIL 2/S15 SW2 INDICATES EXTERIOR X-BRACED STUD WALL. SEE DETAIL 3/S15 FOR COLUMN, BRACE AND ANCHOR BOLT SCHEDULE. SEE SHT S11.
 4. SW1 INDICATES INTERIOR X-BRACED STUD WALL.
 5. SEE DETAIL 2/S15 SW2 INDICATES EXTERIOR X-BRACED STUD WALL. SEE DETAIL 3/S15.
 6. FOR COLUMN, BRACE AND ANCHOR BOLT SCHEDULE. SEE SHT S11.

ENLARGED CORNER PLAN
3/16" = 1'-0"

PARTIAL FOUNDATION PLAN
3/32" = 1'-0"

