




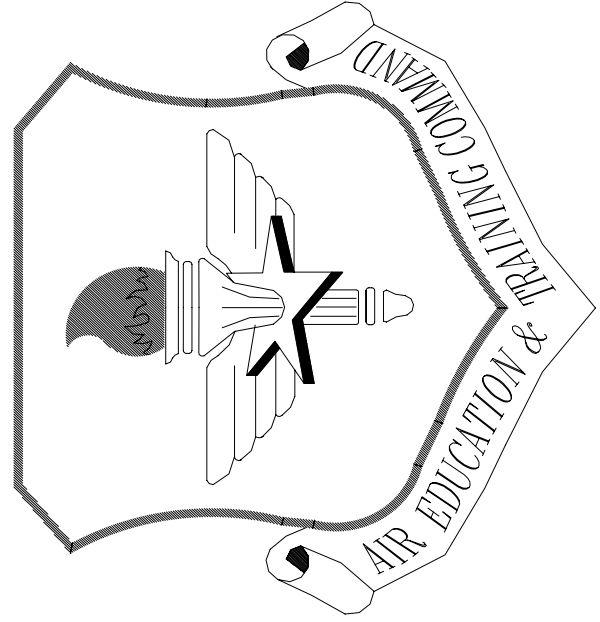

LITTLE ROCK A.F.B.
ARKANSAS

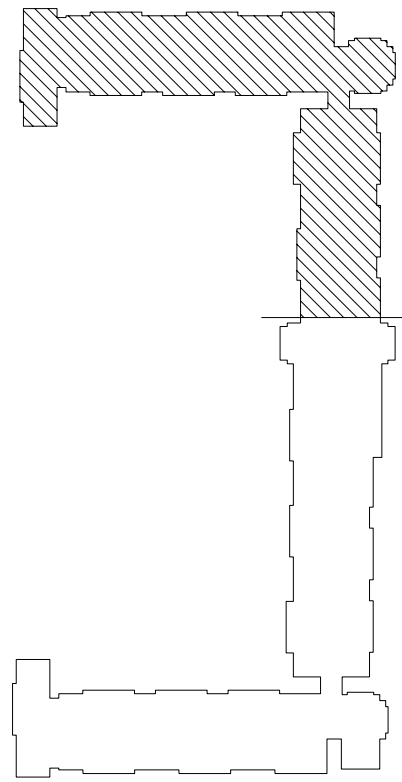

KEY PLAN

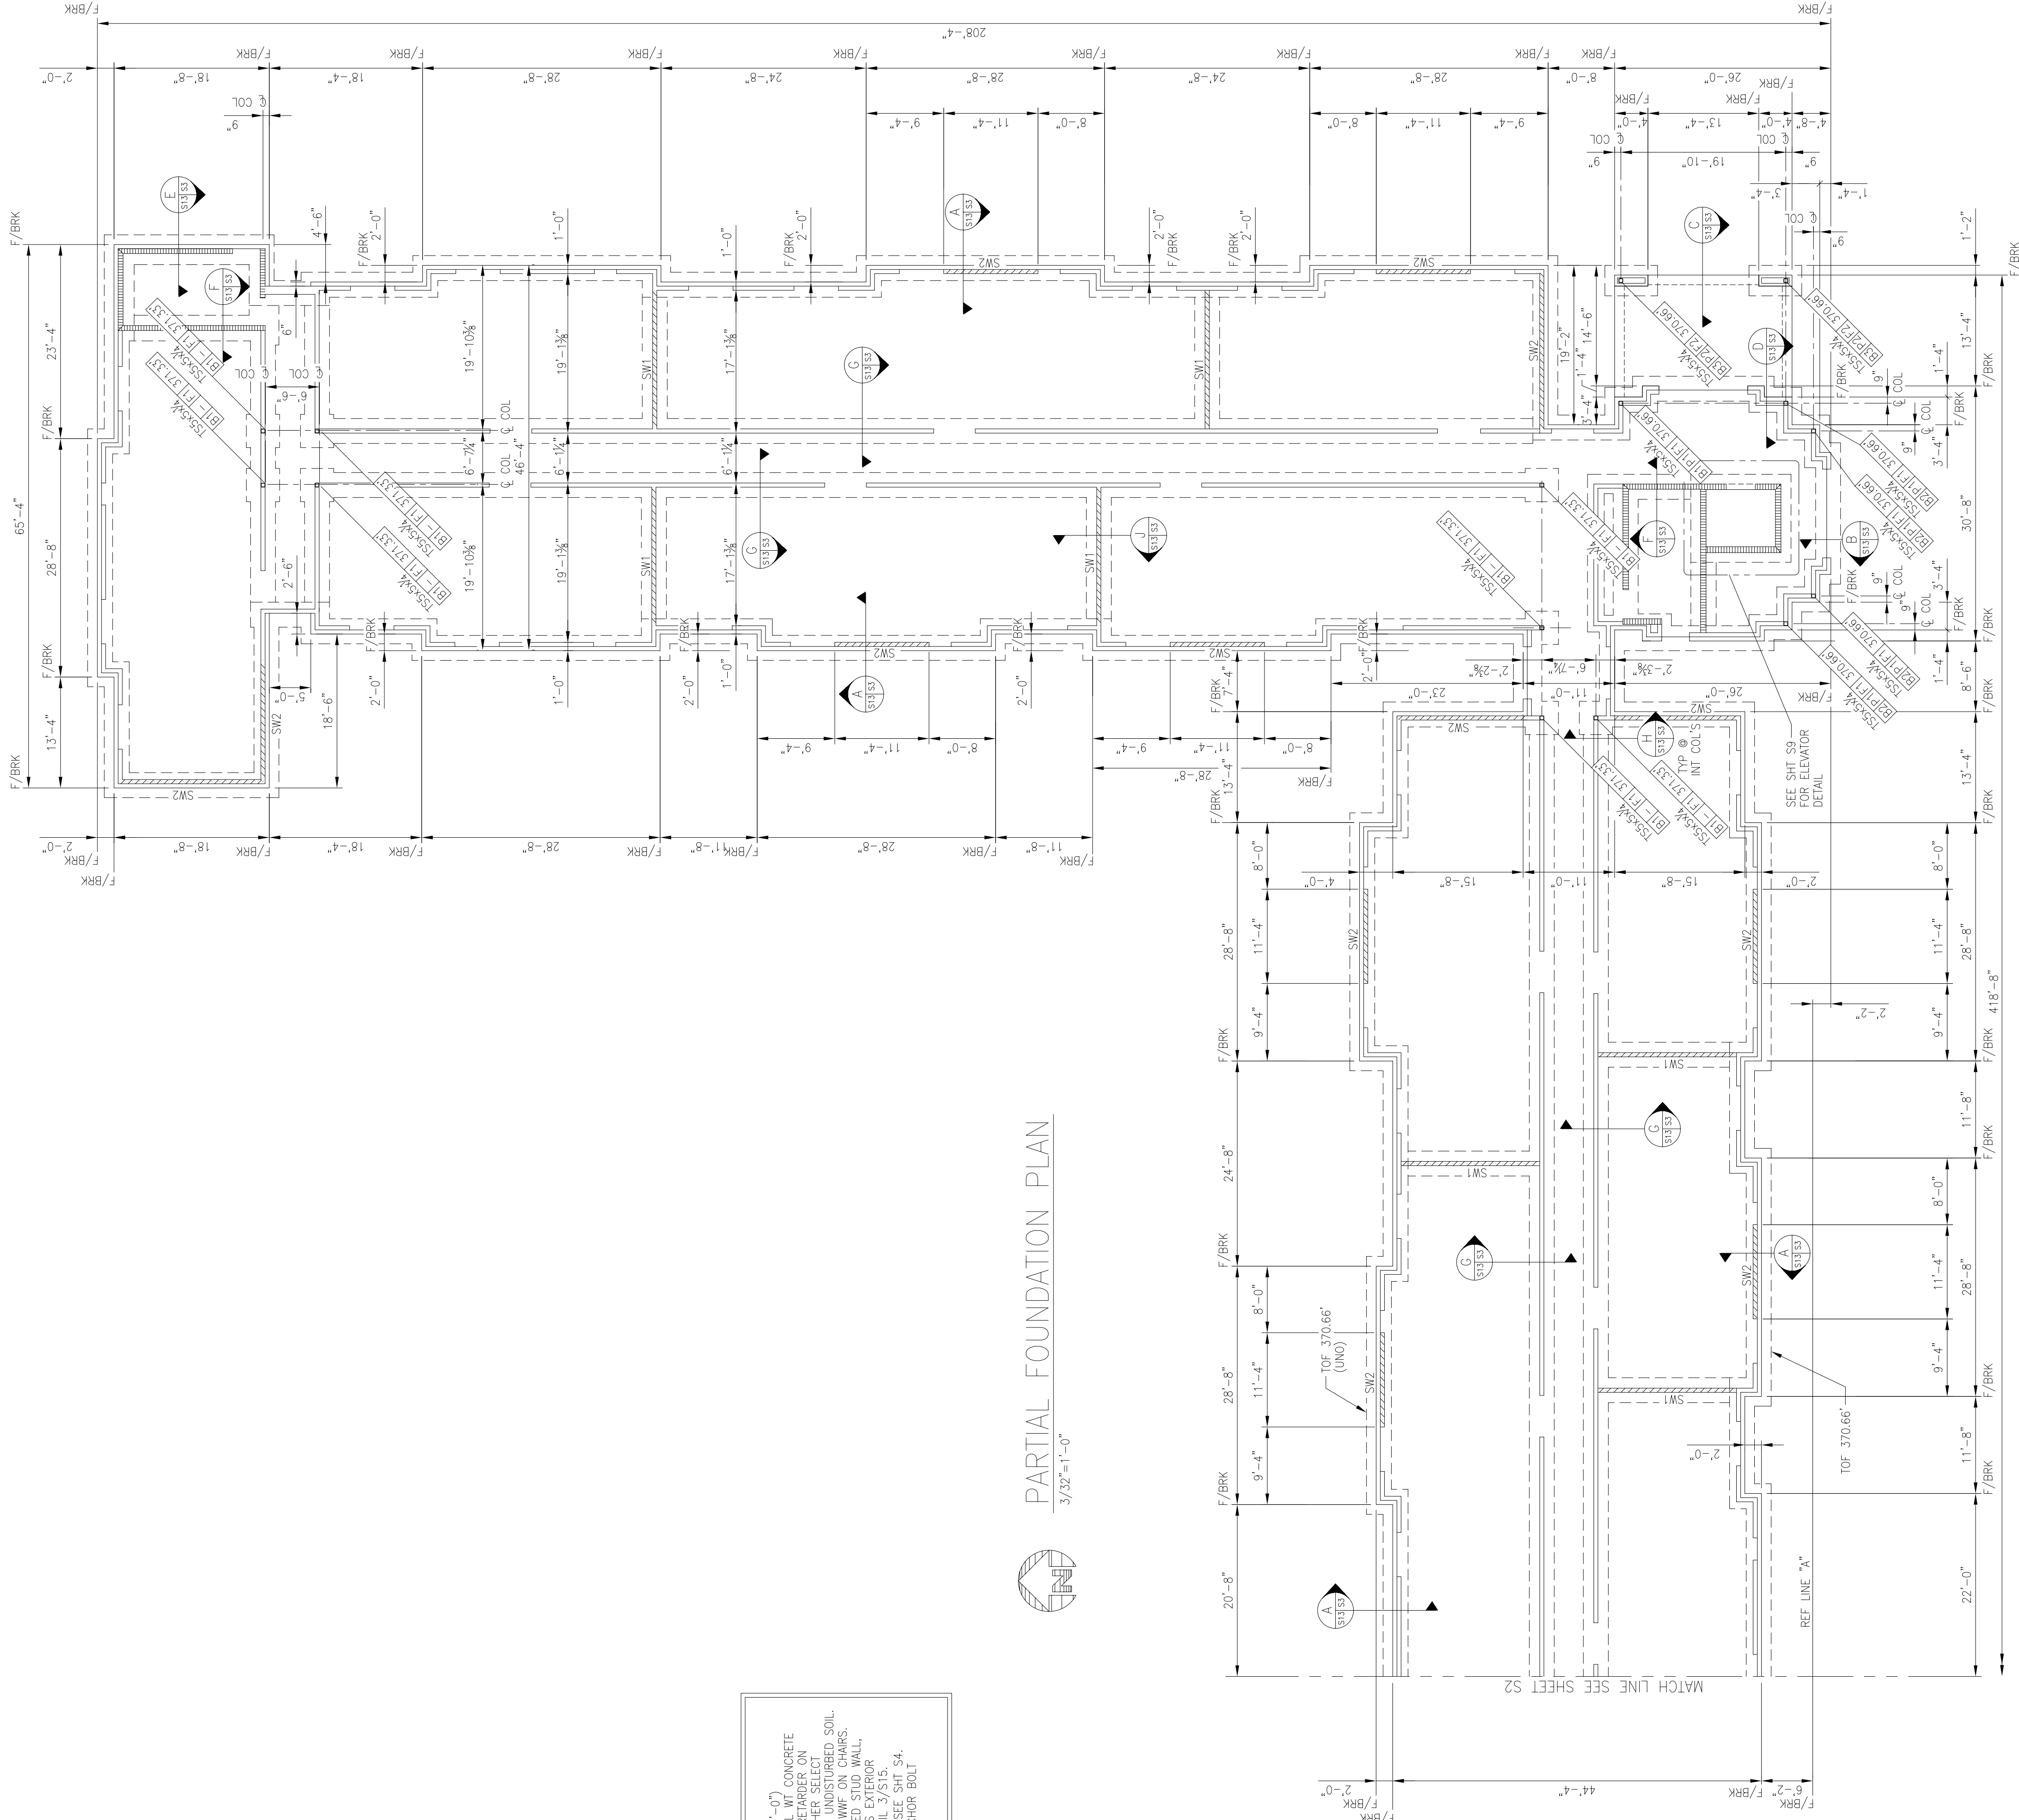

PARTIAL FOUNDATION PLAN

$$\frac{3}{32}'' = 1' - 0''$$
[illegible]

PROJECT TITLE

TEMPORARY LODGING FACILITY

SHEET TITLE

PARTIAL
FOUNDATION
PLAN

AS-BUILT

DRAWN BY MO	LEAD DESIGNER TVR
TECH REVIEWER	FILE LOCATION
DESIGNED BY TVR	PROJECT NUMBER NKAK02-5001
DATE 28 MAY 2002	SHEET S3
SCALE 3/32" = 1'-0"	43 OF 108

TES: FINISH FLOOR EL. 372.00" (REF. 0'-0")
FLOOR CONSTRUCTION: 1" NORMAL WT. CONCRETE
ON 4" 2 LAYERS OF 6 MIL WPOF RETARDER ON
4" INCHES GRANULAR FILL ON EITHER SELECT
COMPECTED STRUCTURAL FILL OR UNDISTURBED SOIL.
REINFORCEMENT: 6x6-W2-3W2/3 W/IF ON CHAIRS.
SNT INDICATES INTERIOR X-BRACED STUD WALL.
SEE DETAIL 2/5/51 SW2 INDICATES EXTERIOR
X-BRACED STUD WALL. SEE DETAIL 3/5/51.
FOR CONTRACTION JOINT LAYOUT SEE SHT. S4.
FOR COLUMN, PEDESTAL AND ANCHOR BOLT
SCHEDULE SEE SHT. S11.