


LITTLE ROCK A.F.B.  
ARKANSAS

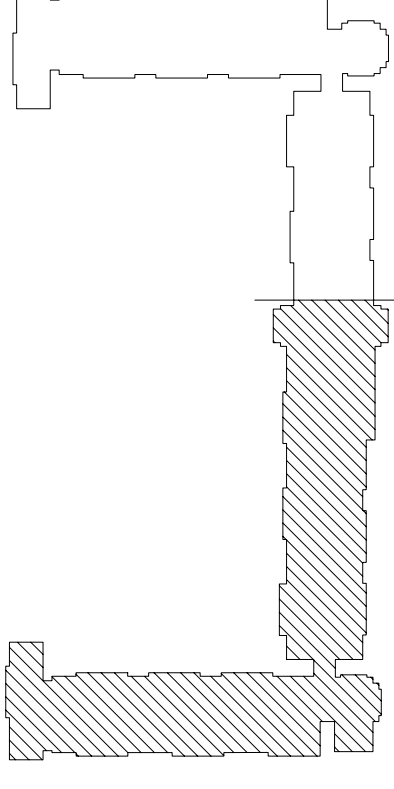


KEY PLAN

- NOTES:
1. REFERENCE SECTION A/S11 FOR CONTRACTION JOINT DETAIL FOR SLABS ON GRADE.
  2. REFERENCE DETAIL 2/S21 FOR CONTRACTION JOINT DETAIL FOR ELEVATED SLAB.

PARTIAL CONTRACTION JOINT PLAN FIRST AND SECOND FLOOR



3/32"=1'-0"

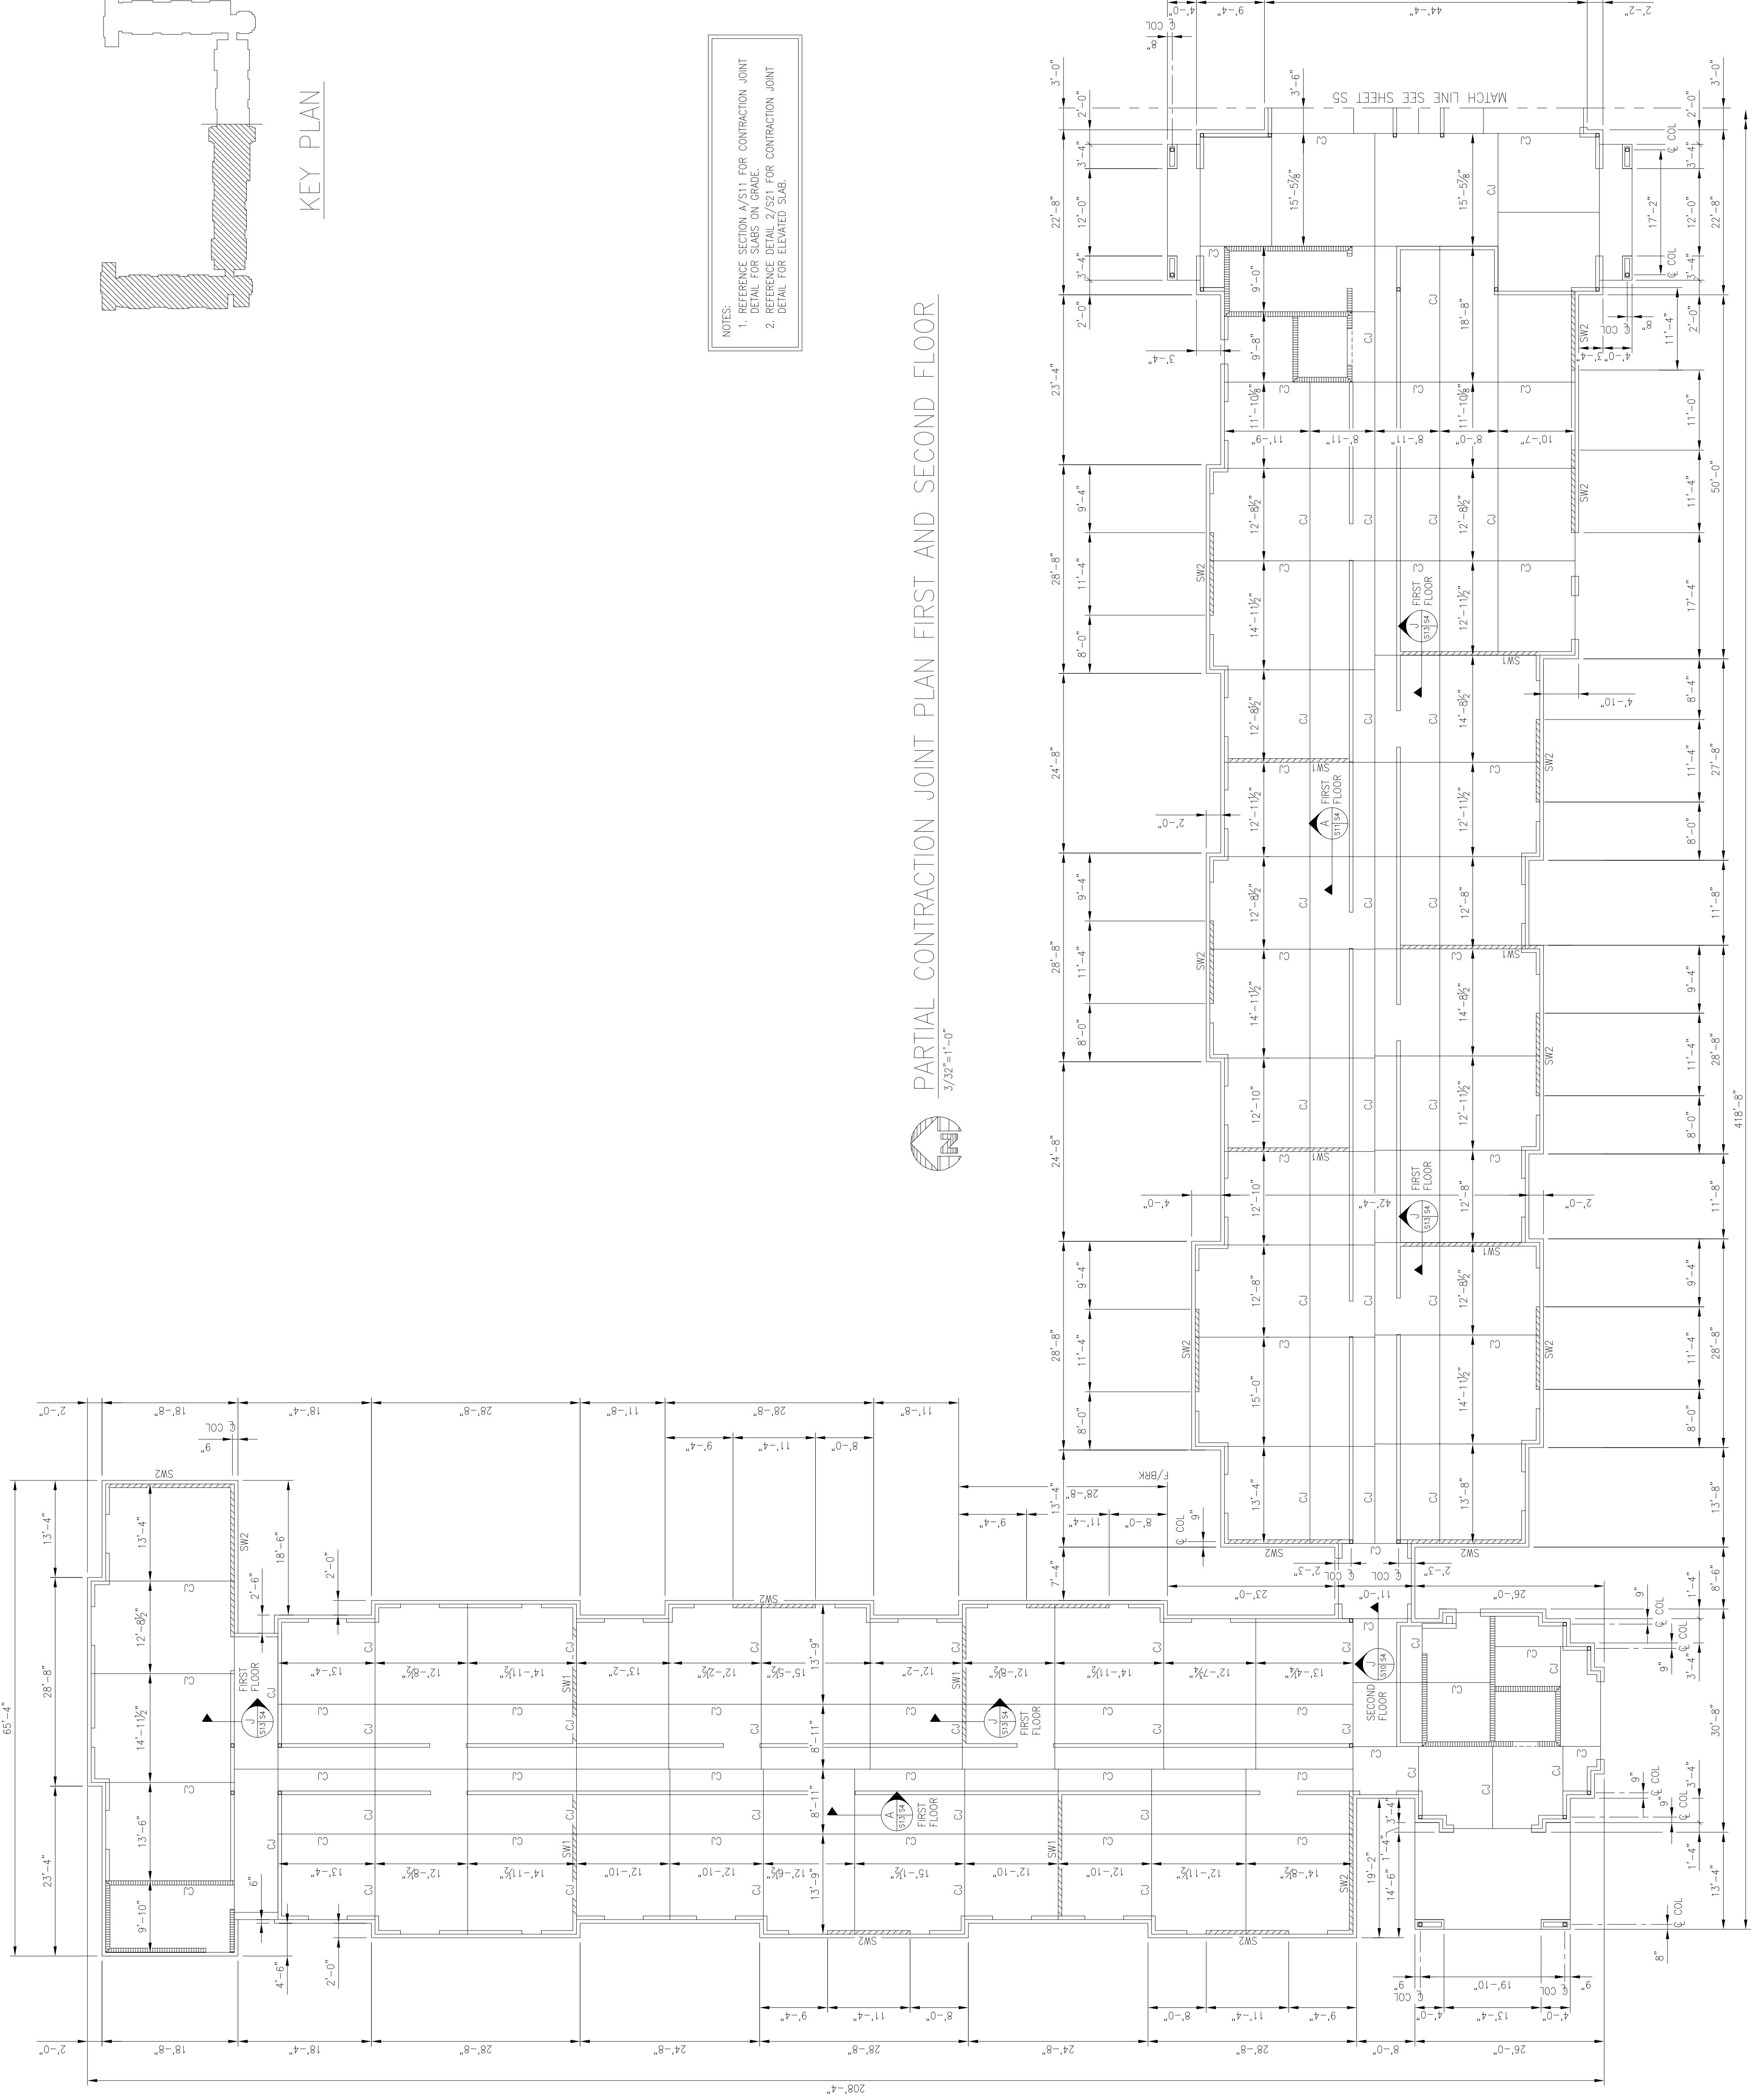

No.	Revision/Issue	Date	BY	APP'D
1	No Changes from Design to As-Built			

PROJECT TITLE  
**TEMPORARY LODGING FACILITY**

SHEET TITLE  
**PARTIAL CONTRACTION JOINT PLAN AS-BUILT**

LEAD DESIGNER TVR	PROJECT NUMBER NKAK02-5001	SHEET <b>S4</b>	44 of 108
TECH REVIEWER TVR	DATE 28 MAY 2002		
SCALE 3/32"=1'-0"			