



LITTLE ROCK A.F.B.
ARKANSAS

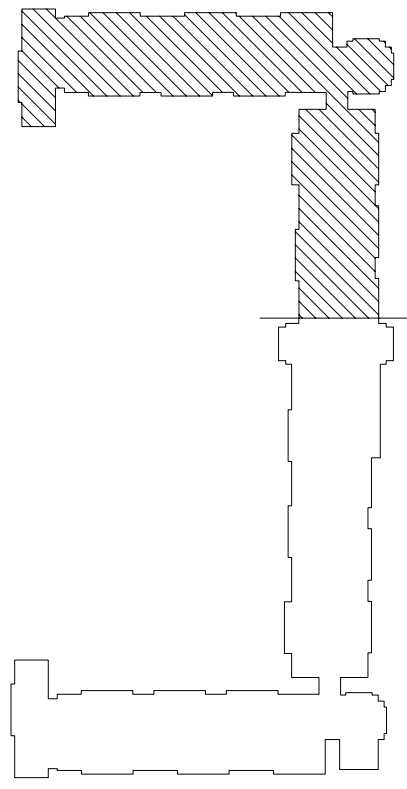

KEY PLAN

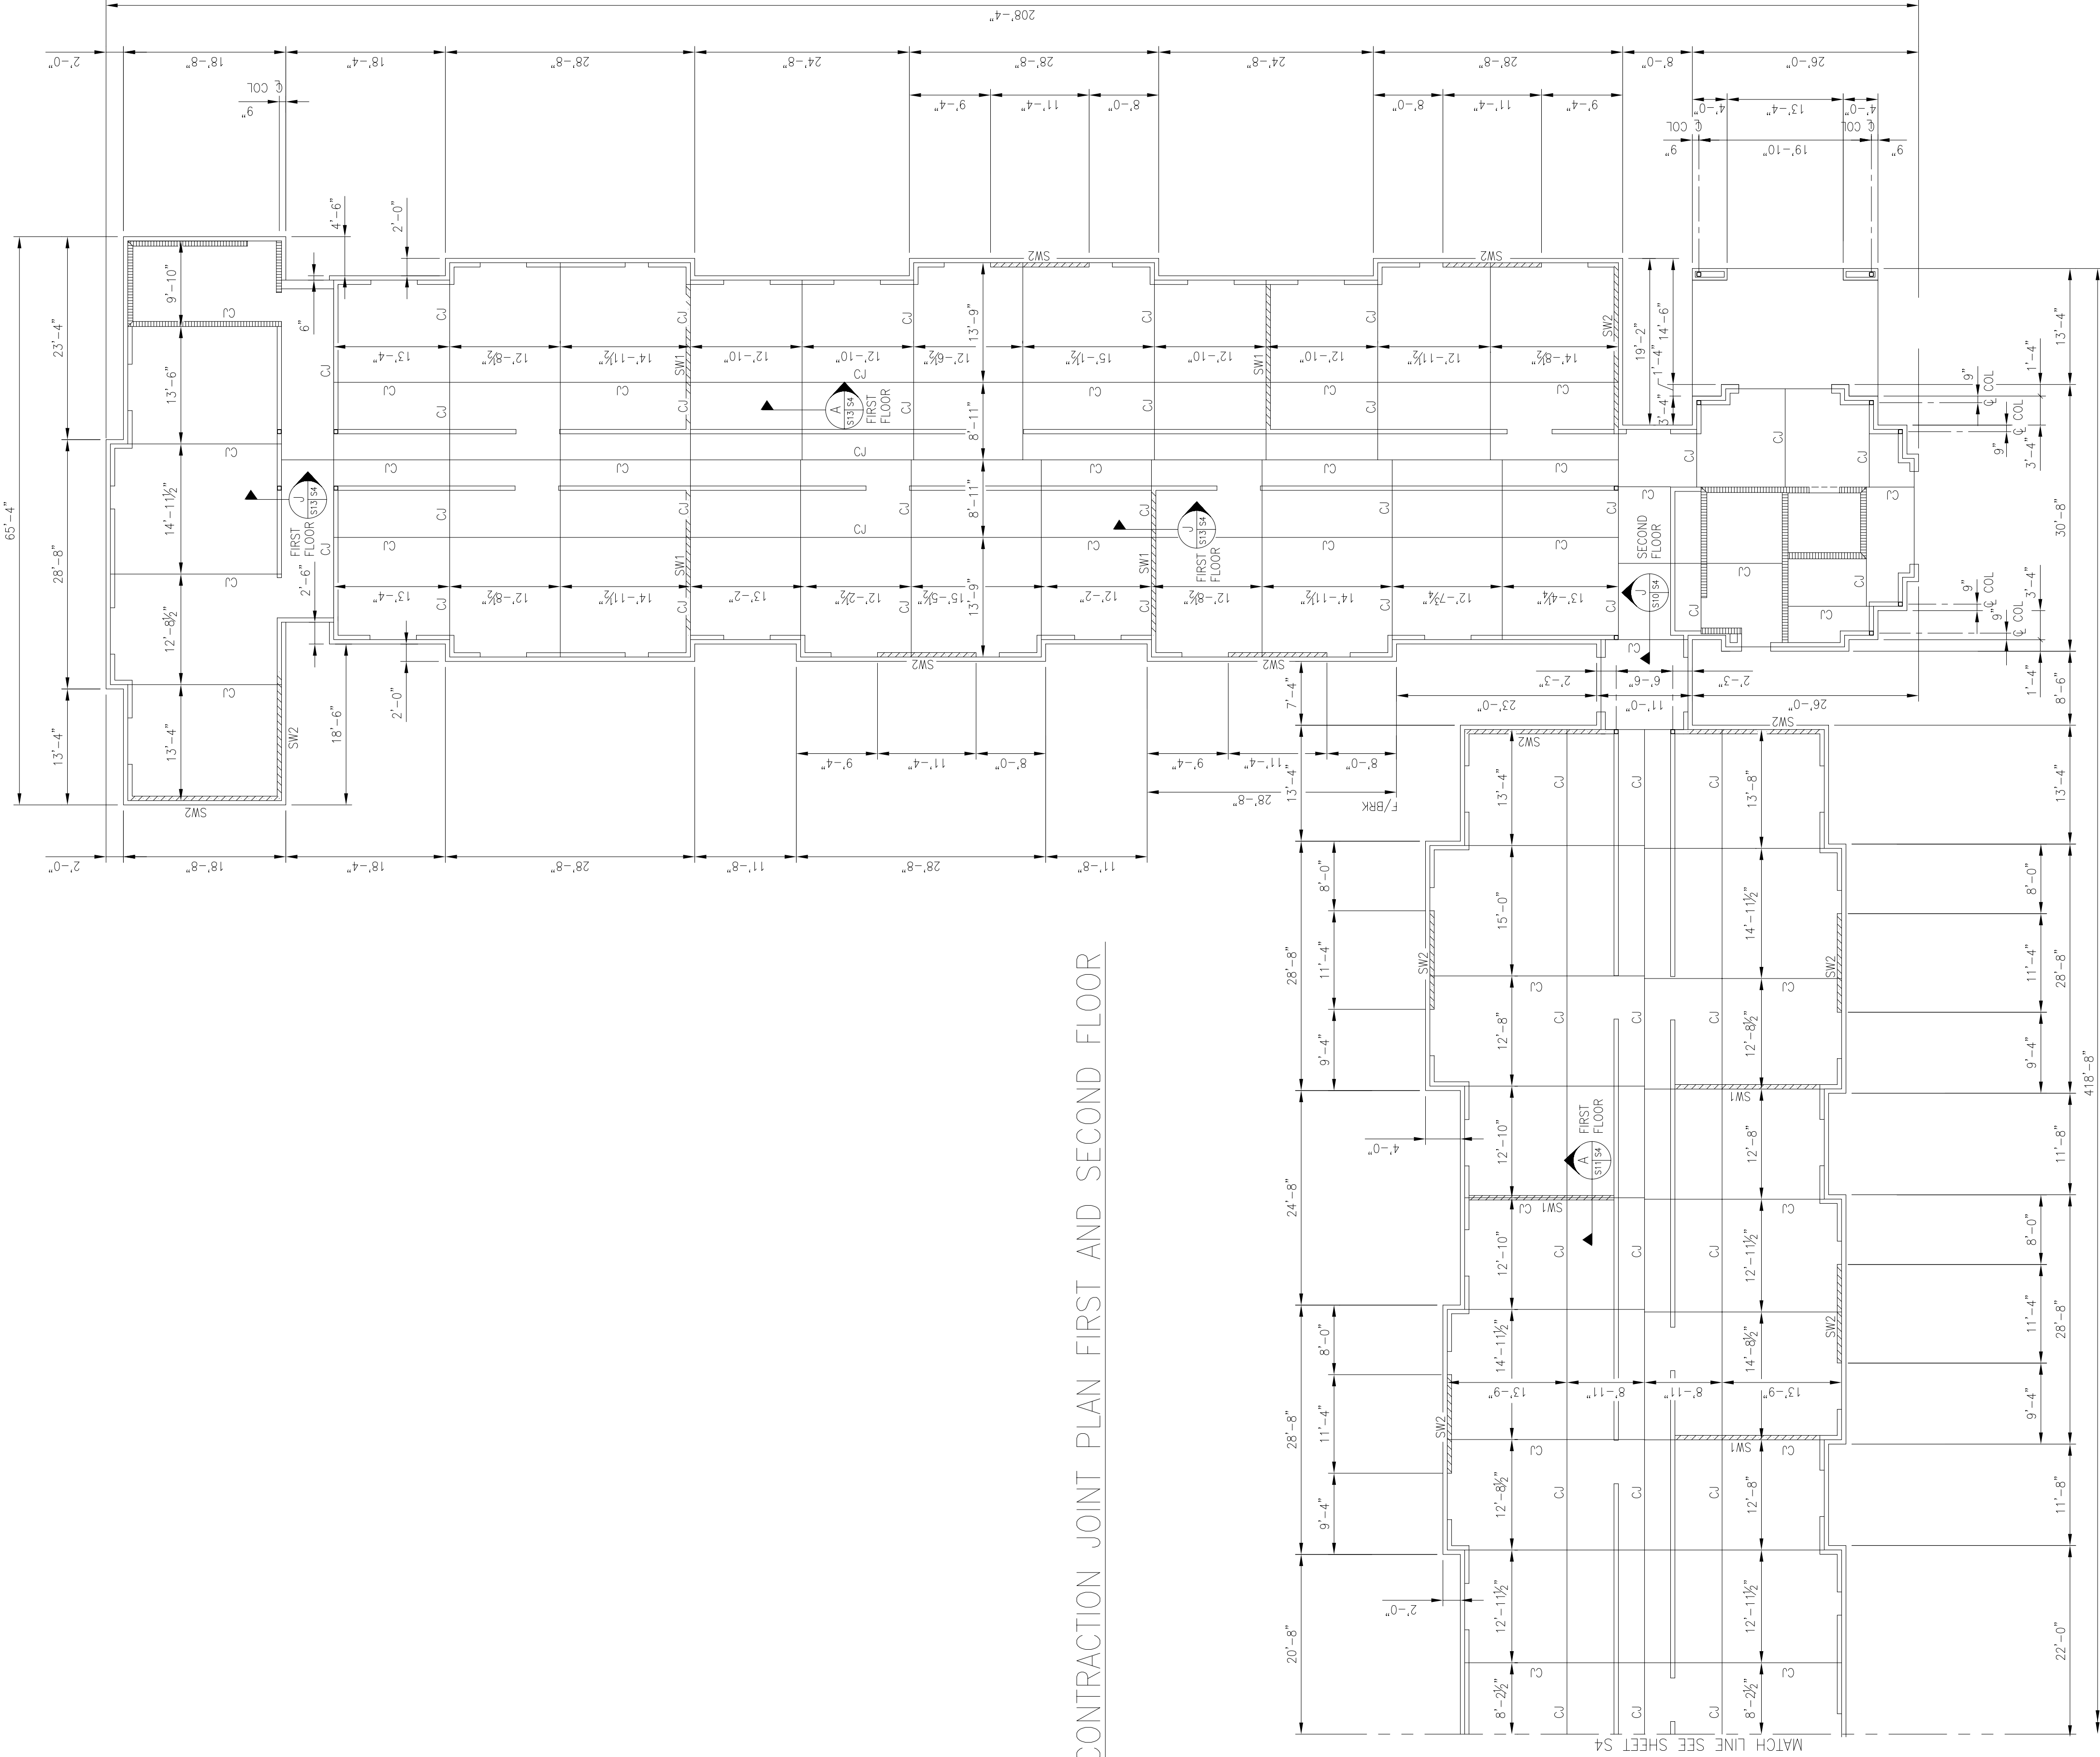

NOTES:

1. REFERENCE SECTION 4/S11 FOR CONTRACTION JOINT DETAIL FOR SLABS ON GRADE.
2. REFERENCE DETAIL 2/S21 FOR CONTRACTION JOINT DETAIL FOR ELEVATED SLAB.



PARTIAL CONTRACTION JOINT PLAN FIRST AND SECOND FLOOR
3/32"=1'-0"

[illegible]

PROJECT TITLE

TEMPORARY LODGING FACILITY

SHEET TITLE

PARTIAL
CONTRACTION JOINT
PLAN
AS-BUILT

DRAWN BY MO	LEAD DESIGNER TVR	PROJECT NUMBER NKAK02-5001	SHEET S5
TECH REVIEWER	FILE LOCATION		
DATE 28 MAY 2002	DESIGNED BY TVR	45 of 108	
SCALE 3/32" = 1'-0"			