

[illegible]

PROJECT TITLE



TEMPORARY LODGING
FACILITY

SHEET TITLE

PARTIAL
ROOF FRAMING
PLAN

AS-BUILT


DOWN BY MO	LEAD DESIGNER TVR
TECH REVIEWER	FILE LOCATION
DESIGNED BY TVR	PROJECT NUMBER NKAK02-5001
DATE 28 MAY 2002	SHEET S8
SCALE 3/32"=1'-0"	48 OF 108

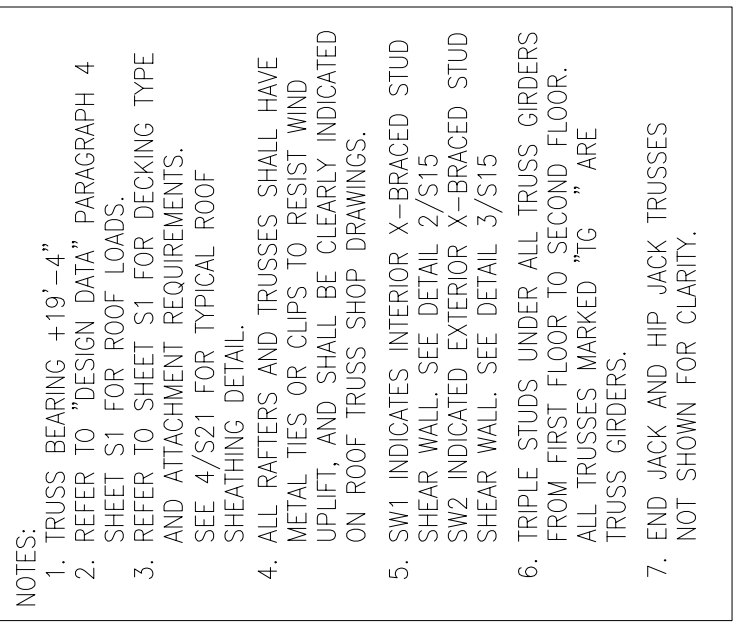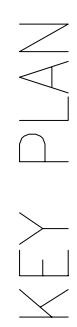


PARTIAL INTERMEDIATE FRAMING PLAN



ROOF FRAMING PLAN

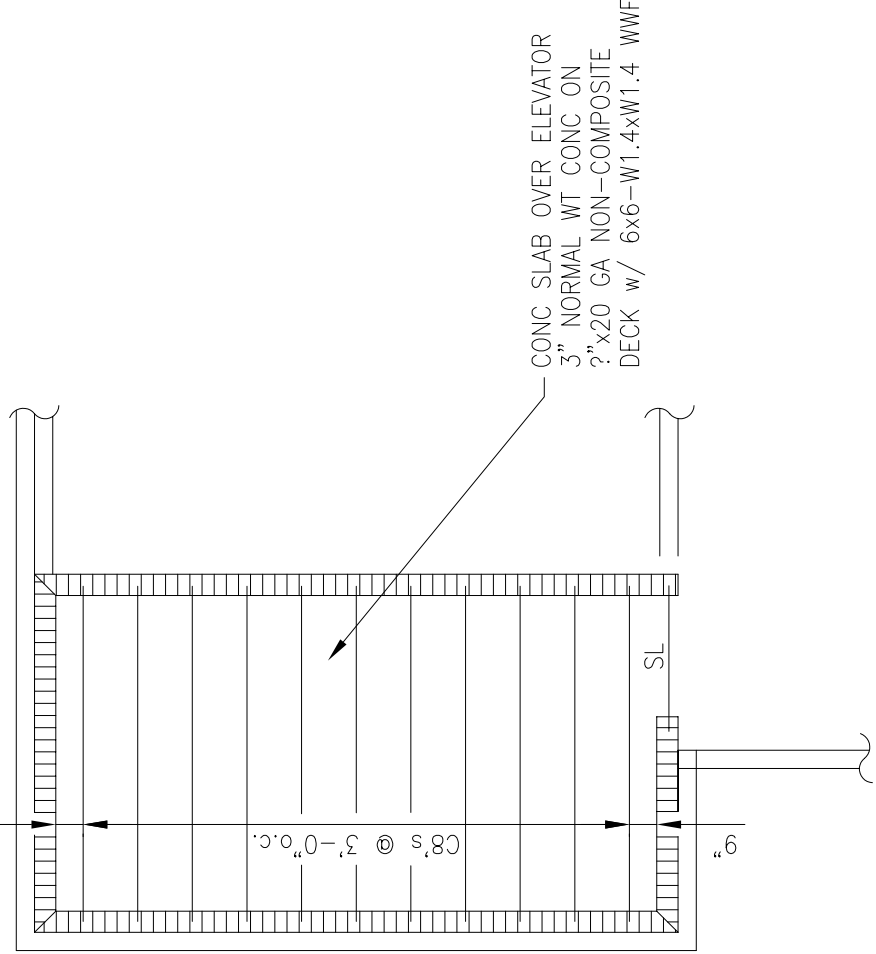

PARTIAL ROOF FRAMING PLAN

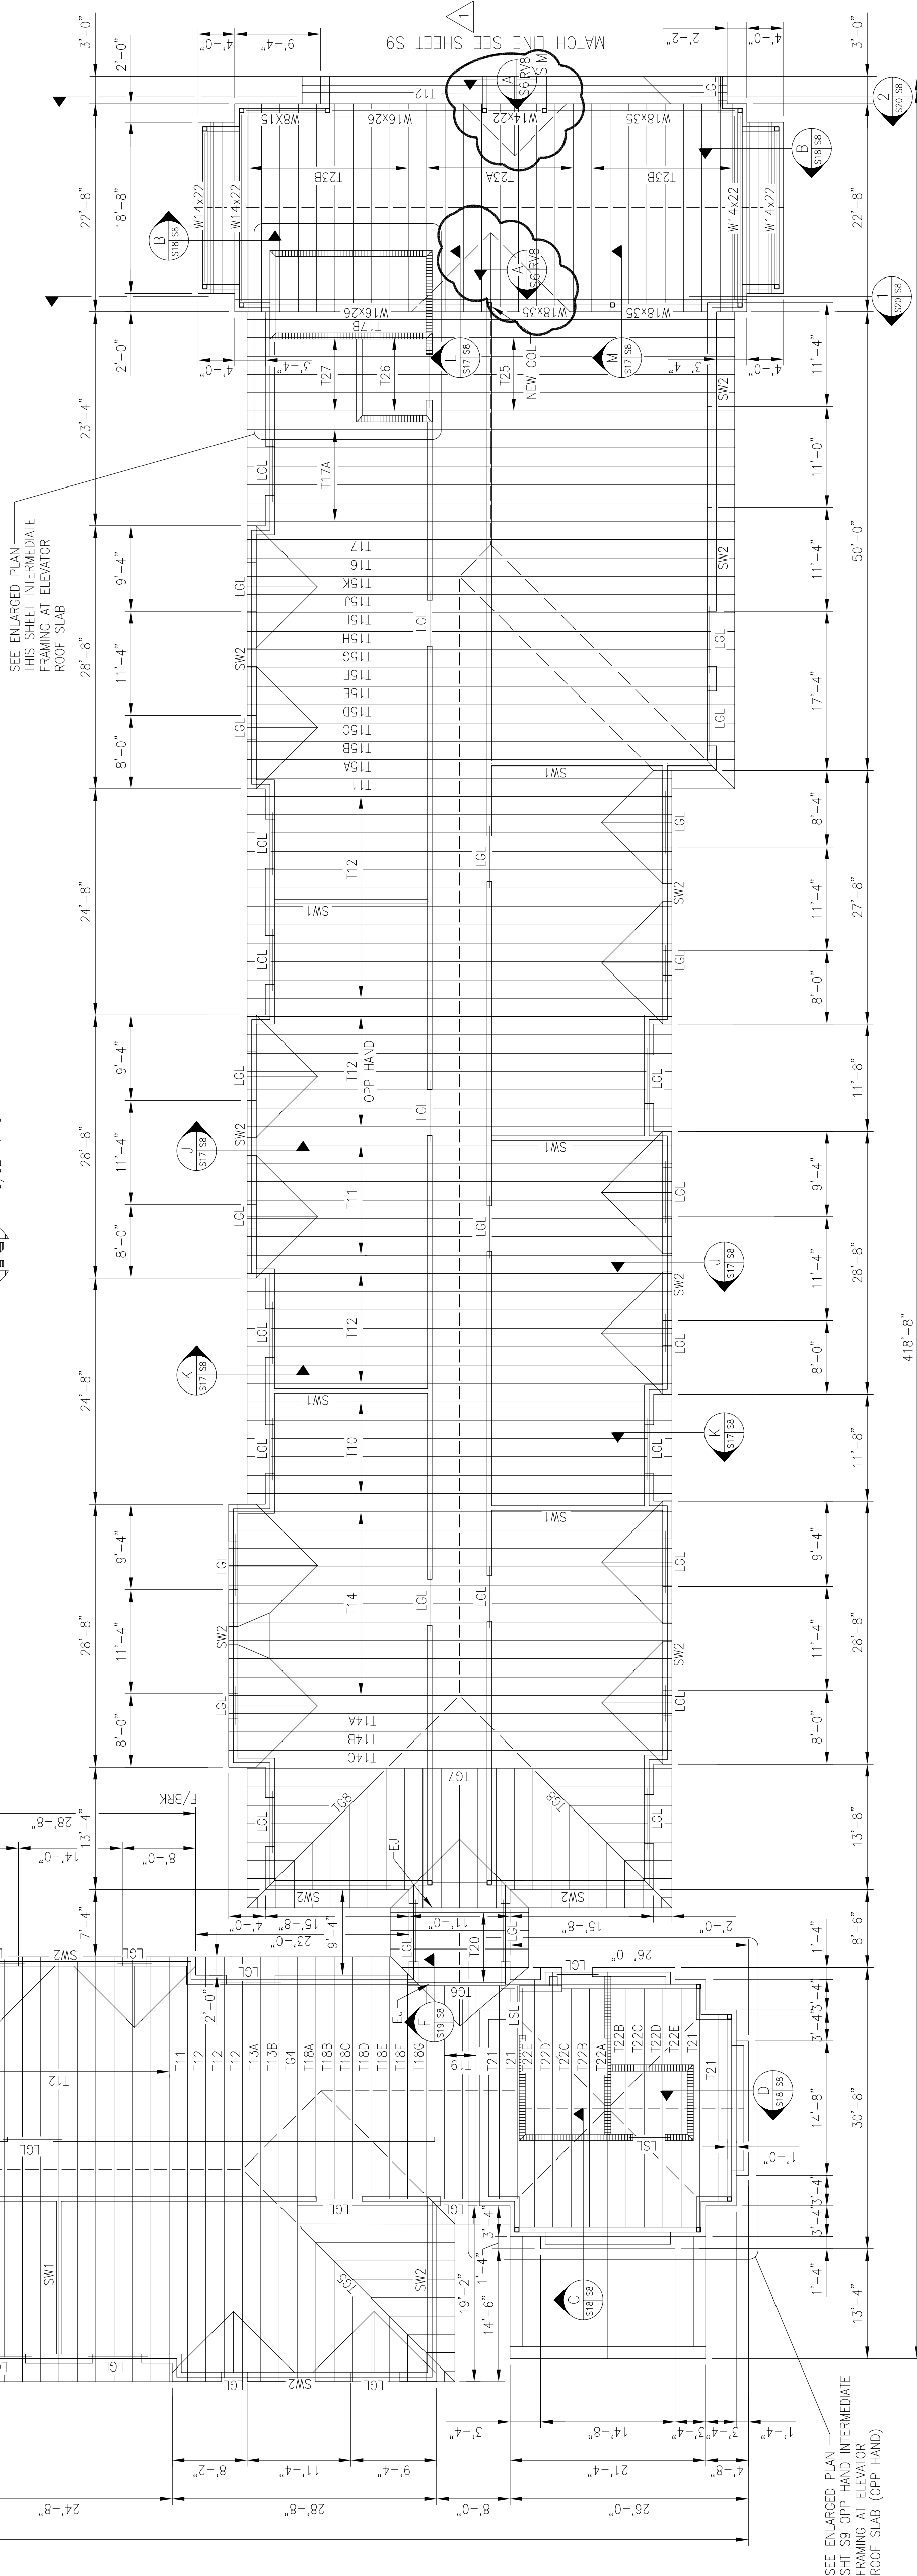

SEE ENLARGED PLAN —
SHT S9 OPP HAND INTERMEDIATE
FRAMING AT ELEVATOR
ROOF SLAB (OPP HAND)