
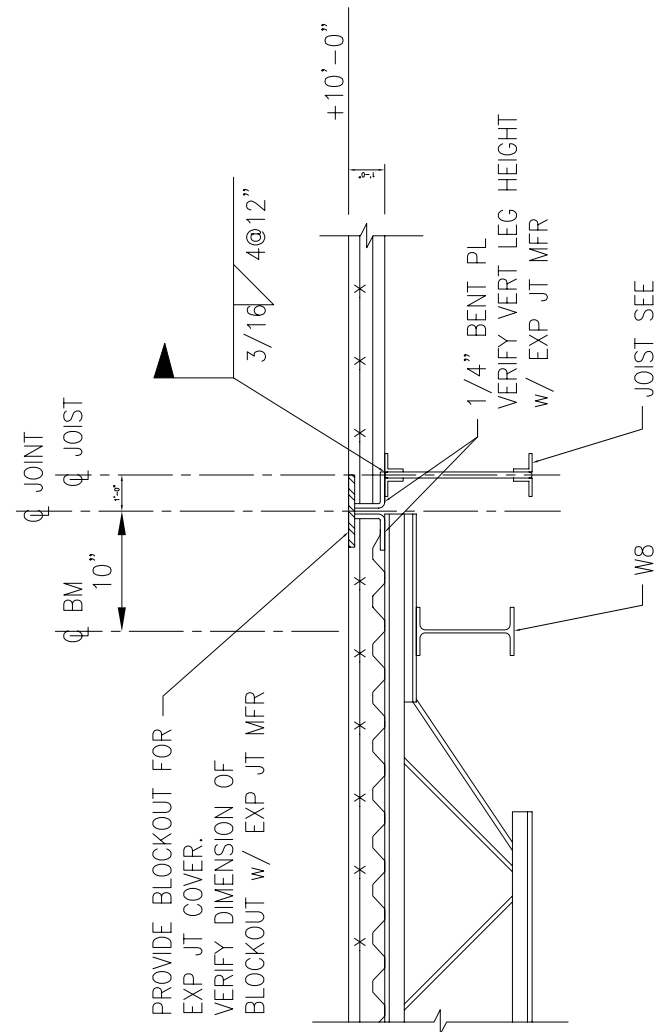
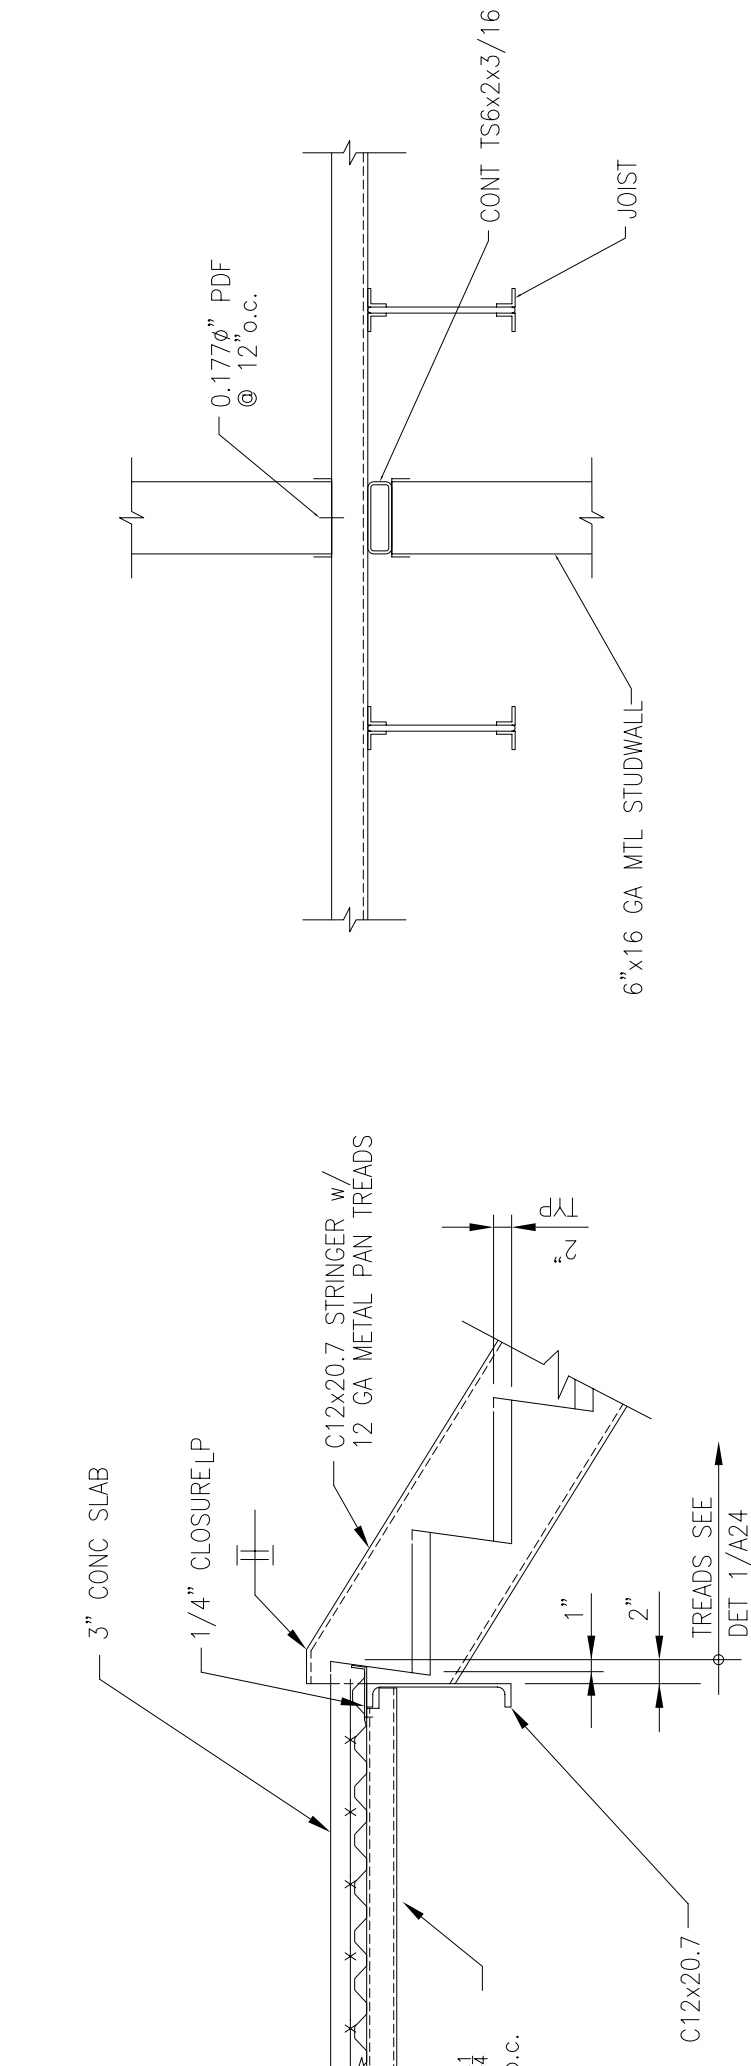
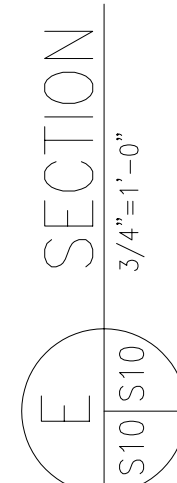
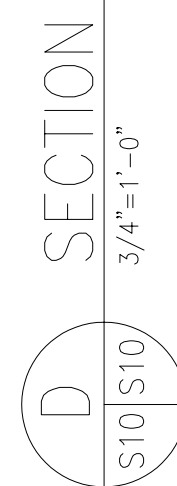
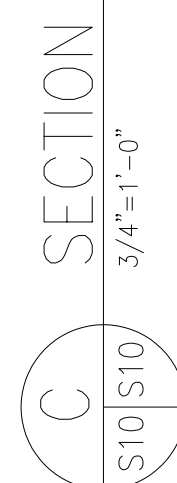
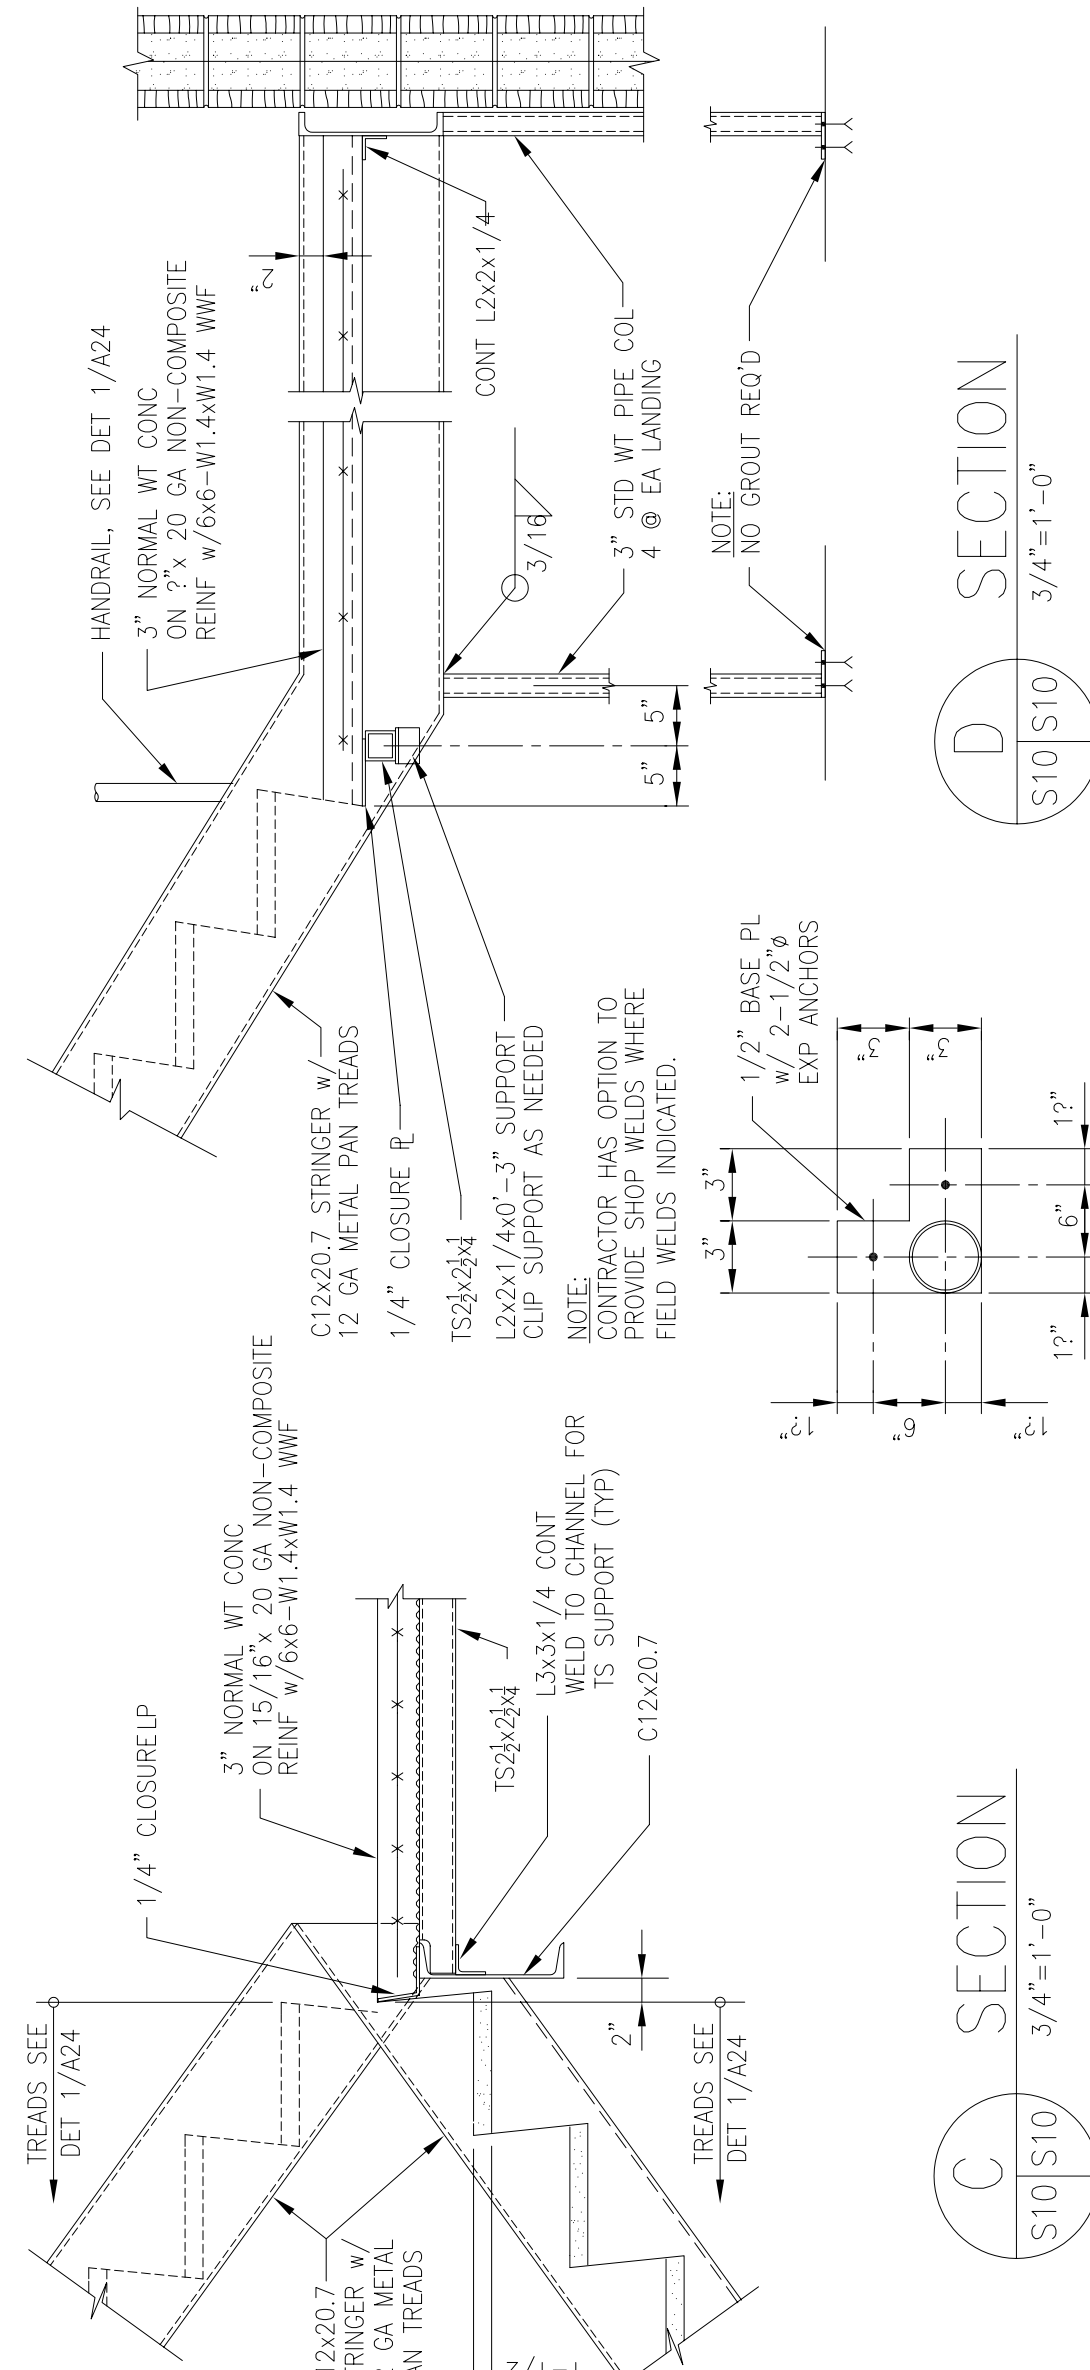
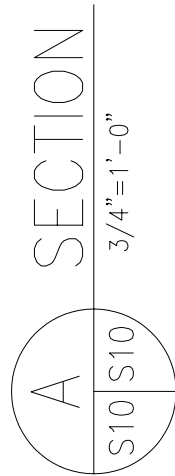
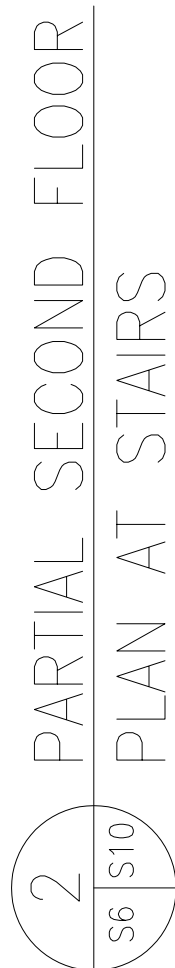


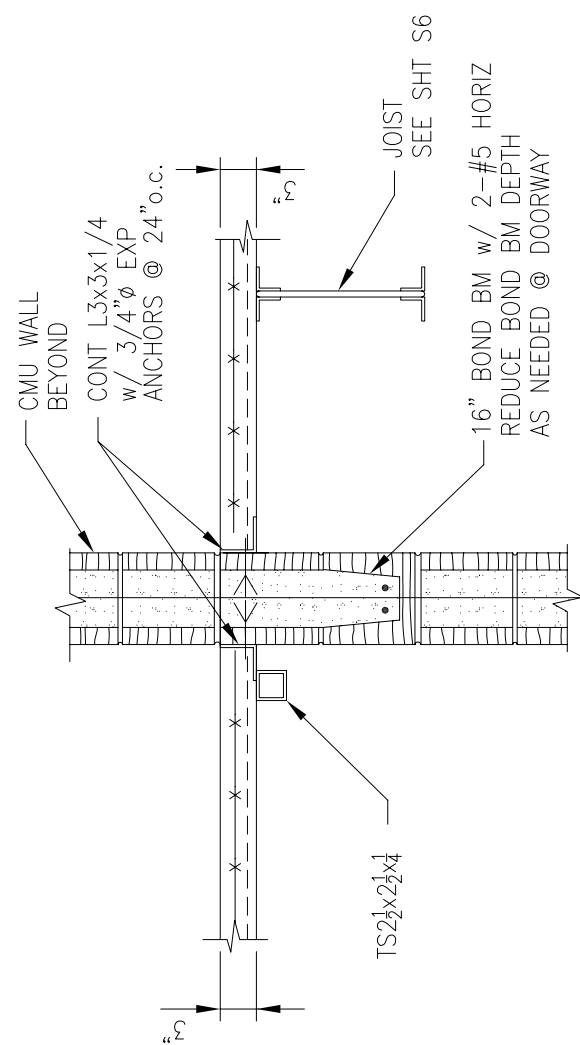

DRAWN BY MO	LEAD DESIGNER IVR
TECH REVIEWER	FILE LOCATION
DESIGNED BY IVR	PROJECT NUMBER NKAK02-5001
DATE 28 MAY 2002	SHEET S10
SCALE 3/16"=1'-0"	50 or 108

[illegible]

PROJECT TITLE
TEMPORARY LODGING
FACILITY

SHEET TITLE

PARTIAL SECOND
FLOOR PLAN
AT STAIRS

AS-BUILT

DATE 28 MAY 2002	SHEET 50 OF 108
SCALE 3/16"=1'-0"	