


KEYED CONTROL JOINT

TYPICAL @ SLAB CONTRACTION JOINT
UNLESS NOTED OTHERWISE



S3 S11 NOT TO SCALE

NOT TO SCALE

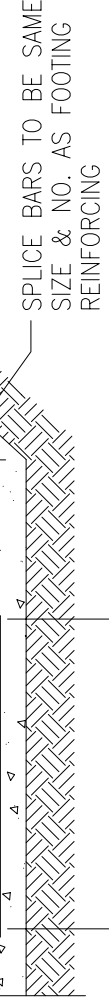

S3	S11
----	-----

NOT TO SCALE



SCALE

ANCHOR BOLT SCHEDULE						
BOLT DIA. (D)	LENGTH (L)		HOOK (H)	MIN THRD	MIN PROJ	MAX PROJ
	TYPE					
	A	B				
3/4"	1'-0"	1'-0"	6"	4"	3-1/2"	6"

ROAD FOOTING SCHEDULE

ANCHOR BOLT NOTES

1. ANCHOR BOLTS SHALL MEET THE REQUIREMENTS OF ASTM A307 OR A36 UNLESS NOTED OTHERWISE.
2. ALL ANCHOR BOLTS SHALL BE FURNISHED WITH TWO(2) HEX NUTS AND CUT WASHERS OF SPECIFICATIONS COMPATIBLE WITH THOSE OF THE THREADED SHANKS UNLESS NOTED OTHERWISE.
3. THE LOWER NUT FOR CONVENTIONAL COLUMNS (W/ SHAPES & TS COLUMNS) THE LOWER NUT SHALL BE PLACED UNDER THE BASE PLATE AND SHALL BE USED FOR LEVELING



STANDARD ANCHOR BOLT TYPE A

ANCHOR BOLT TYPE B

[illegible]

1. BASE PLATE SCHEDULE

DETAIL BASE PLATE A

NOT TO SCALE
(TS COLUMN SHOWN, PIPE COLUMN SIMILAR)

NOTE:
1-1/2" NON-SHRINK
NON-METALIC GROUT

DETAIL BASE PLATE B




NOT TO SCALE
(TS COLUMN SHOWN, PIPE COLUMN SIMILAR)

NOTE:
1-1/2" NON-SHRINK
NON-METALIC GROUT

DETAIL BASE PLATE C

NOT TO SCALE
(TS COLUMN SHOWN, PIPE COLUMN SIMILAR)

NOTE:
1-1/2" NON-SHRINK
NON-METALIC GROUT

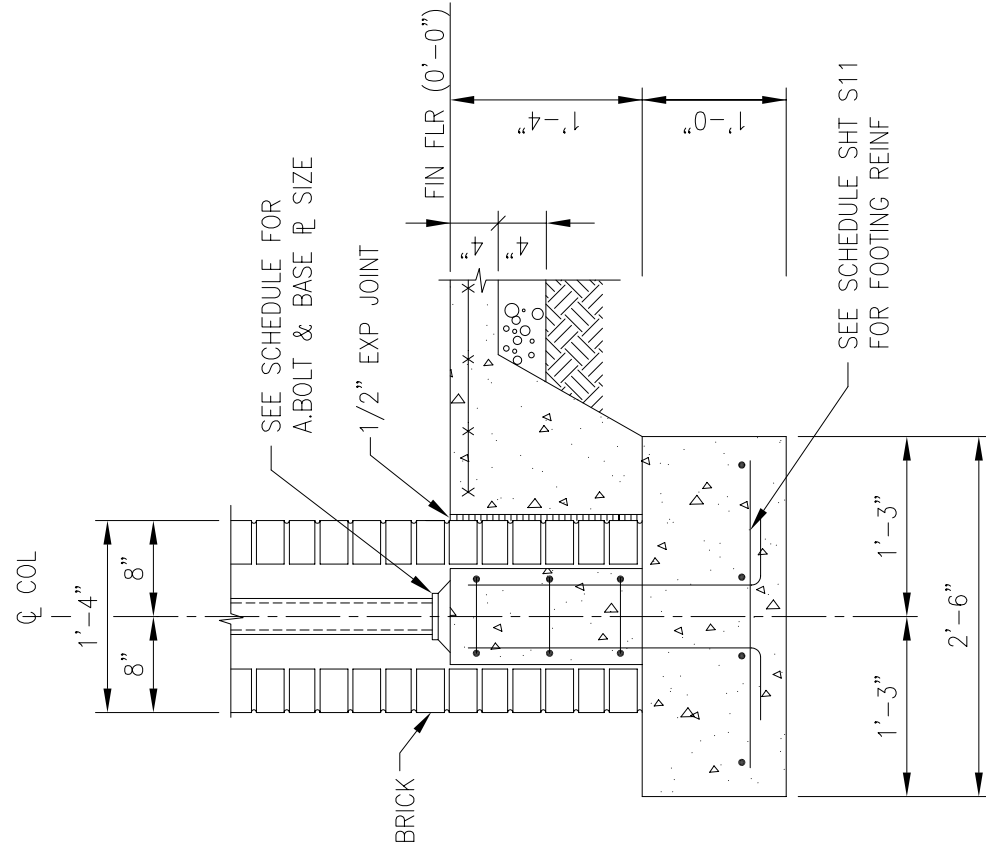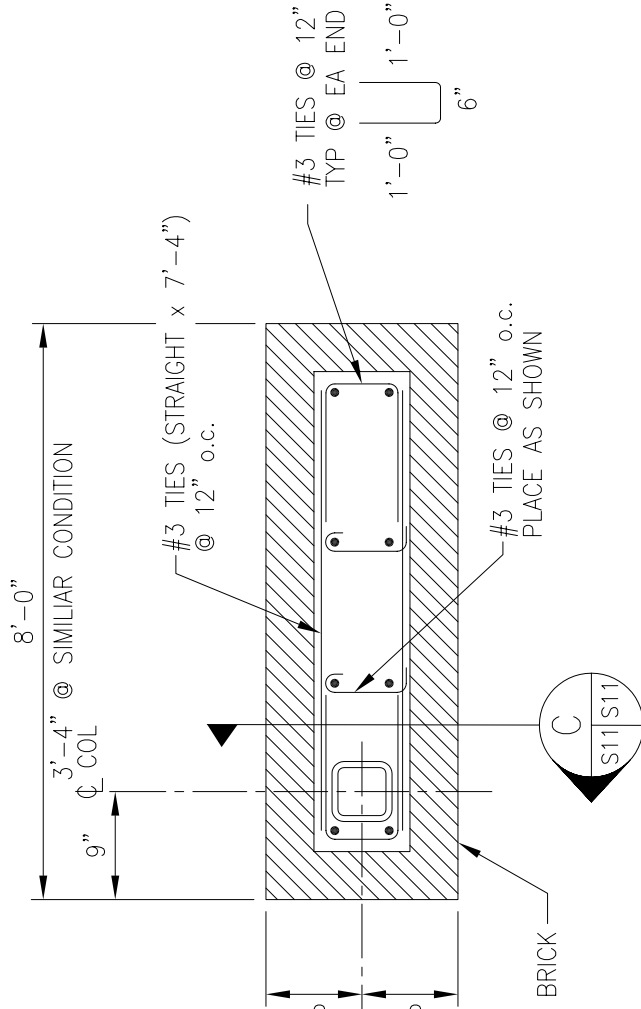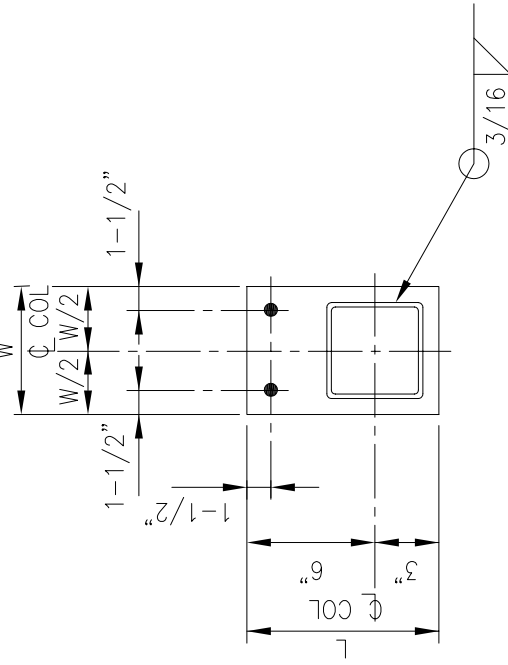

S2	S11	$3/4^n = 1 - 0^n$
----	-----	-------------------