



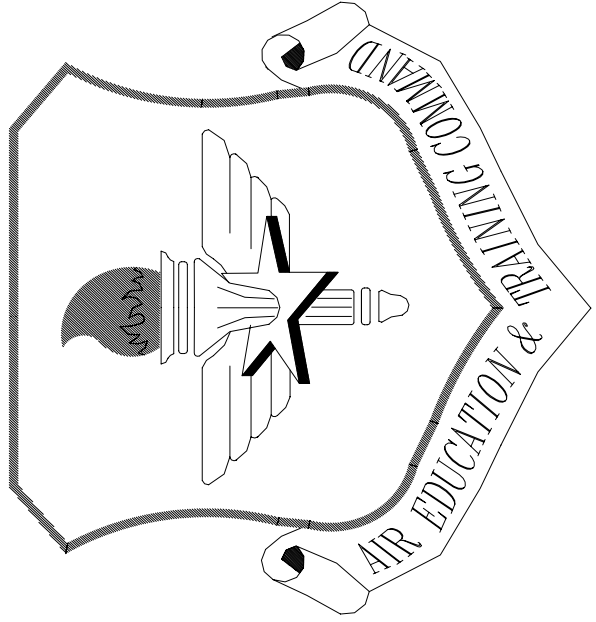

LITTLE ROCK A.F.B.
ARKANSAS

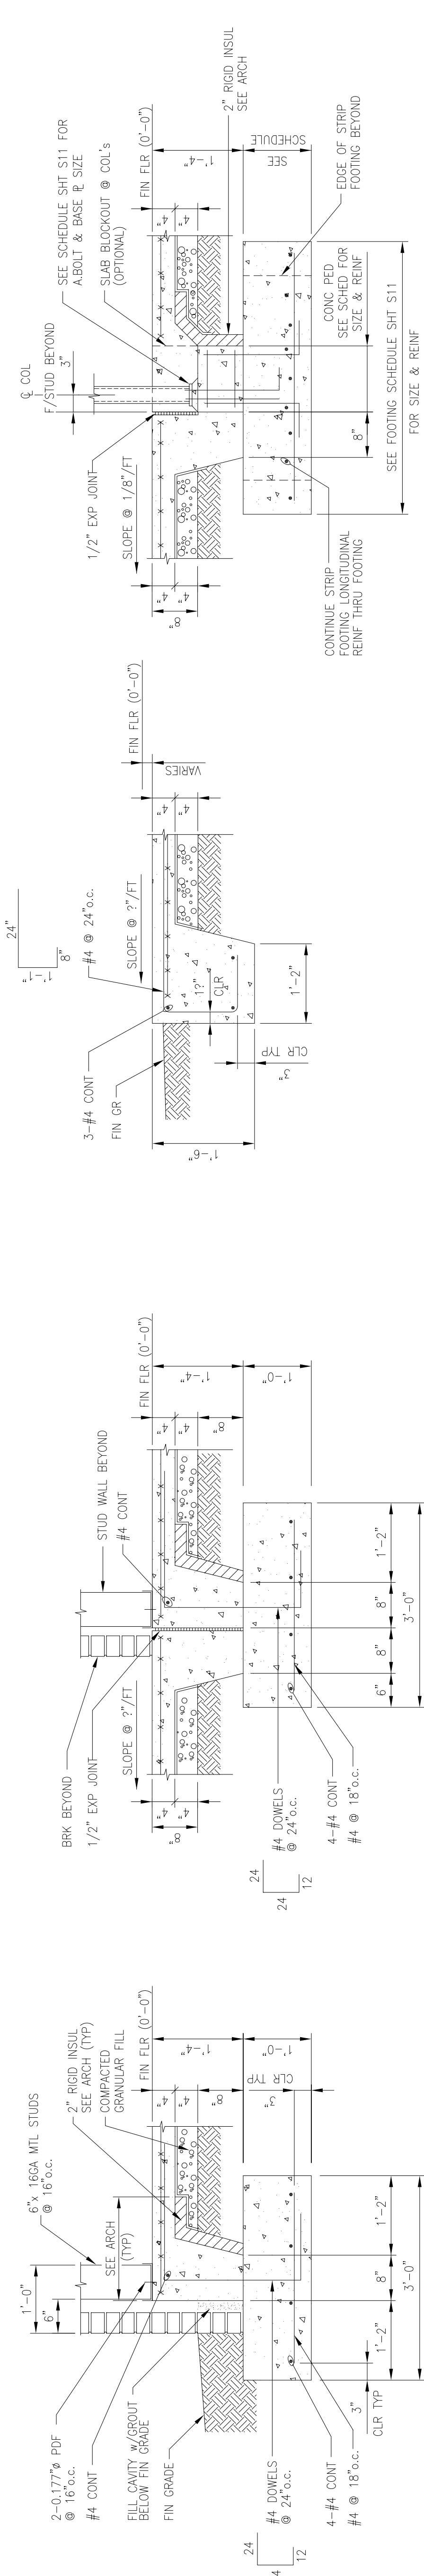


A SECTION
S2 S13 S3
3/4"=1'-0"


B SECTION
S2 S13 S3
3/4"=1'-0"

C SECTION
S2 S13 S3
3/4"=1'-0"


D SECTION
S2 S13 S3
3/4"=1'-0"

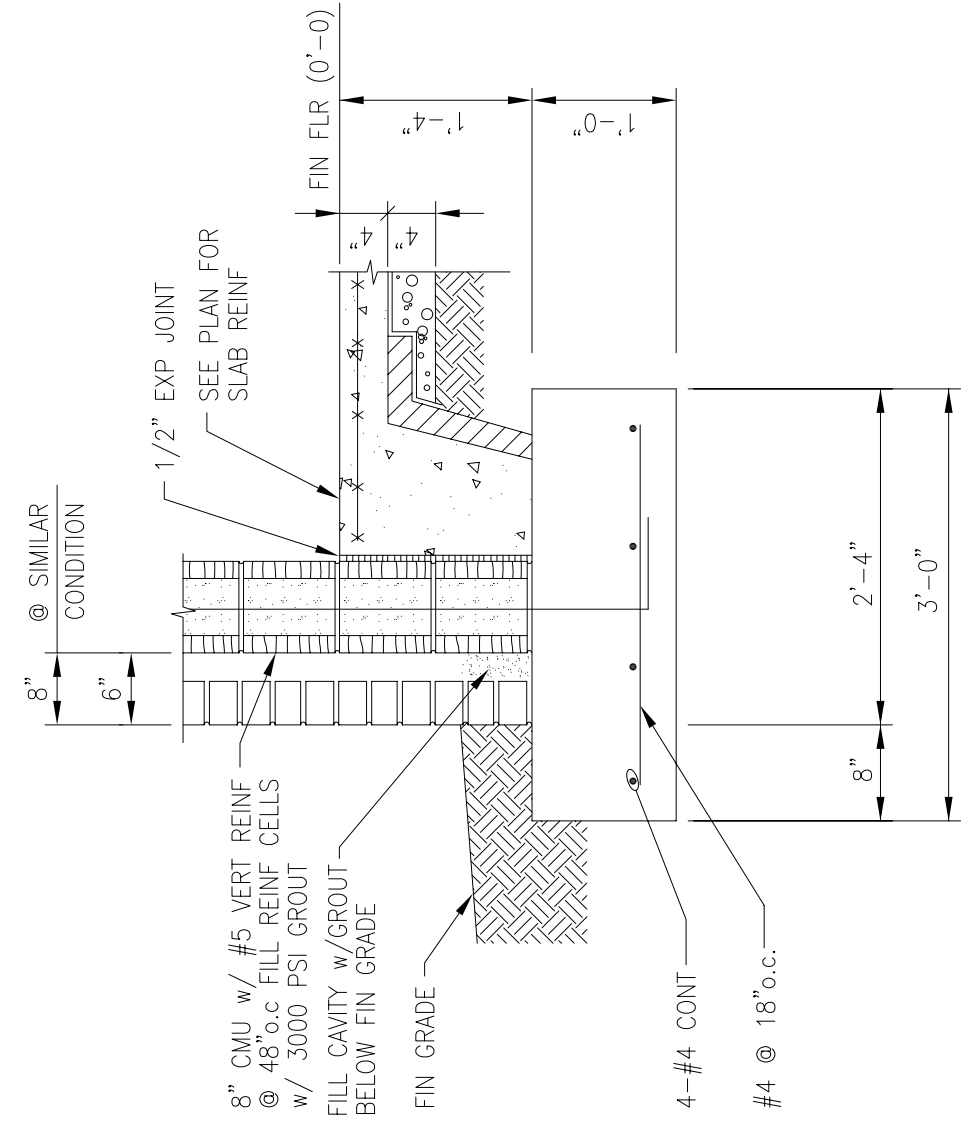


E SECTION
S2 S13 S3
3/4"=1'-0"

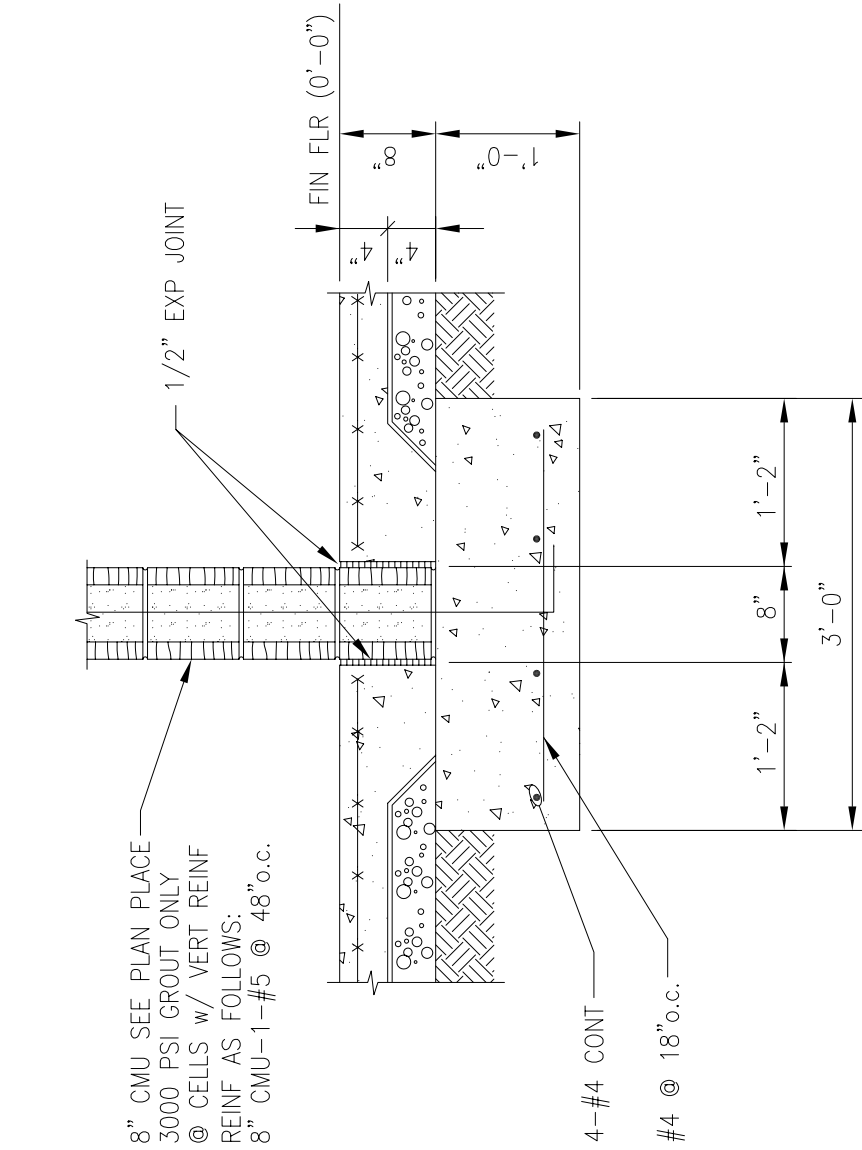


F SECTION
S2 S13 S3
3/4"=1'-0"

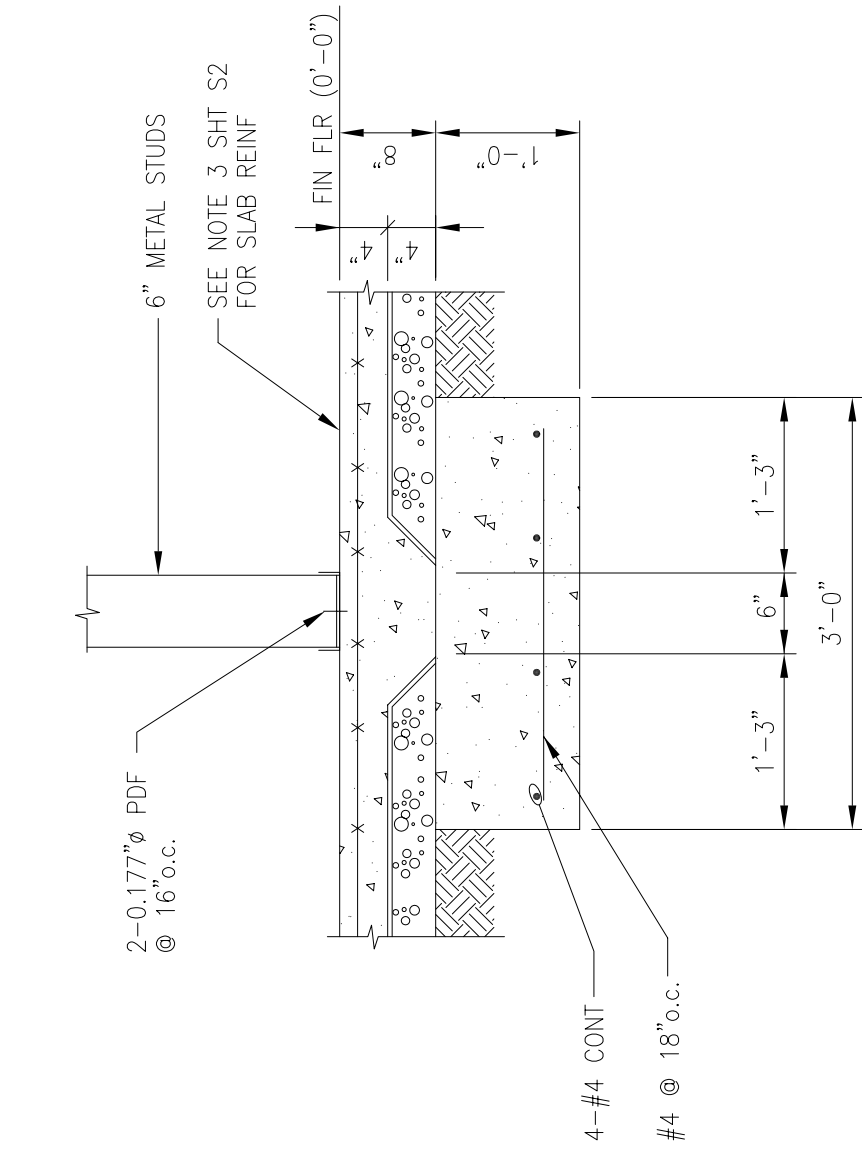


G SECTION
S2 S13 S3
3/4"=1'-0"

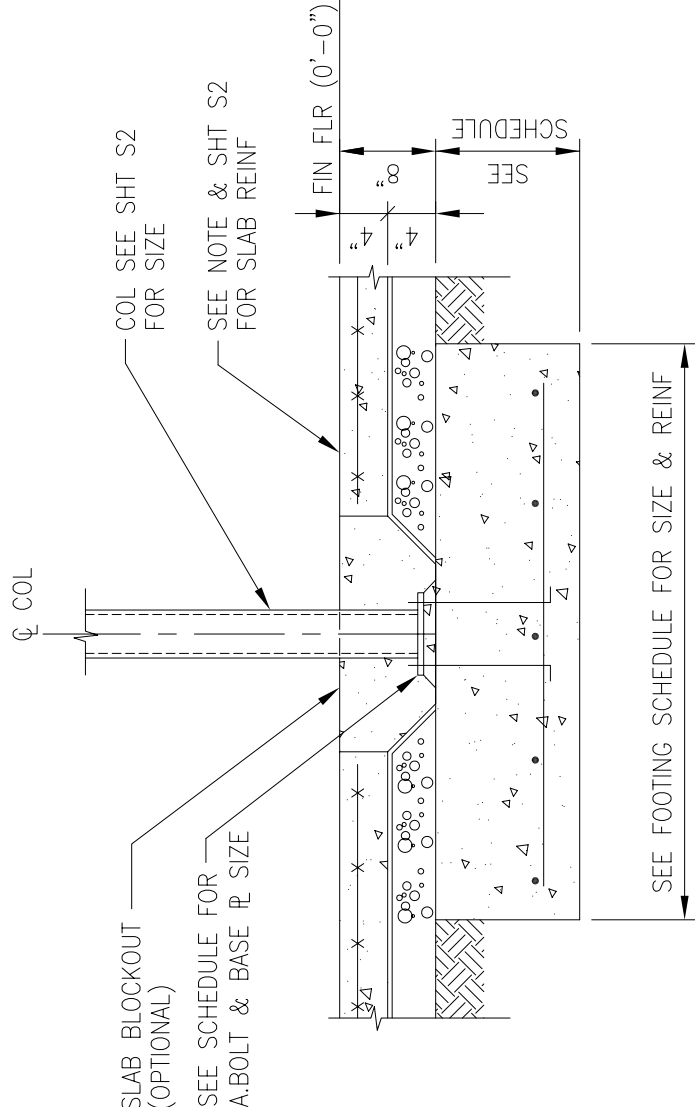


H SECTION
S2 S13 S3
3/4"=1'-0"

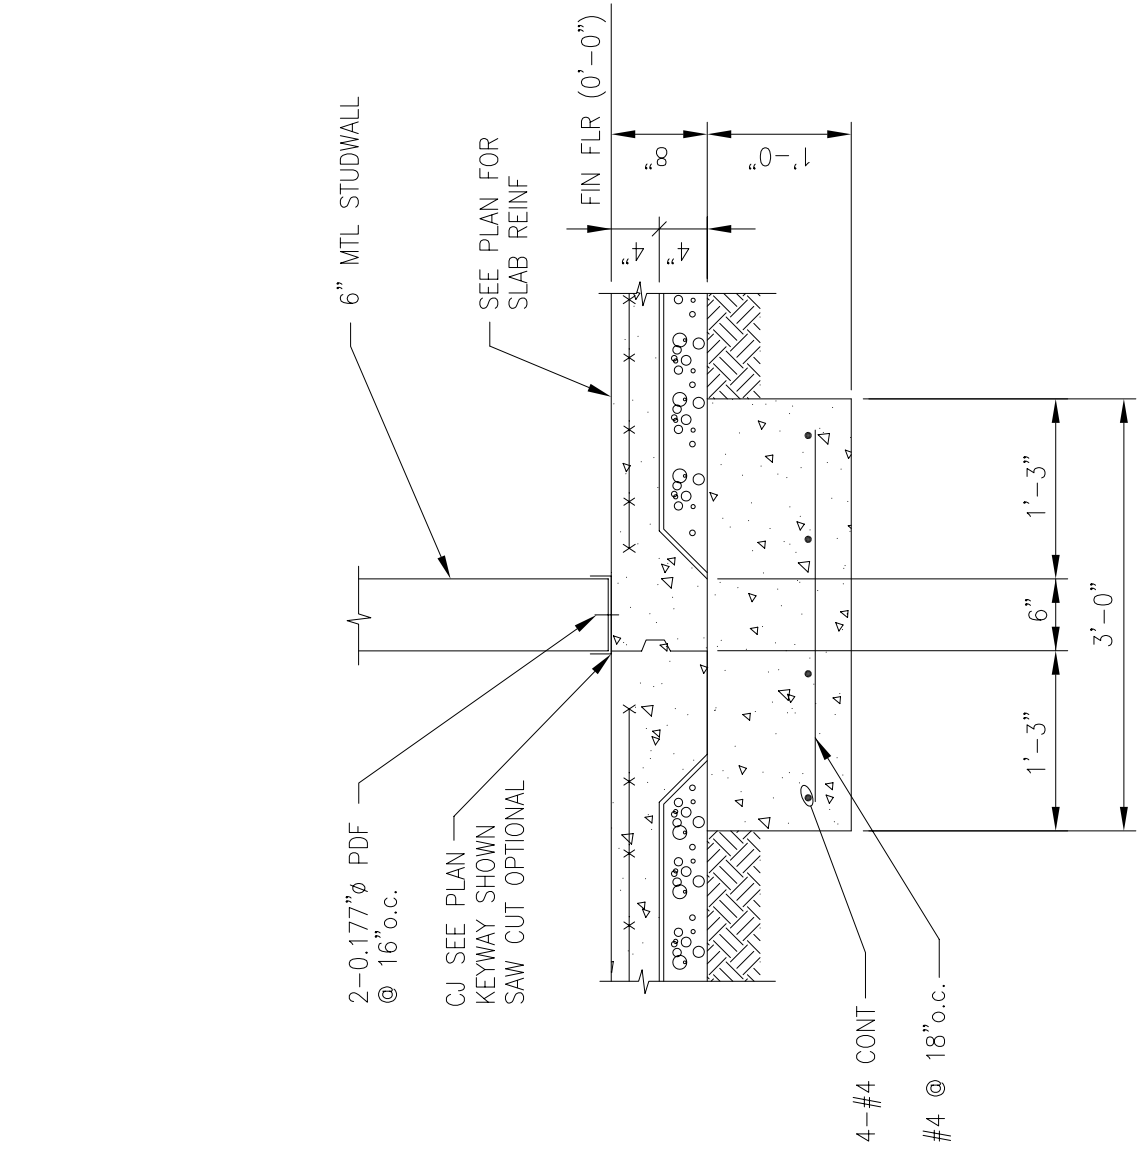


J SECTION
S2 S13 S3
3/4"=1'-0"

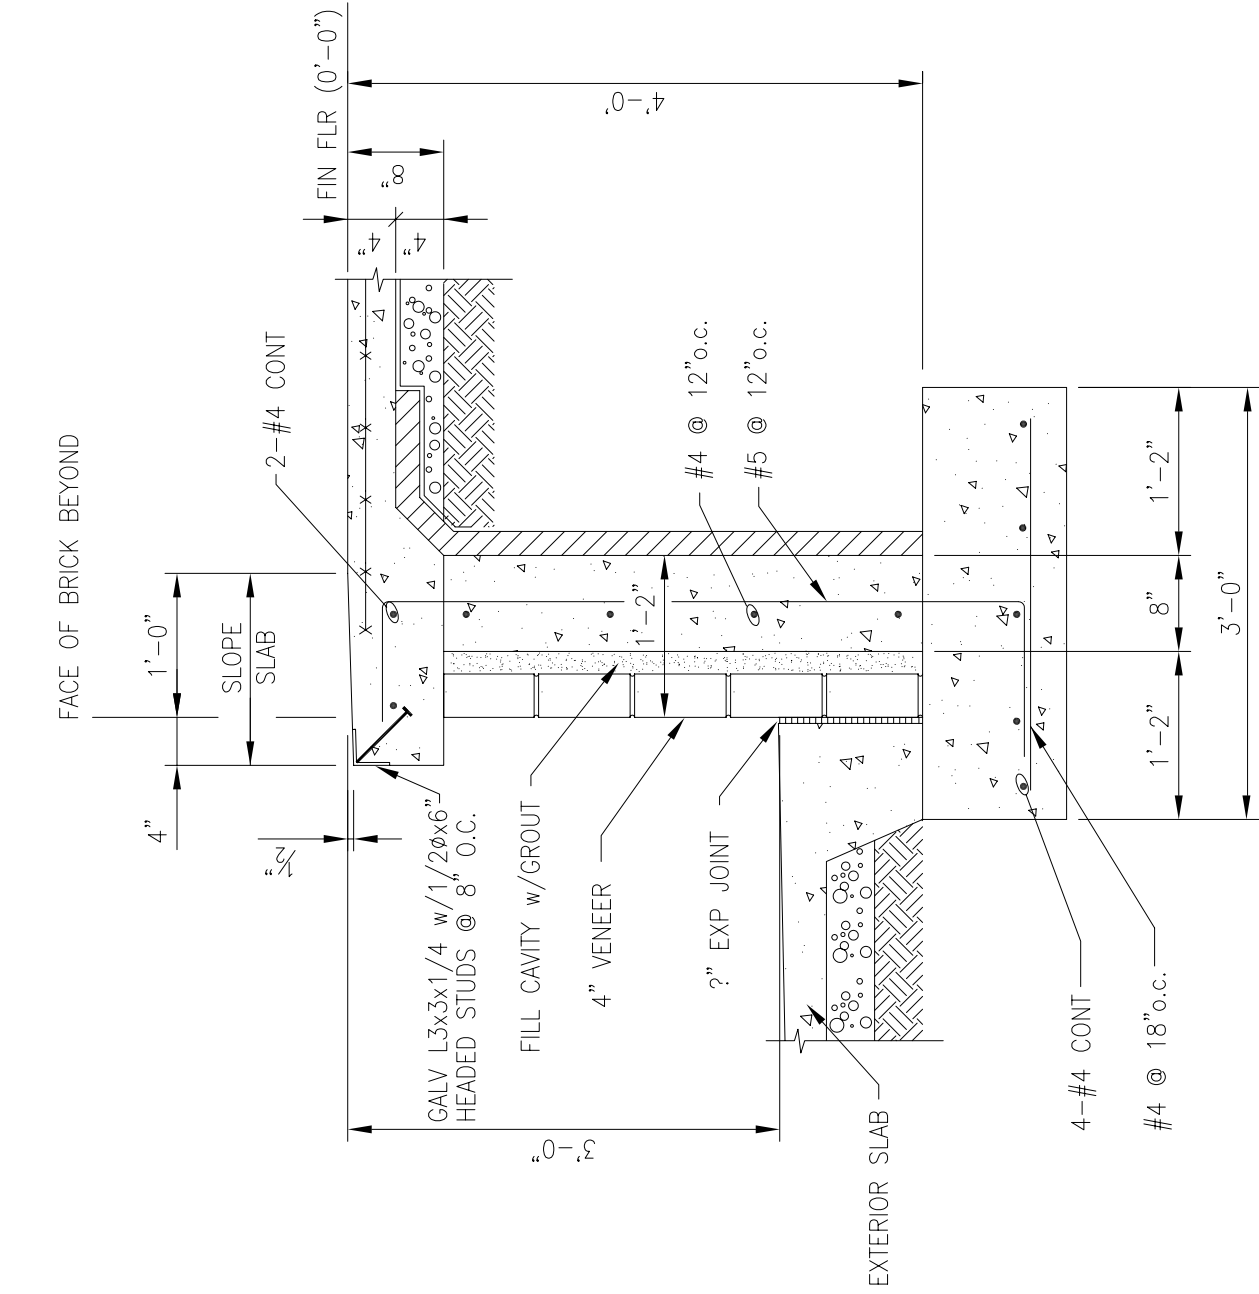

K SECTION
S2 S13 S3
3/4"=1'-0"

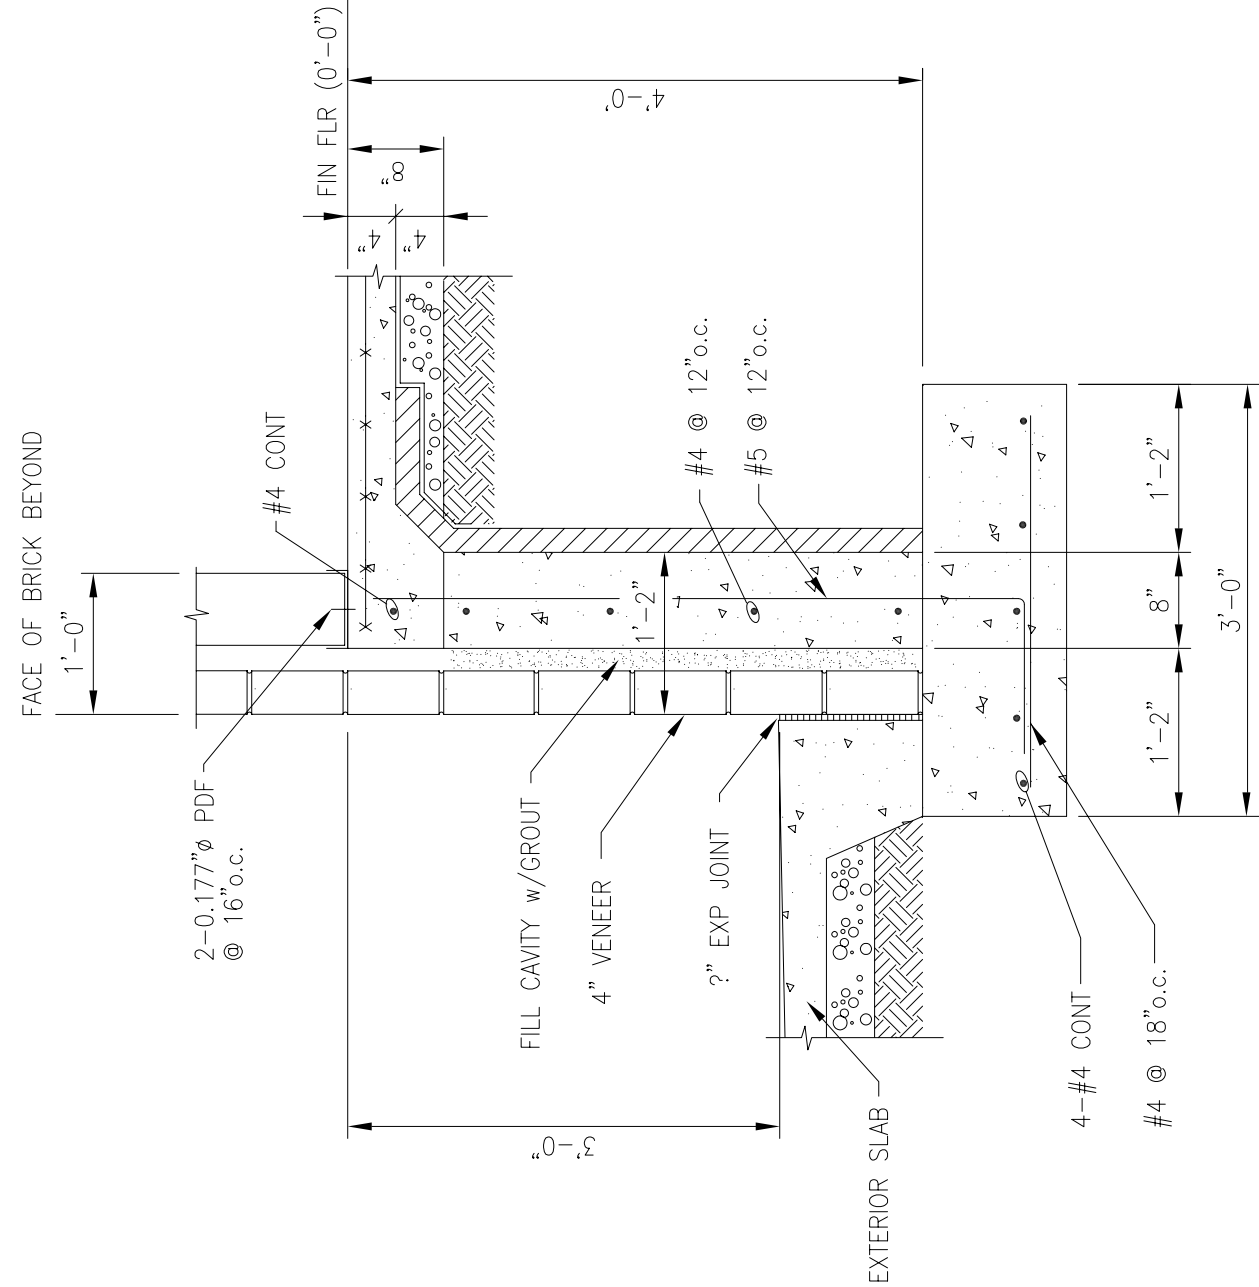

L SECTION
S2 S13 S3
3/4"=1'-0"

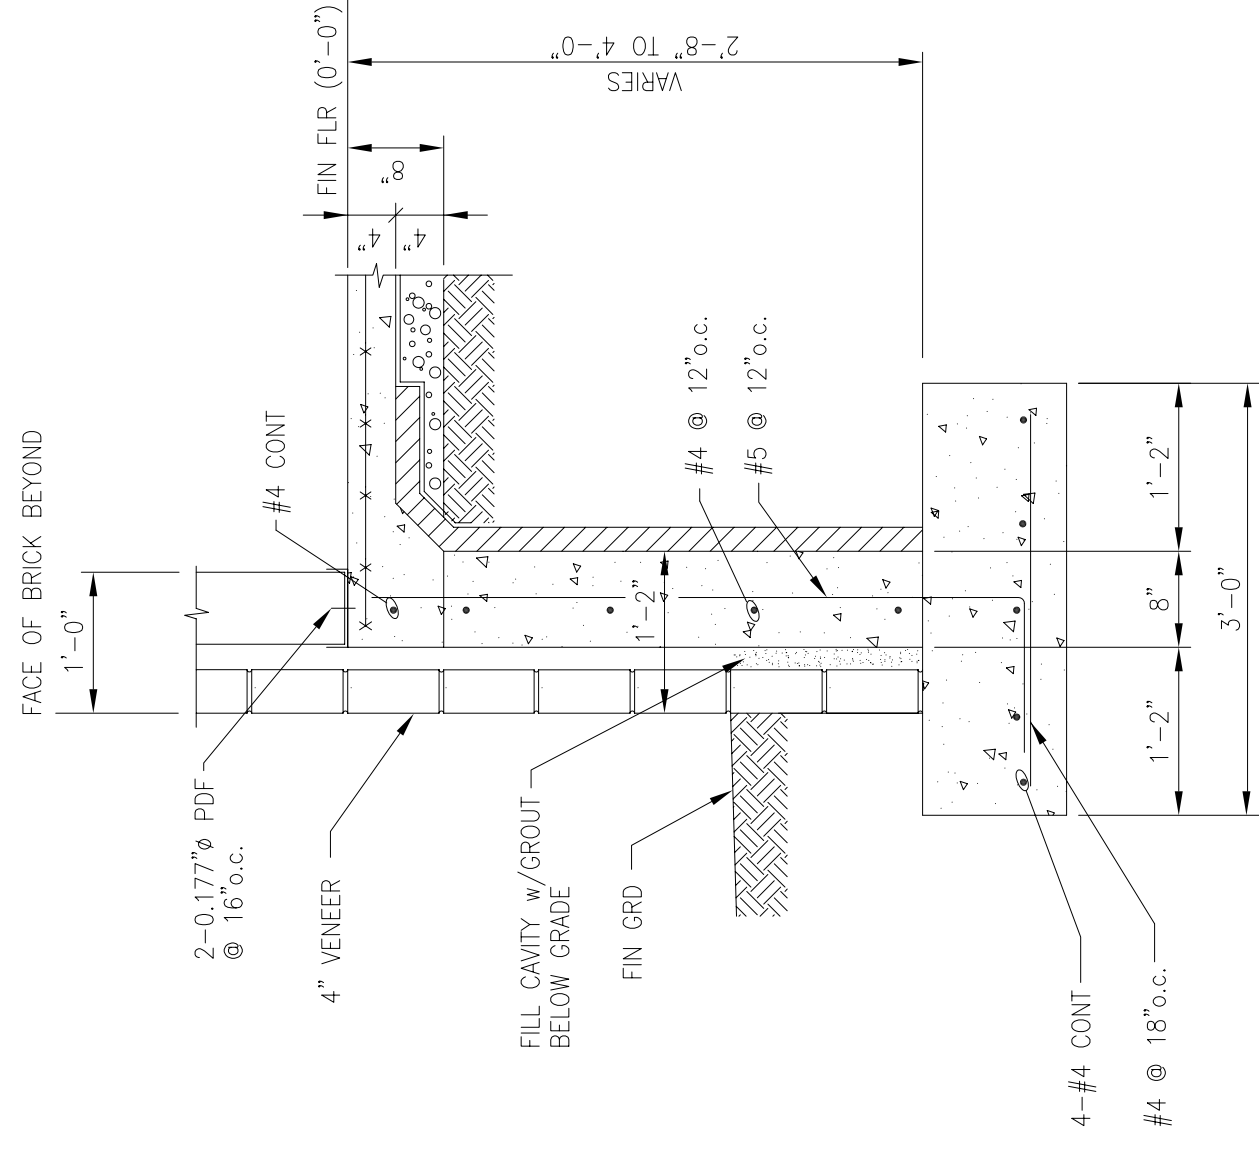

M SECTION
S2 S13 S3
3/4"=1'-0"

PROJECT TITLE
TEMPORARY LODGING
FACILITY

SHEET TITLE
FOUNDATION SECTIONS
AS-BUILT

DRAWN BY TLK	LEAD DESIGNER
TECH REVIEWER	FILE LOCATION
DESIGNED BY TVR	PROJECT NUMBER NKAK02-5001
DATE 28 MAY 2002	SHEET S13
SCALE 3/4"=1'-0"	53 of 108