
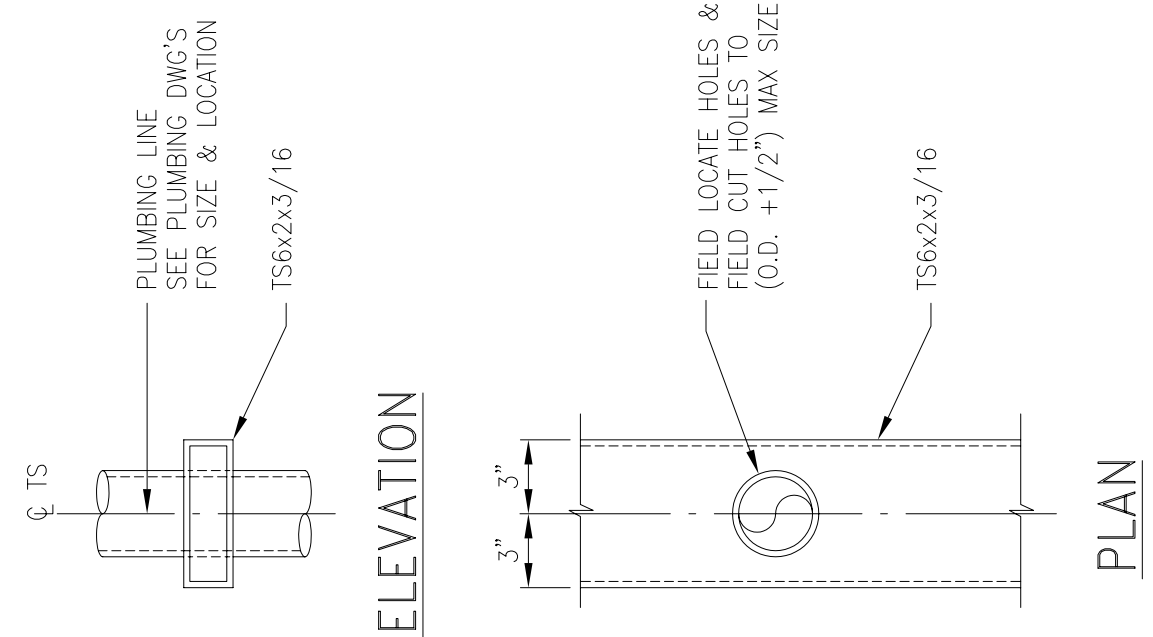
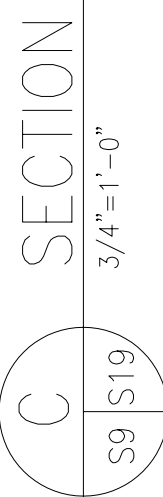
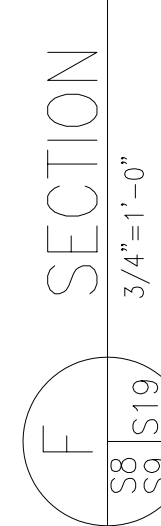
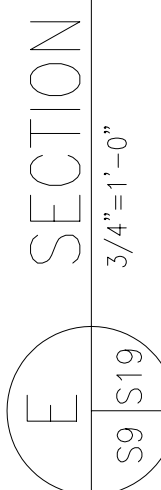
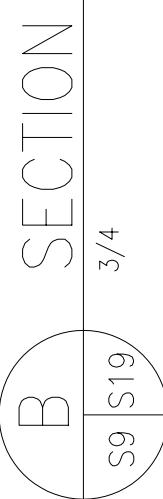
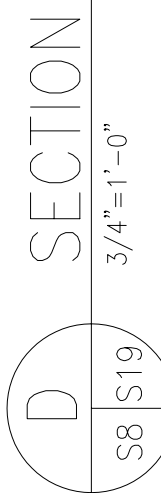


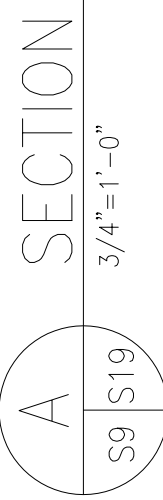

PROJECT TITLE

TEMPORARY LODGING
FACILITY

ROOF FRAMING SECTIONS AS-BUILT

DRAWN BY TLK	LEAD DESIGNER
TECH REVIEWER	FILE LOCATION
DESIGNED BY IVR	PROJECT NUMBER NK402-5001
DATE 28 MAY 2002	SHEET S19
SCALE $3/4" = 1'-0"$	59 OF 108