

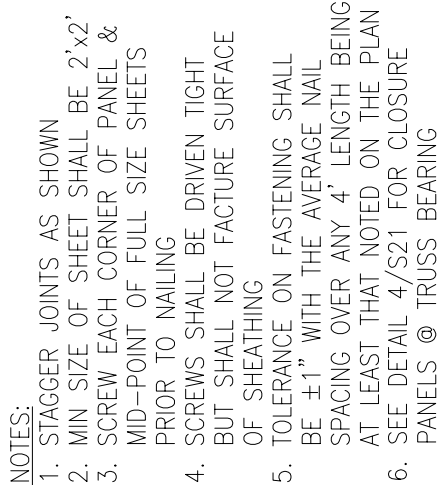
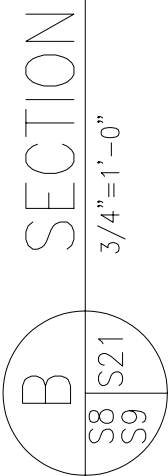
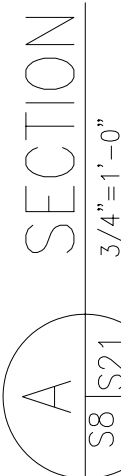


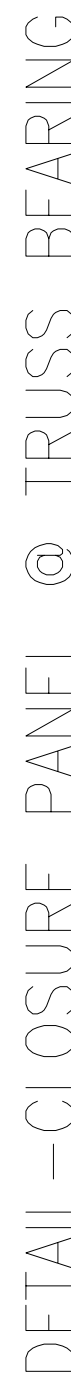

SAWCUT CONTROL JOINT

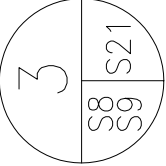

ROOF SHEATHING ON STEEL

[illegible]

PROJECT TITLE

TEMPORARY LODGING FACILITY

SHEET TITLE

ROOF FRAMING SECTIONS
AS-BUILT

DRAWN BY TLK	LEAD DESIGNER
TECH. REVIEWER	FILE LOCATION
DESIGNED BY TVR	PROJECT NUMBER NKAK02-5001
DATE 28 MAY 2002	SHEET S21
SCALE 3/4" = 1'-0"	61 OF 108