

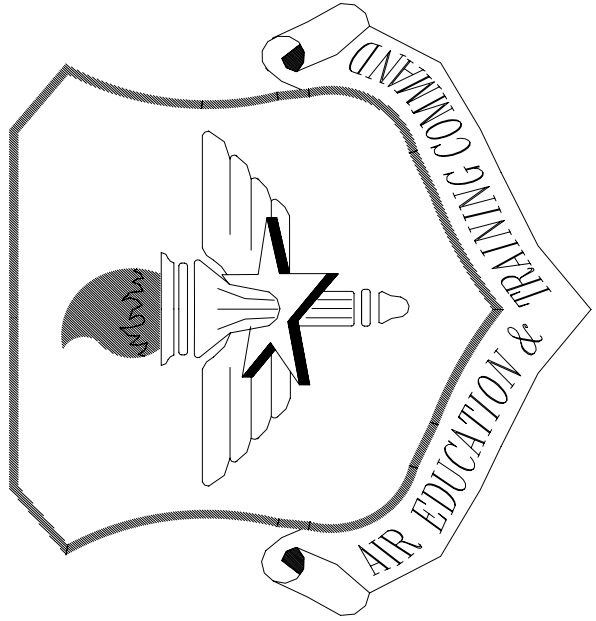
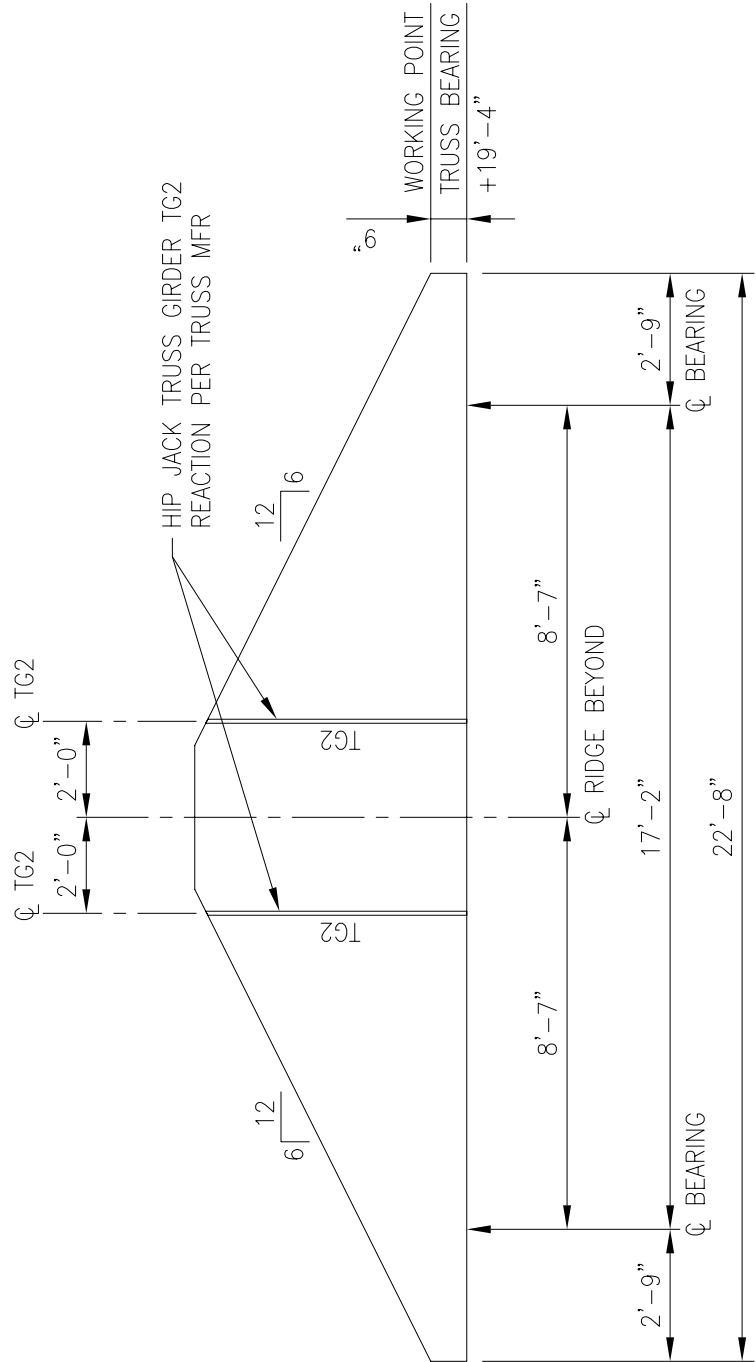


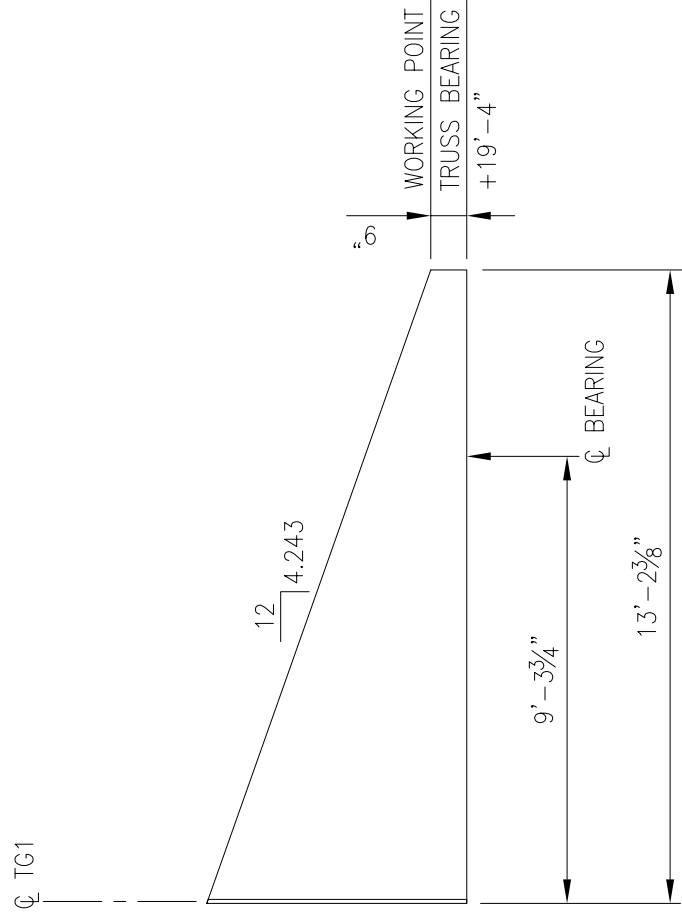


LITTLE ROCK A.F.B.
ARKANSAS

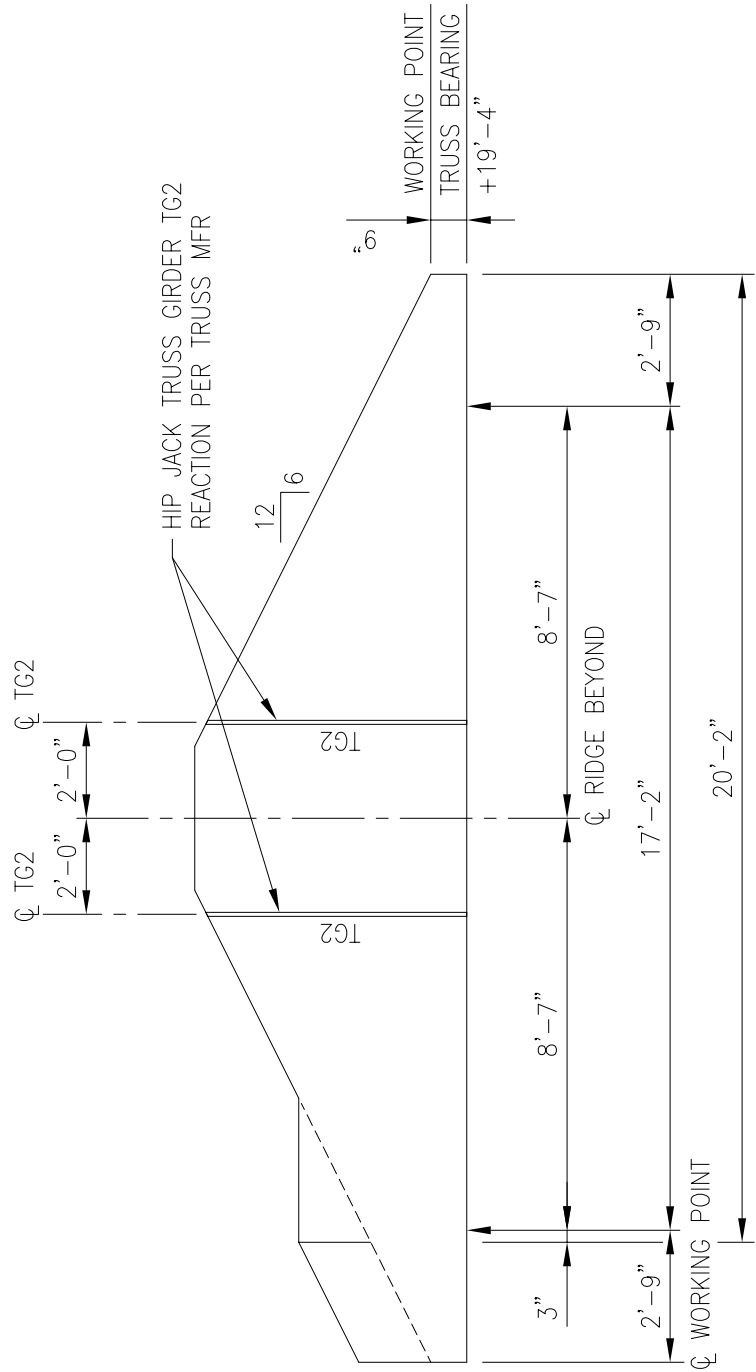

TRUSS GIRDER TG1

TRUSS GIRDER TG2


TRUSS GIRDER TG3

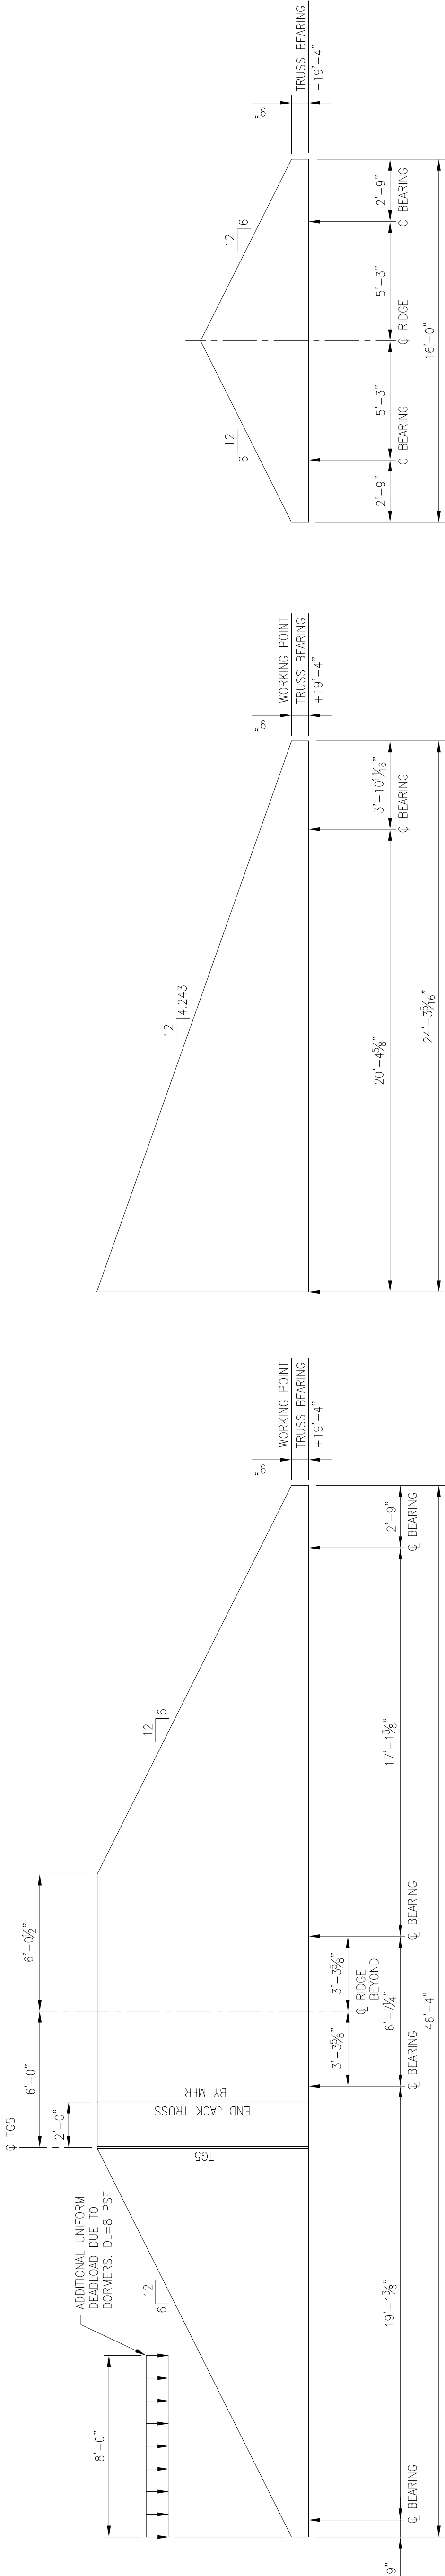


TRUSS GIRDER TG4

TRUSS GIRDER TG5

TRUSS GIRDER TG6

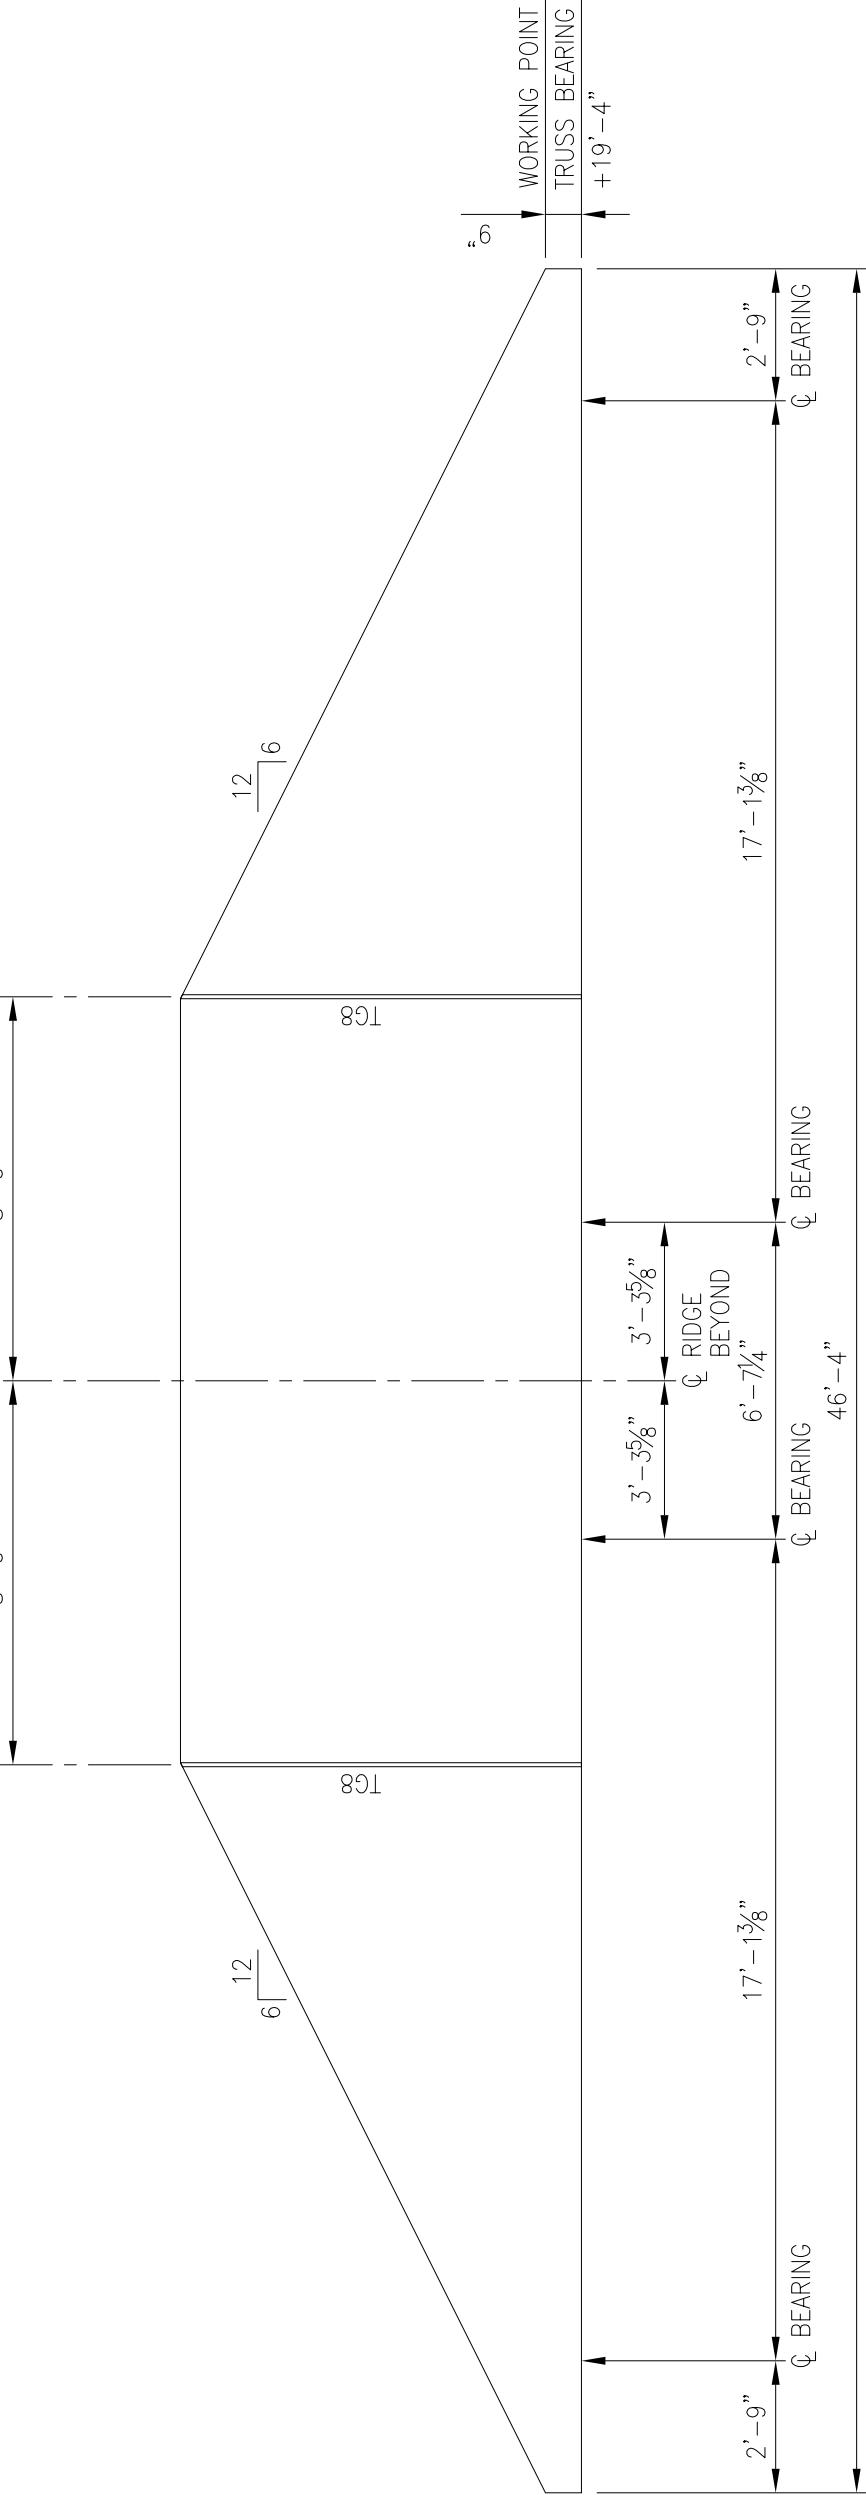

TRUSS GIRDER TG7

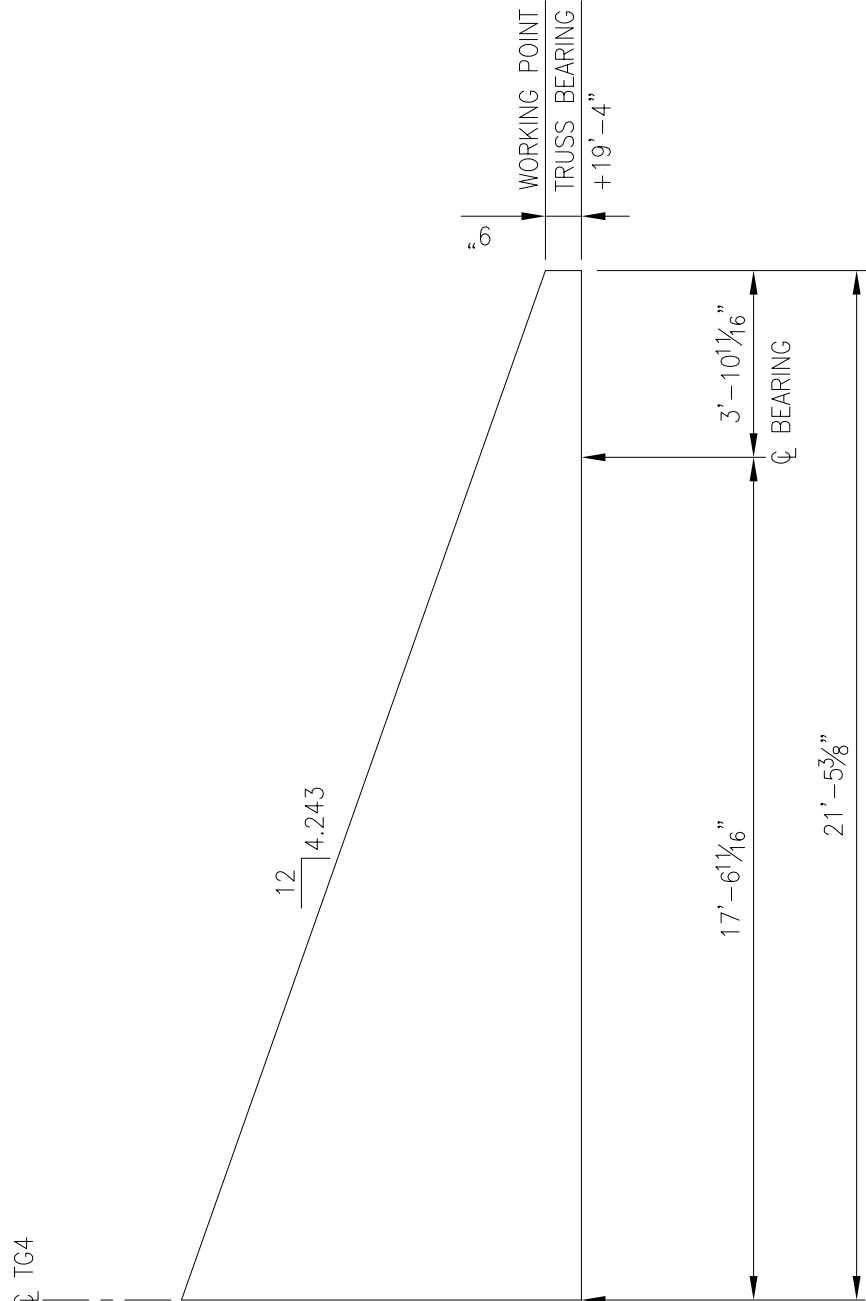

TRUSS GIRDER TG8

No.	Revision/Issue	Date	By	App'D
1	No Changes from Design to As-Built			

PROJECT TITLE

TEMPORARY LODGING
FACILITY

SHEET TITLE

TRUSS GIRDER PROFILES
AS-BUILT

DRAWN BY	MO	LEAD DESIGNER
TECH REVIEWER		FILE LOCATION
DESIGNED BY	TVR	PROJECT NUMBER
DATE	28 MAY 2002	NKAK02-5001
SCALE	1/4" = 1'-0"	SHEET
		S22
		62 of 108