



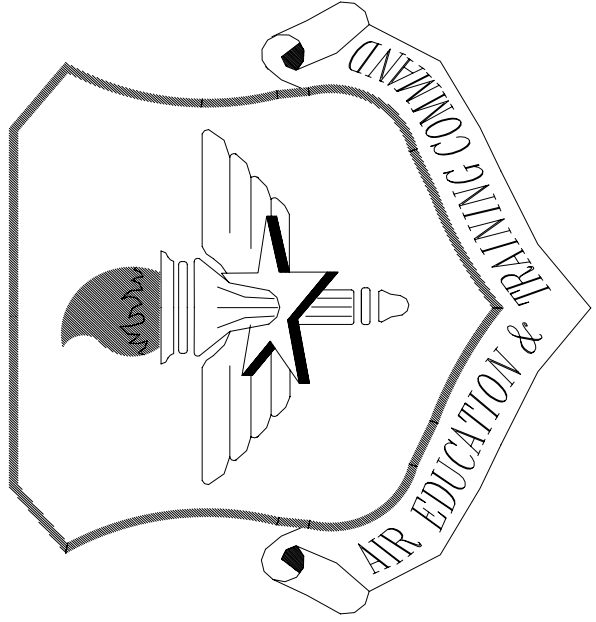


LITTLE ROCK A.F.B.
ARKANSAS

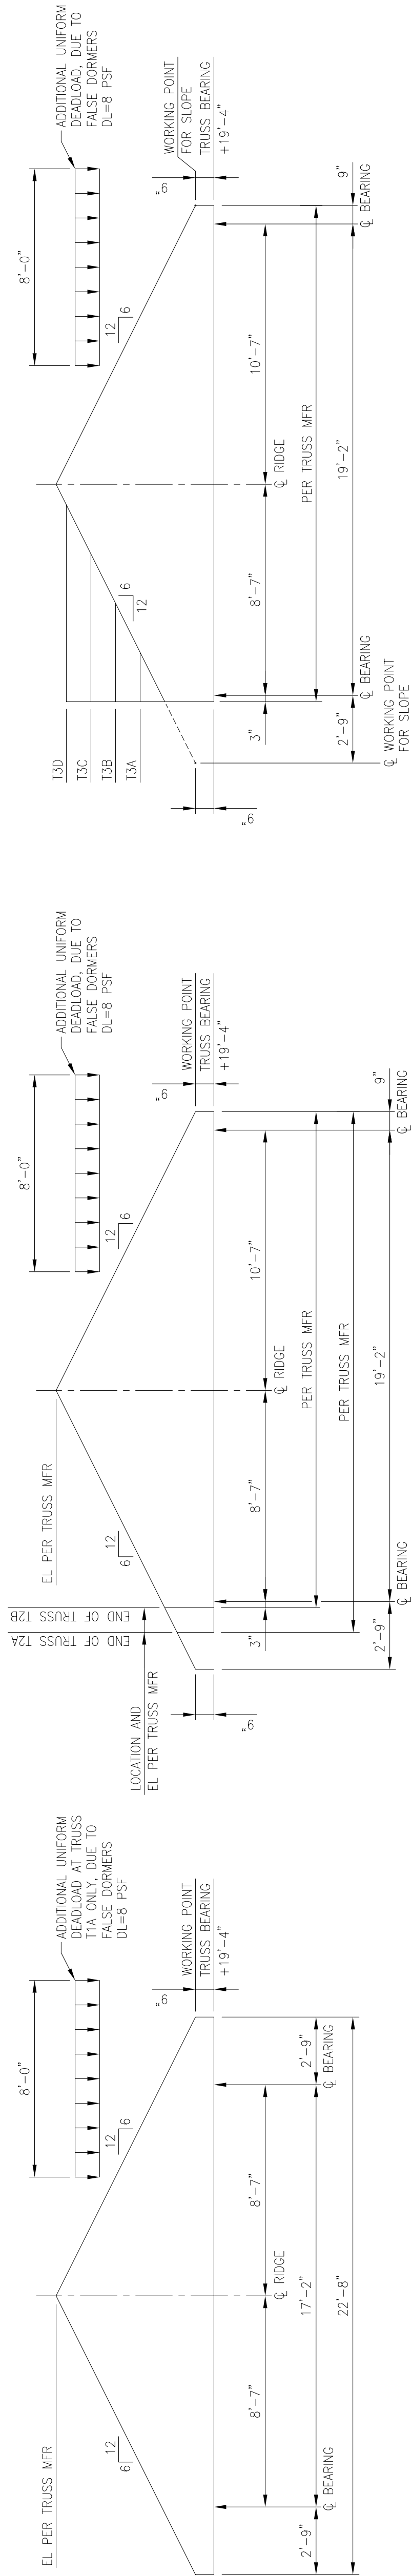

TRUSS T1 & T1A

TRUSS T2, T2A & T2B


TRUSS T3A, T3B, T3C & T3D

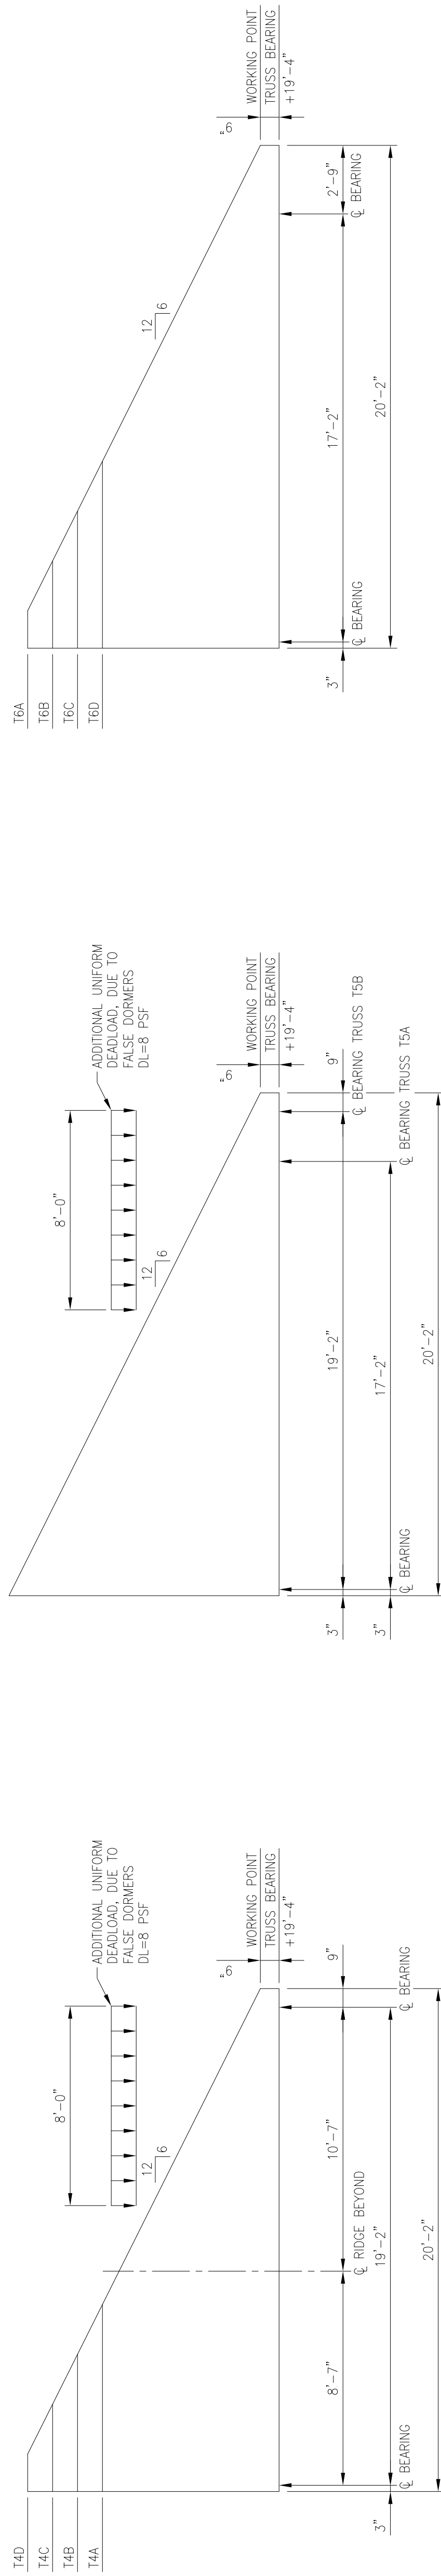

TRUSS T4A, T4B, T4C & T4D

TRUSS T5A & T5B

TRUSS T6A, T6B, T6C & T6D

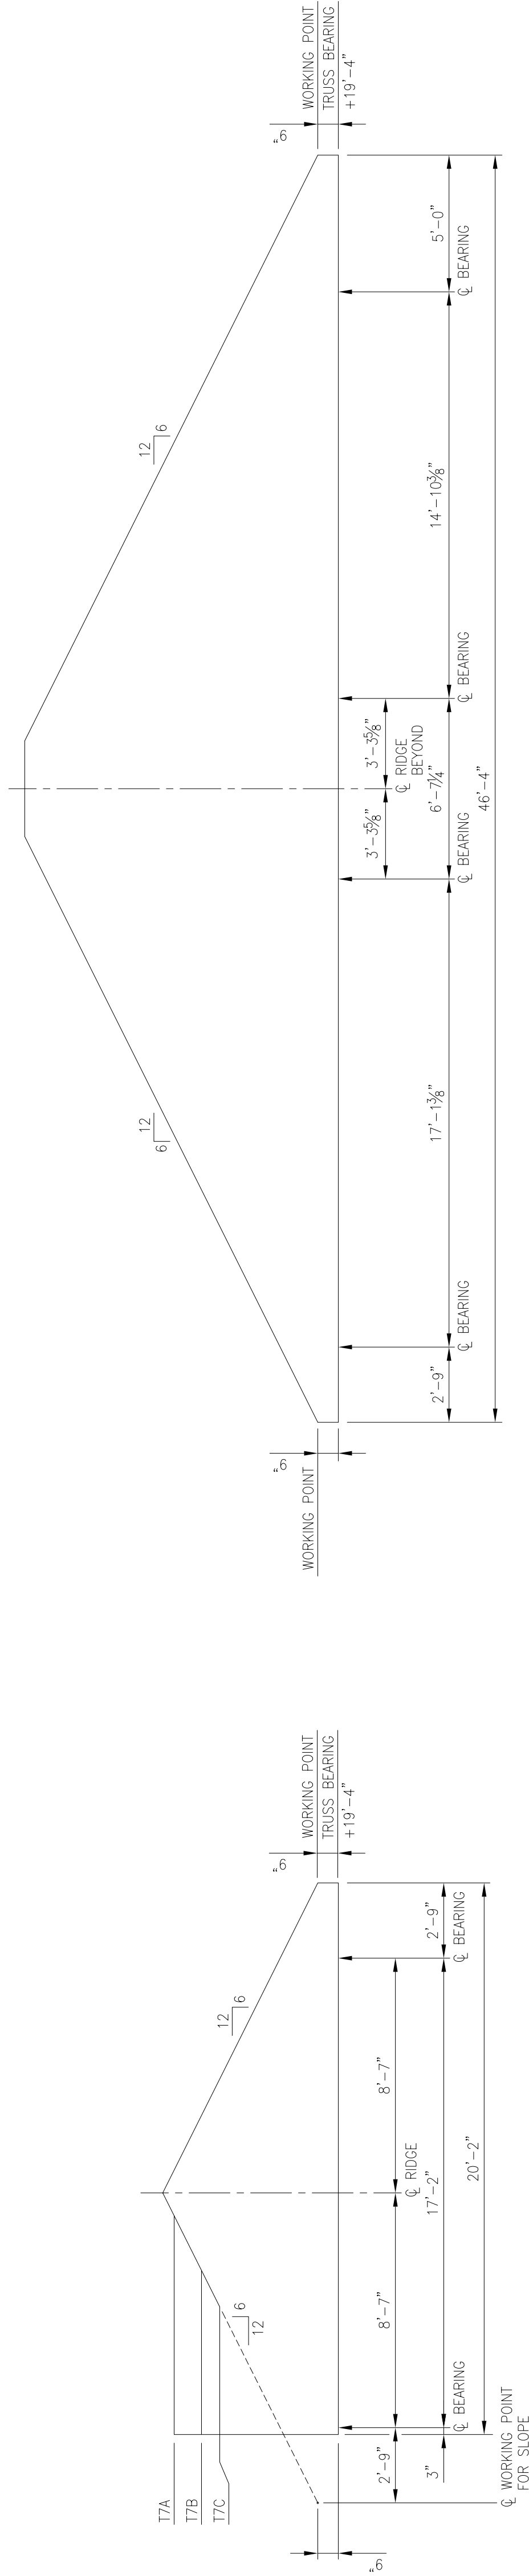

TRUSS T7A, T7B & T7C

TRUSS T8

[illegible]

PROJECT TITLE

TEMPORARY LODGING FACILITY

SHEET TITLE

TRUSS GIRDER PROFILES
AS-BUILT

LEAD DESIGNER	DRAWN BY MO	DATE 28 MAY 2002	SHEET S23 PROJECT NUMBER NKAK02-5001
FILE LOCATION	TECH REVIEWER	SCALE 1/4" = 1'-0"	