



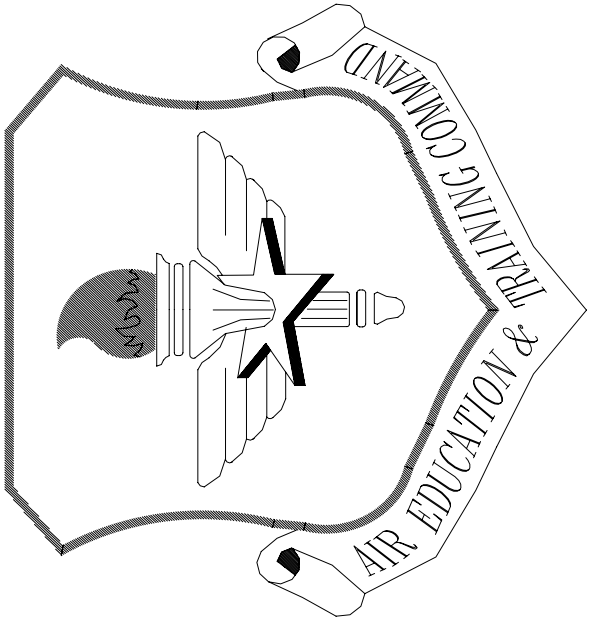


LITTLE ROCK A.F.B.
ARKANSAS

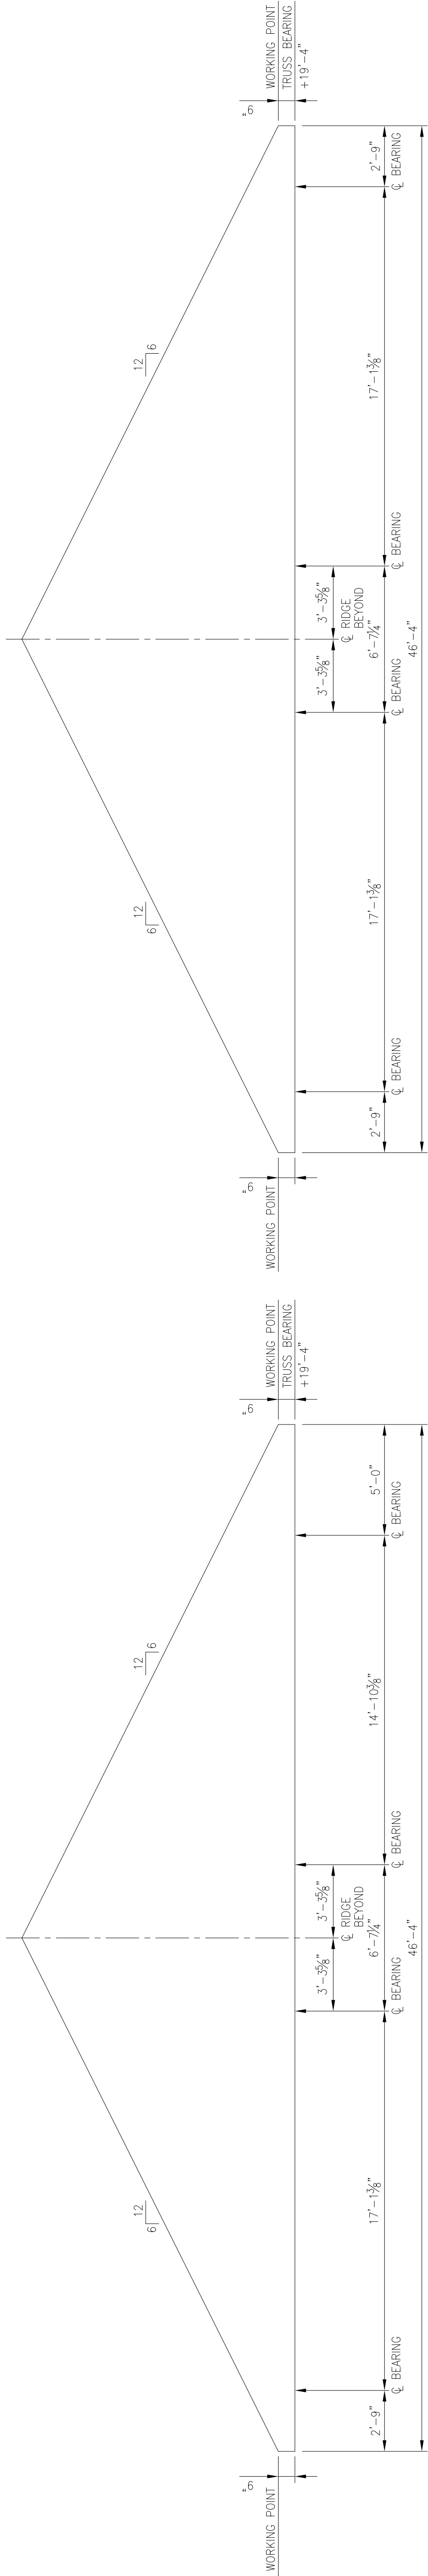


TRUSS T9

TRUSS T10

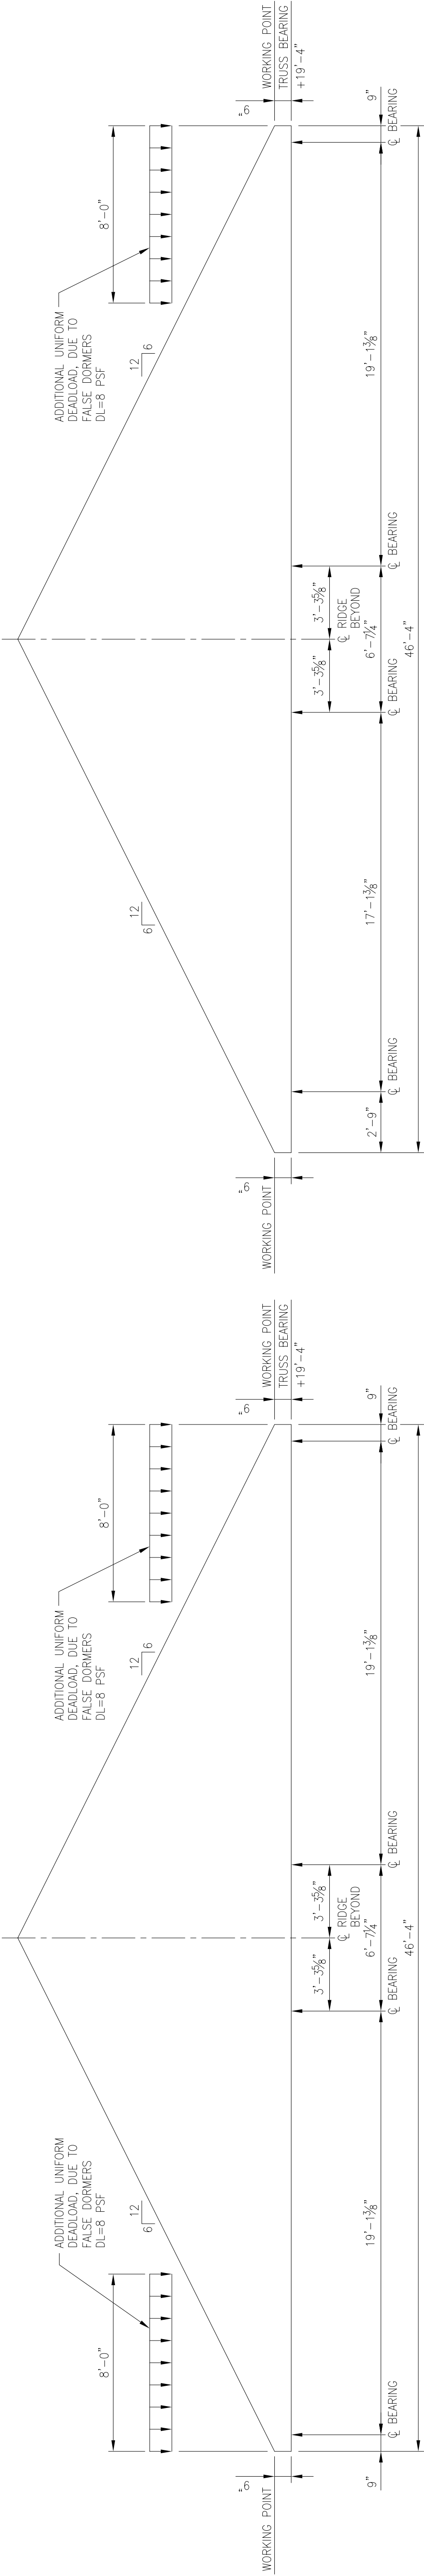

TRUSS T11

TRUSS T12

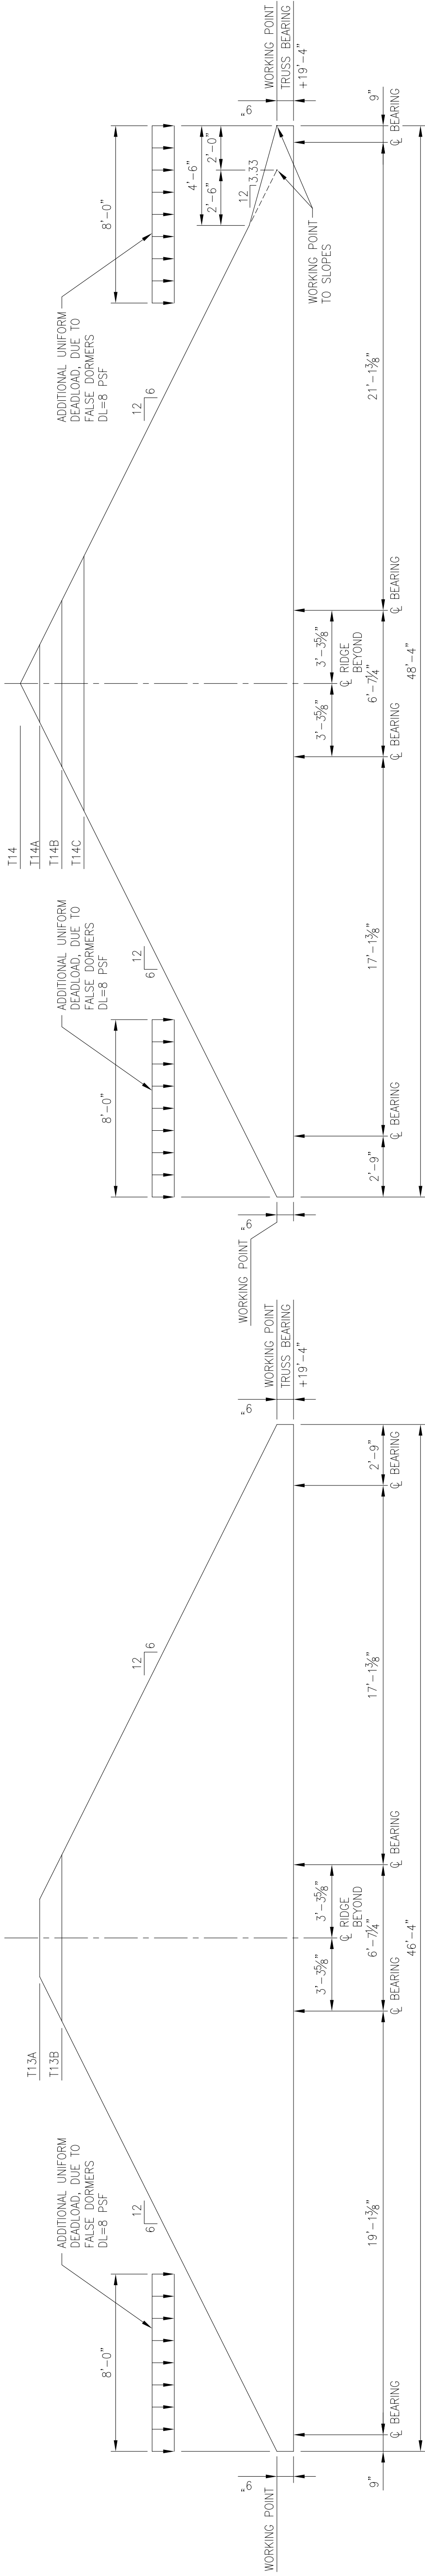

TRUSS T13A & T13B

TRUSS T14, T14A, T14B & T14C

No.	Revision/Issue	Date	BY	APP'D
1	No Changes from Design to As-Built			

PROJECT TITLE
TEMPORARY LODGING
FACILITY

SHEET TITLE
TRUSS GIRDER PROFILES
AS-BUILT

DRAWN BY MO	LEAD DESIGNER
TECH REVIEWER	FILE LOCATION
DESIGNED BY TYR	PROJECT NUMBER NKAK02-5001
DATE 28 MAY 2002	SHEET S24
SCALE 1/4" = 1'-0"	64 or 108