




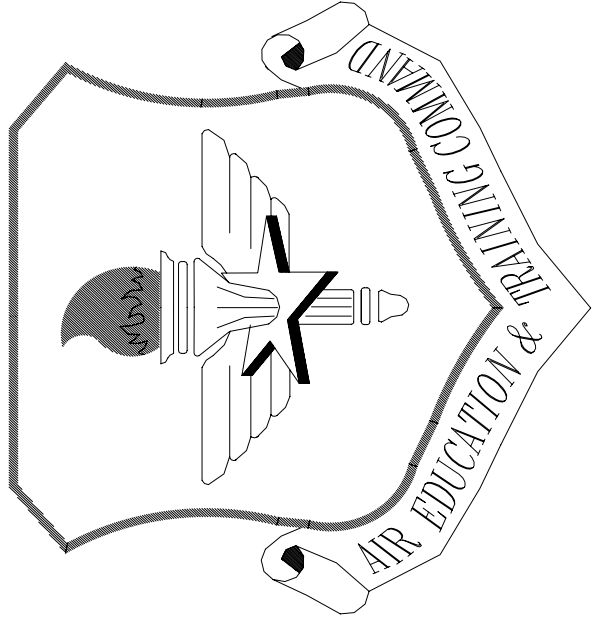


LITTLE ROCK A.F.B.
ARKANSAS

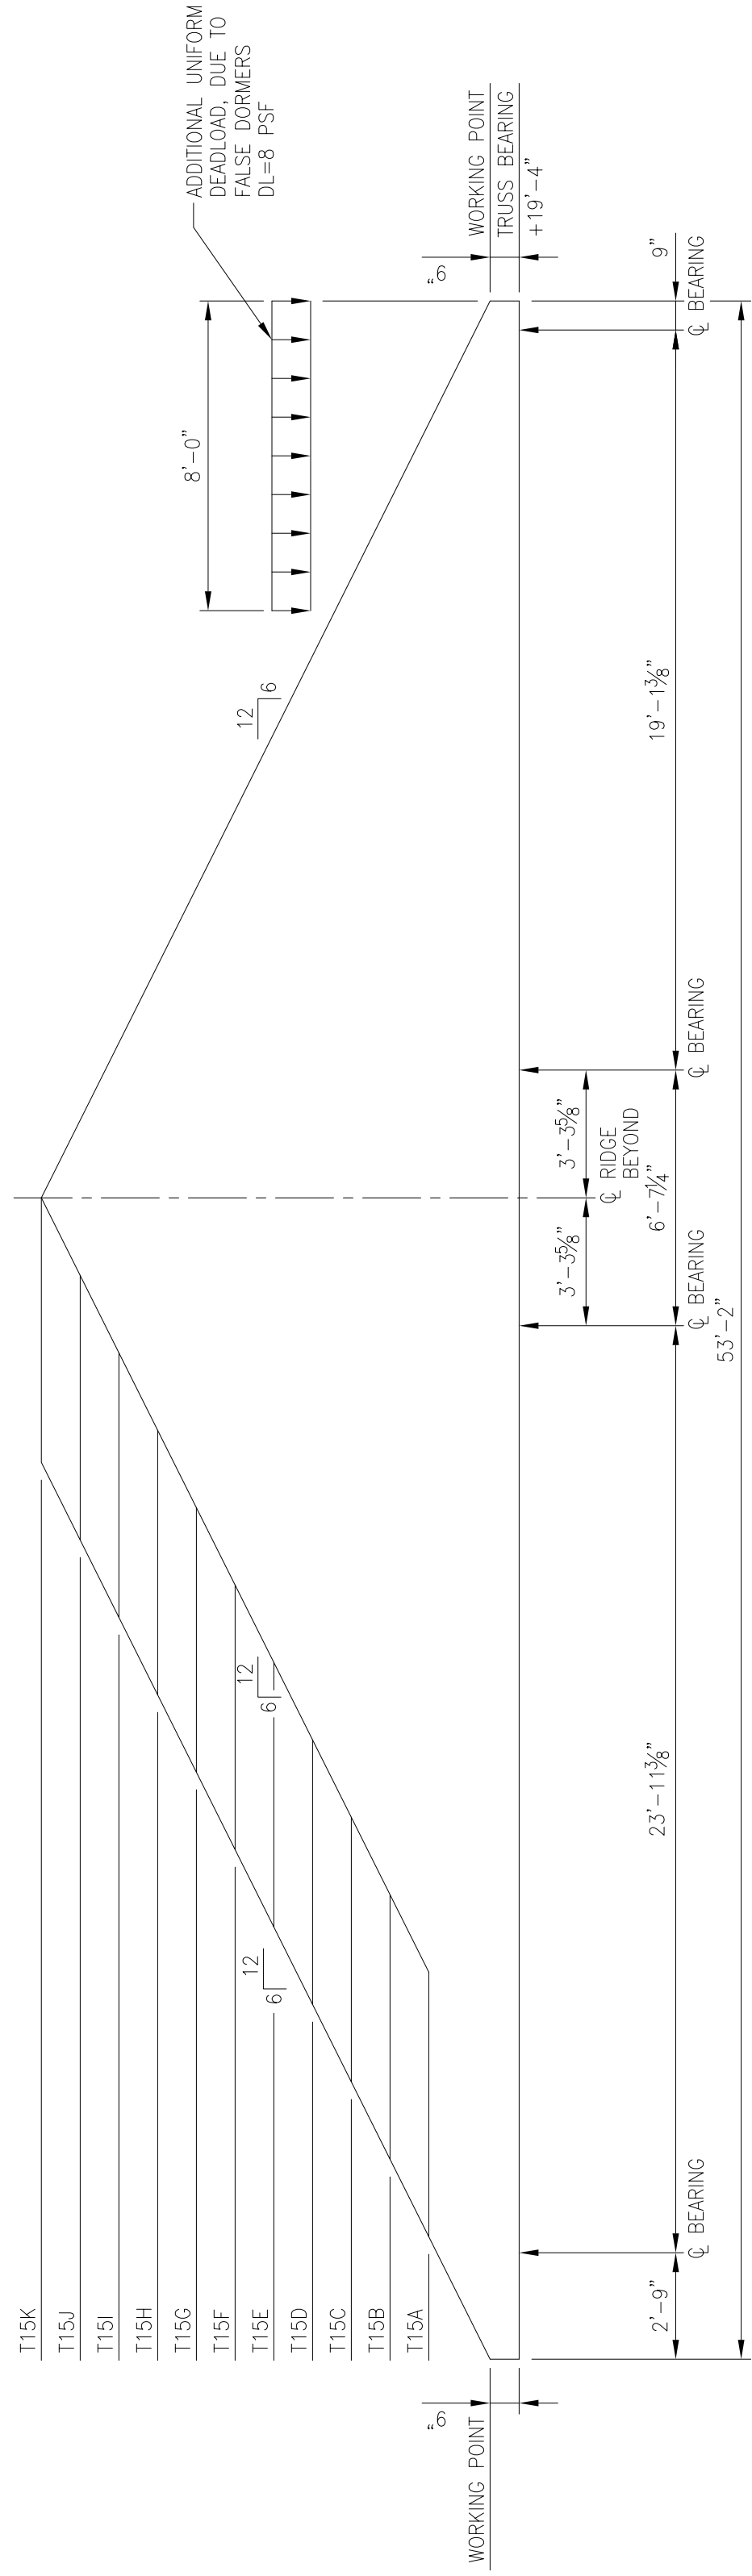

TRUSS T15A THRU T15K

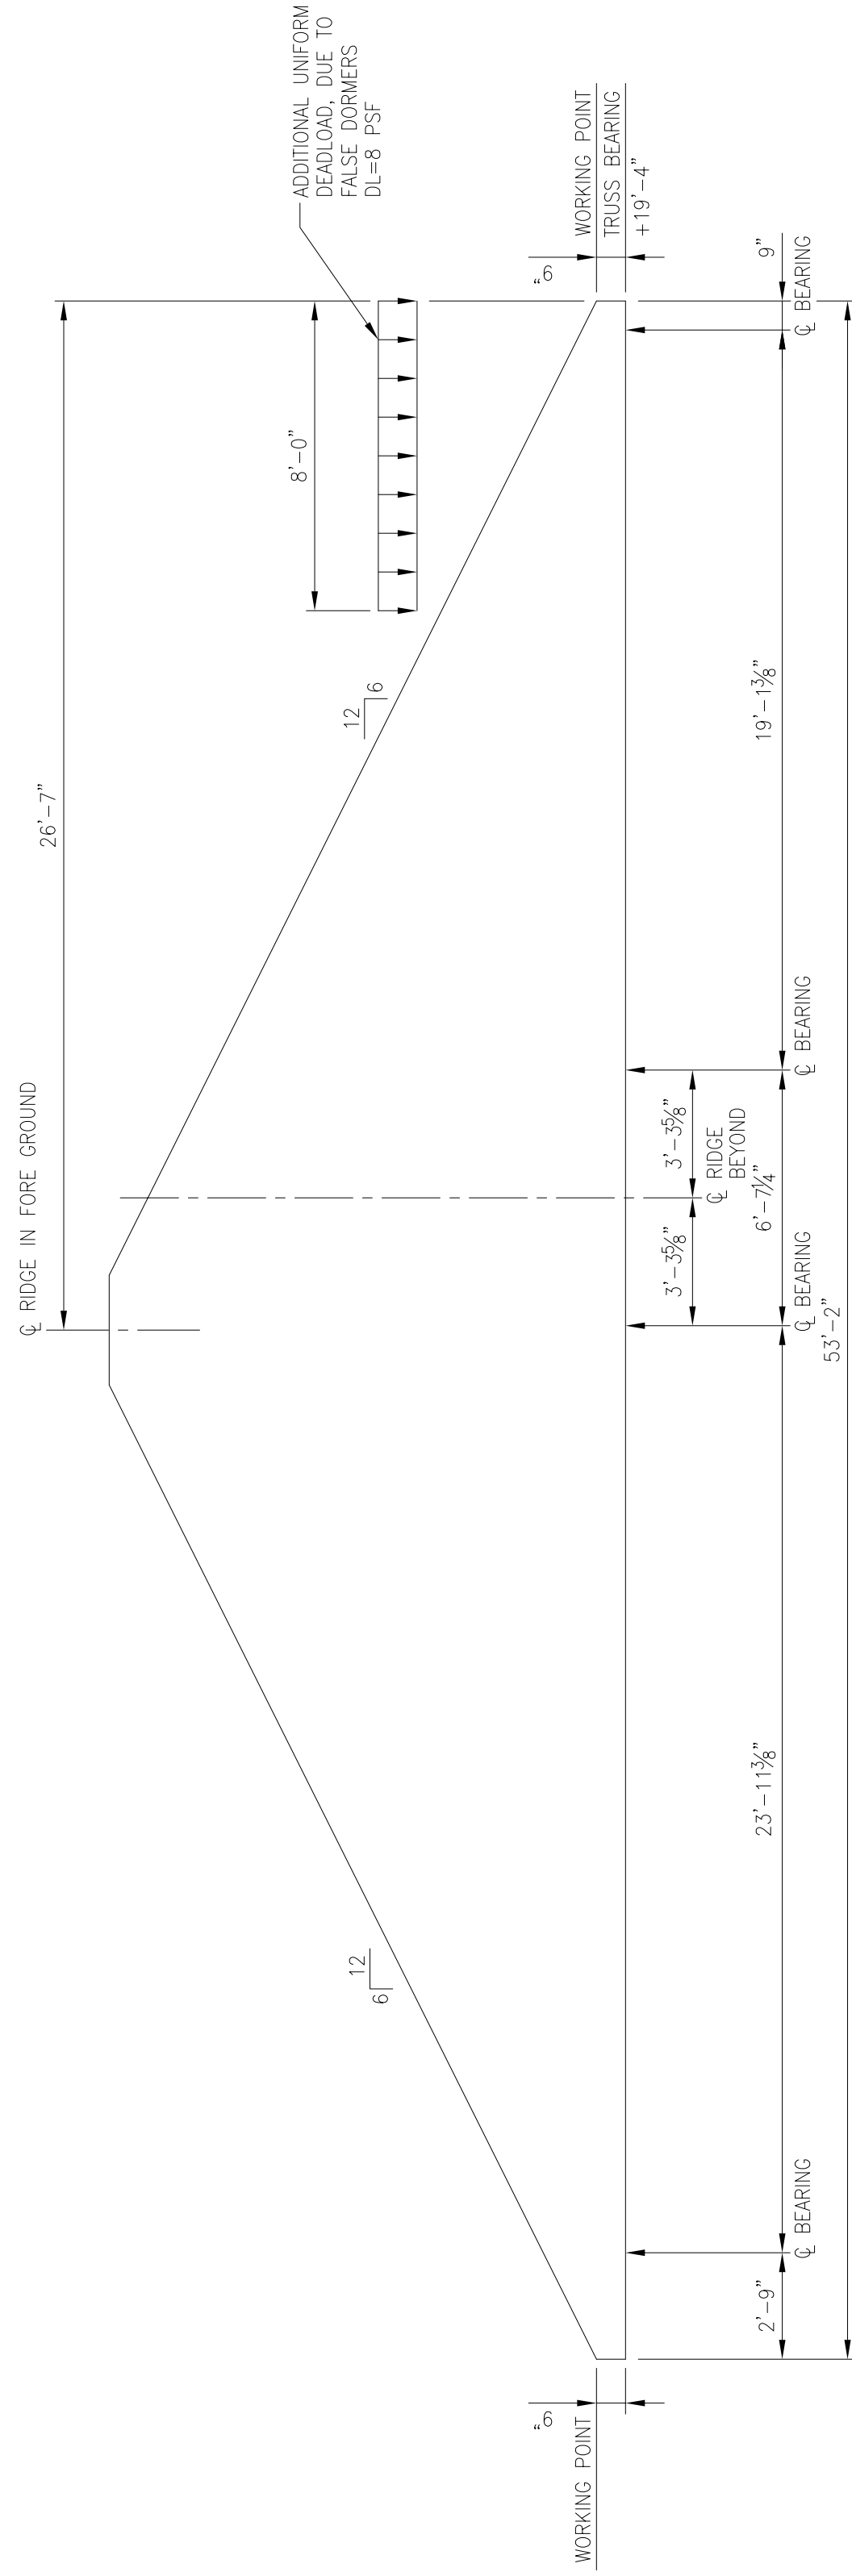

TRUSS T16

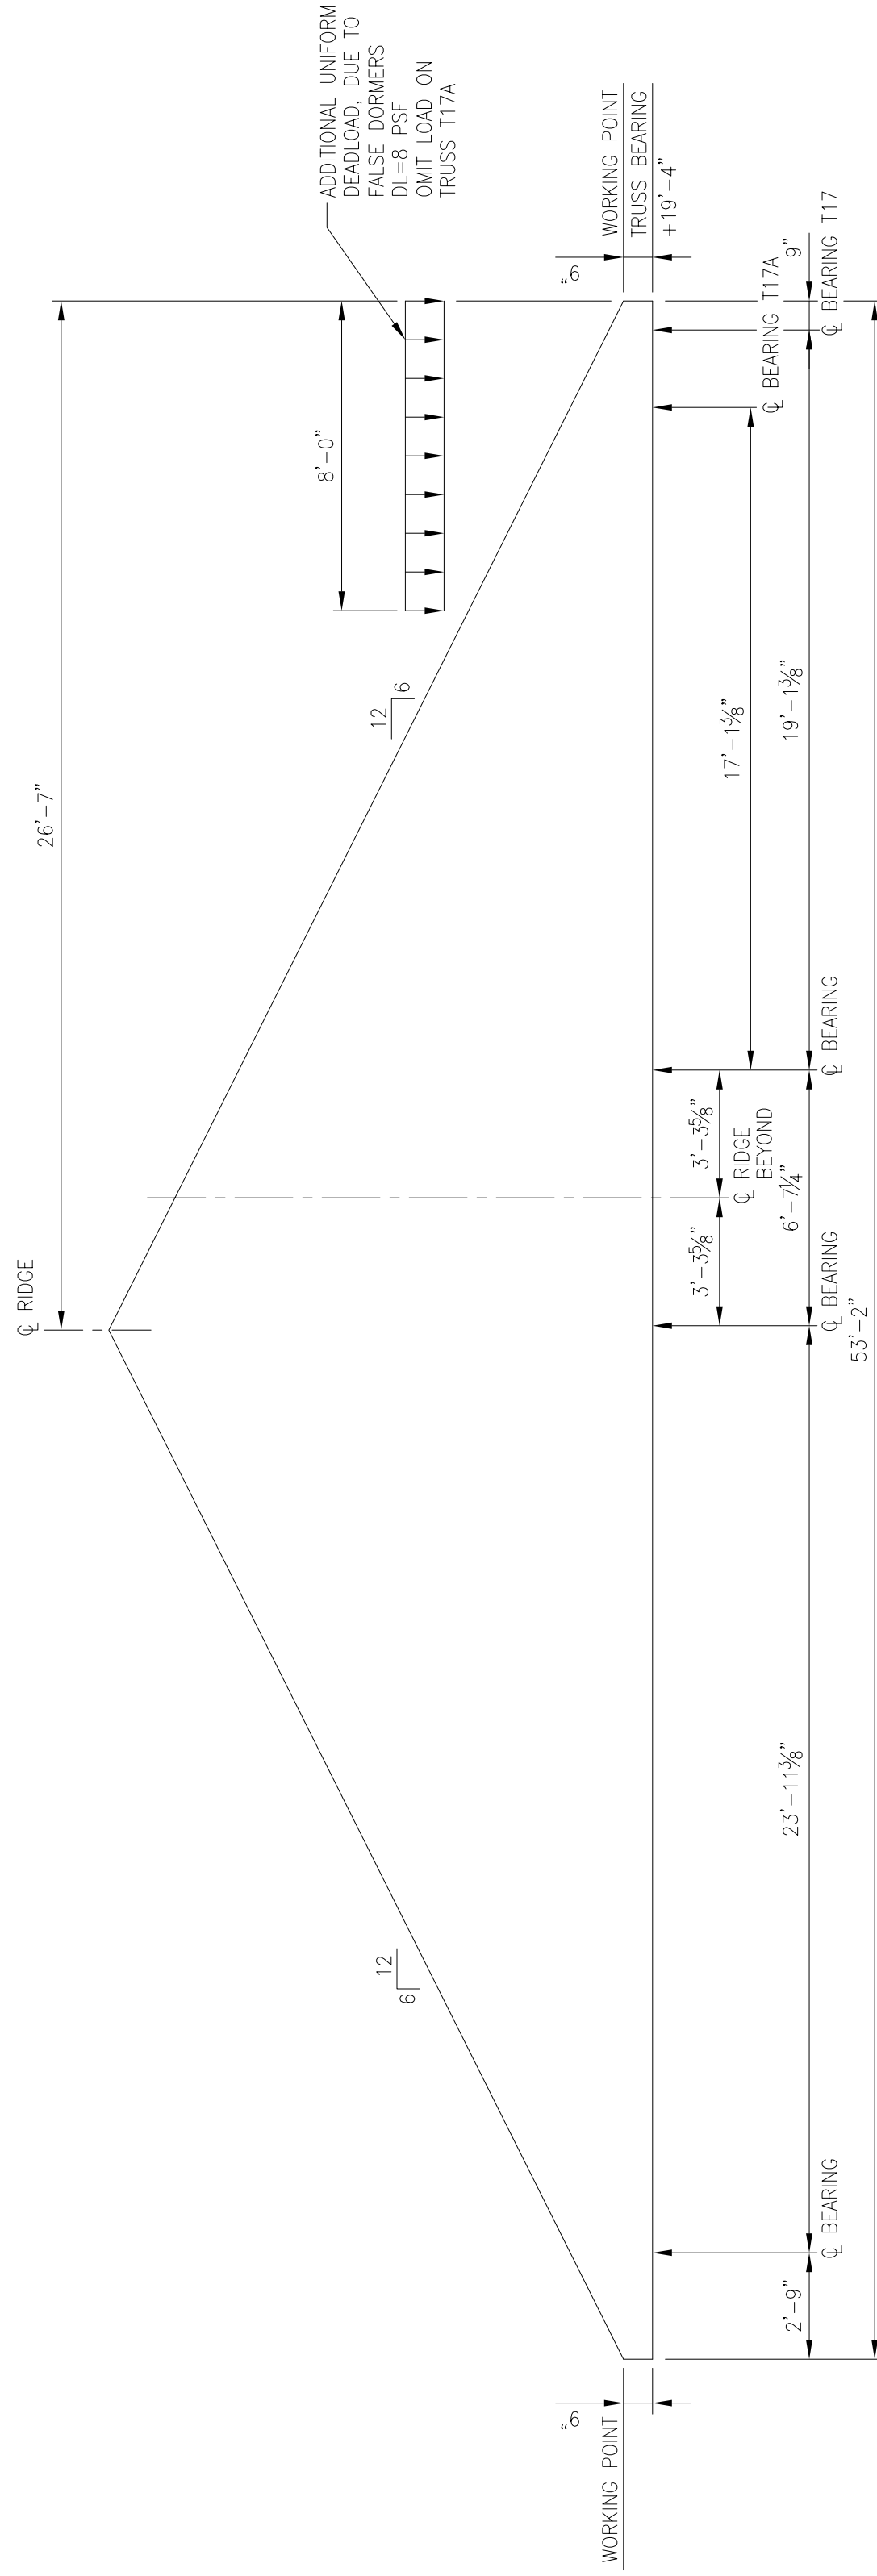

TRUSS T17 & T17A

[illegible]

PROJECT TITLE	TEMPORARY LODGING FACILITY

SHEET TITLE

TRUSS GIRDER PROFILES

AS-BUILT

DRAWN BY MO	LEAD DESIGNER
TECH. REVIEWER	FILE LOCATION
DESIGNED BY TVR	PROJECT NUMBER NKAK02-5001
DATE 28 MAY 2002	SHEET S25
SCALE 1/4" = 1'-0"	65 or 108