



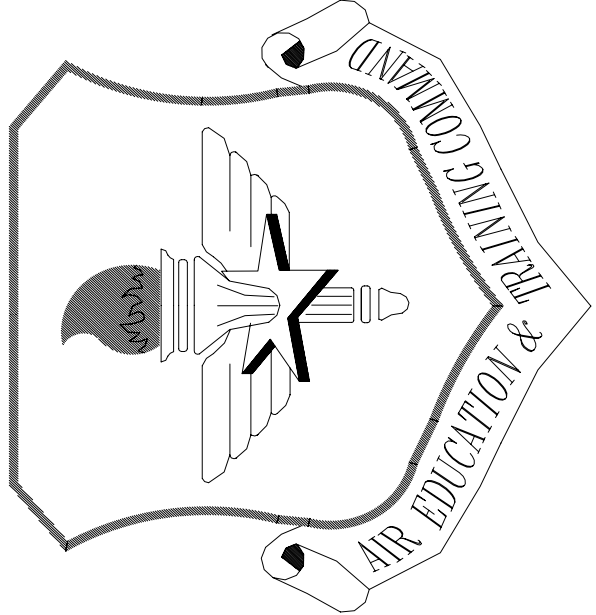


LITTLE ROCK A.F.B.
ARKANSAS

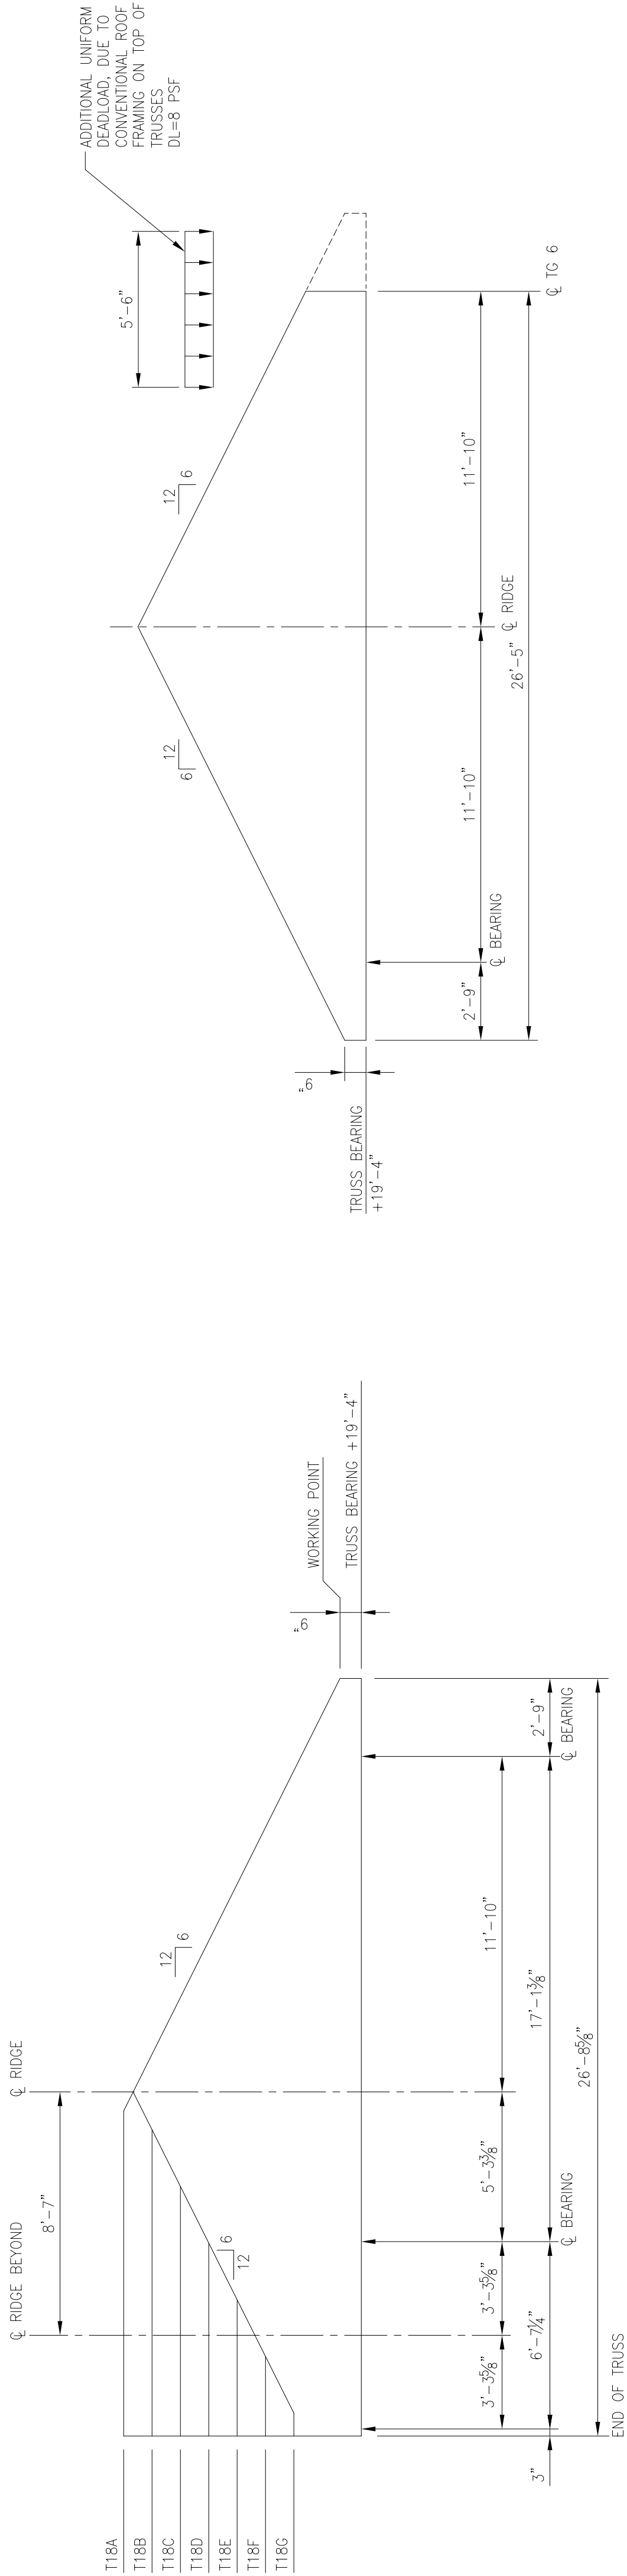

TRUSS T18A THRU T18G


TRUSS T19

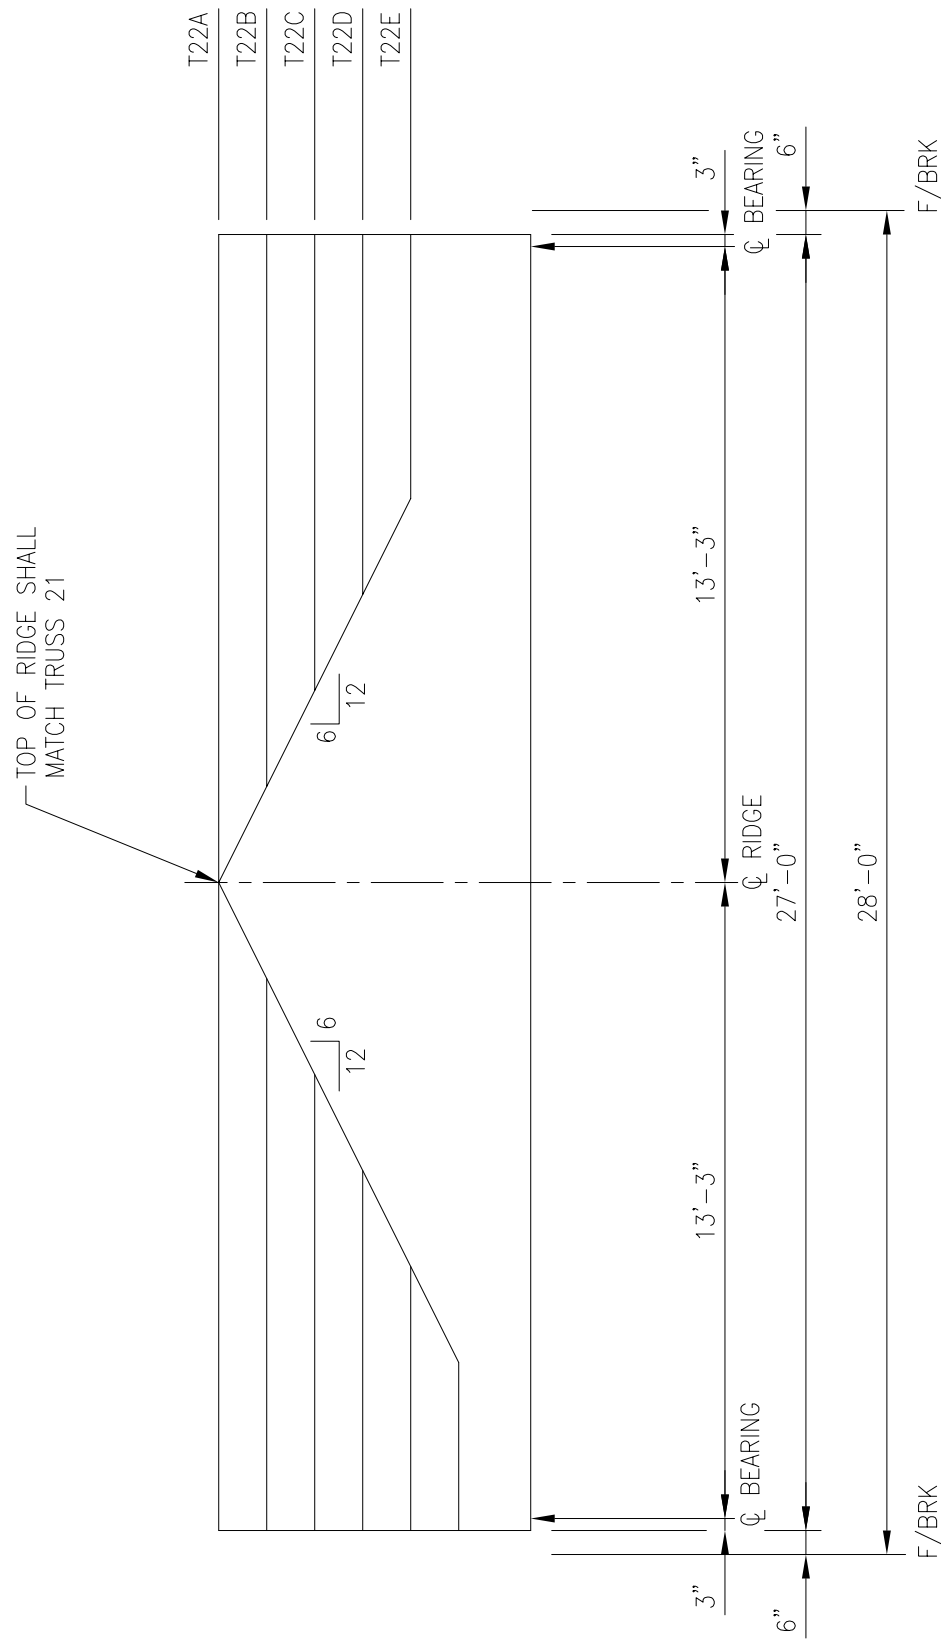

TRUSS T20

TRUSS T21

TRUSS T22A THRU 22

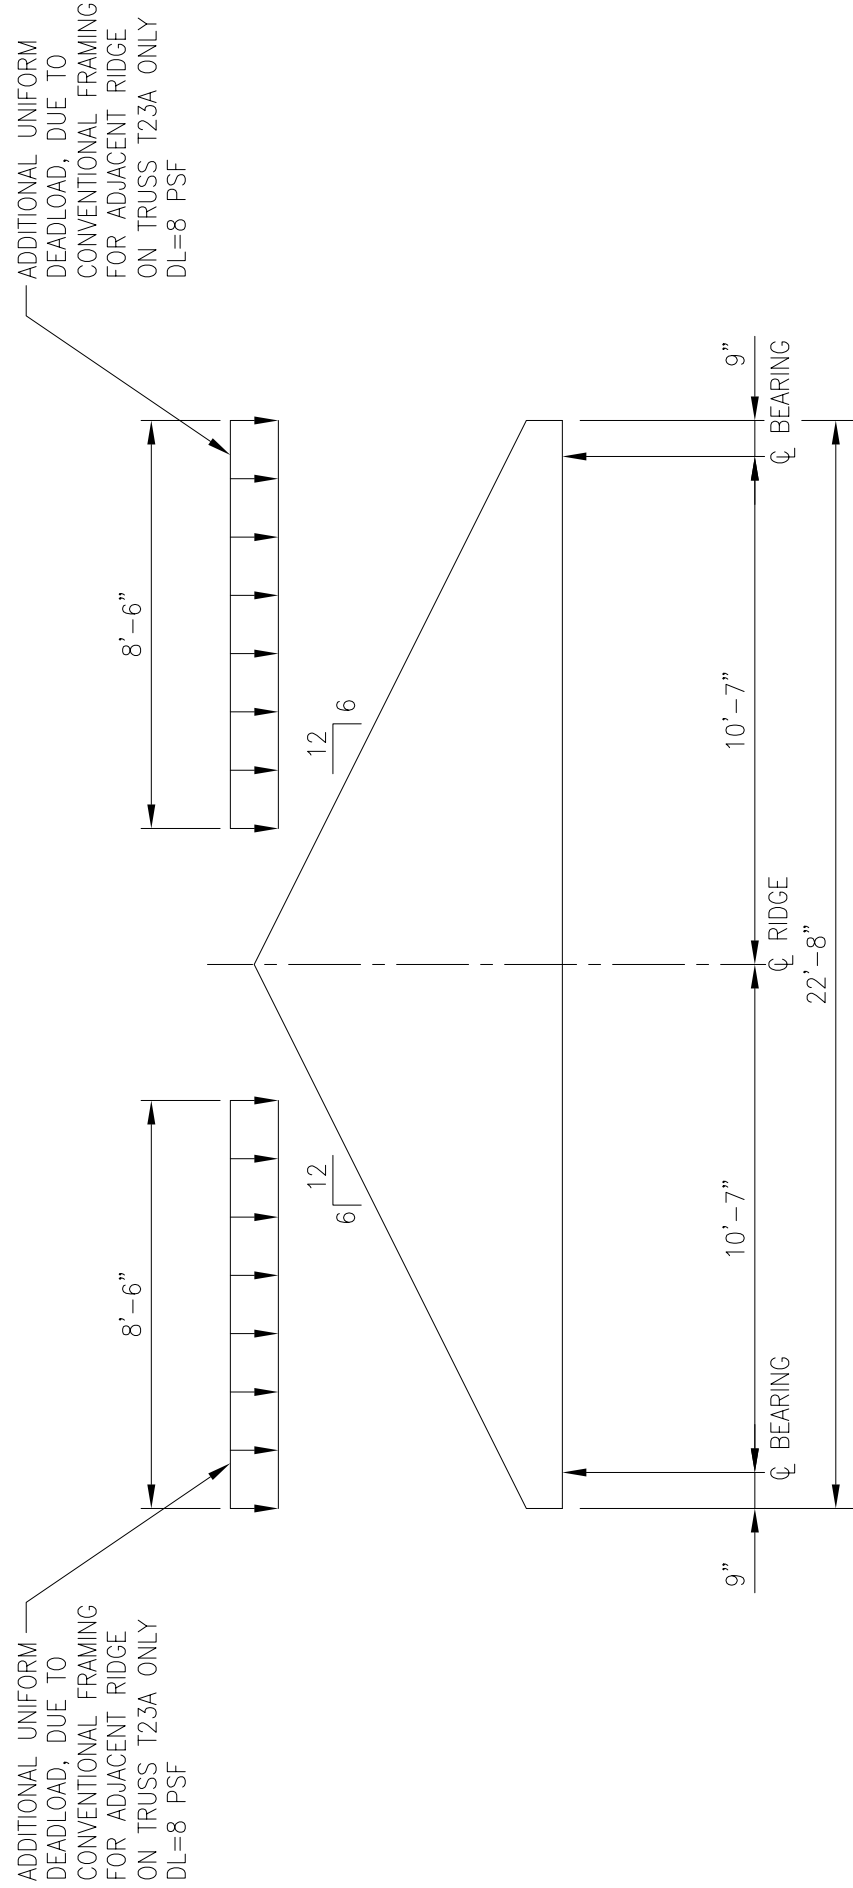

TRUSS T23A & T23B

TRUSS T24

No.	Revision/Issue	Date	By	App'd
1	No Changes from Design to As-Built			

PROJECT TITLE
TEMPORARY LODGING
FACILITY

SHEET TITLE
TRUSS GIRDER PROFILES
AS-BUILT

DRAWN BY RMM	LEAD DESIGNER
TECH REVIEWER	FILE LOCATION
DESIGNED BY TVR	PROJECT NUMBER NKAK02-5001
DATE 28 MAY 2002	SHEET S26
SCALE 1/4"=1'-0"	66 ^{OF} 108