



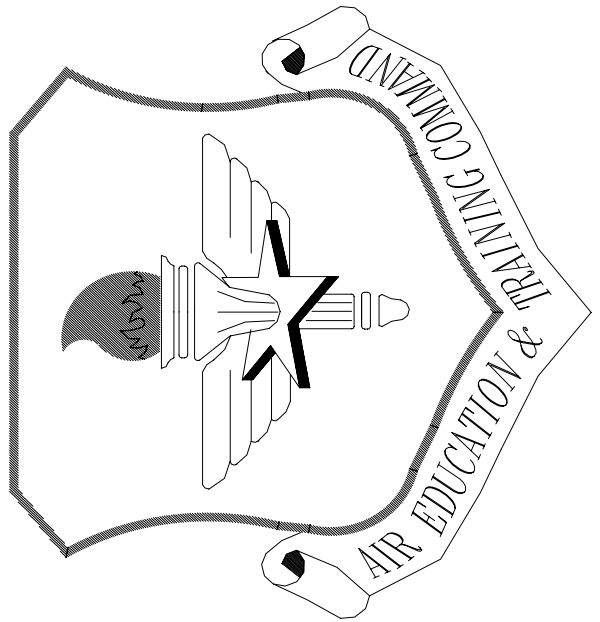

LITTLE ROCK A.F.B.
ARKANSAS

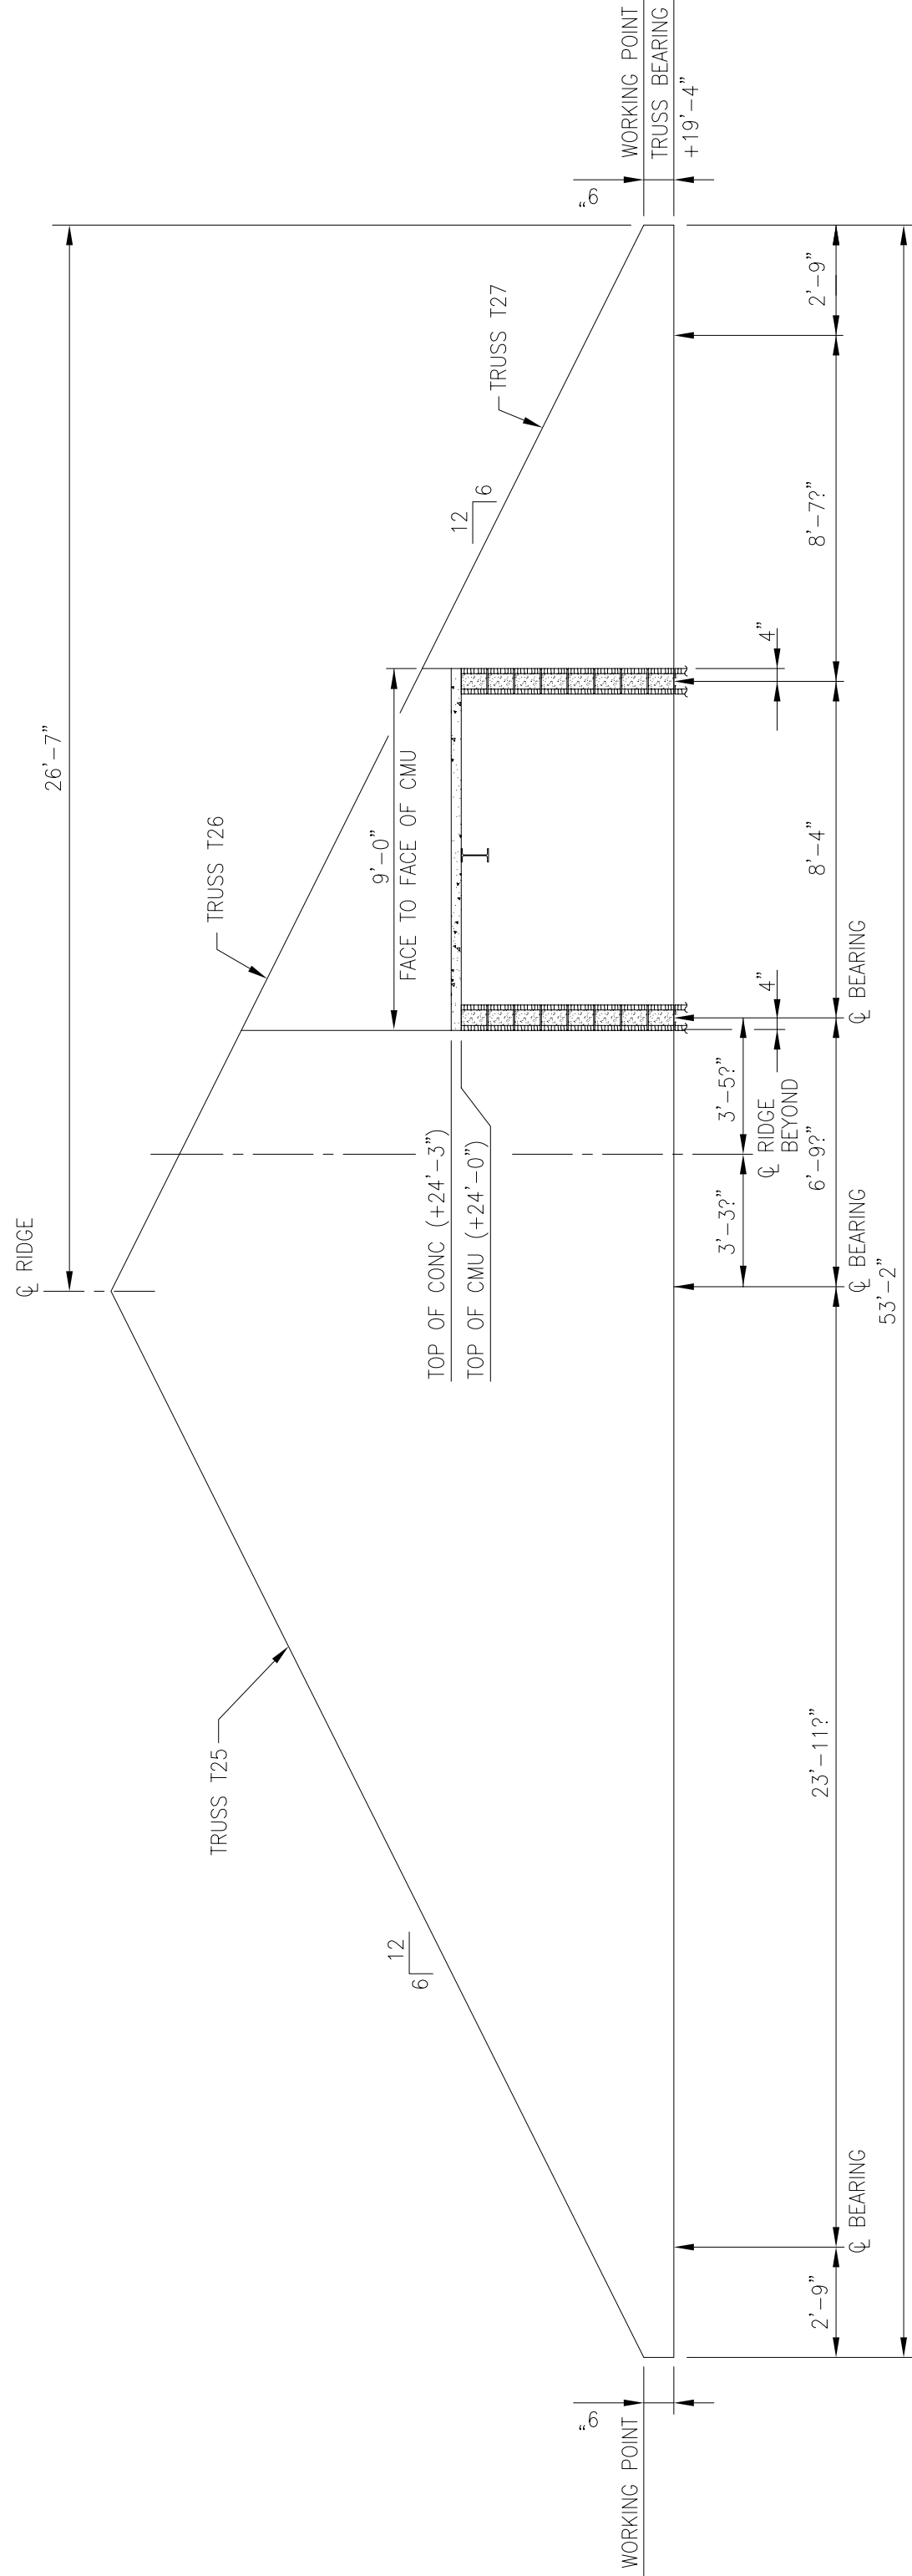

NOTE: DIMENSION OF ELEVATOR SHAFT MAY VARY DEPENDING ON ACTUAL MANUFACTURER OR MODEL SELECTED. VERIFY DIMENSIONS OF CMU PRIOR TO TRUSS FABRICATION.

TRUSS T25, T26, T27

$$z^n = 1, -0^n$$
[illegible]

PROJECT TITLE

TEMPORARY LODGING FACILITY

SHEET TITLE

TRUSS GIRDER PROFILES
AS-BUILT

DRAWN BY MO	LEAD DESIGNER
TECH REVIEWER	FILE LOCATION
DESIGNED BY TVR	PROJECT NUMBER NKAK02-5001
DATE 28 MAY 2002	SHEET S27
SCALE 1/4" = 1'-0"	67 OF 108