



LITTLE ROCK A.F.B.
ARKANSAS

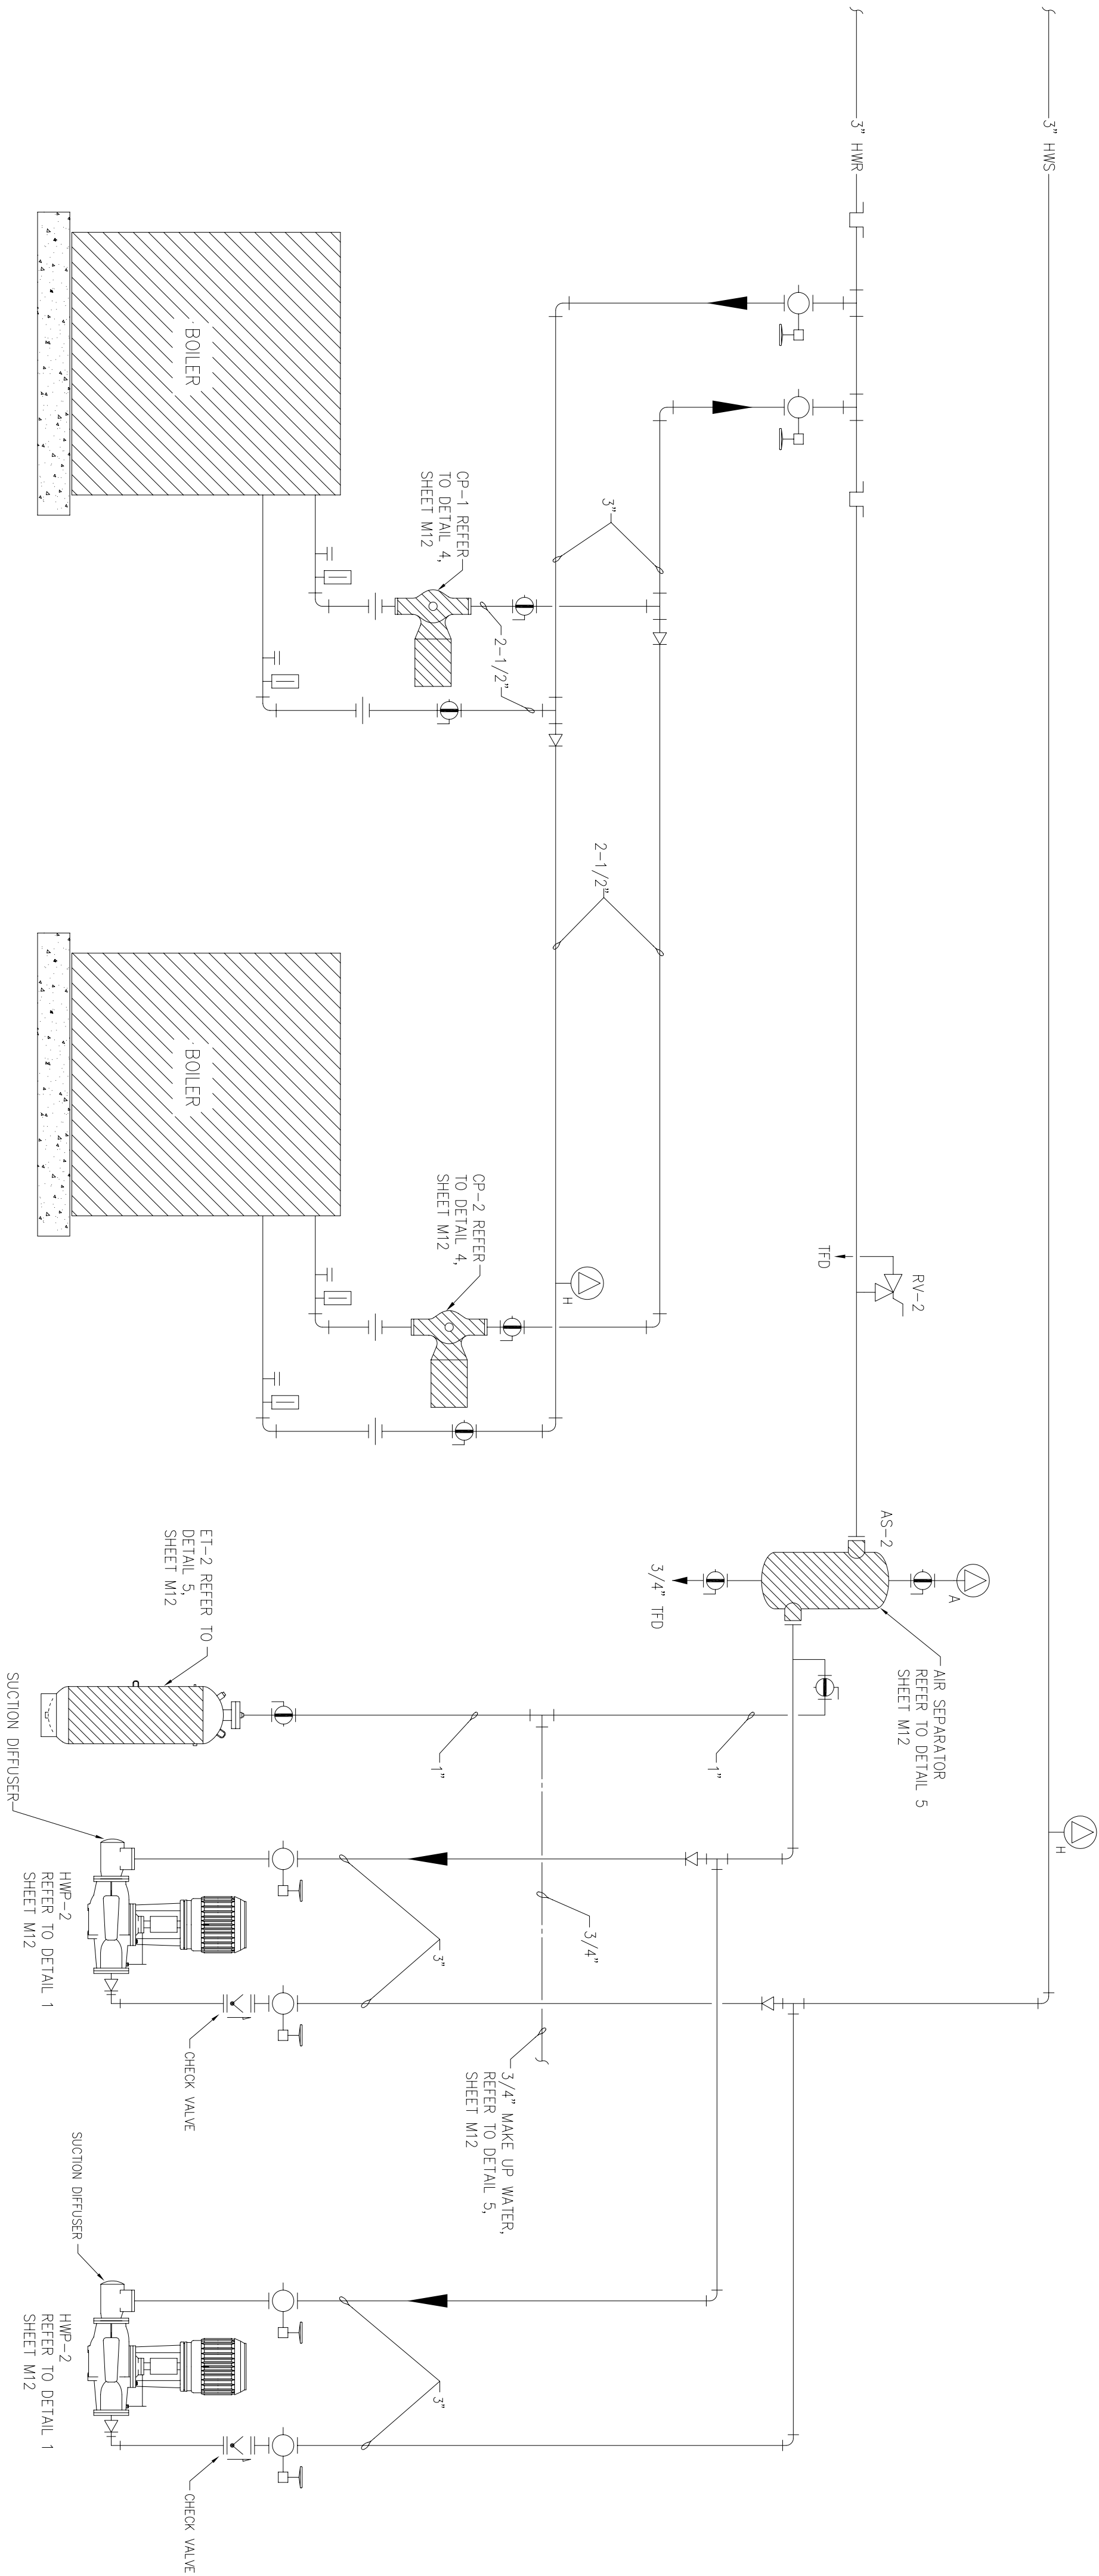

① HEATING WATER FLOW DIAGRAM
SCALE: NONE

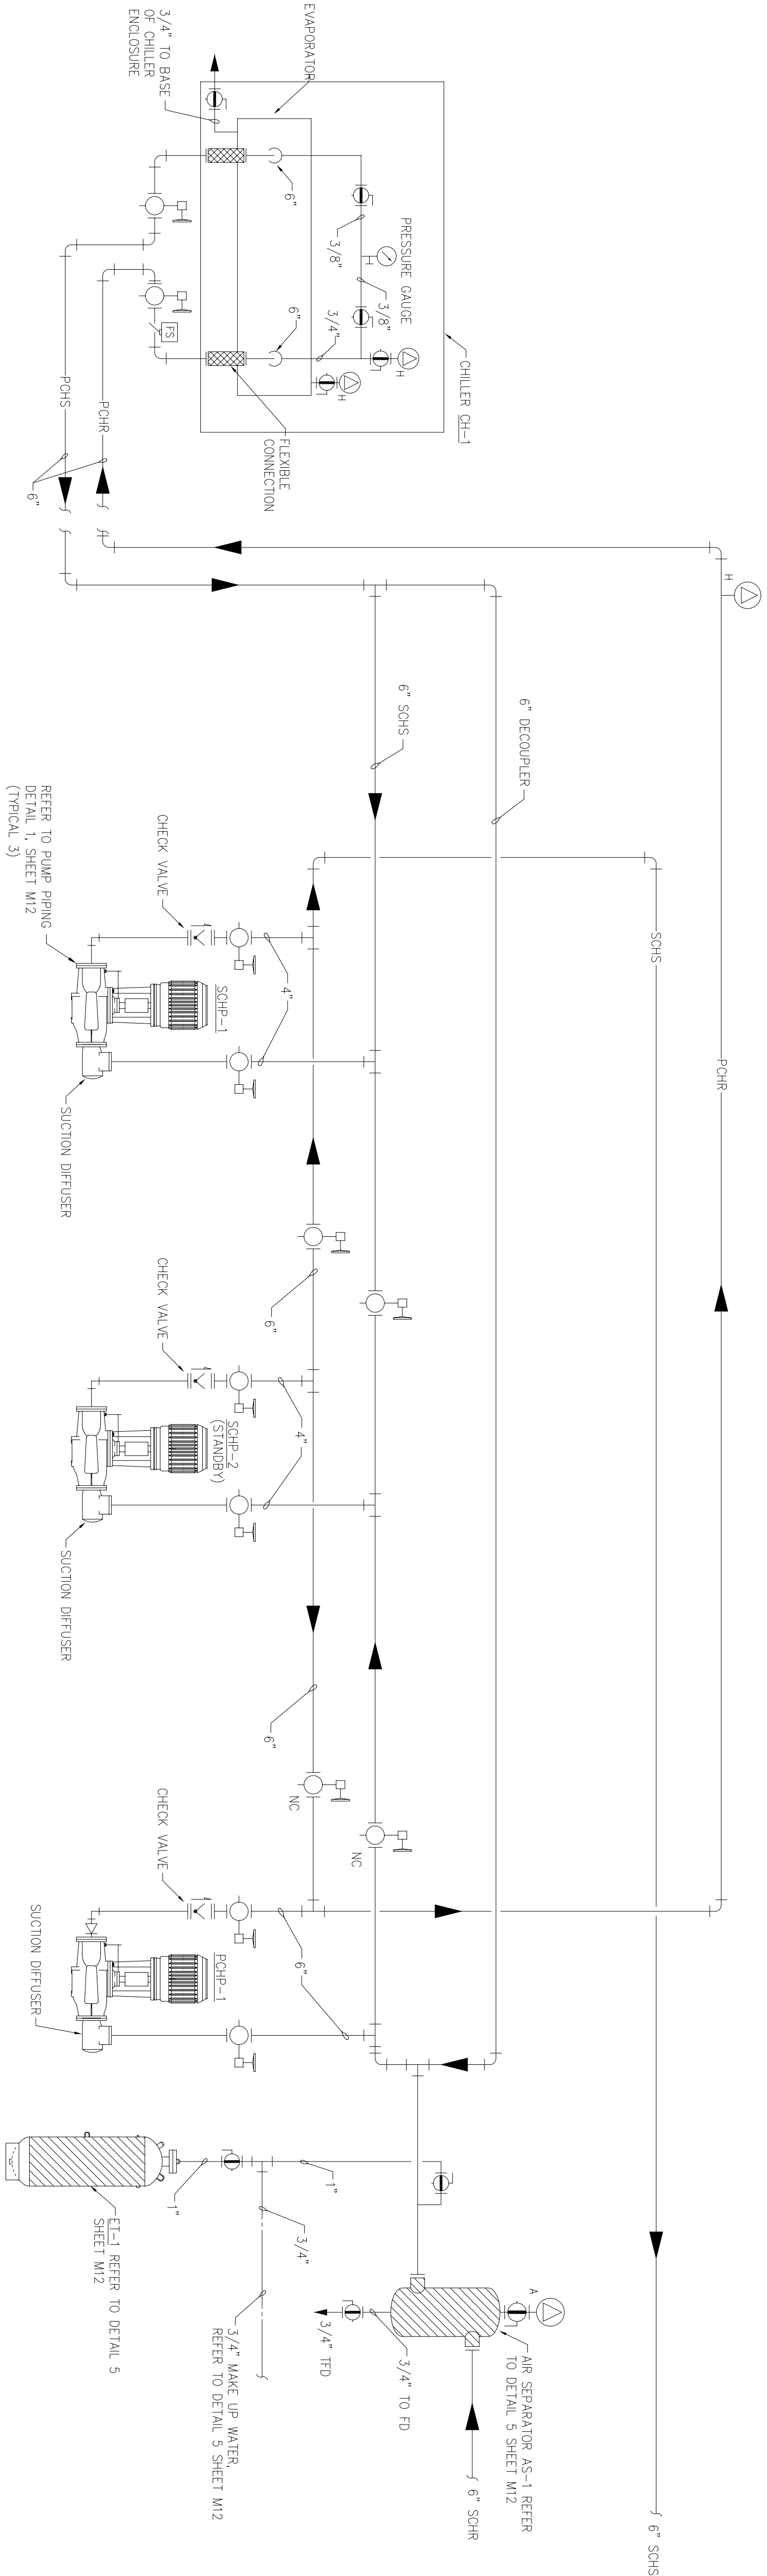

② CHILLED WATER FLOW DIAGRAM
SCALE: NONE

CIVIL ENGINEER	CHIEF ENGINEER
CHIEF OF OPERATIONS	BIO ENVIRONMENTAL ENG.
FIRE CHIEF	SAFETY
PROGRAM MANAGER	USING AGENCY

APP'D	BY	Date	Revision/Issue	No.
			No Changes from Design to As-Built	1

PROJECT TITLE
TEMPORARY LODGING
FACILITY

SHEET TITLE
HVAC FLOW DIAGRAMS
AS-BUILT

DRAWN BY TNS	LEAD DESIGNER WET
TECH REVIEWER TNS	FILE LOCATION
DESIGNED BY TNS	PROJECT NUMBER MKA02-5001
DATE 28 MAY 2002	SHEET M15
SCALE NONE	82 of 108